


site location plan : service access

duisdale house hotel : isle of skye

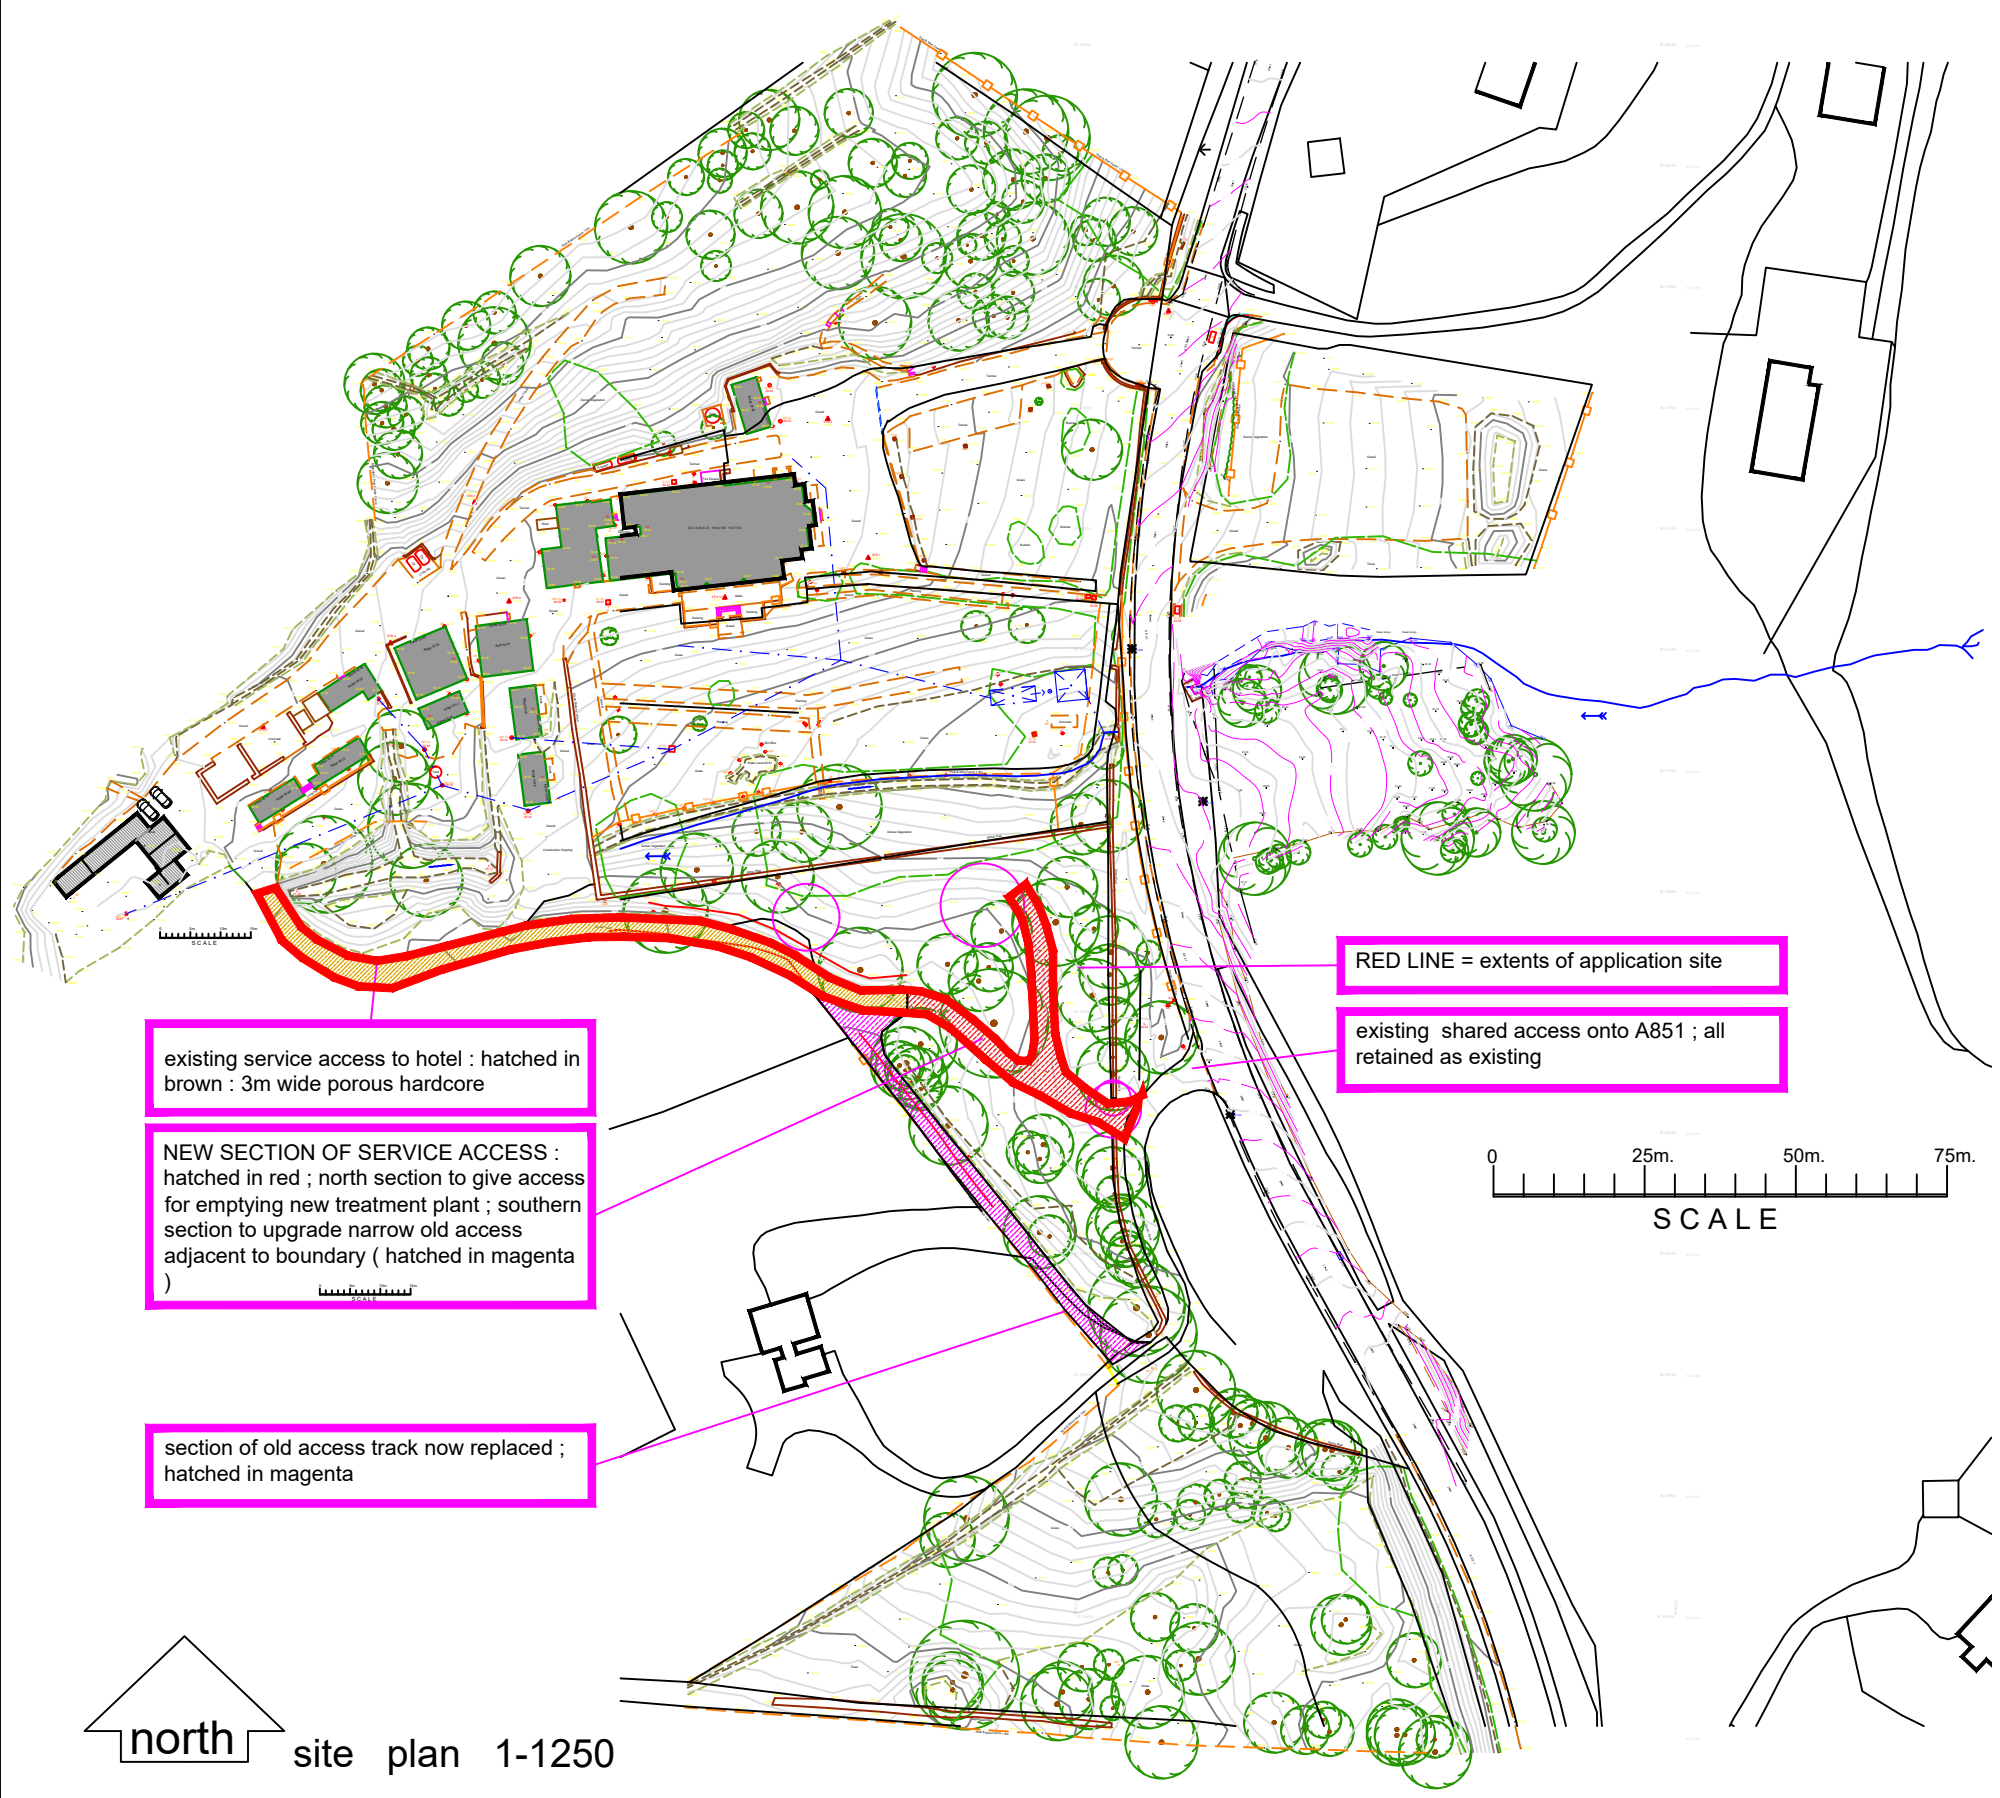


existing service access to hotel : hatched in brown : 3m wide porous hardcore


NEW SECTION OF SERVICE ACCESS : hatched in red ; north section to give access for emptying new treatment plant ; southern section to upgrade narrow old access adjacent to boundary ( hatched in magenta )

section of old access track now replaced ; hatched in magenta

RED LINE = extents of application site

existing shared access onto A851 ; all retained as existing

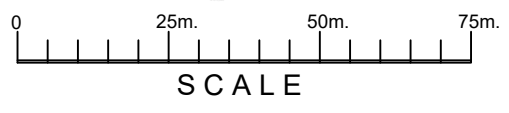

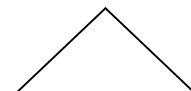
  
 north site plan 1-1250

chartered architect  
 1 waterloo : isle of skye  
<http://www.grigor-taylorassociates.co.uk>  
 tansygd@btinternet.com : 07720059219

service access improvements : dunsdale house  
 for anne gracie  
 scale 1-1250@a3  
 dwg no. 989A-101a



grigor-taylor associates  
chartered architect