


site location plan : service access

duisdale house hotel : isle of skye

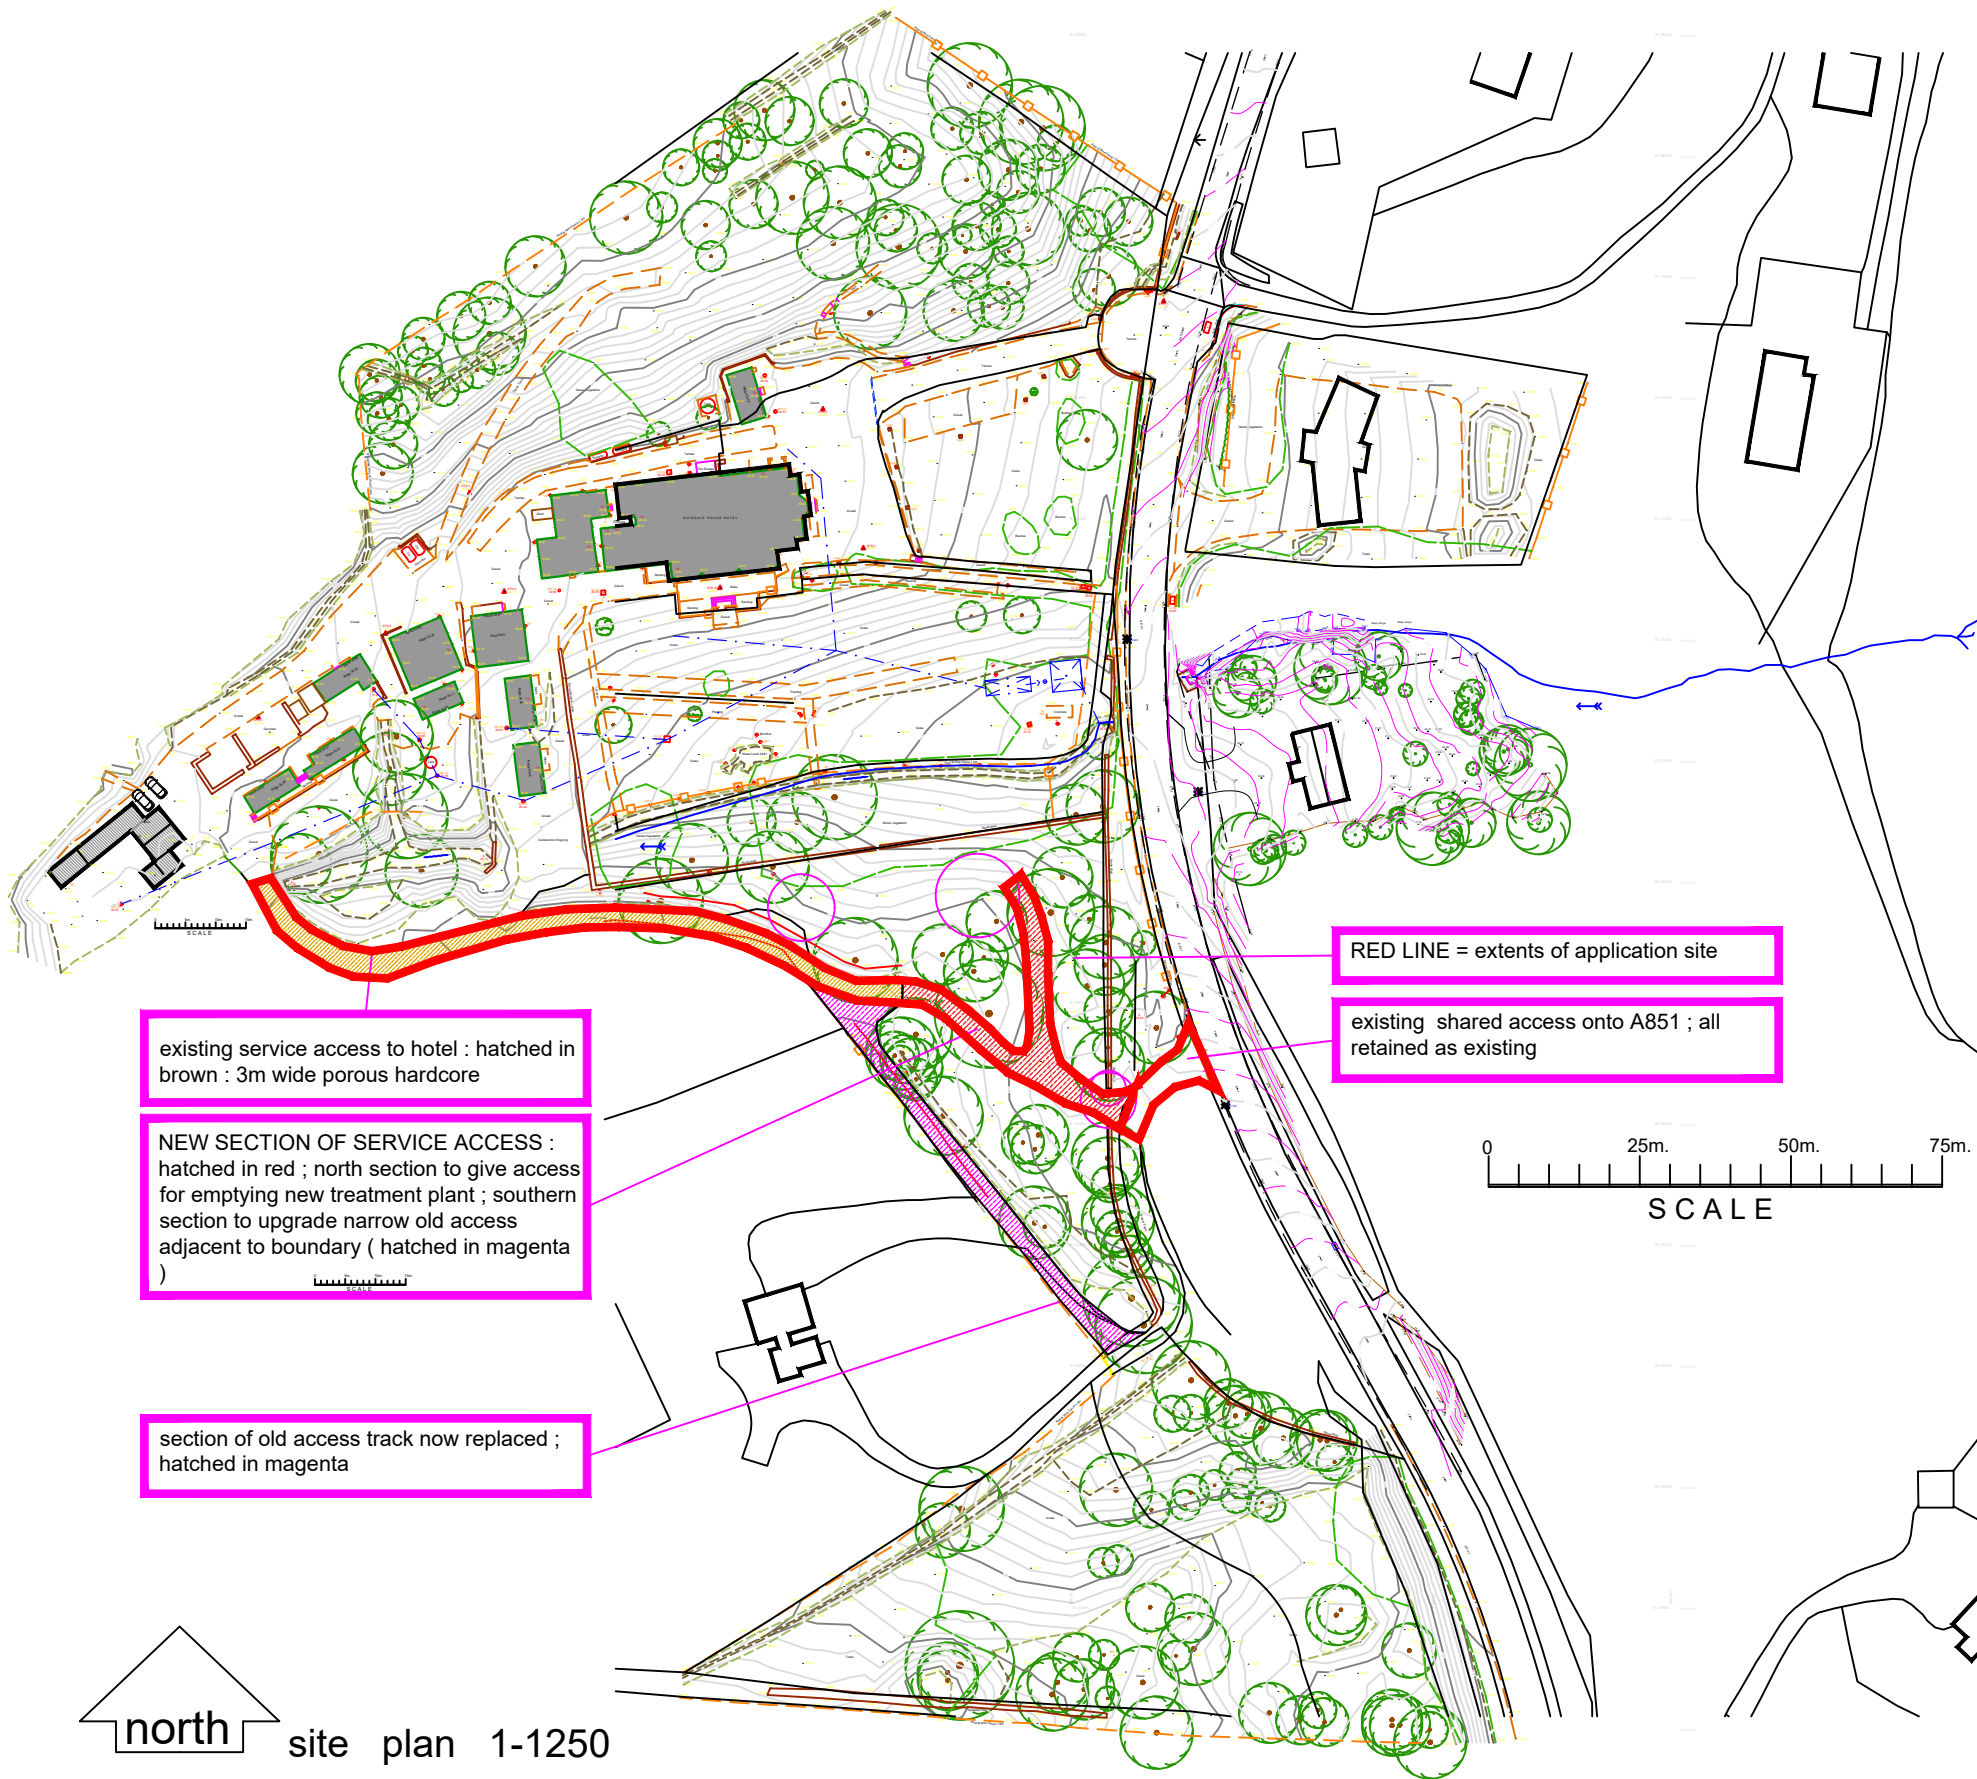

existing service access to hotel : hatched in brown : 3m wide porous hardcore

NEW SECTION OF SERVICE ACCESS : hatched in red ; north section to give access for emptying new treatment plant ; southern section to upgrade narrow old access adjacent to boundary (hatched in magenta)

section of old access track now replaced ; hatched in magenta

RED LINE = extents of application site

existing shared access onto A851 ; all retained as existing



north site plan 1-1250

chartered architect
 1 waterloo : isle of skye
<http://www.grigor-taylorassociates.co.uk>
 tansygd@btinternet.com : 07720059219

service access improvements : duisdale house
 for anne gracie
 scale 1-1250@a3
 dwg no. 989A-101b

grigor-taylor associates
 chartered architect