


PROPOSED REDLINE:
0.264 HECTARES

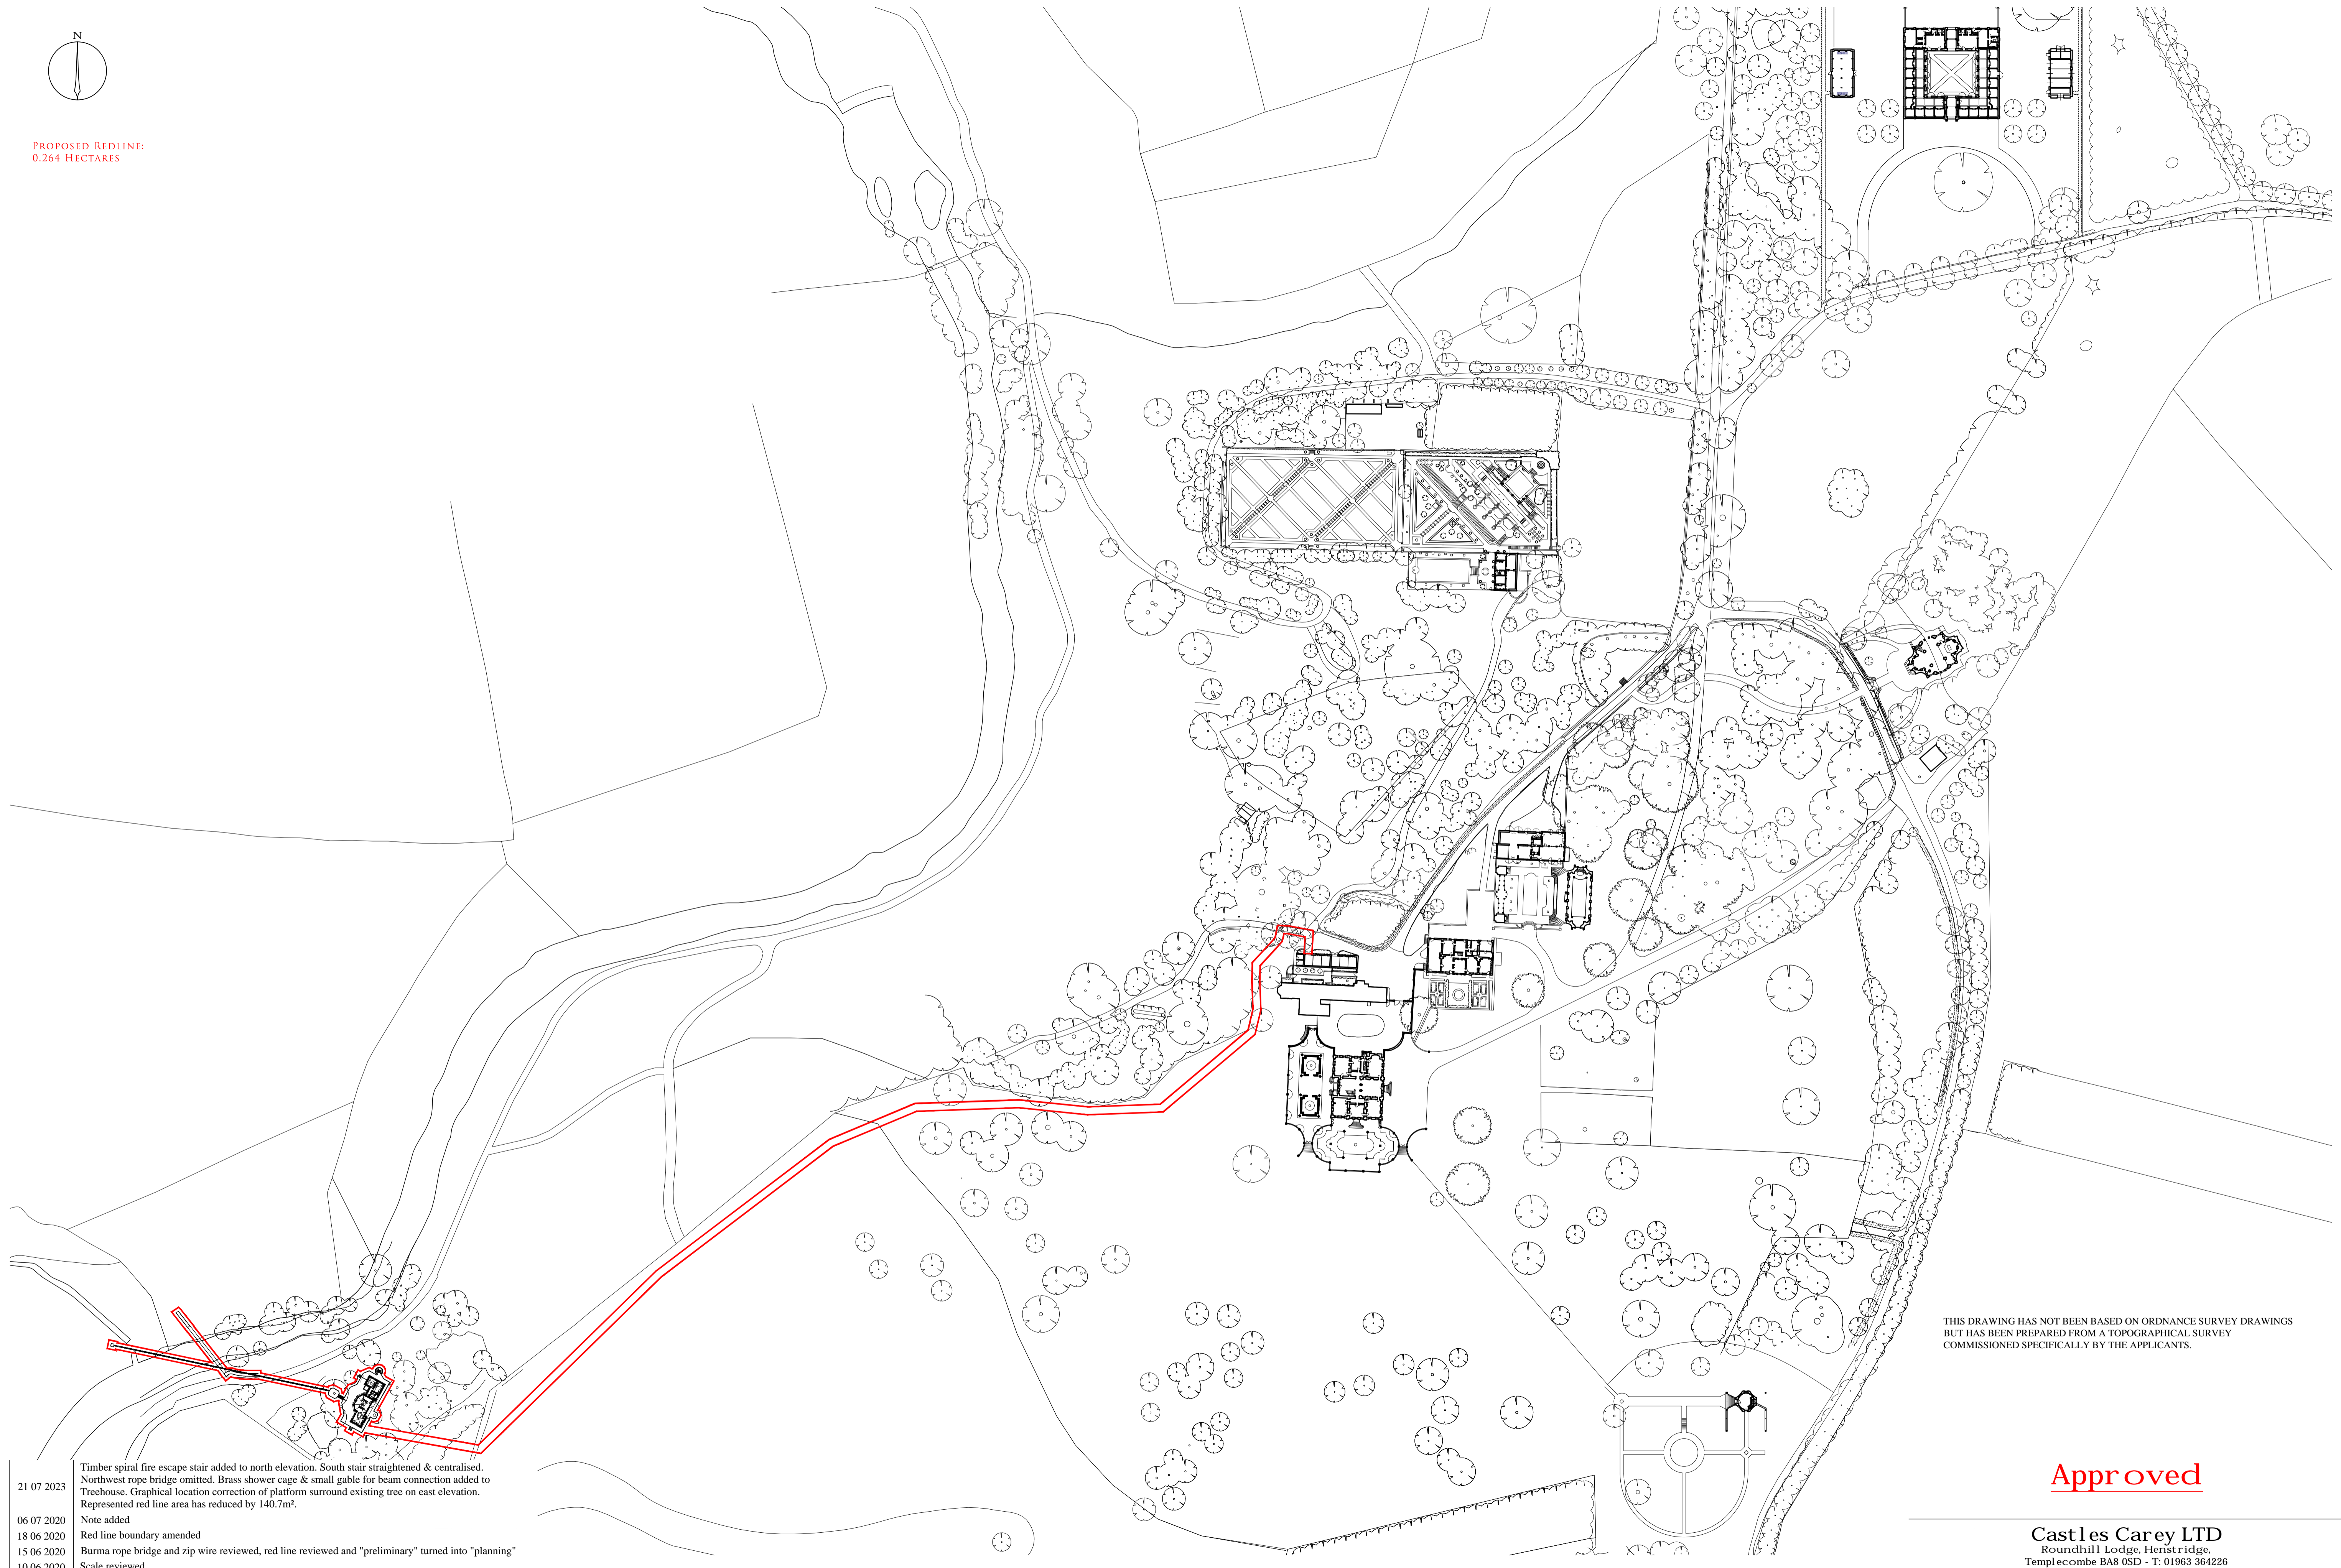

THIS DRAWING HAS NOT BEEN BASED ON ORDNANCE SURVEY DRAWINGS
BUT HAS BEEN PREPARED FROM A TOPOGRAPHICAL SURVEY
COMMISSIONED SPECIFICALLY BY THE APPLICANTS.

Approved

E	21 07 2023	Timber spiral fire escape stair added to north elevation. South stair straightened & centralised. Northwest rope bridge omitted. Brass shower cage & small gable for beam connection added to Treehouse. Graphical location correction of platform surround existing tree on east elevation. Represented red line area has reduced by 140.7m ² .
D	06 07 2020	Note added
C	18 06 2020	Red line boundary amended
B	15 06 2020	Burma rope bridge and zip wire reviewed, red line reviewed and "preliminary" turned into "planning"
A	10 06 2020	Scale reviewed
REV.	DATE	NOTES

Castles Carey LTD
Roundhill Lodge, Henstridge,
Templecombe BA8 0SD - T: 01963 364226

PROJECT:	Mawley Hall: Treehouse
DRAWING TITLE:	Location Plan
DRAWING NO.:	AD15
DATE:	08-06-2020
REVISION:	E
SCALE:	1:1250@A1

CHECK ALL DIMENSIONS CAREFULLY ON SITE AND REPORT ANY DISCREPANCIES
DO NOT SCALE FROM THIS DRAWING (EXCEPT PLANNING DRAWINGS)