




Existing fence at 1800mm to be retained

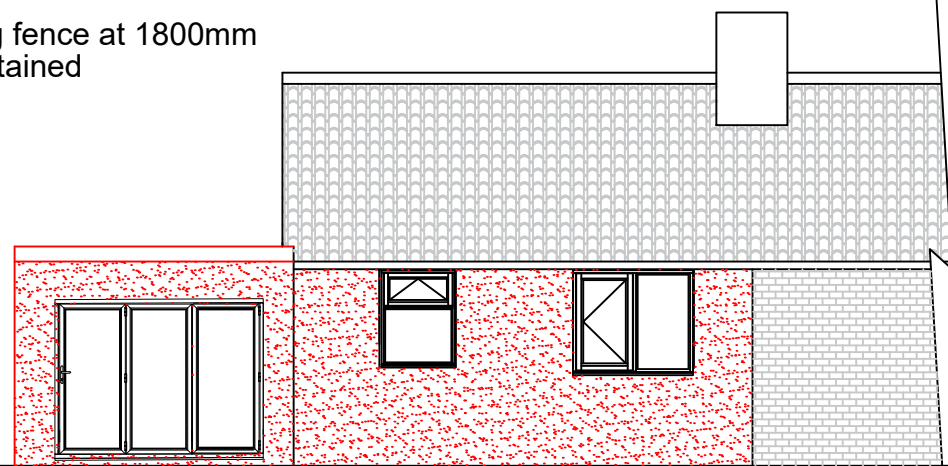

Front Elevation

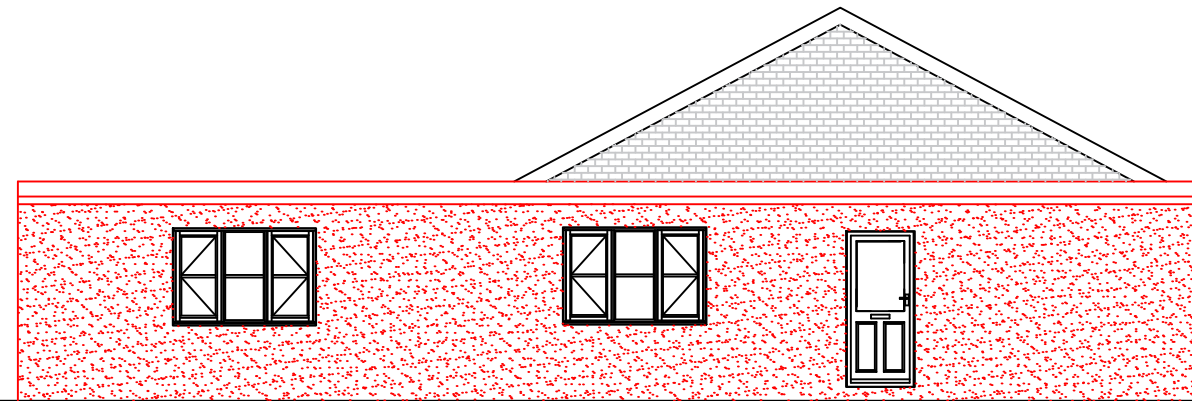

Side (South) Elevation

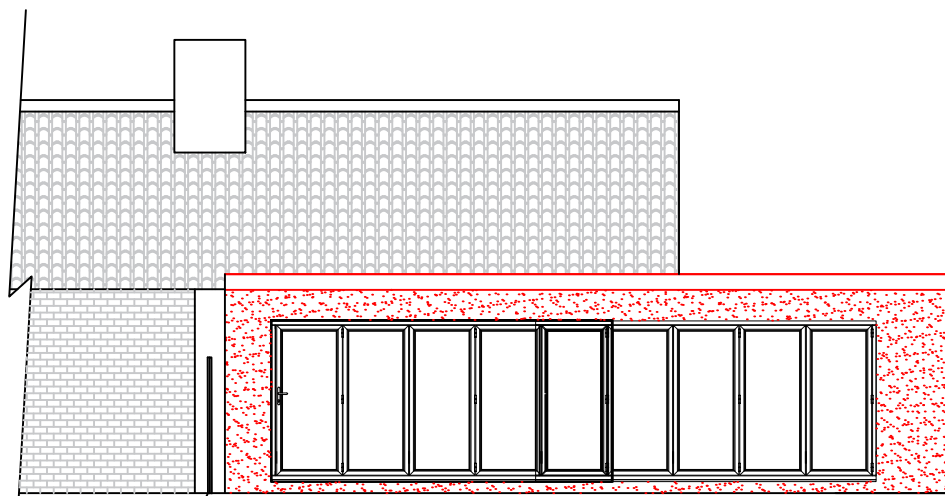


Existing fence at 1800mm to be retained

Rear Elevation

Existing fence at 1800mm to be retained


2900

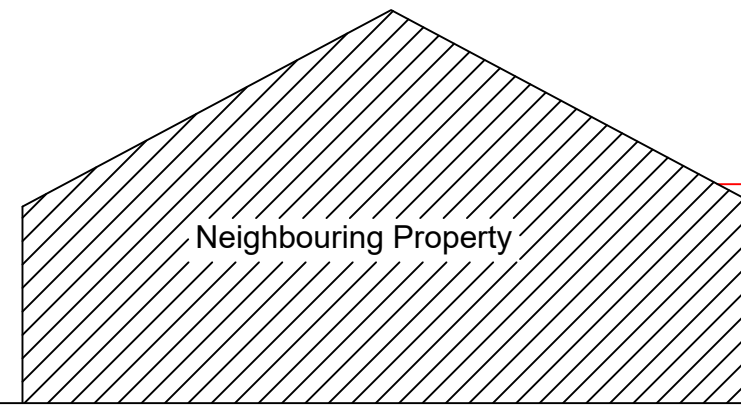

Neighbouring Property

Existing Extension wall to be retained

Side (North) Elevation

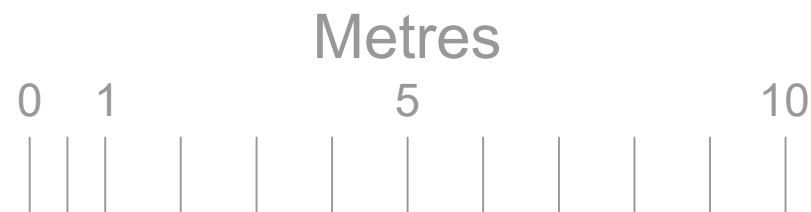

Rev B  
Marked up to Planning Dept comments  
Do Not Scale

Title  
Proposed Elevations

Scale 1:100	Size A3	Date Oct 23
----------------	------------	----------------

Drawing Number  
23/023/05

Rev  
B

Project Title  
Building Extension and Alterations  
to 20 the Crossings Airmym, Goole. DN14 8LE  
For Mr Collins

Tel 01472 210547 - 07545 225615 - 07716196800