


Ground Floor Plan

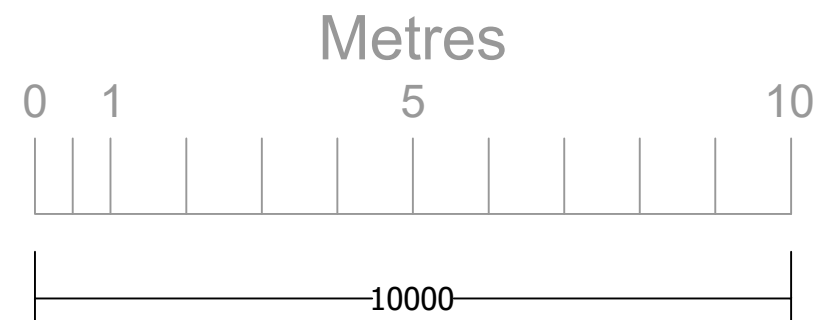

Rev B
Marked up to Planning Dept comments

Do Not Scale

Title
Existing Plans

| | | |
|----------------|------------|----------------|
| Scale 1:100 | Size A3 | Date Oct 23 |
|----------------|------------|----------------|



Tel 01472 210547 - 07545 225615 - 07716196800

Drawing Number
23/023/02

Rev
B

Project Title Building Extension and Alterations
to 20 the Crossings Airmym, Goole. DN14 8LE
For Mr Collins