




AS BUILT GROUND FLOOR PLAN

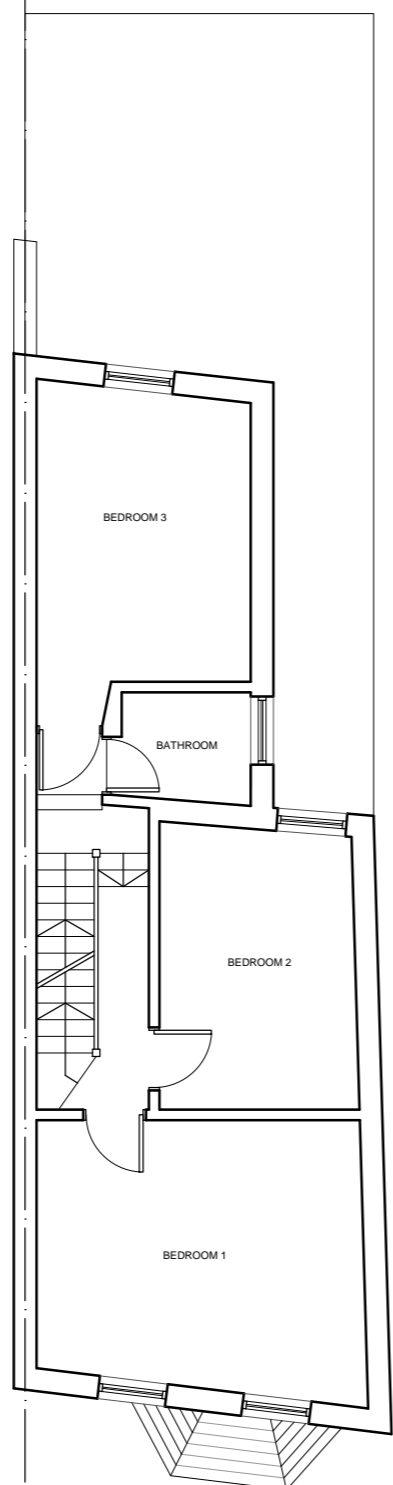


AS BUILT FIRST FLOOR PLAN

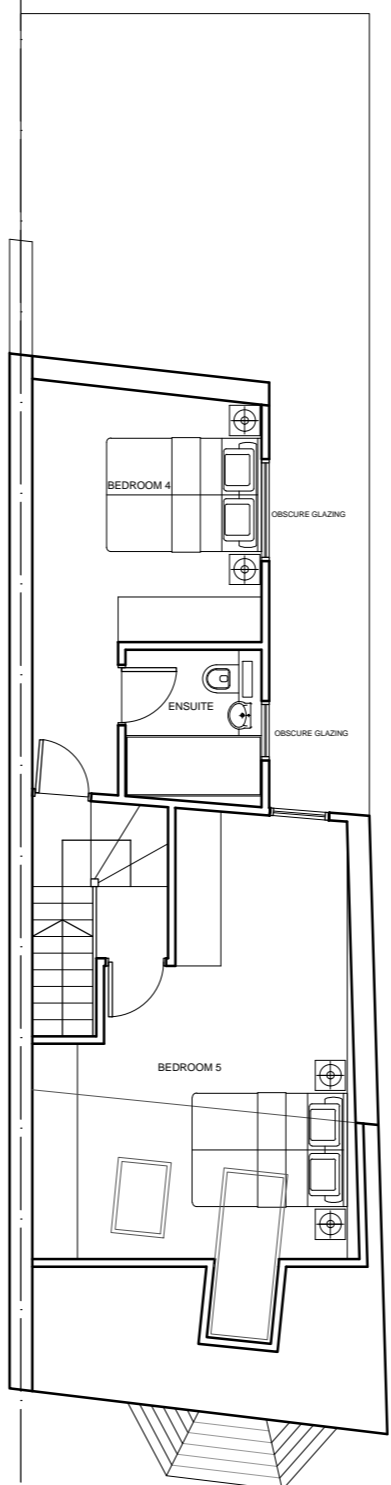


AS BUILT SECOND FLOOR PLAN

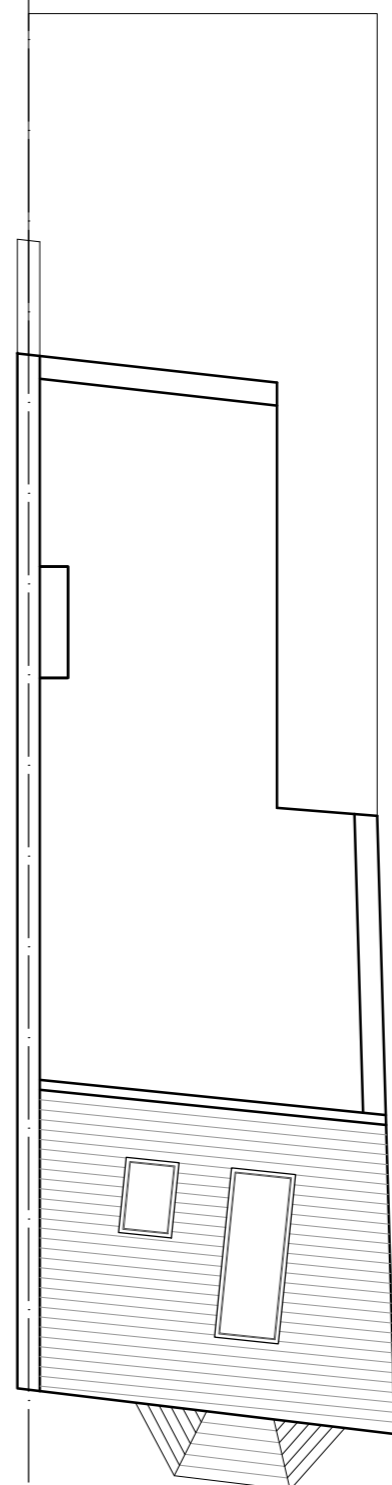


AS BUILT ROOF PLAN

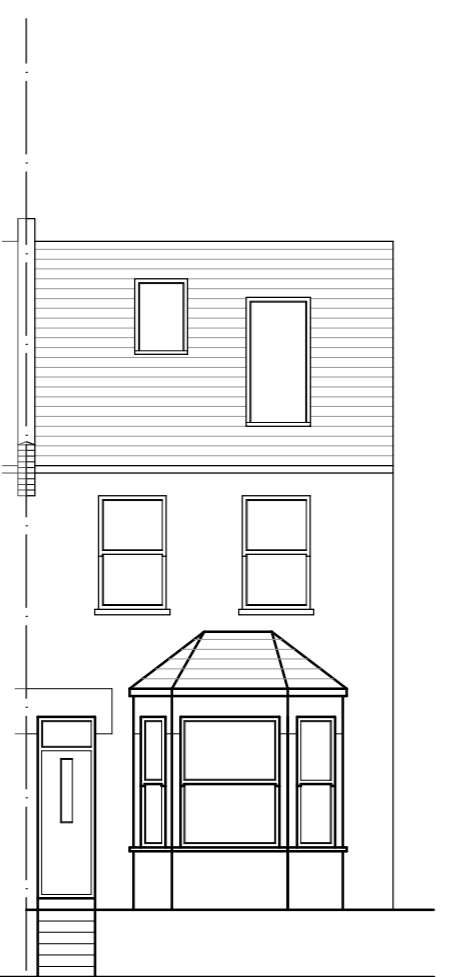

AS BUILT FRONT ELEVATION

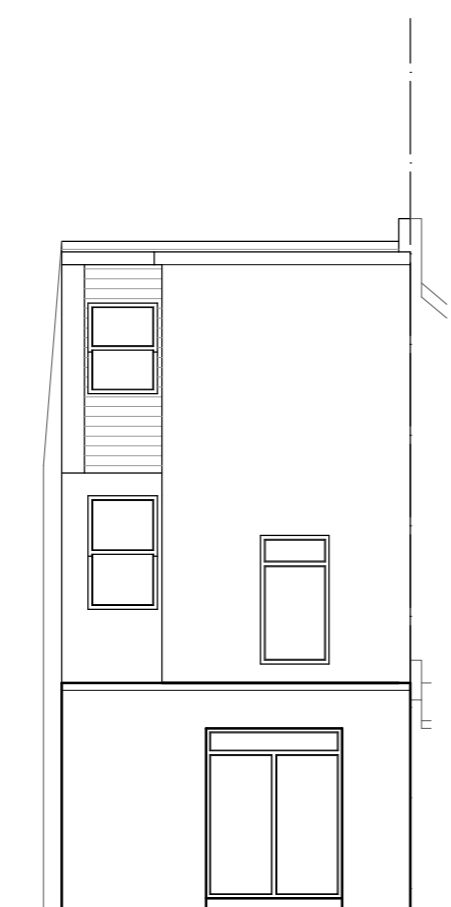

AS BUILT REAR ELEVATION

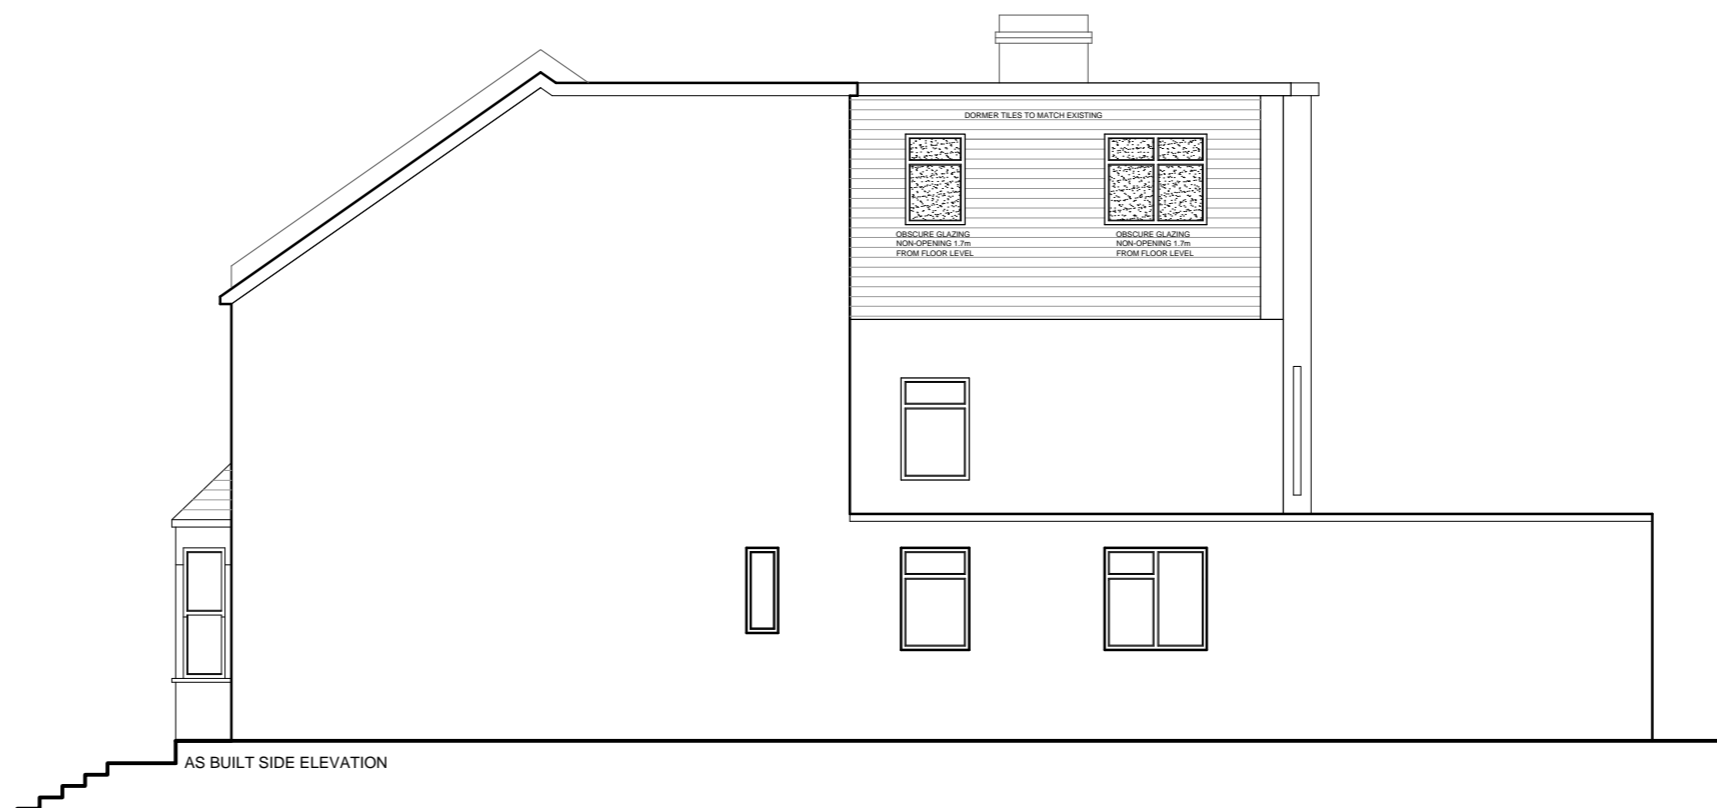

AS BUILT SIDE ELEVATION



SCALE 1:100

REVISIONS		
No	Description	Date

Notes

DRAWING STATUS  
PLANNING

INSTRUCTION  
This drawing is the property of ARISTA ARCHITECTURE and may not be reproduced without prior consent.  
[www.arista-architecture.com](http://www.arista-architecture.com)

Client	ECOS PROPERTIES LTD	
Project	127 EDGRIDGE ROAD CROYDON CR0 1EJ	
Title	AS BUILT PLANS & ELEVATIONS	
Scale	1:100	Drawing No.
Date	07.11.23	Rev.