



STARBUCKS COFFEE COMPANY
2401 UTAH AVENUE SOUTH
SEATTLE, WASHINGTON 98134
(206) 318-1575

DRAWINGS AND SPECIFICATIONS ARE CONFIDENTIAL AND SHALL REMAIN THE SOLE PROPERTY OF STARBUCKS CORPORATION. WHICH IS THE OWNER OF THE COPYRIGHT IN THIS WORK. THEY SHALL NOT BE REPRODUCED (IN WHOLE OR IN PART), SHARED WITH THIRD PARTIES OR USED IN ANY MANNER ON OTHER PROJECTS OR EXTENSIONS TO THIS PROJECT WITHOUT THE PRIOR WRITTEN CONSENT OF STARBUCKS CORPORATION. THESE DRAWINGS AND SPECIFICATIONS ARE INTENDED TO EXPRESS DESIGN INTENT FOR A PROTOTYPICAL STARBUCKS STORE (WHICH IS SUBJECT TO CHANGE AT ANYTIME) AND DO NOT REFLECT ACTUAL SITE CONDITIONS. NEITHER PARTY SHALL HAVE ANY OBLIGATION NOR LIABILITY TO THE OTHER (EXCEPT STATED ABOVE) UNTIL A WRITTEN AGREEMENT IS FULLY EXECUTED BY BOTH PARTIES.

STARBUCKS TEMPLATE VERSION EMEA 2019_01

ARCHITECT OF RECORD

THIS DRAWING IS A DESIGN DEVELOPMENT DOCUMENT. SITE SPECIFIC MODIFICATIONS MADE UNDER THE RESPONSIBLE CHARGE OF THE ARCHITECT AND/OR ENGINEER-OF-RECORD WILL BE REQUIRED PRIOR TO USING THIS DOCUMENT FOR BIDDING, PERMITTING, OR CONSTRUCTION.

SCHEMATIC ONLY - NOT INTENDED FOR CONSTRUCTION

PROJECT NAME:
BOLTON MANCHESTER RD DT

PROJECT ADDRESS:
**UNITED KINGDOM
GREATER MANCHESTER
BOLTON MANCHESTER RD**

STORE # **71852**
PROJECT # **95226-001**
PLAYBOOK FORMAT **DRIVE-THRU**
INITIAL ISSUE DATE **08/11/23**
DESIGN MANAGER **AARON WEST**
PROJECT DESIGNER **EMILY SABINE**
CHECKED BY **NAME**


REVISION SCHEDULE

REV	DATE	BY	DESCRIPTION


SHEET TITLE:
Schematic Site Plan

SCALE: AS SHOWN (@A3)

SD2

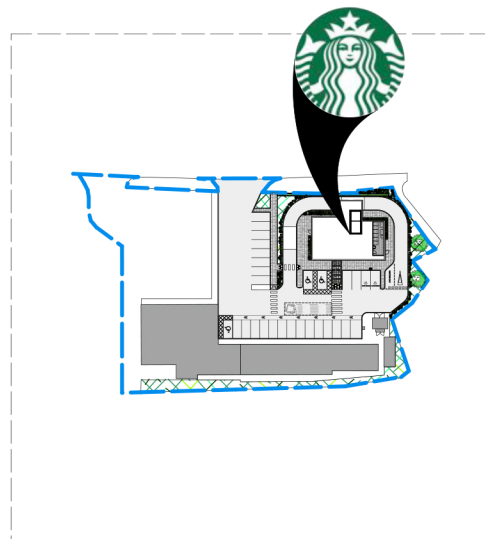

2 LOCATION PLAN
Scale: 1:2000

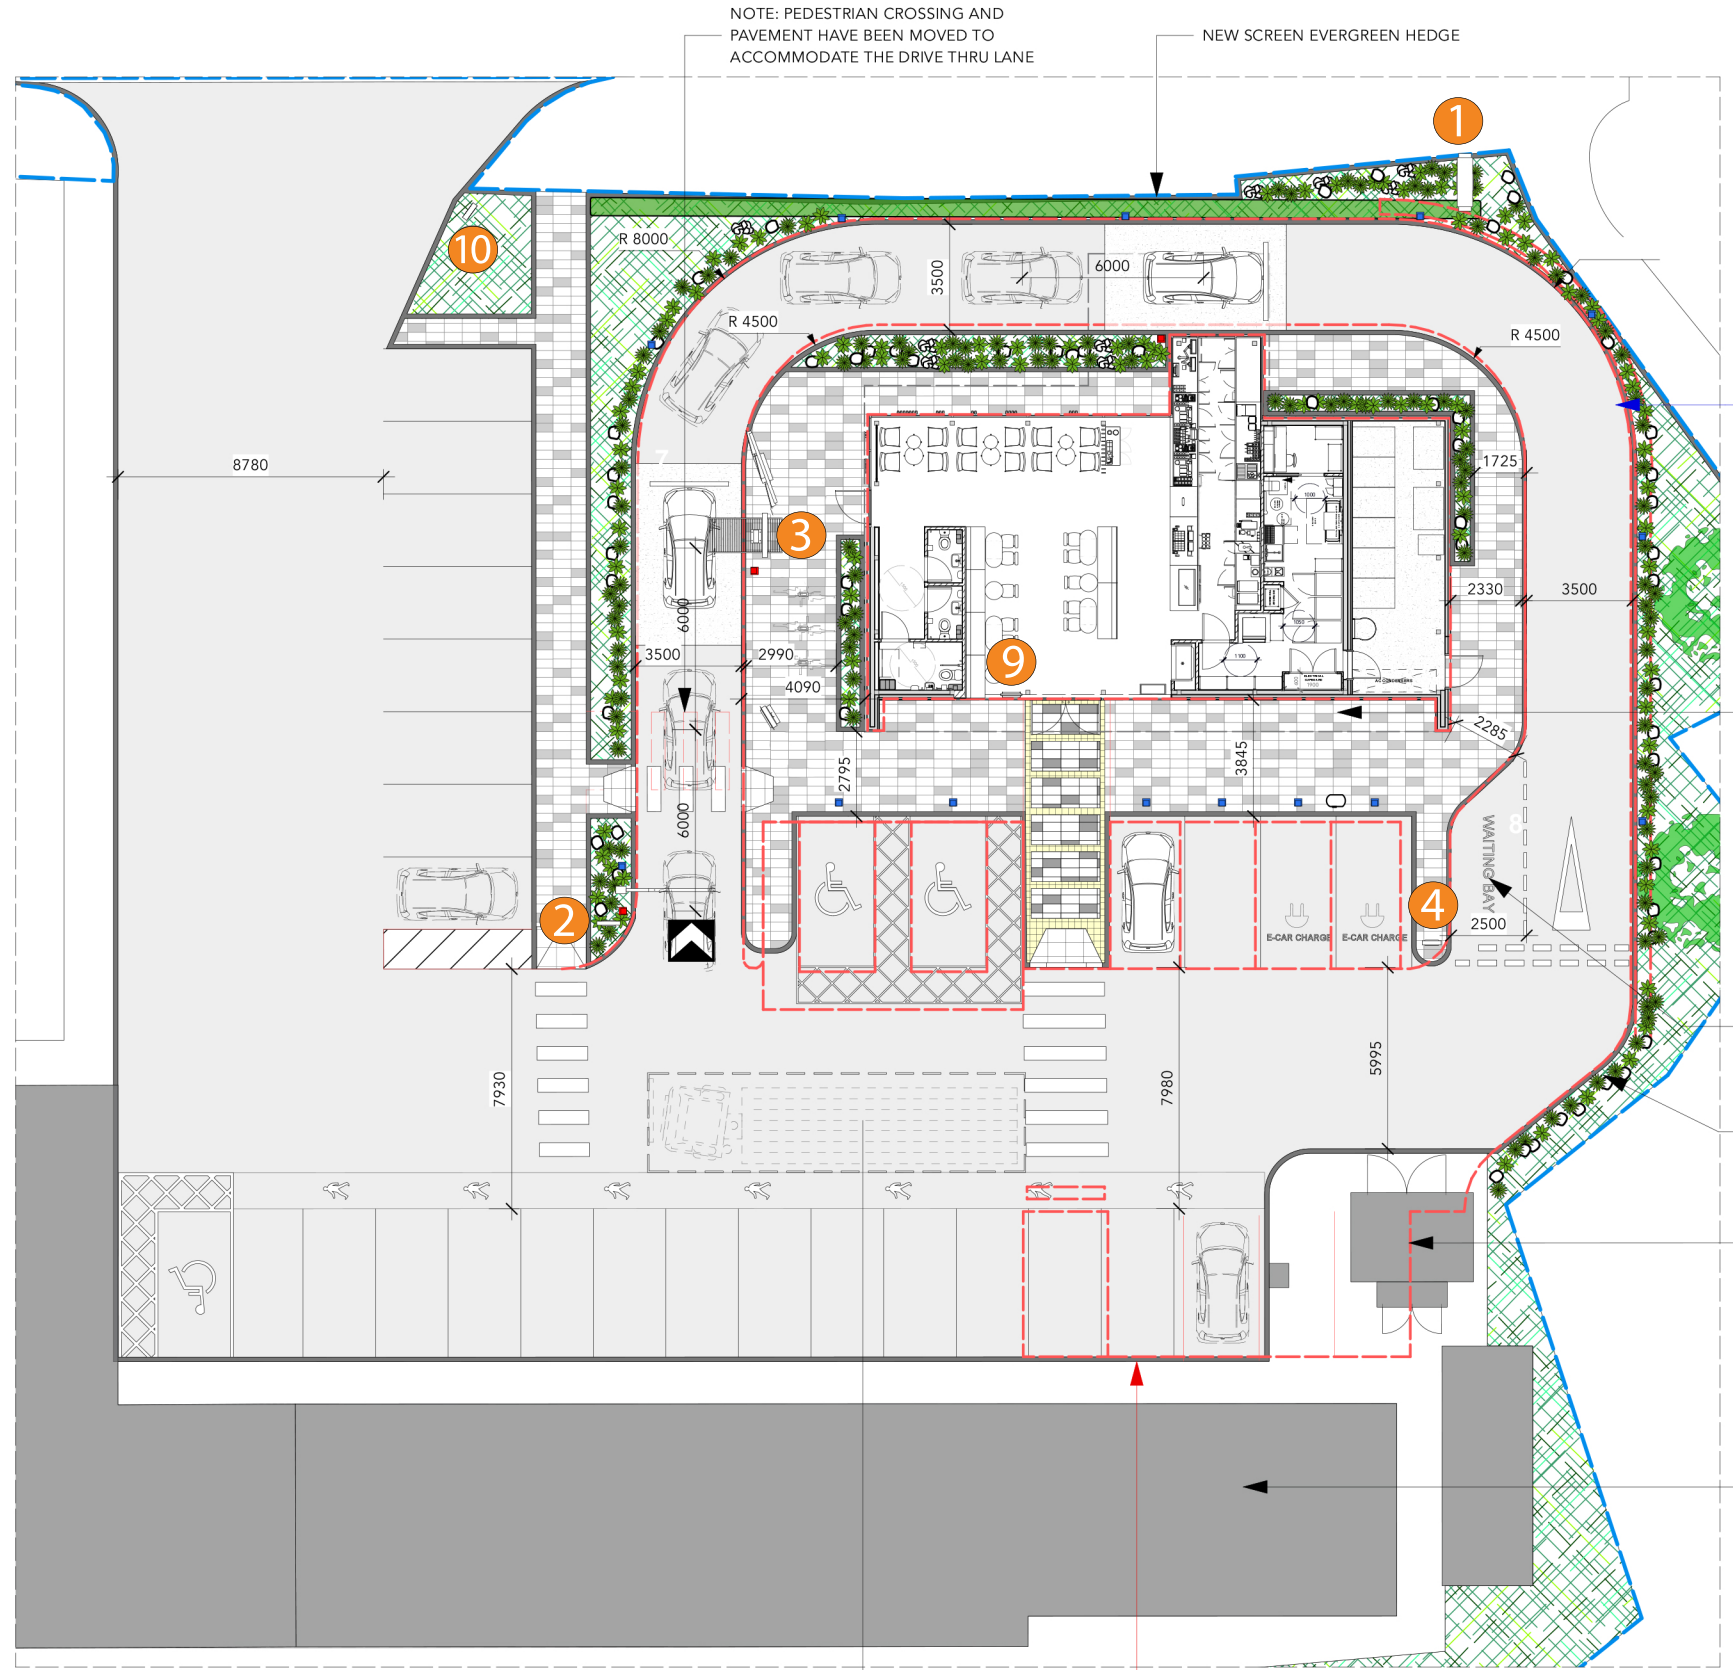

BLUE LINE INDICATES SITE DEMISE

NOTE: OUTDOOR SEATING REMOVED. DISTANCE TO BETWEEN PARKING WAS LESS THAN THE MINIMUM STANDARD OF 3600MM

NOTE: CCTV TO BE DIRECTED AT WAITING BAY

EXISTING DOMESTIC TIMBER FENCE RETAINED

NEW SUBSTATION

NEW BUILDINGS

NOTE: PEDESTRIAN CROSSING AND PAVEMENT HAVE BEEN MOVED TO ACCOMMODATE THE DRIVE THRU LANE
NEW SCREEN EVERGREEN HEDGE

NOTE: INDICATIVE OUT OF HOURS LOADING BAY. TRACKING REPORT TBC IF LOCATION IS FEASIBLE.

RED LINE INDICATES TEST FIT PLAN

1 SITE PLAN
Scale: 1:250

- METAL BOLLARD WITH REFLECTIVE STRIP
- NON-ILLUMINATED BOLLARD

