
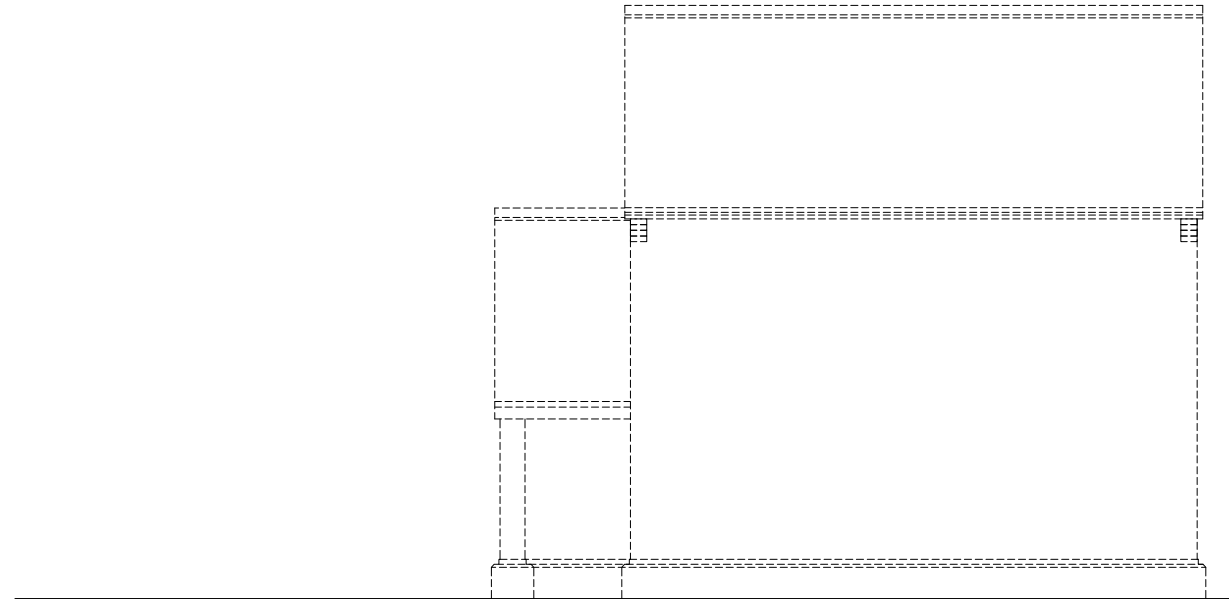
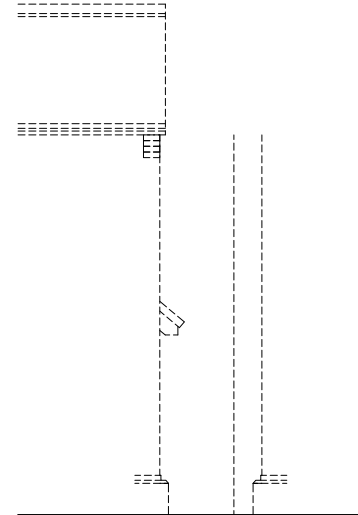


No.	Revision	Date
-	-	-



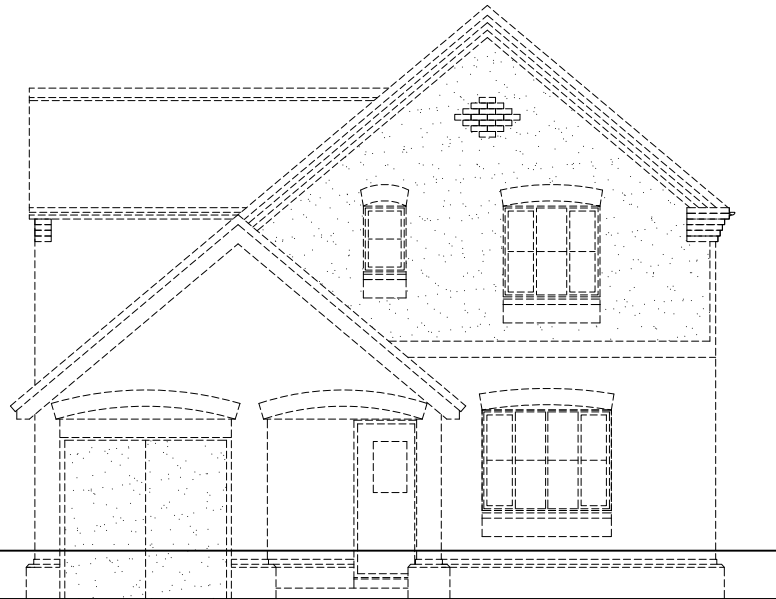


Front Elevation

No7 No6
Rear Elevation

Side Elevation

PRE-EXISTING ELEVATIONS

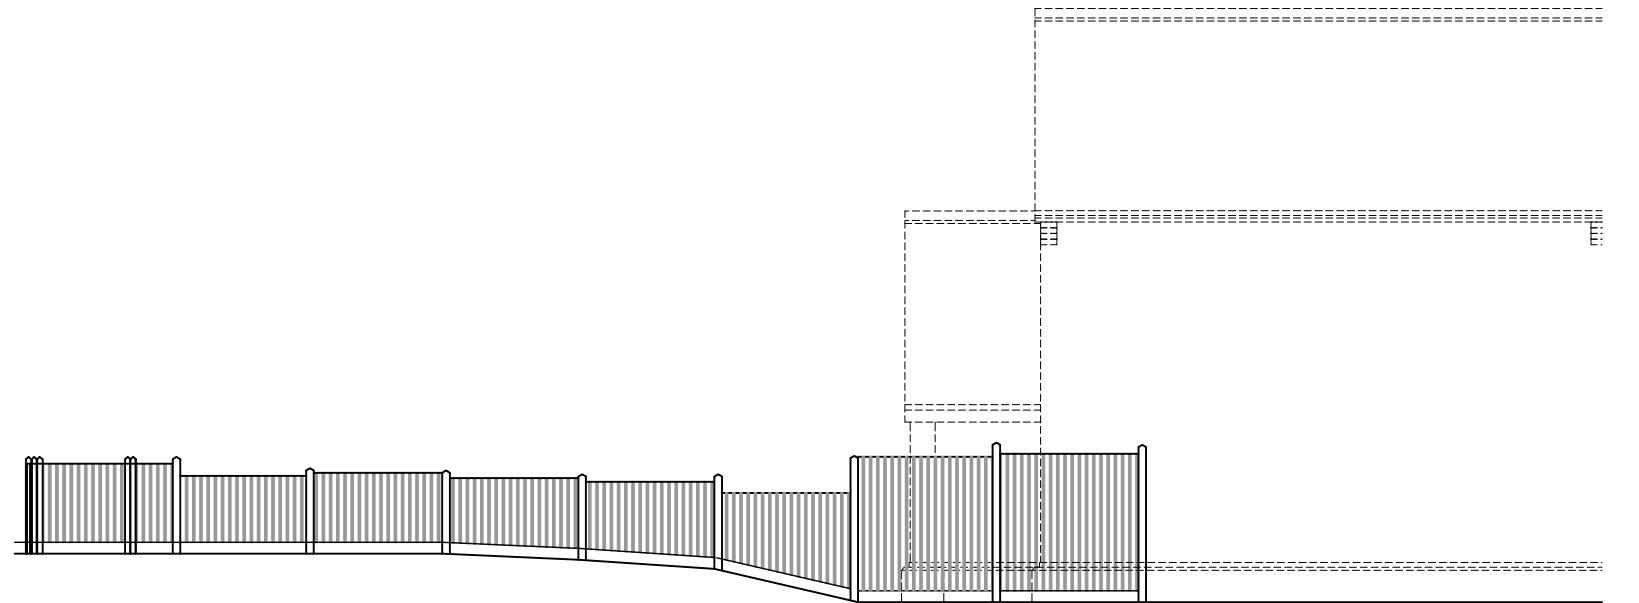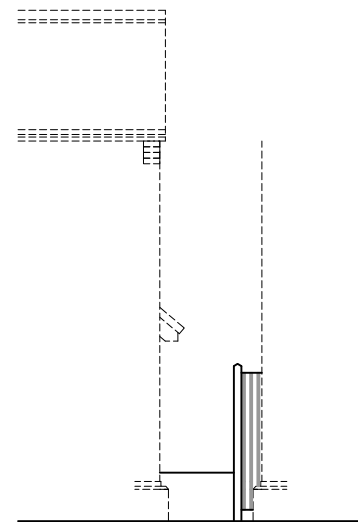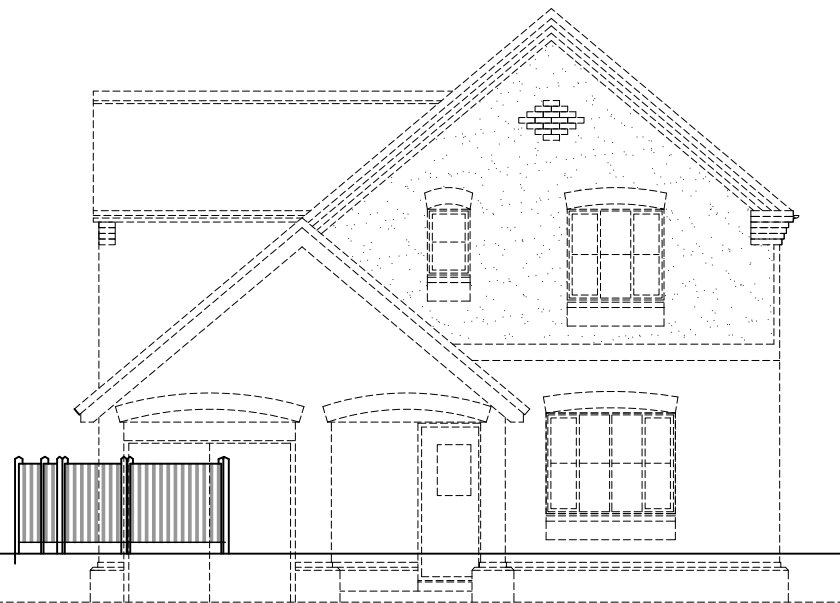

Front Elevation

No7 No6
Rear Elevation

Side Elevation

AS-BUILT ELEVATIONS

