



No.	Revision	Date
-	-	-

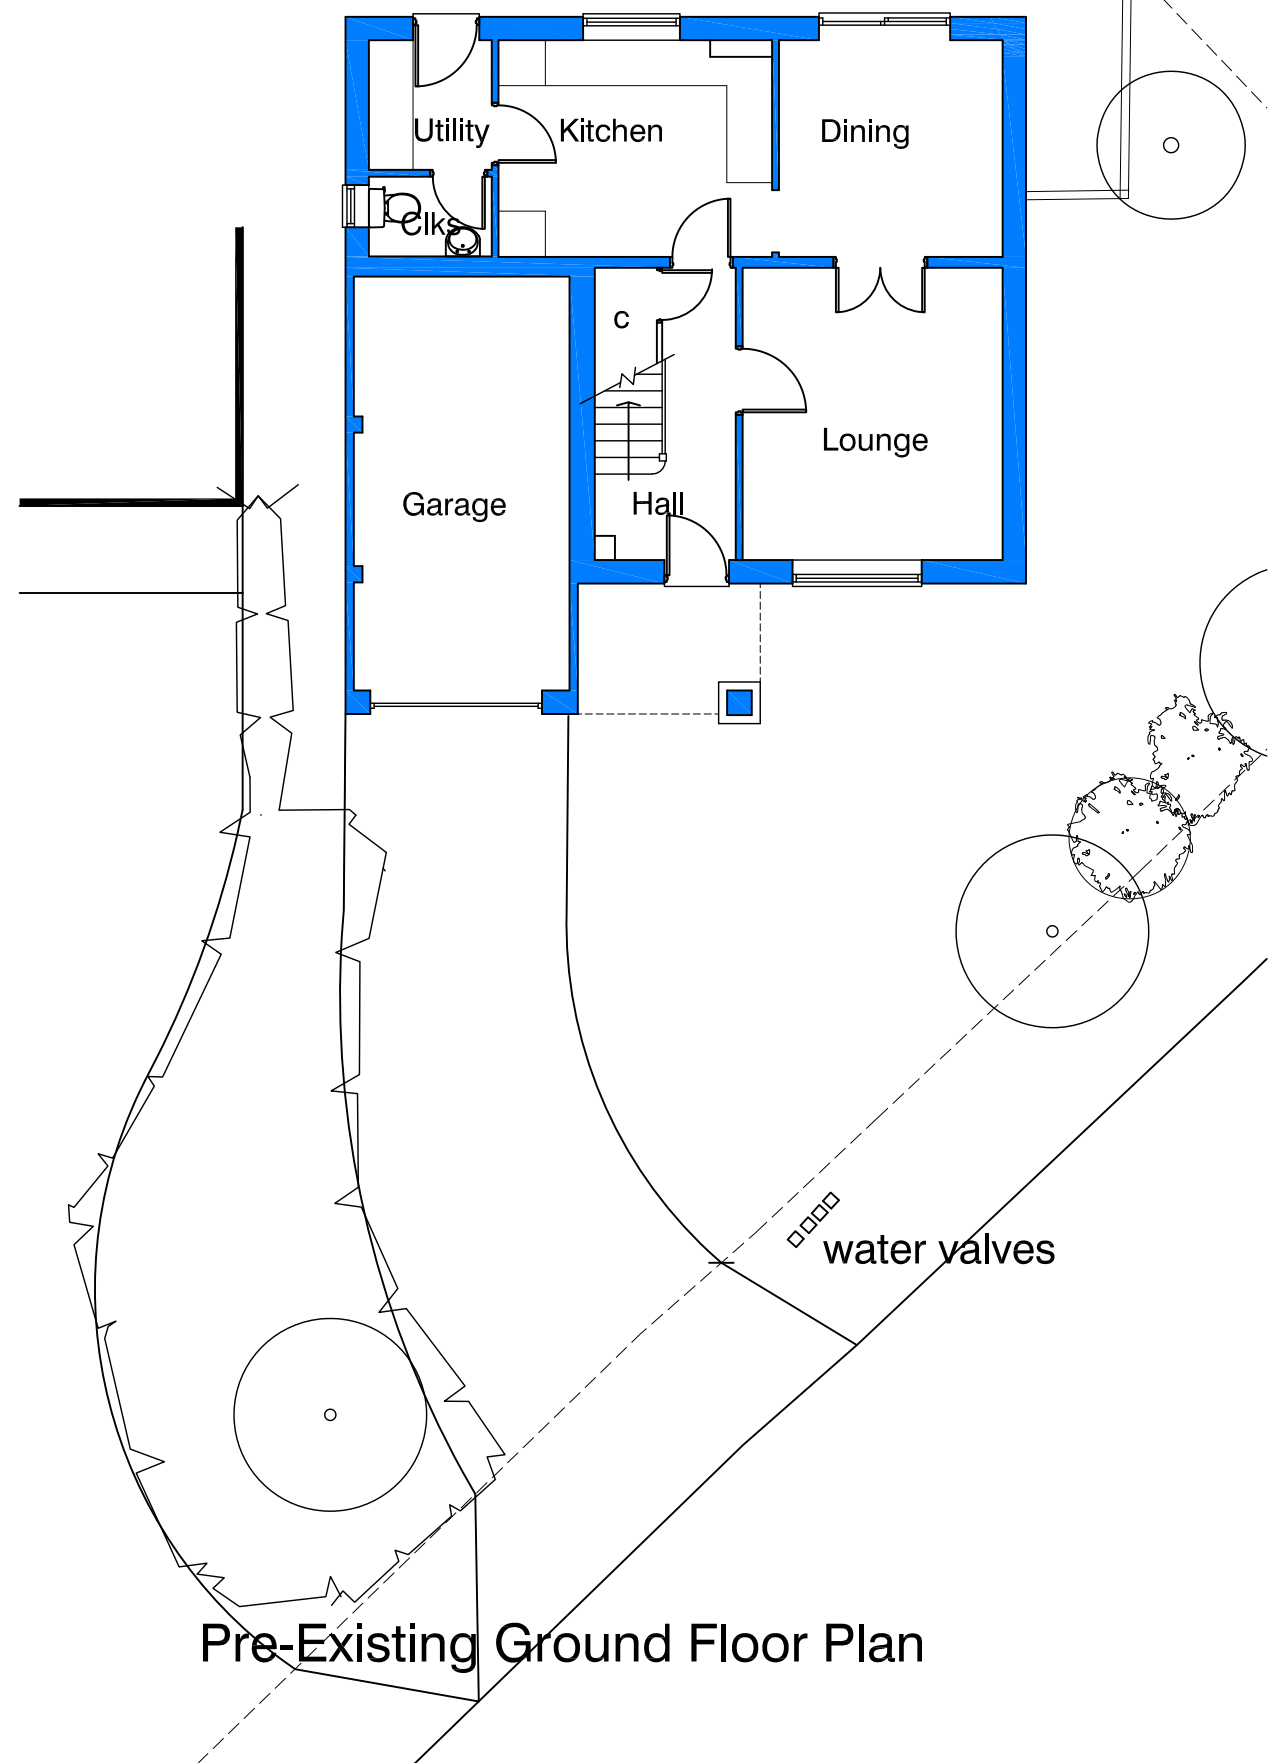

Pre-Existing Ground Floor Plan

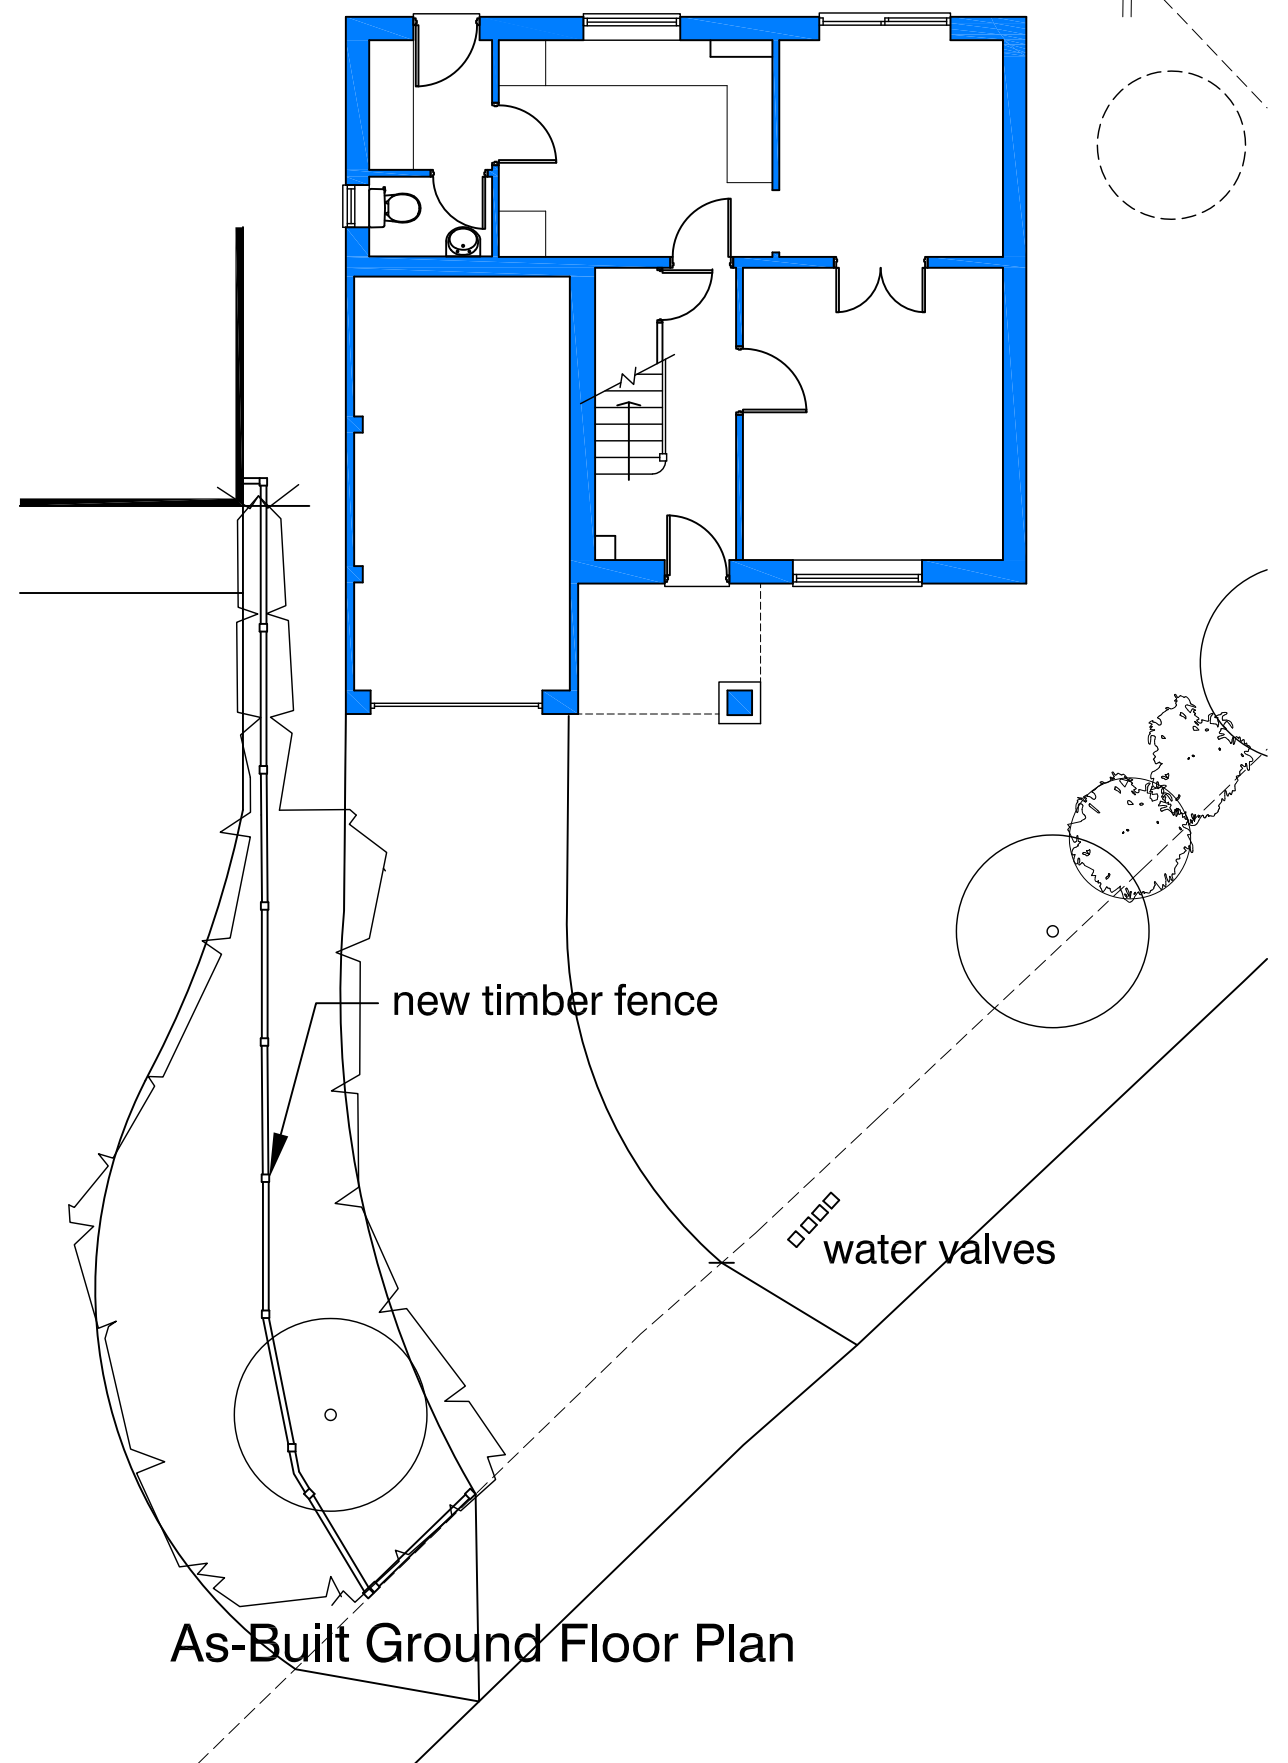

As-Built Ground Floor Plan

