


SOUTH - WEST ELEVATION

0 0.5 1 1.5
metres

1:50 @ A4 DWG No: ART52-211201-2 REV: -
ARTIFEX 360

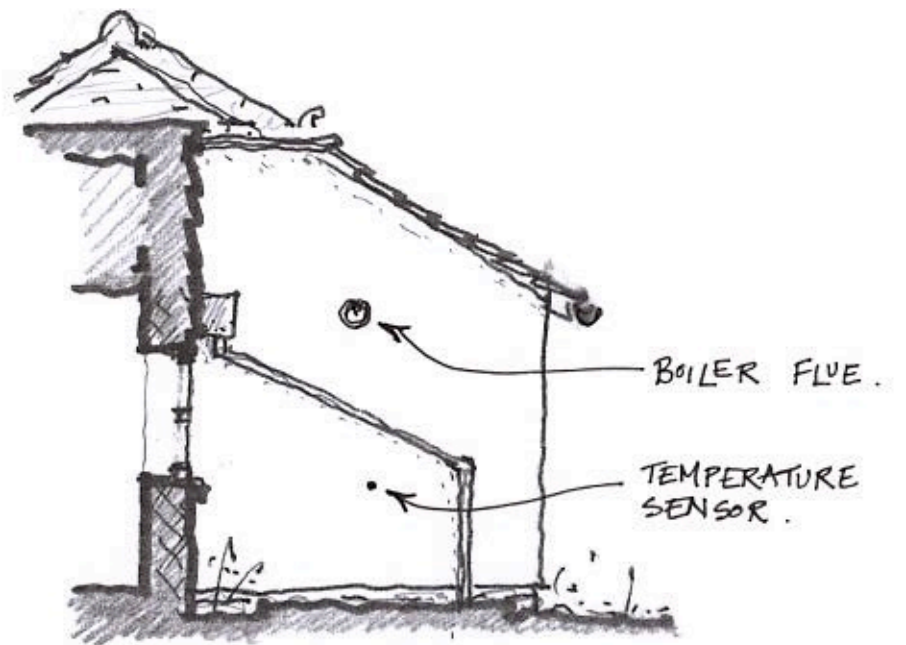

NORTH - WEST ELEVATION

OLD POST: AS INSTALLED