


This drawing is protected under Copyright and at no time must any portion of this drawing be reproduced or copied in anyway without the permission of Morgan Lovell.
 All dimensions must be checked on site, do not scale, other than for planning purposes.

SUBJECT TO SITE SURVEY
 CHECK SURVEY UNDERTAKEN ONLY
 BUILDING PARAMETERS TAKEN FROM DRAWINGS PROVIDED
 BUILDING PARAMETERS TAKEN FROM AS BUILT DRAWINGS PROVIDED

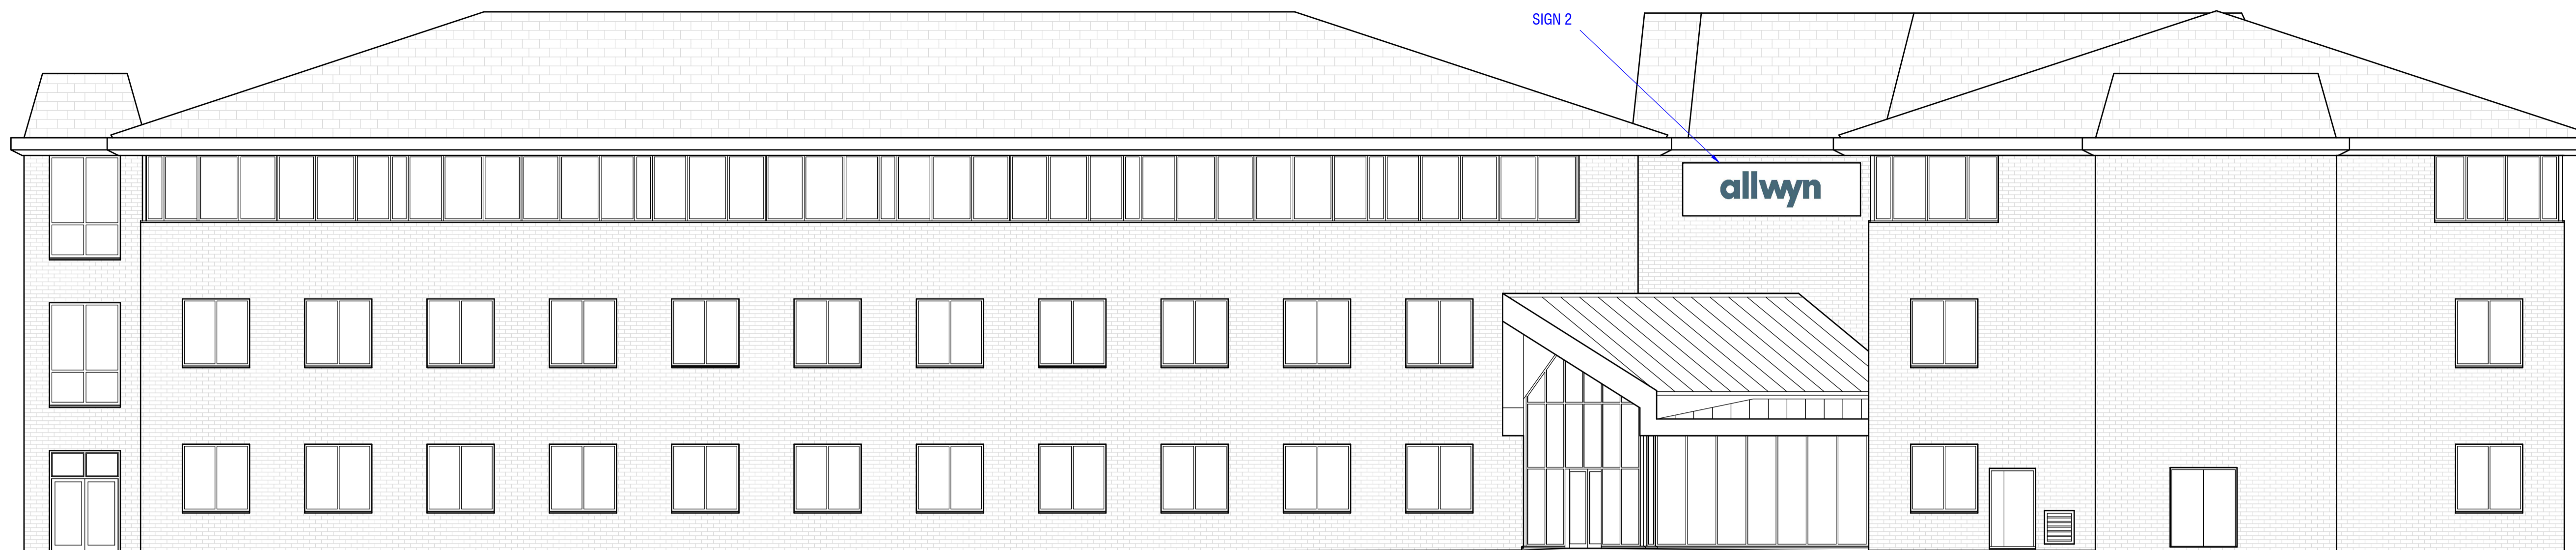


MAGDALEN HOUSE - NORTH ELEVATION

REPLACEMENT SIGNAGE DETAILS:

SIGN BOARDS SIZE TO MATCH EXISTING:
 2 X 5600mm WIDE x 1400mm HIGH x 25mm DEEP PPC ALUMINIUM IN WHITE, 8.8M FROM GROUND LEVEL.

'allwyn' BOX LETTERING PPC ALUMINIUM IN BLUE, 50mm DEEP, MAXIMUM HEIGHT 940mm.

MAX PROJECTION FROM BUILDING 75mm.

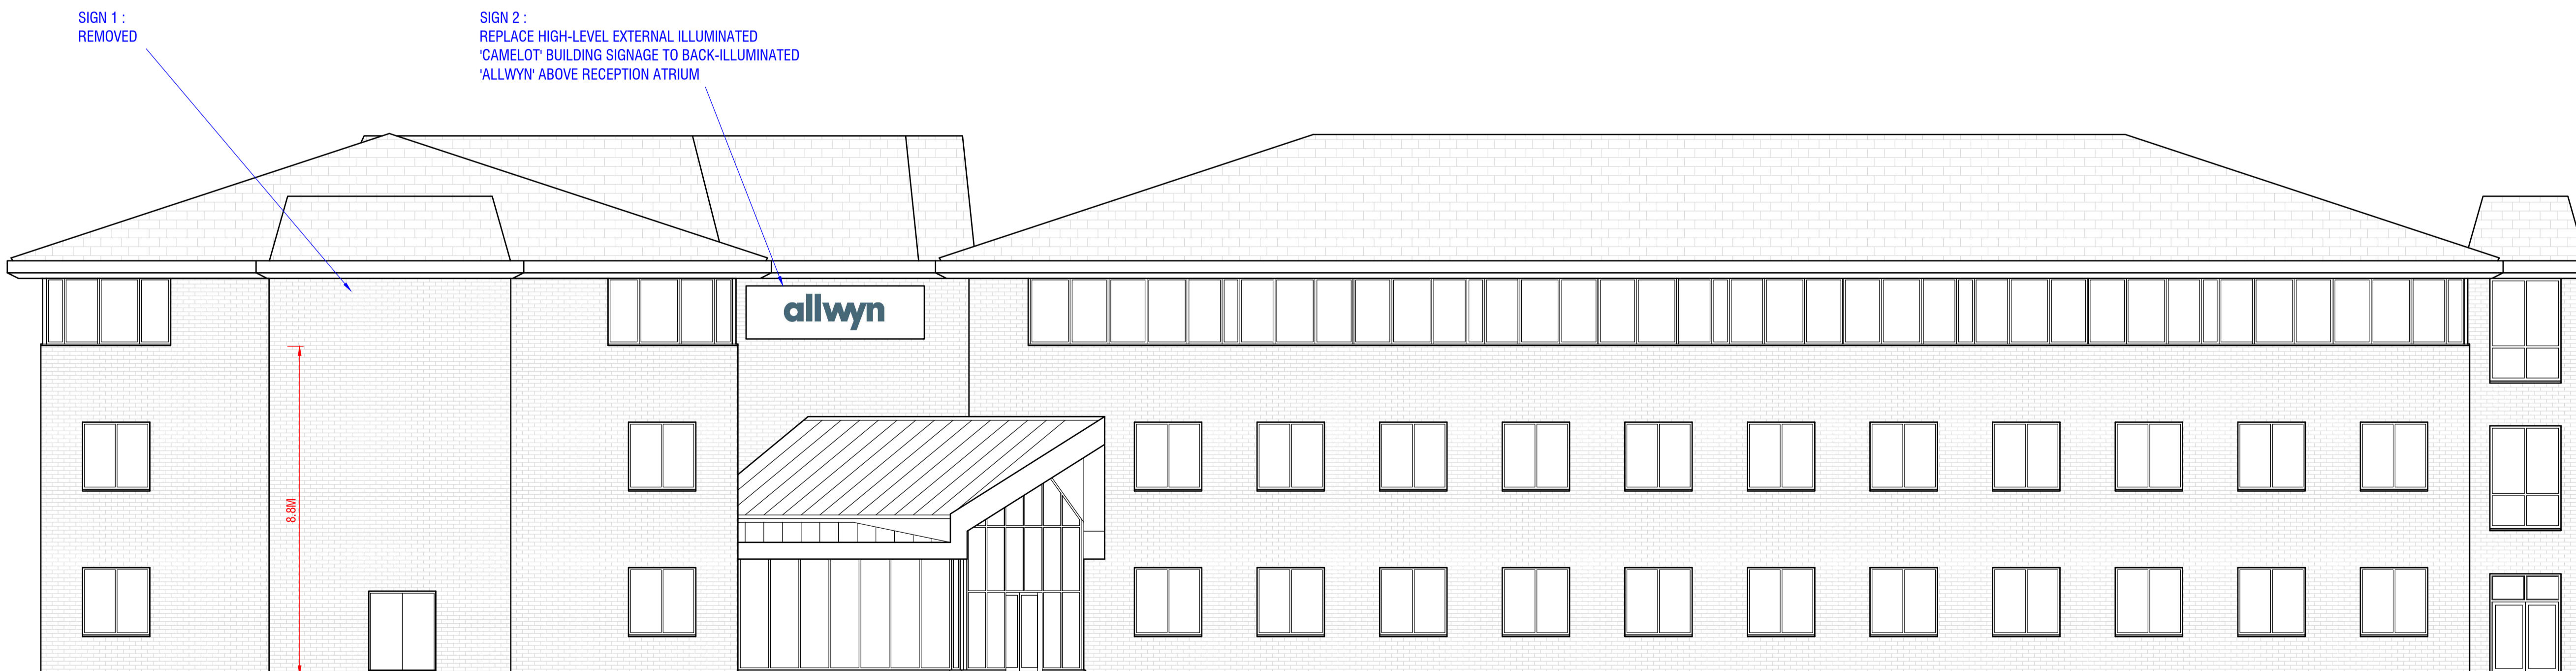

MAGDALEN HOUSE - EAST ELEVATION

PLANNING

Morgan Lovell

MAXIS 1 Western Road Bracknell Berkshire RG12 1RT
 T: 0134 435 3800 E: contact@morganlovell.com
 W: http://www.morganlovell.com

Client
ALLWYN

Project
 AVALON HOUSE,
 MAGDALEN HOUSE &
 MOOR BUILDING

Title
**MAGDALEN HOUSE - REBRANDING
 PROPOSED EXTERNAL ELEVATIONS**

Scale	Date	Designer/Drawn By	Checked By / Date
1:100 @ A1	14.07.23	AN / DL	AN

Drawing Number			
Project No.	Floor	Drawing No.	Rev
MAxxxx	00	ELE-PR	A

