

**DISCLAIMER NOTES:**

- THIS DOCUMENT IS COPYRIGHT OF THE ORIGINATOR AND MUST BE TREATED AS CONFIDENTIAL
- THIS DOCUMENT MUST NOT BE ALTERED, REPRODUCED OR DISTRIBUTED WITHOUT PRIOR WRITTEN CONSENT OF THE ORIGINATOR
- THIS DOCUMENT MUST NOT BE ALTERED - THE ORIGINATOR ACCEPTS NO RESPONSIBILITY FOR ANY DISCREPANCIES ARISING AS A RESULT OF THE ORIGINATOR'S INFORMATION BEING ALTERED BY OTHERS
- ANY DISCREPANCY MUST BE REPORTED TO THE ORIGINATOR
- DO NOT SCALE THIS DOCUMENT - USE FIGURED DIMENSIONS ONLY
- ALL DIMENSIONS MUST BE CHECKED ON SITE PRIOR TO COMMENCEMENT OF ANY RELATED WORKS
- THIS DOCUMENT MUST BE READ IN CONJUNCTION WITH ALL SUPPORTING DOCUMENTS PRODUCED BY THE ORIGINATOR AND OTHER PROJECT DISCIPLINES
- THE ORIGINATOR ACCEPTS NO RESPONSIBILITY FOR THE ACCURACY OF BACKGROUND INFORMATION PRODUCED BY THIRD PARTIES - THIS MUST BE TREATED AS INDICATIVE ONLY
- USERS OF THIS DOCUMENT ARE RESPONSIBLE FOR CHECKING WHICH REVISION IS CURRENT
- THE DOCUMENT STATUS "INFORMATION" OR "PRELIMINARY" INDICATES THAT THIS DRAWING IS FOR REFERENCE PURPOSES ONLY - THE ORIGINATOR WILL ACCEPT NO RESPONSIBILITY FOR THE COMPLETENESS OF INFORMATION UNDER THIS STATUS
- THE DOCUMENT STATUS "RECORD" OR "AS BUILT" HAS BEEN PREPARED IN PART, BASED UPON INFORMATION FURNISHED BY OTHERS, WHILE THIS INFORMATION IS BELIEVED TO BE RELIABLE, THE ORIGINATOR ASSUMES NO RESPONSIBILITY FOR THE ACCURACY OF THIS "RECORD" OR "AS BUILT" DOCUMENT OR FOR ANY ERRORS OR OMISSIONS THAT MAY HAVE BEEN INCORPORATED INTO IT AS A RESULT OF INCORRECT INFORMATION PROVIDED TO THE ORIGINATOR. THOSE RELYING ON THE "RECORD" OR "AS BUILT" DOCUMENT ARE ADVISED TO OBTAIN INDEPENDENT VERIFICATION OF ITS ACCURACY

**DRAWING NOTES:**

CDM REGULATIONS 2015  
SIGNIFICANT OR NON-OBVIOUS RISKS AND RISKS WHICH ARE DIFFICULT TO MANAGE ARE IDENTIFIED ON THIS DRAWING USING THE FOLLOWING SYMBOL, IDENTIFIED TO THE RIGHT WITH BRIEF ACCOMPANYING TEXT. FOR FURTHER DETAILS OF THE RISKS IDENTIFIED BY DESIGNERS, REFERENCE SHOULD BE MADE TO CDM HAZARD REGISTER.

**KEY**

- BRITISH TELECOM
- ELECTRICAL
- UNIDENTIFIED
- VIRGIN MEDIA
- GPR - UNIDENTIFIED
- GAS
- WATER MAIN

**ADOPTABLE SURFACING KEY**




- ADOPTED ACCESS ROAD**
- 40mm THK CLOSE GRADED SURFACE COURSE WITH 10mm AGGREGATE: AC 10 CLOSE SURF 100/150 HS (EXCLUDING LIMESTONE)
  - 60mm THICK DENSE BINDER COURSE WITH 20mm AGGREGATE: AC 20 DENSE BIN 100/150 REC BS EN 13108-1
  - 100mm THICK DENSE, HEAVY DUTY BASE COURSE WITH 32mm AGGREGATE: AC 32 DENSE BASE 100/150 REC BS EN 13108-1
  - 150mm THK TYPE 1 GRANULAR SUB BASE MATERIAL TO CLAUSE 803 OF THE SPECIFICATION FOR HIGHWAY WORKS.
  - 250mm THK 6F2 ON GROUND WITH CBR OF 5%. MIN CBR OF 30% MUST BE ACHIEVED AT TOP OF SUB BASE AT EACH LOCATION TESTED.

- ADOPTED TARMAC FOOTPATH / SERVICE STRIP**
- 20mm CLOSE GRADED SURFACE COURSE WITH 6mm AGGREGATE: AC 6 DENSE SURF 100/150 HS EN 13108-1 (EXCLUDING LIMESTONE)
  - 60mm THICK DENSE BINDER COURSE WITH 20mm AGGREGATE: AC 20 DENSE BIN 100/150 REC BS EN 13108-1
  - 150mm THK TYPE 1 GRANULAR SUB BASE MATERIAL TO CLAUSE 803 OF THE SPECIFICATION

**KERBING KEY**

- 125mm UPSTAND KERB
- TRANSITION KERB
- DROPPED CROSSING, 6mm AT PEDESTRIAN & 25mm AT VEHICULAR CROSSINGS
- PIN KERB
- EXISTING RETAINED GULLY POSITIONS
- TACTILE BLOCK PAVING - UNCONTROLLED TACTILE CROSSING (BUFF).

CLEAN AND PROVE ALL EXISTING GULLY POTS AND CONNECTIONS. GULLY'S TO BE INSPECTED WHEN SURFACING COMPLETE

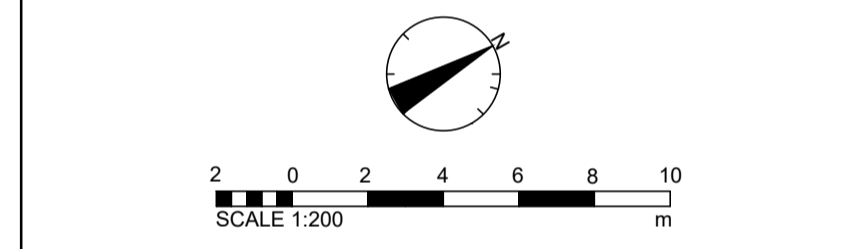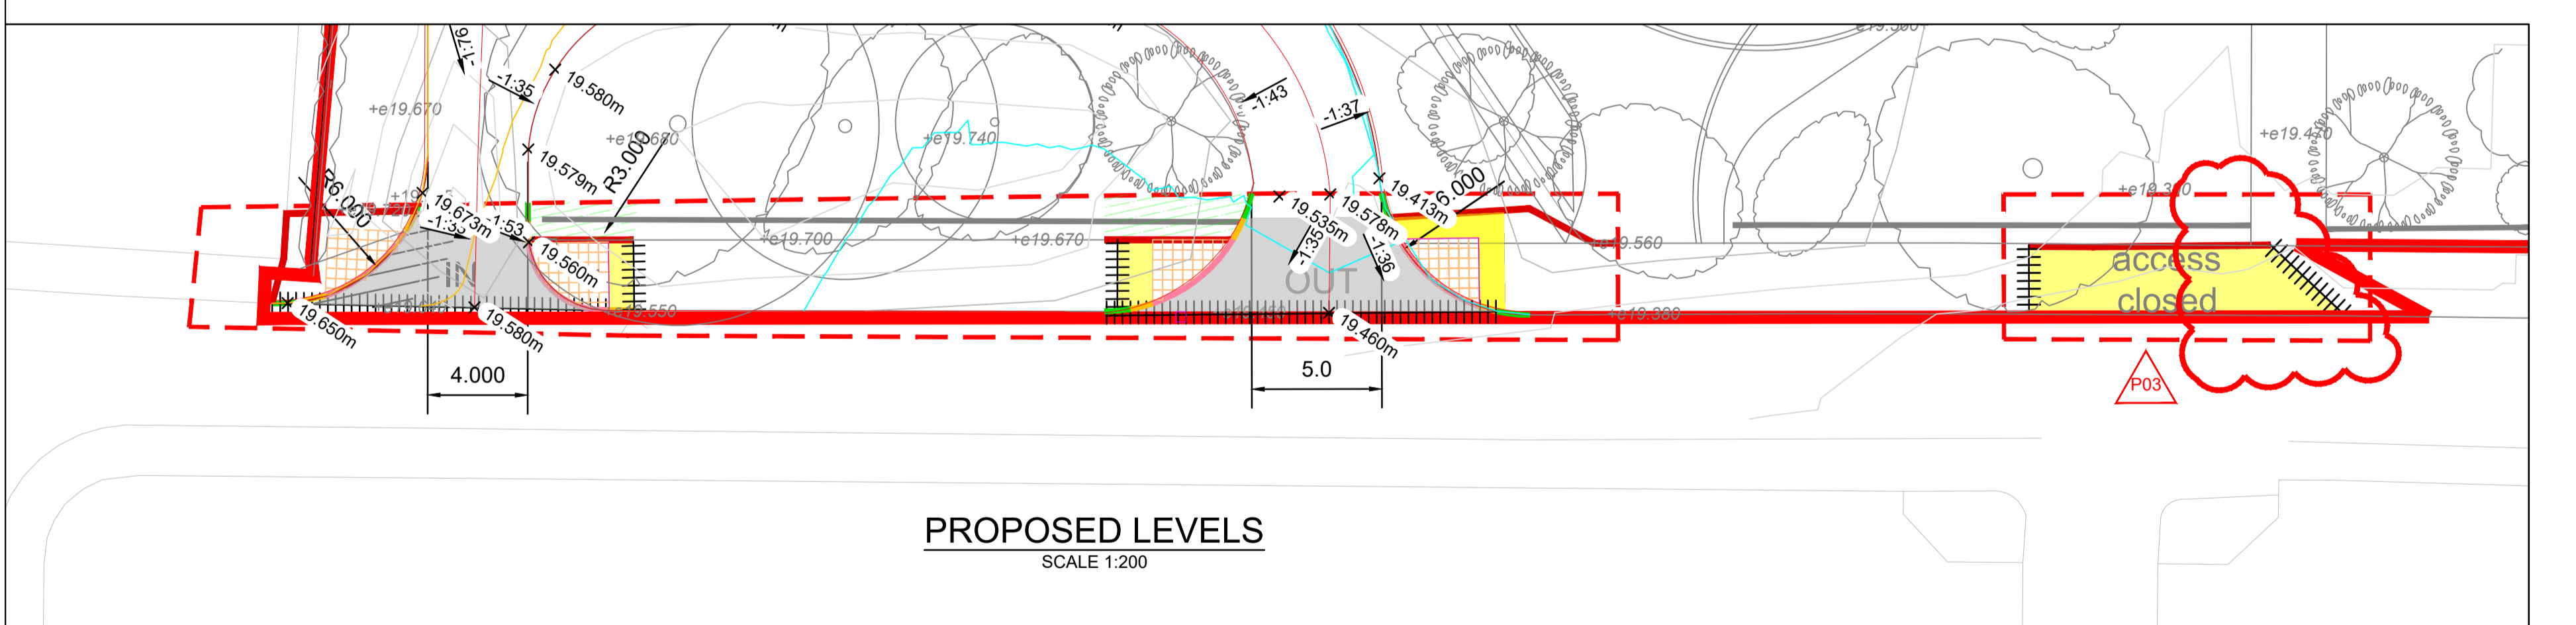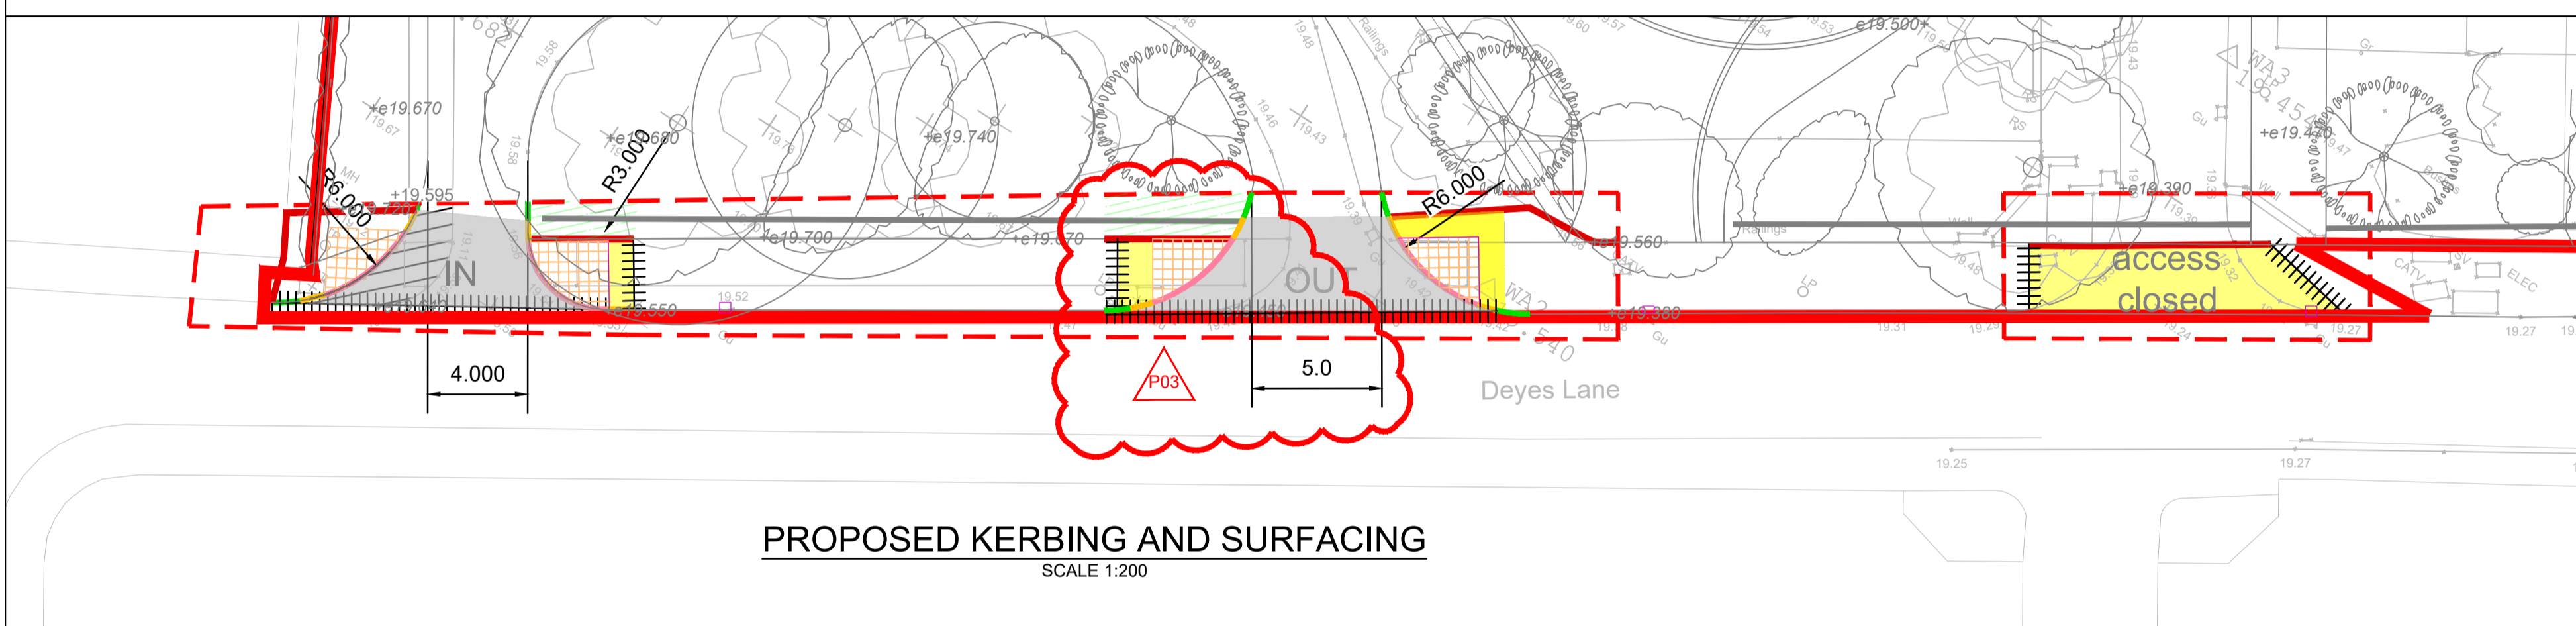

| REV | DESCRIPTION   | DATE     | BY | CHKD |
|-----|---|----------|----|------|
| P03 | PROPOSED KERBLINE UPDATED - EXISTING KERBLINE REMOVED FROM BACKGROUND | 29.06.22 | JF | WF   |
| P02 | PRELIMINARY   | 27.06.22 | JF | WF   |
| P01 | PRELIMINARY   | 22.04.22 | JF | WF   |

ORIGINATOR:

5TH FLOOR  
BELVEDERE HOUSE  
12 BOOTH STREET  
MANCHESTER, M2 4AW

TEL: 0161 833 9579  
WWW.RIDGE.CO.UK

CLIENT:  
**KIER CONSTRUCTION**

IN ASSOCIATION WITH:  
**EDUCATION FUNDING AGENCY**

PROJECT:  
**DEYES HIGH SCHOOL  
LIVERPOOL**

TITLE:  
**S278  
HIGHWAYS WORKS  
GENERAL ARRANGEMENTS**

|           |      |       |               |          |      |
|-----------|------|-------|---------------|----------|------|
| ENG/TECH: | CSE: | ICSE: | SCALE:        | AS NOTED | @ A1 |
| JF        | WF   | WF    | STATUS ISSUE: | S2       |      |

STATUS:  
**PRELIMINARY**

\*\*UNLESS ISSUED FOR CONSTRUCTION - WORKS AT CLIENT/CONTRACTORS RISK\*\*

|              |                            |       |        |       |       |         |      |
|--------------|----------------------------|-------|--------|-------|-------|---------|------|
| SUITABILITY: | S0 - Initial Status or WIP |       |        |       |       |         |      |
| PROJECT:     | ORG:                       | ZONE: | LEVEL: | TYPE: | ROLE: | NUMBER: | REV: |
| 5016885      | RDG                        | XX    | XX     | DR    | C     | 0602    | P03  |