


NOTE:
GREY LINES INDICATE APPROVED LANDLORD STRIP OUT & DEMO WORKS
RED LINES INDICATE ADDITIONAL WORKS REQUESTED BY FETTL

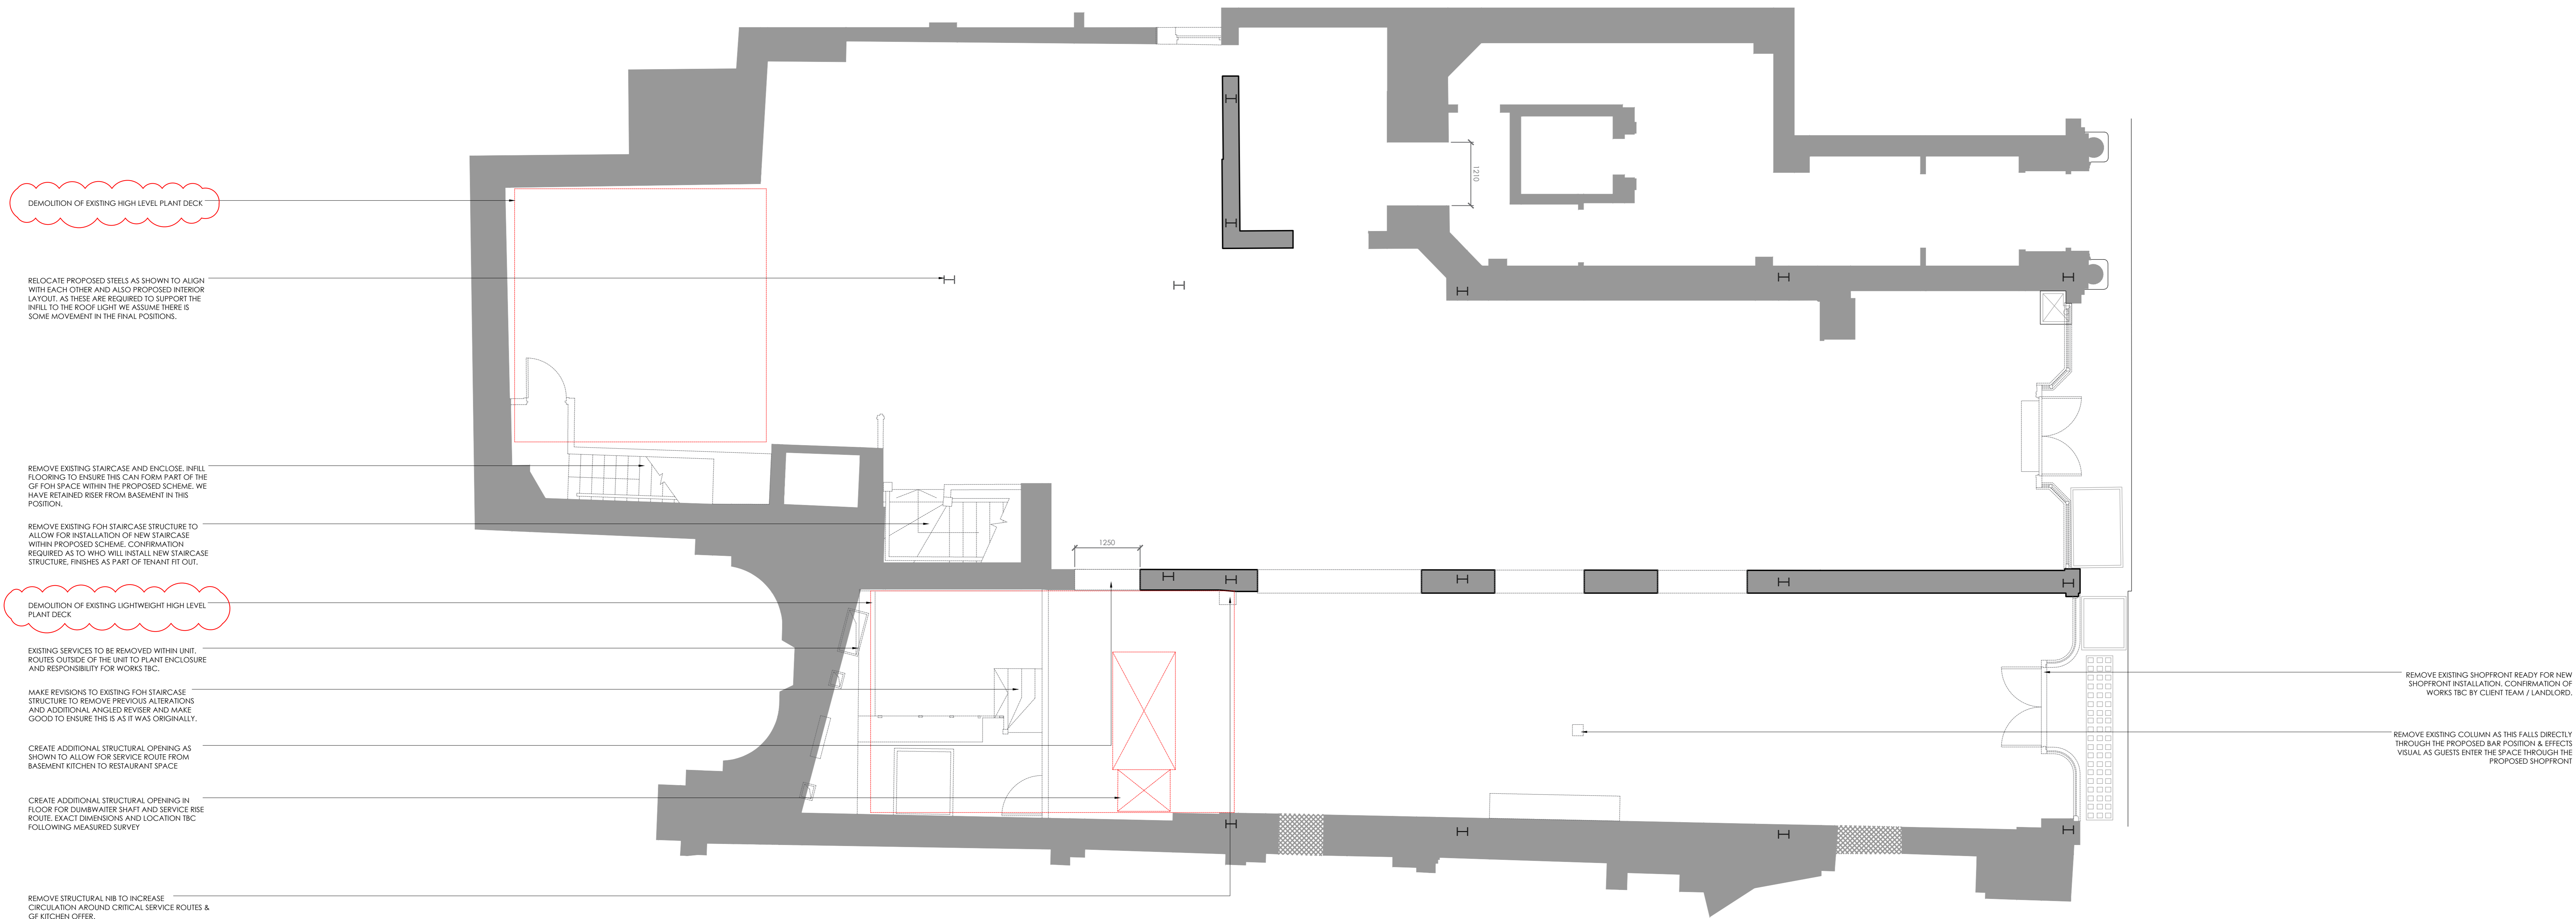

01 PROPOSED GROUND FLOOR - DEMOLITION / LANDLORD PLAN
 1:50 @A0



PLANNING

NOTES © 2023 FETTL DESIGN LTD

1. THE DRAWINGS SHOW DESIGN INTENT ONLY. ALL DIMENSIONS TO BE CHECKED ON-SITE PRIOR TO CONSTRUCTION OR PRODUCTION. CONSTRUCTION DETAILS TO BE CONFIRMED BY CONTRACTOR/MANUFACTURER BY SUBMITTING SHOP DRAWINGS FOR DESIGNER'S APPROVAL.
2. DESIGN/DRAWING IS NOT TO BE SCALED FOR PRODUCTION AND CONSTRUCTION PURPOSES.
3. ALL DISCREPANCIES AND OMISSIONS ON-SITE MUST BE REPORTED TO DESIGNER FOR COMMENTS OR APPROVAL PRIOR TO COMMENCING WORK.
4. ALL ELECTRICAL, LIGHTING, HVAC AND PLUMBING ISSUES TO BE REFERRED TO ENGINEER'S DRAWINGS PRIOR TO COMMENCEMENT OF WORKS.
5. THE DESIGN ARE SUBJECT TO APPROVAL BY STATUTORY AUTHORITIES AND ANY NECESSARY ALTERATIONS SHOULD BE MADE IF REQUIRED TO COMPLY WITH STATUTORY REQUIREMENTS.
6. ALL DESIGN CONCEPTS AND DRAWINGS ARE THE PROPERTY OF FETTL DESIGN LTD AND ARE COVERED BY COPYRIGHT. NO REPRODUCTIONS, ADAPTATIONS AND/OR COPIES MAY BE MADE WITHOUT WRITTEN PERMISSION OF FETTL DESIGN LTD.

CLIENT
HARNBURY HOLDINGS

PROJECT
CICCHETTI, PICCADILLY

TITLE
**GROUND FLOOR
 DEMOLITION / LANDLORD PLAN**

FIRST ISSUE	SCALE	SHEET SIZE
13/11/2023	1:50	A0

DRAWING NO.	REV.
22117-FO-401	A