

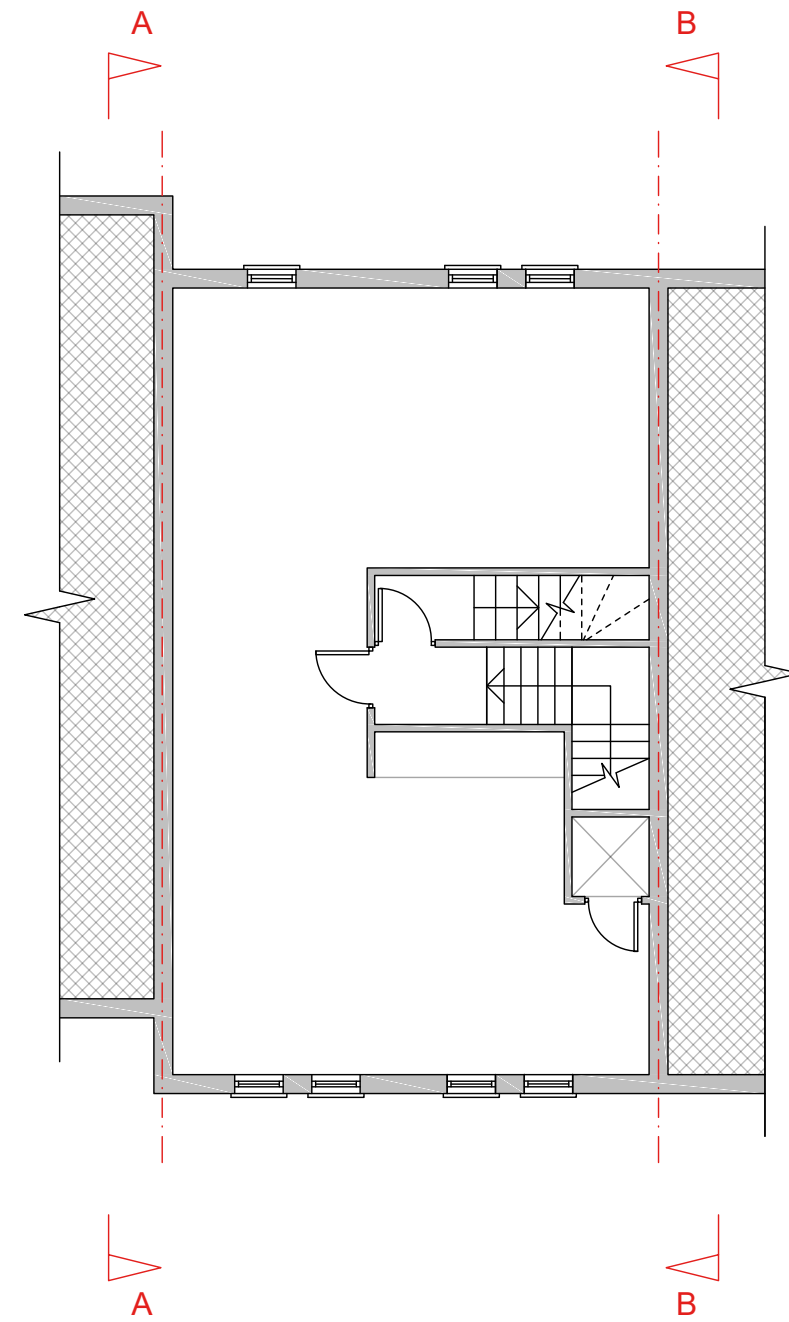
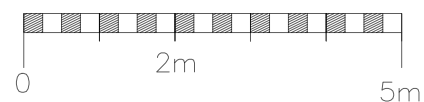


GROUND FLOOR PLAN

AS BUILT
11a BEAUMONT GATE

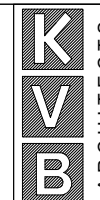


FIRST FLOOR PLAN

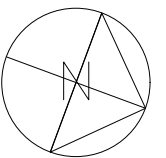

K V B Architects Ltd
Chartered Architects
9 High Street
Tring, Herts
HP23 5AH
Tel: +44 (0)1442 824691
Email: greg@kvbarchitects.co.uk
www.kvbarchitects.co.uk

CLIENT
St Albans City Football Club
PROJECT
**11a Beaumont Gate, Shenley Hill, Radlett,
WD7 7AR**
TITLE
As Built Drawings



SCALE 1:100 @ A3	DATE 29.11.23
DRAWN OE	CHECKED
DRAWING NO.	102
JOB NO.	REVISION

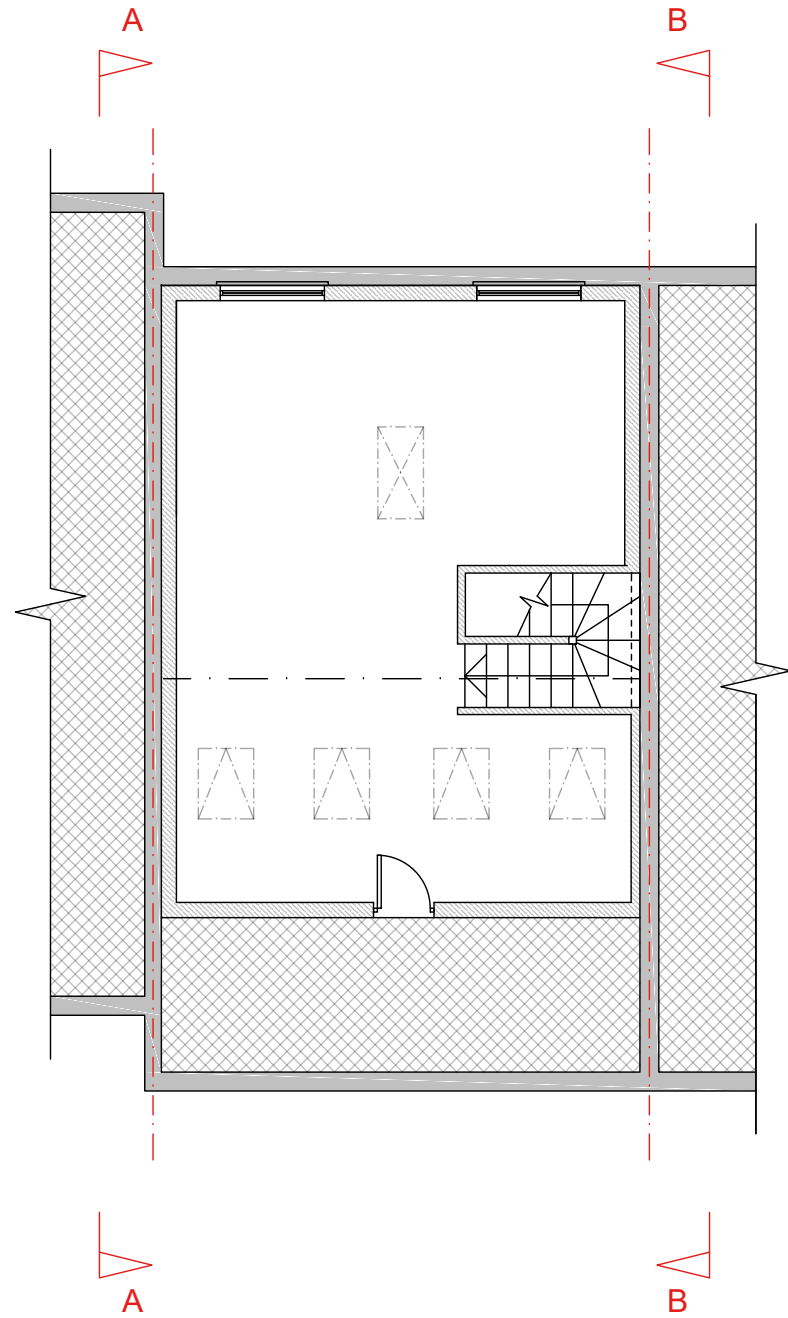



LOFT PLAN

AS BUILT

11a BEAUMONT GATE

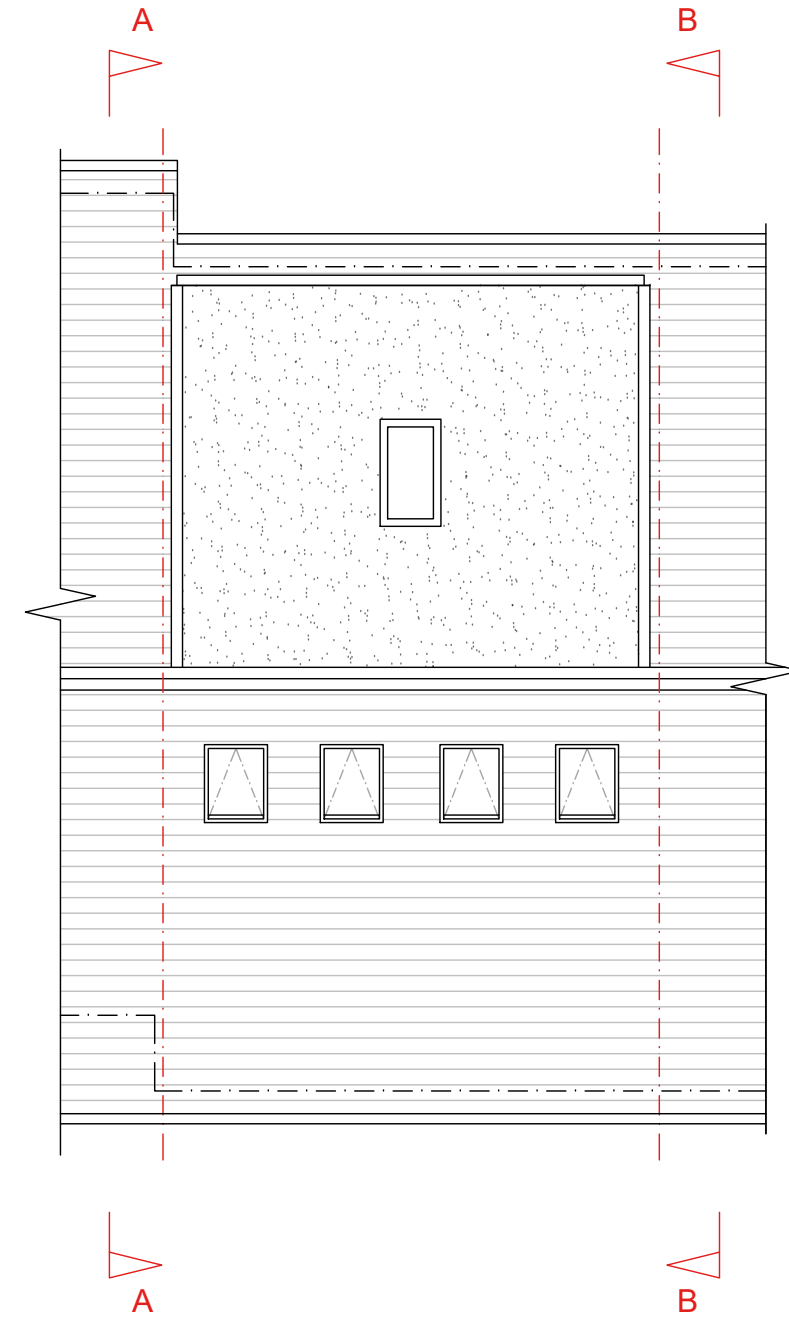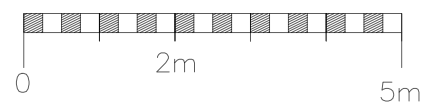

ROOF PLAN

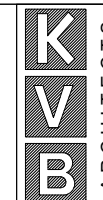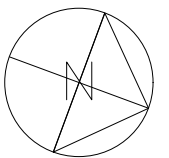

K V B Architects Ltd
Chartered Architects
9 High Street
Tring, Herts
HP23 5AH
Tel: +44 (0)1442 824691
Email: greg@kvbarchitects.co.uk
www.kvbarchitects.co.uk

CLIENT
St Albans City Football Club

PROJECT
11a Beaumont Gate, Shenley Hill, Radlett, WD7 7AR



TITLE
As Built Drawings

SCALE 1:100 @ A3	DATE 29.11.23
DRAWN OE	CHECKED
DRAWING NO.	103
JOB NO.	REVISION





FRONT ELEVATION

AS BUILT
11a BEAUMONT GATE

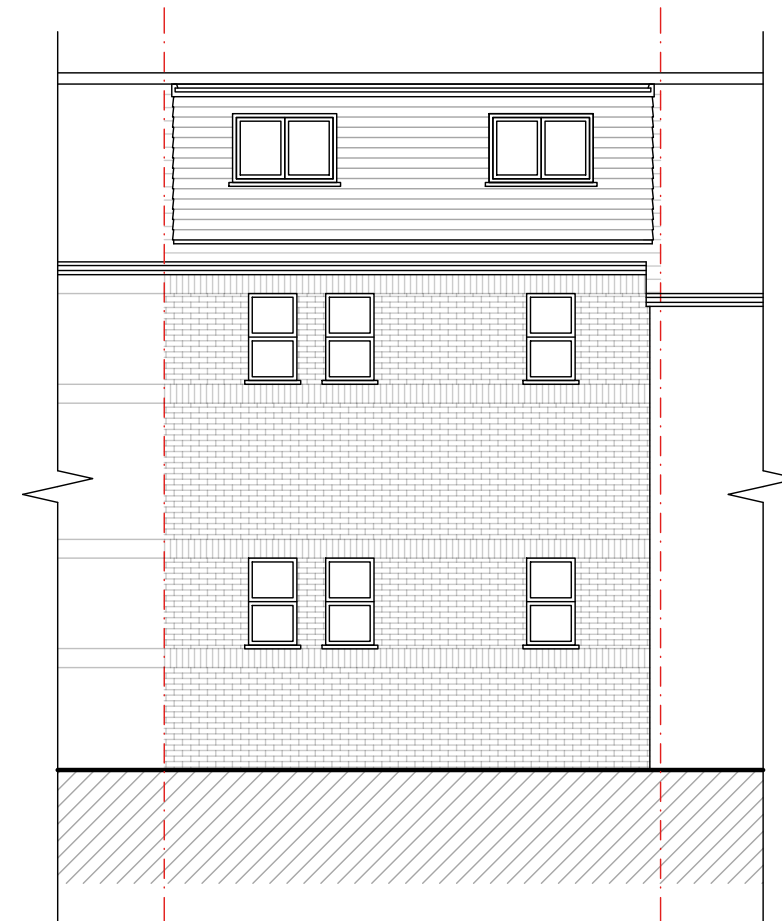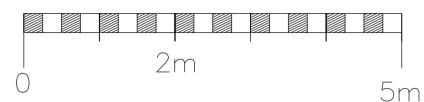


REAR ELEVATION

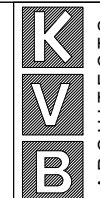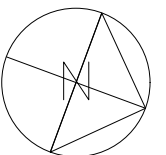


K V B Architects Ltd
Chartered Architects
9 High Street
Tring, Herts
HP23 5AH
Tel: +44 (0)1442 824691
Email: greg@kvbarchitects.co.uk
www.kvbarchitects.co.uk

CLIENT
St Albans City Football Club
PROJECT
**11a Beaumont Gate, Shenley Hill, Radlett,
WD7 7AR**
TITLE
AS Built Drawings


SCALE 1:100 @ A3	DATE 29.11.23
DRAWN OE	CHECKED
DRAWING NO.	104
JOB NO.	REVISION

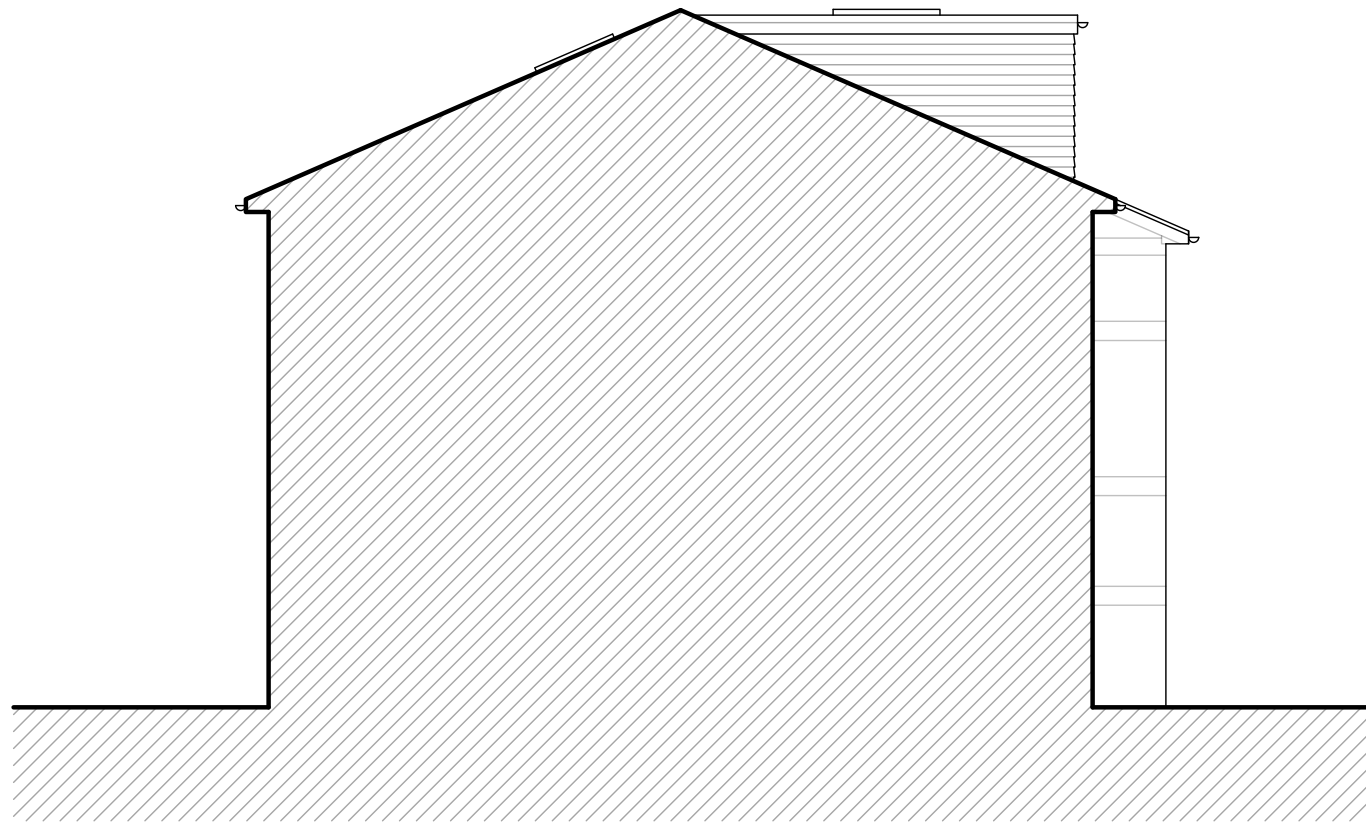


SECTION A-A

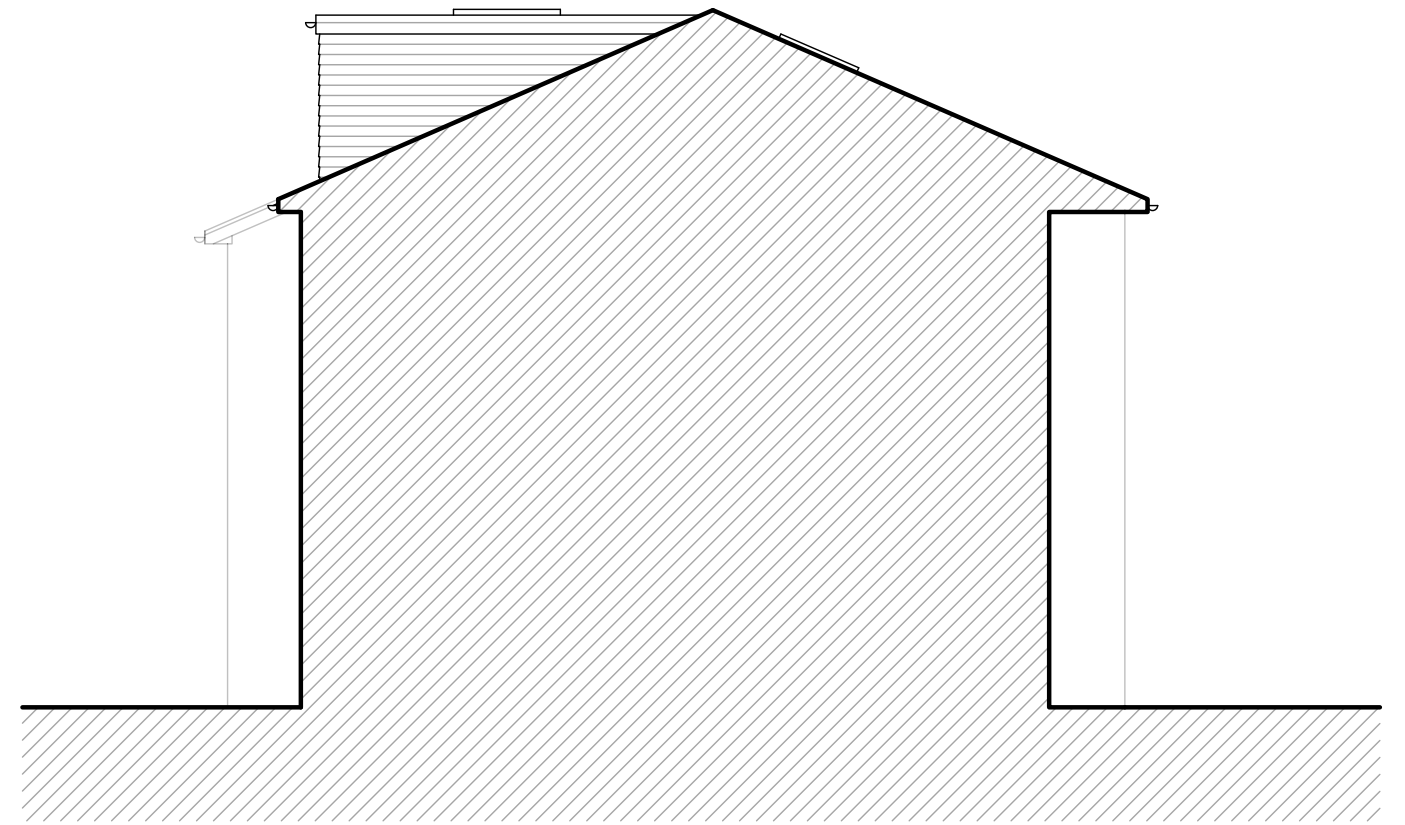

SECTION B-B

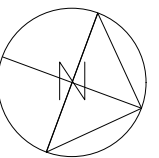


AS BUILT
11a BEAUMONT GATE

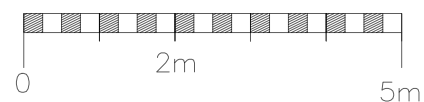



K V B Architects Ltd
Chartered Architects
9 High Street
Tring, Herts
HP23 5AH
Tel: +44 (0)1442 824691
Email: greg@kvbarchitects.co.uk
www.kvbarchitects.co.uk

CLIENT St Albans City Football Club	SCALE 1:100 @ A3	DATE 29.11.23
PROJECT 11a Beaumont Gate, Shenley Hill, Radlett, WD7 7AR	DRAWN OE	CHECKED
TITLE AS Built Drawings	DRAWING NO. 105	
	JOB NO.	REVISION


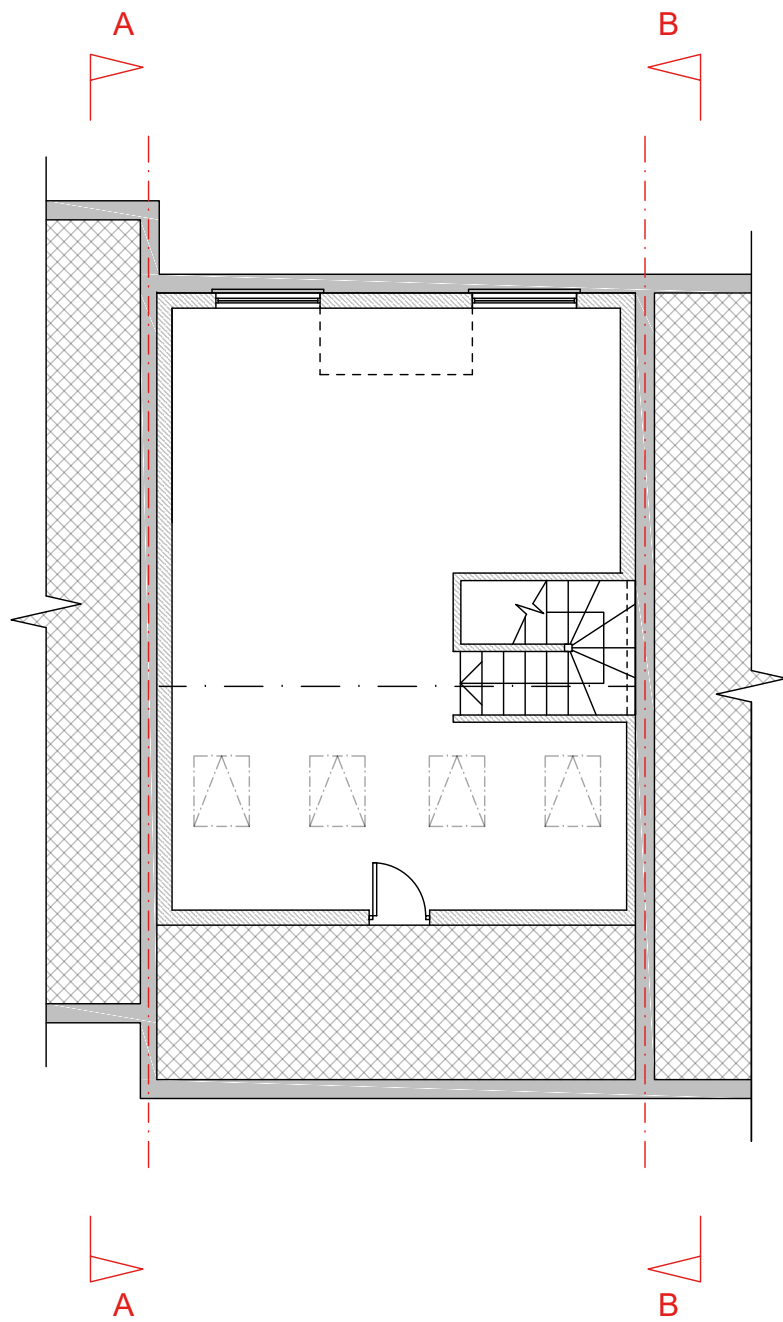


LOFT PLAN

PROPOSED 11a BEAUMONT GATE

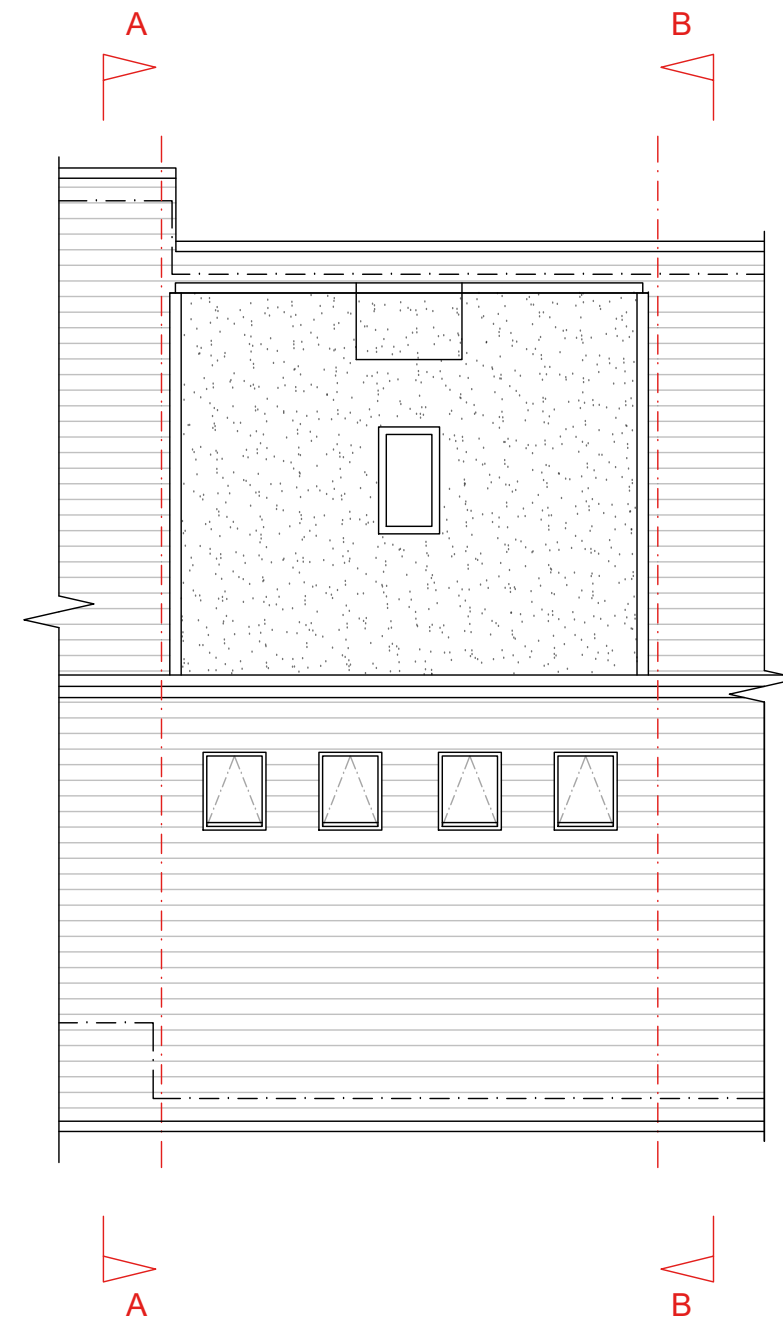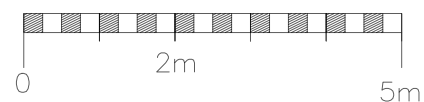

ROOF PLAN

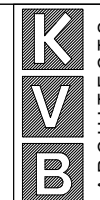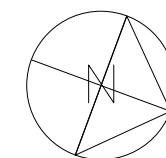

K V B Architects Ltd
Chartered Architects
9 High Street
Tring, Herts
HP23 5AH
Tel: +44 (0)1442 824691
Email: greg@kvbarchitects.co.uk
www.kvbarchitects.co.uk

CLIENT
St Albans City Football Club
PROJECT
**11a Beaumont Gate, Shenley Hill, Radlett,
WD7 7AR**
TITLE
Proposed Drawings


SCALE 1:100 @ A3	DATE 29.11.23
DRAWN OE	CHECKED
DRAWING NO.	106
JOB NO.	REVISION




FRONT ELEVATION

PROPOSED

11a BEAUMONT GATE

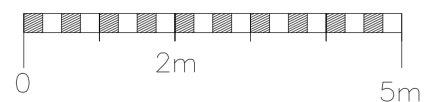

REAR ELEVATION

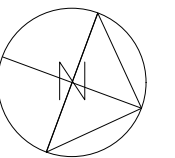

K V B Architects Ltd
Chartered Architects
9 High Street
Tring, Herts
HP23 5AH
Tel: +44 (0)1442 824691
Email: greg@kvbarchitects.co.uk
www.kvbarchitects.co.uk

CLIENT
St Albans City Football Club

PROJECT
**11a Beaumont Gate, Shenley Hill, Radlett,
WD7 7AR**

TITLE
Proposed Drawings

SCALE 1:100 @ A3	DATE 29.11.23
DRAWN OE	CHECKED
DRAWING NO.	107
JOB NO.	REVISION