

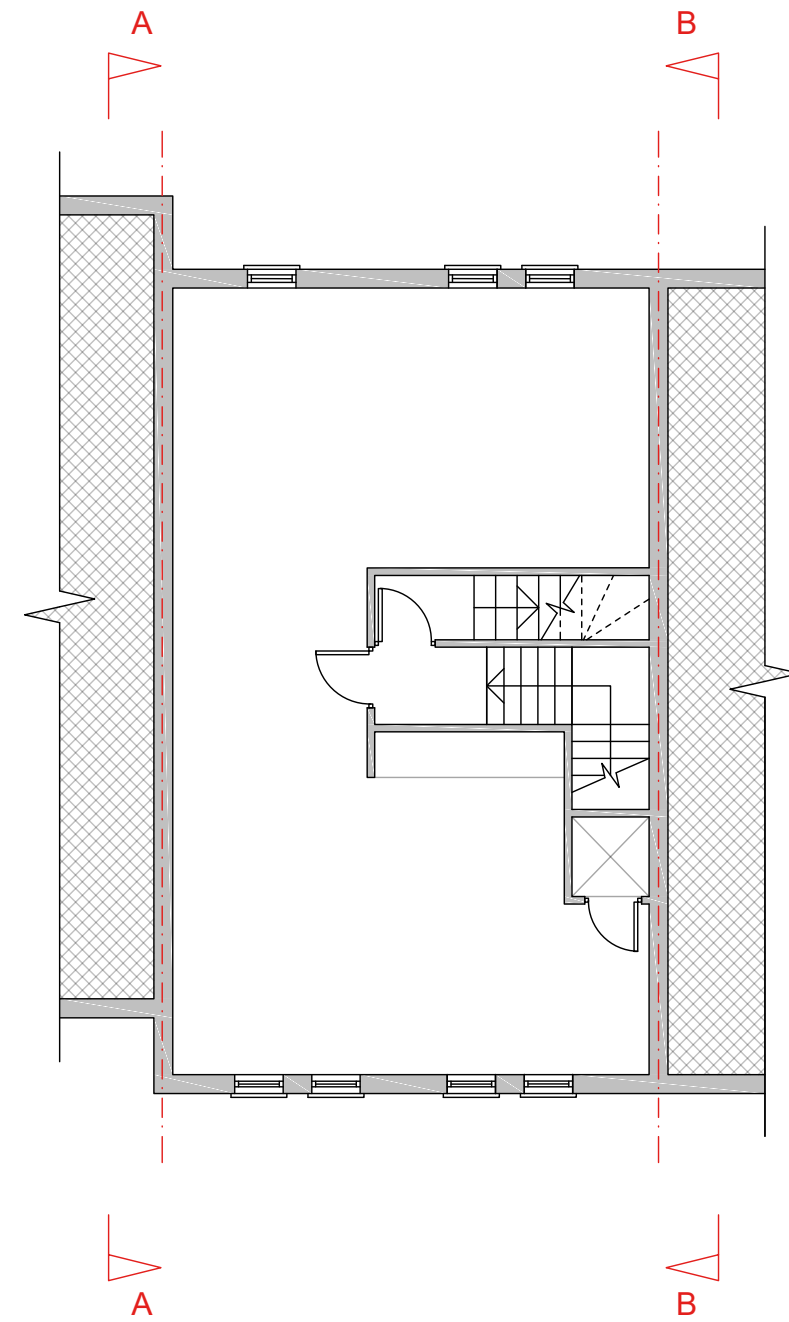
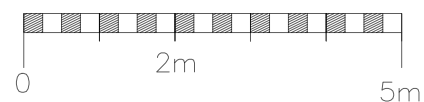


GROUND FLOOR PLAN

**AS BUILT**  
11a BEAUMONT GATE

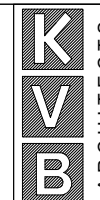

FIRST FLOOR PLAN

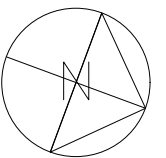


**K V B Architects Ltd**  
Chartered Architects  
9 High Street  
Tring, Herts  
HP23 5AH  
Tel: +44 (0)1442 824691  
Email: greg@kvbarchitects.co.uk  
www.kvbarchitects.co.uk

CLIENT  
**St Albans City Football Club**

PROJECT  
**11a Beaumont Gate, Shenley Hill, Radlett,  
WD7 7AR**

TITLE  
**As Built Drawings**



SCALE <b>1:100 @ A3</b>	DATE <b>29.11.23</b>
DRAWN <b>OE</b>	CHECKED
DRAWING NO.	<b>102</b>
JOB NO.	REVISION

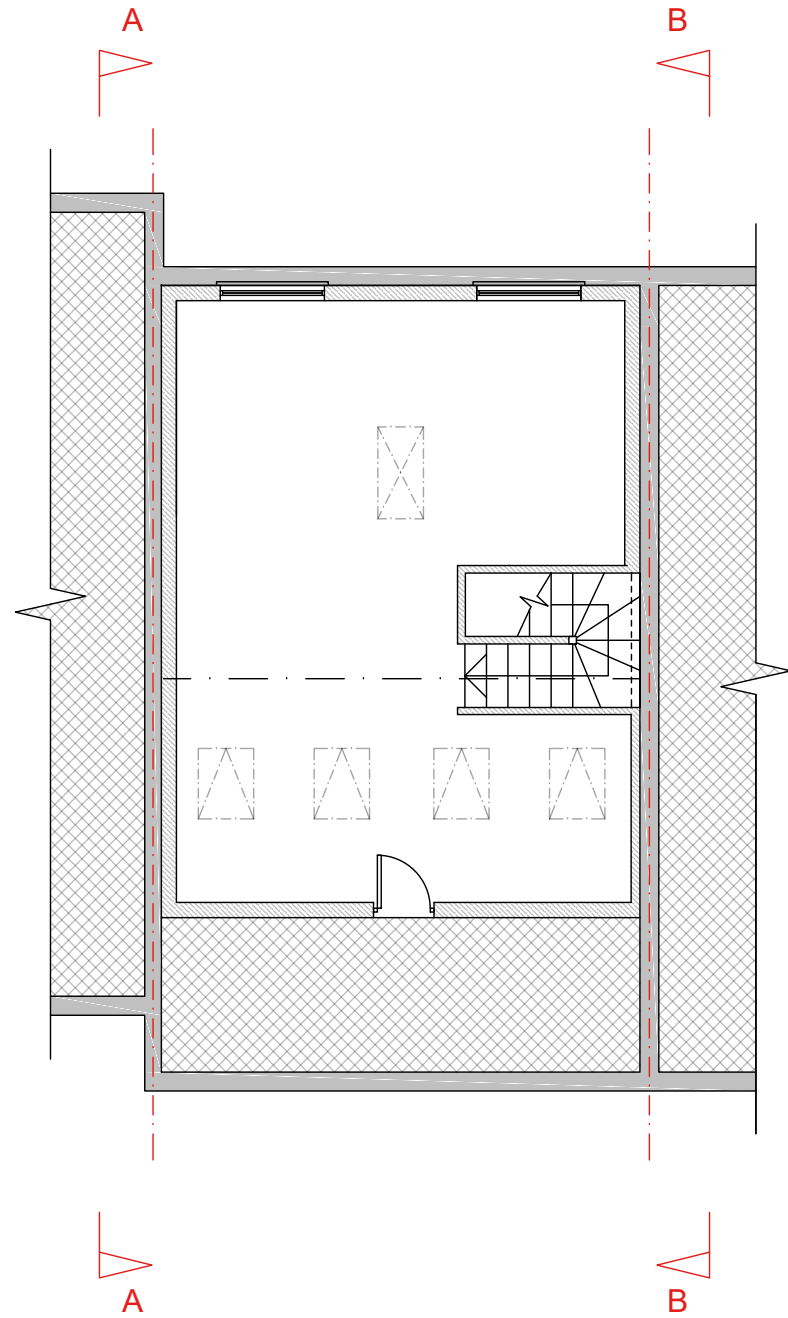



LOFT PLAN

# AS BUILT

## 11a BEAUMONT GATE

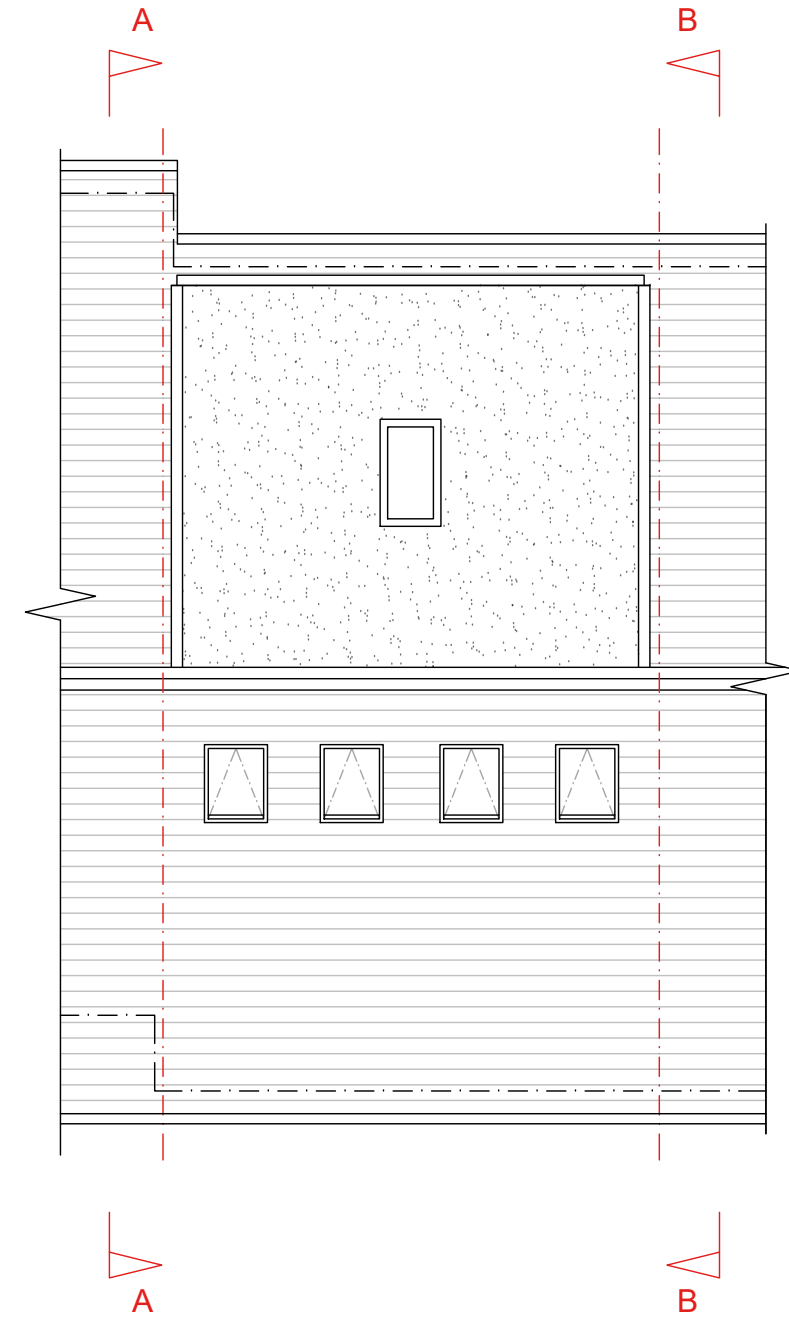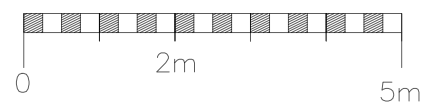

ROOF PLAN

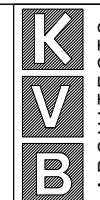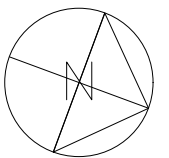

**K V B Architects Ltd**  
Chartered Architects  
9 High Street  
Tring, Herts  
HP23 5AH  
Tel: +44 (0)1442 824691  
Email: greg@kvbarchitects.co.uk  
www.kvbarchitects.co.uk

CLIENT  
**St Albans City Football Club**

PROJECT  
**11a Beaumont Gate, Shenley Hill, Radlett, WD7 7AR**



TITLE  
**As Built Drawings**

SCALE <b>1:100 @ A3</b>	DATE <b>29.11.23</b>
DRAWN <b>OE</b>	CHECKED
DRAWING NO.	<b>103</b>
JOB NO.	REVISION





FRONT ELEVATION

**AS BUILT**  
11a BEAUMONT GATE

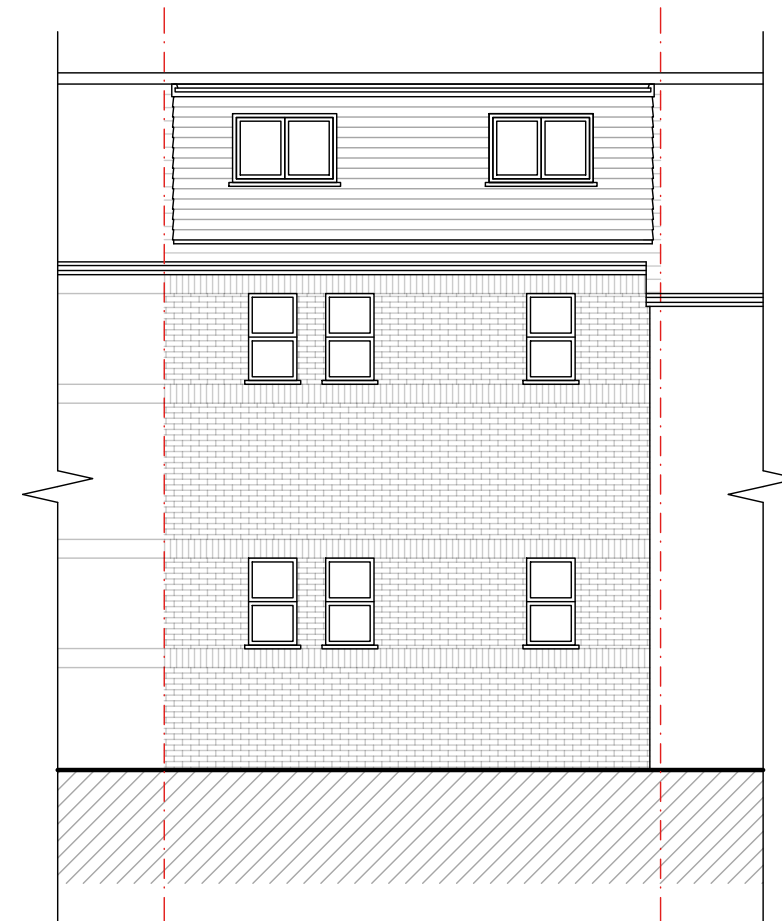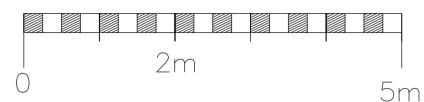

REAR ELEVATION

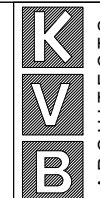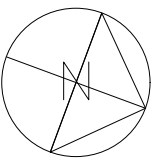


**K V B Architects Ltd**  
Chartered Architects  
9 High Street  
Tring, Herts  
HP23 5AH  
Tel: +44 (0)1442 824691  
Email: greg@kvbarchitects.co.uk  
www.kvbarchitects.co.uk

CLIENT  
**St Albans City Football Club**


PROJECT  
**11a Beaumont Gate, Shenley Hill, Radlett, WD7 7AR**

TITLE  
**AS Built Drawings**


SCALE <b>1:100 @ A3</b>	DATE <b>29.11.23</b>
DRAWN <b>OE</b>	CHECKED
DRAWING NO.	<b>104</b>
JOB NO.	REVISION

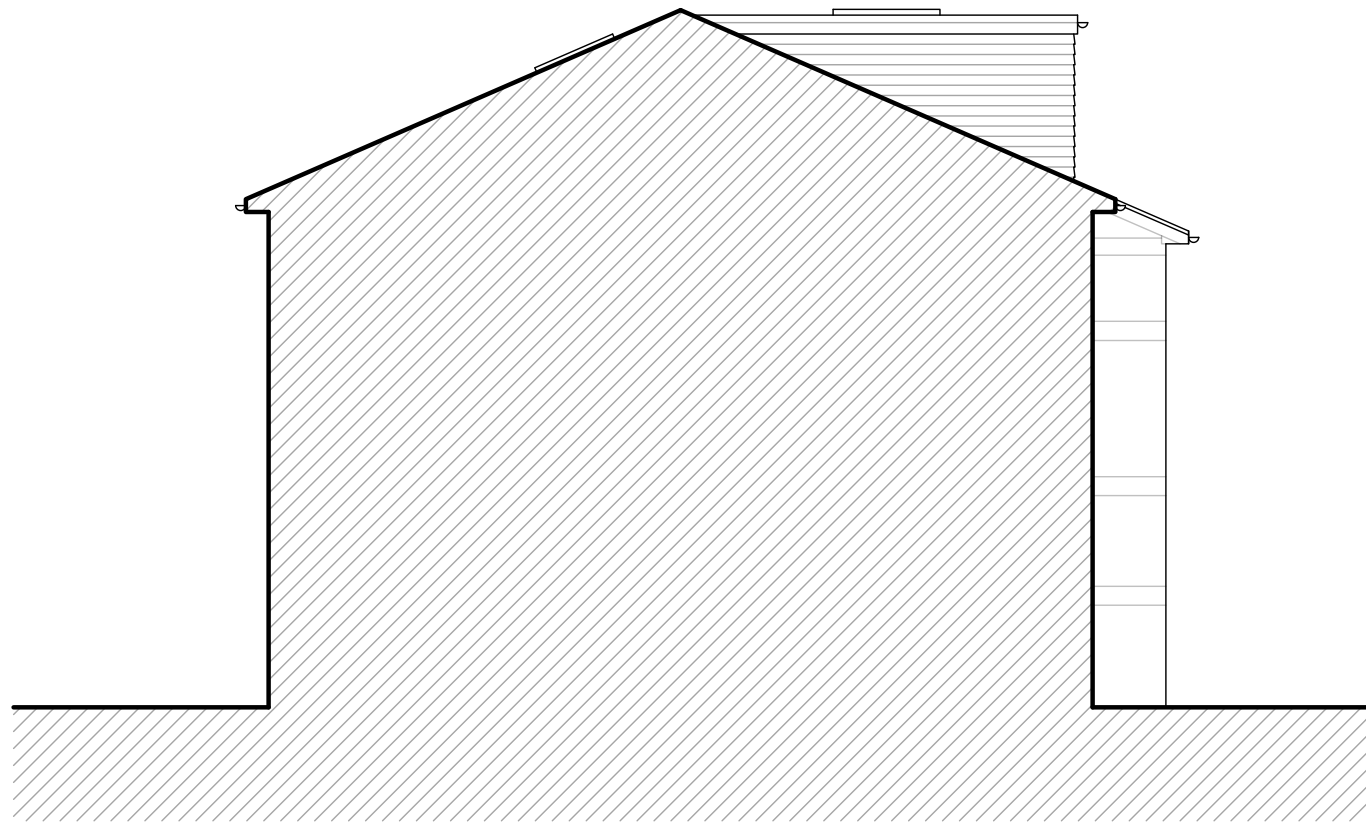



SECTION A-A

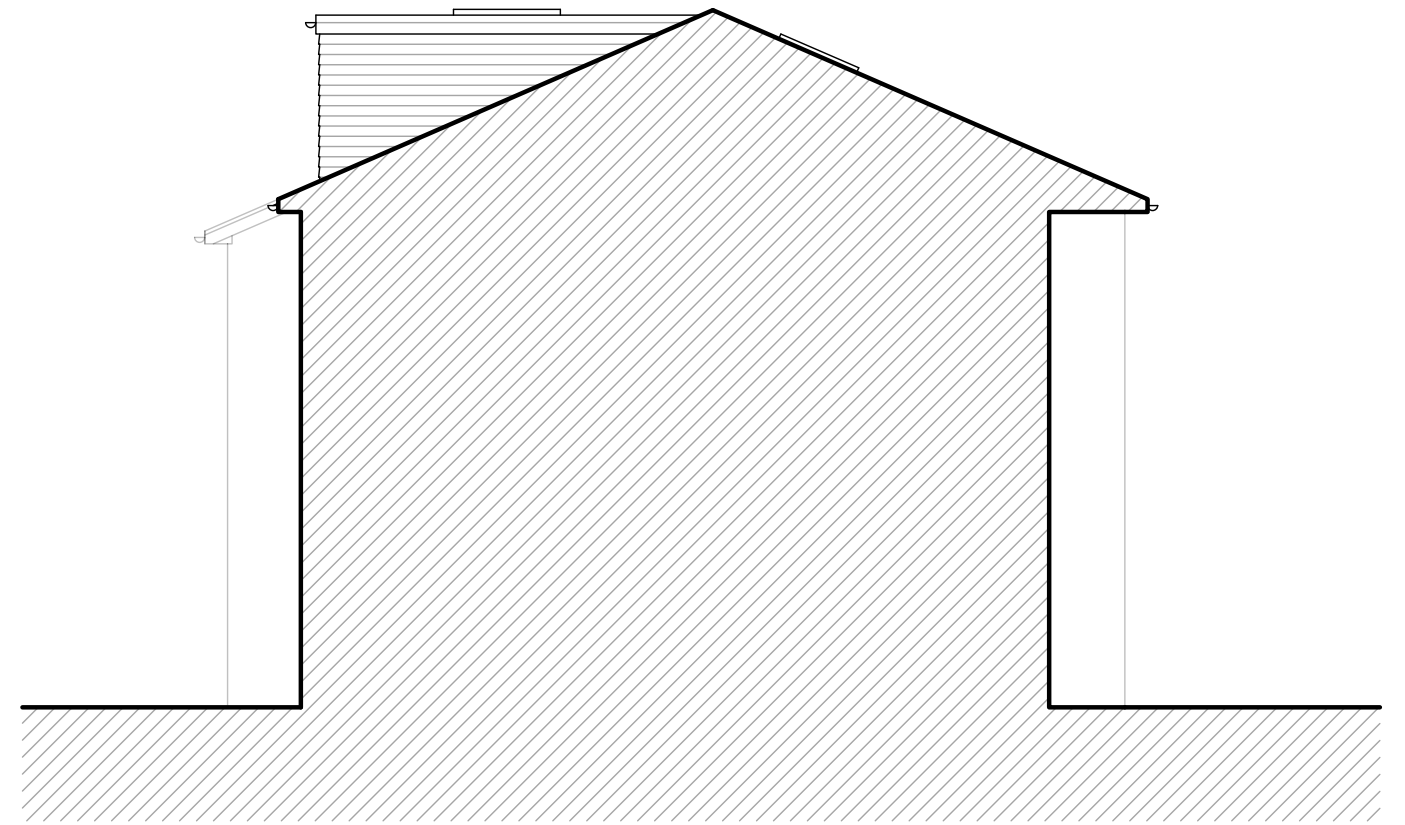

SECTION B-B

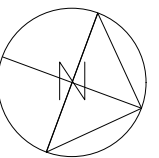

**AS BUILT**  
11a BEAUMONT GATE

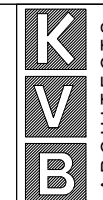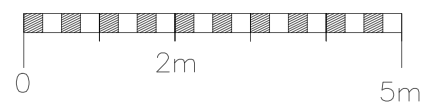

**K V B Architects Ltd**  
Chartered Architects  
9 High Street  
Tring, Herts  
HP23 5AH  
Tel: +44 (0)1442 824691  
Email: greg@kvbarchitects.co.uk  
www.kvbarchitects.co.uk

CLIENT St Albans City Football Club	SCALE 1:100 @ A3	DATE 29.11.23
PROJECT 11a Beaumont Gate, Shenley Hill, Radlett, WD7 7AR	DRAWN <b>OE</b>	CHECKED
TITLE AS Built Drawings	DRAWING NO. <b>105</b>	
	JOB NO.	REVISION