


GROUND FLOOR PLAN



FIRST FLOOR PLAN

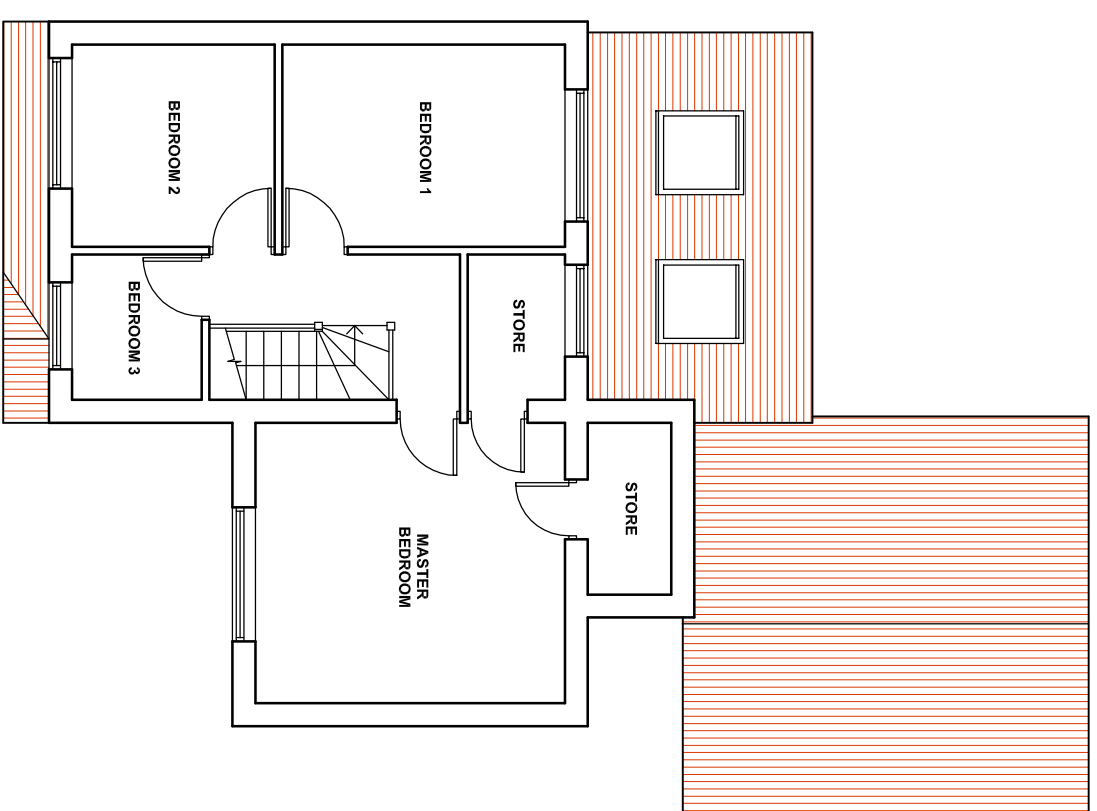

PLANNING

PROJECT TITLE: 191 ROSTREVOR RD DAVENPORT, SK3 8RE.
PROPOSED SIDE EXTENSION TO SEMI DETACHED HOUSE

DRAWING TITLE: AS-BUILT FLOOR PLANS

SCALE: 1:100@A3
DATE: 25.09.23
DRAWN BY: AEP

PROJECT NO: 2310_02

DRAWING NO: 010

REVISION:

pettifer architecture

tel: 07979629158
email: info@pettiferarchitecture.co.uk
www.pettiferarchitecture.co.uk