




ELEVATION A  
(front elevation)

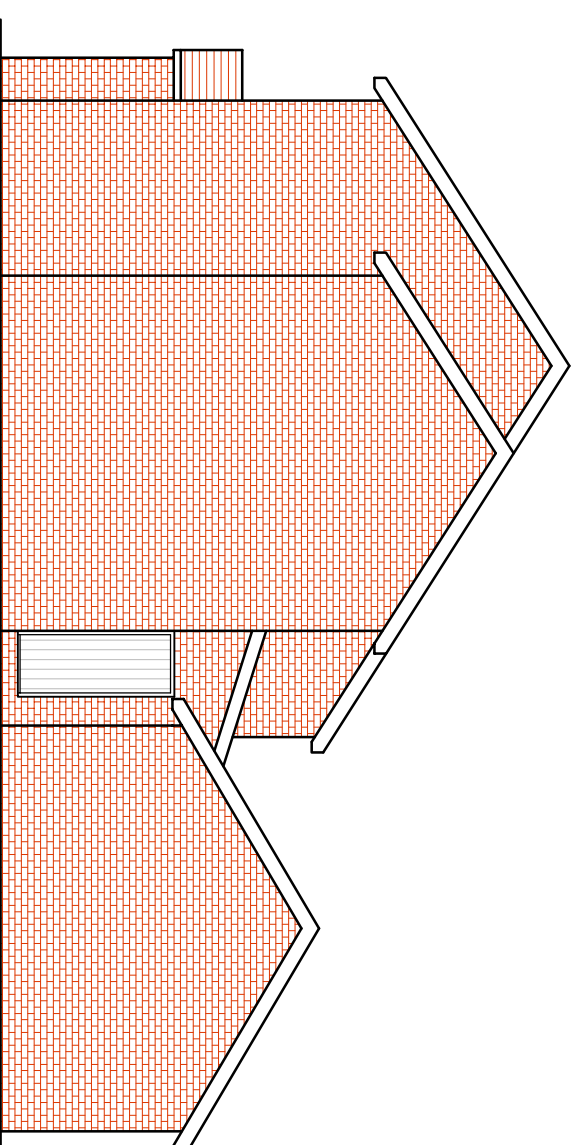

ELEVATION B  
(side elevation)

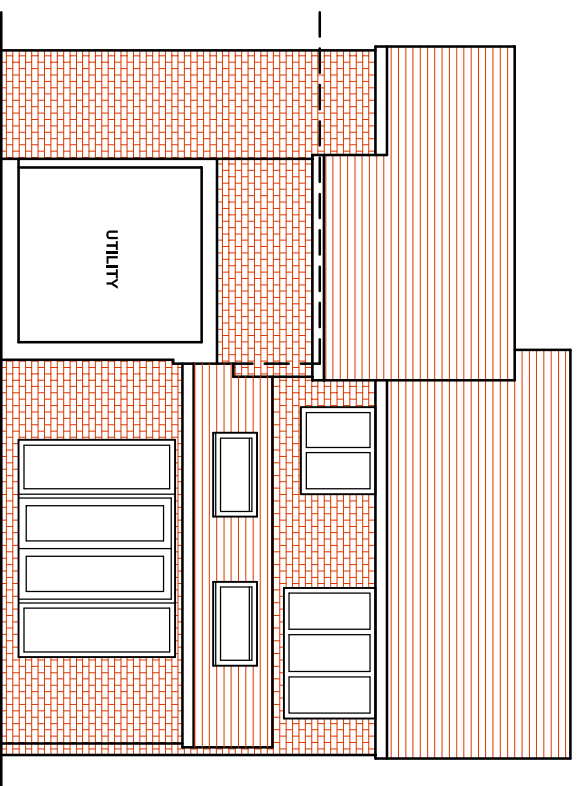

ELEVATION C  
(rear elevation)

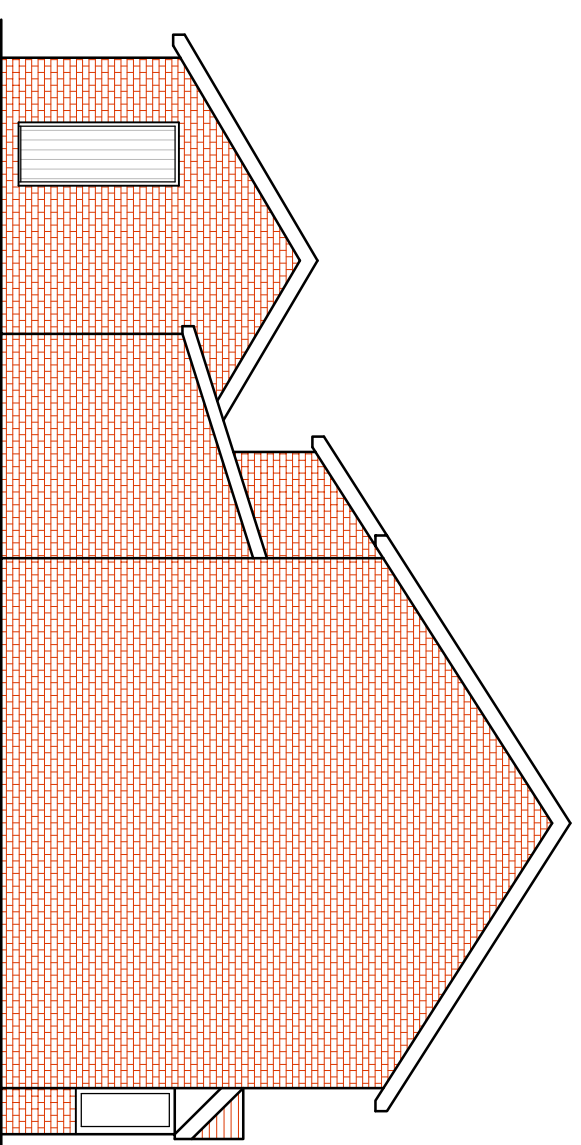

ELEVATION D  
(side elevation)



PLANNING

PROJECT TITLE: 191 ROSTREVOR RD  
DAVENPORT, SK3 8RE.  
PROPOSED SIDE  
EXTENSION TO SEMI  
DETACHED HOUSE

PROJECT NO: 2310\_02

REVISION:

DRAWING TITLE: AS-BUILT ELEVATIONS

DRAWING NO: 020

SCALE: 1:100@A3

DATE: 25.09.23

DRAWN BY: AEP

**pettifer architecture**

tel: 079729629158  
email: info@pettiferarchitecture.co.uk  
www.pettiferarchitecture.co.uk