
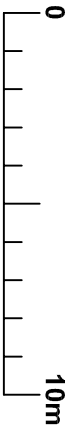


Do not scale drawings. All dimensions to be verified on site before proceeding with the work. All dimensions given in millimetres unless stated otherwise. All drawings to be read in conjunction with other consultants' drawings and specifications.

revision drawn date

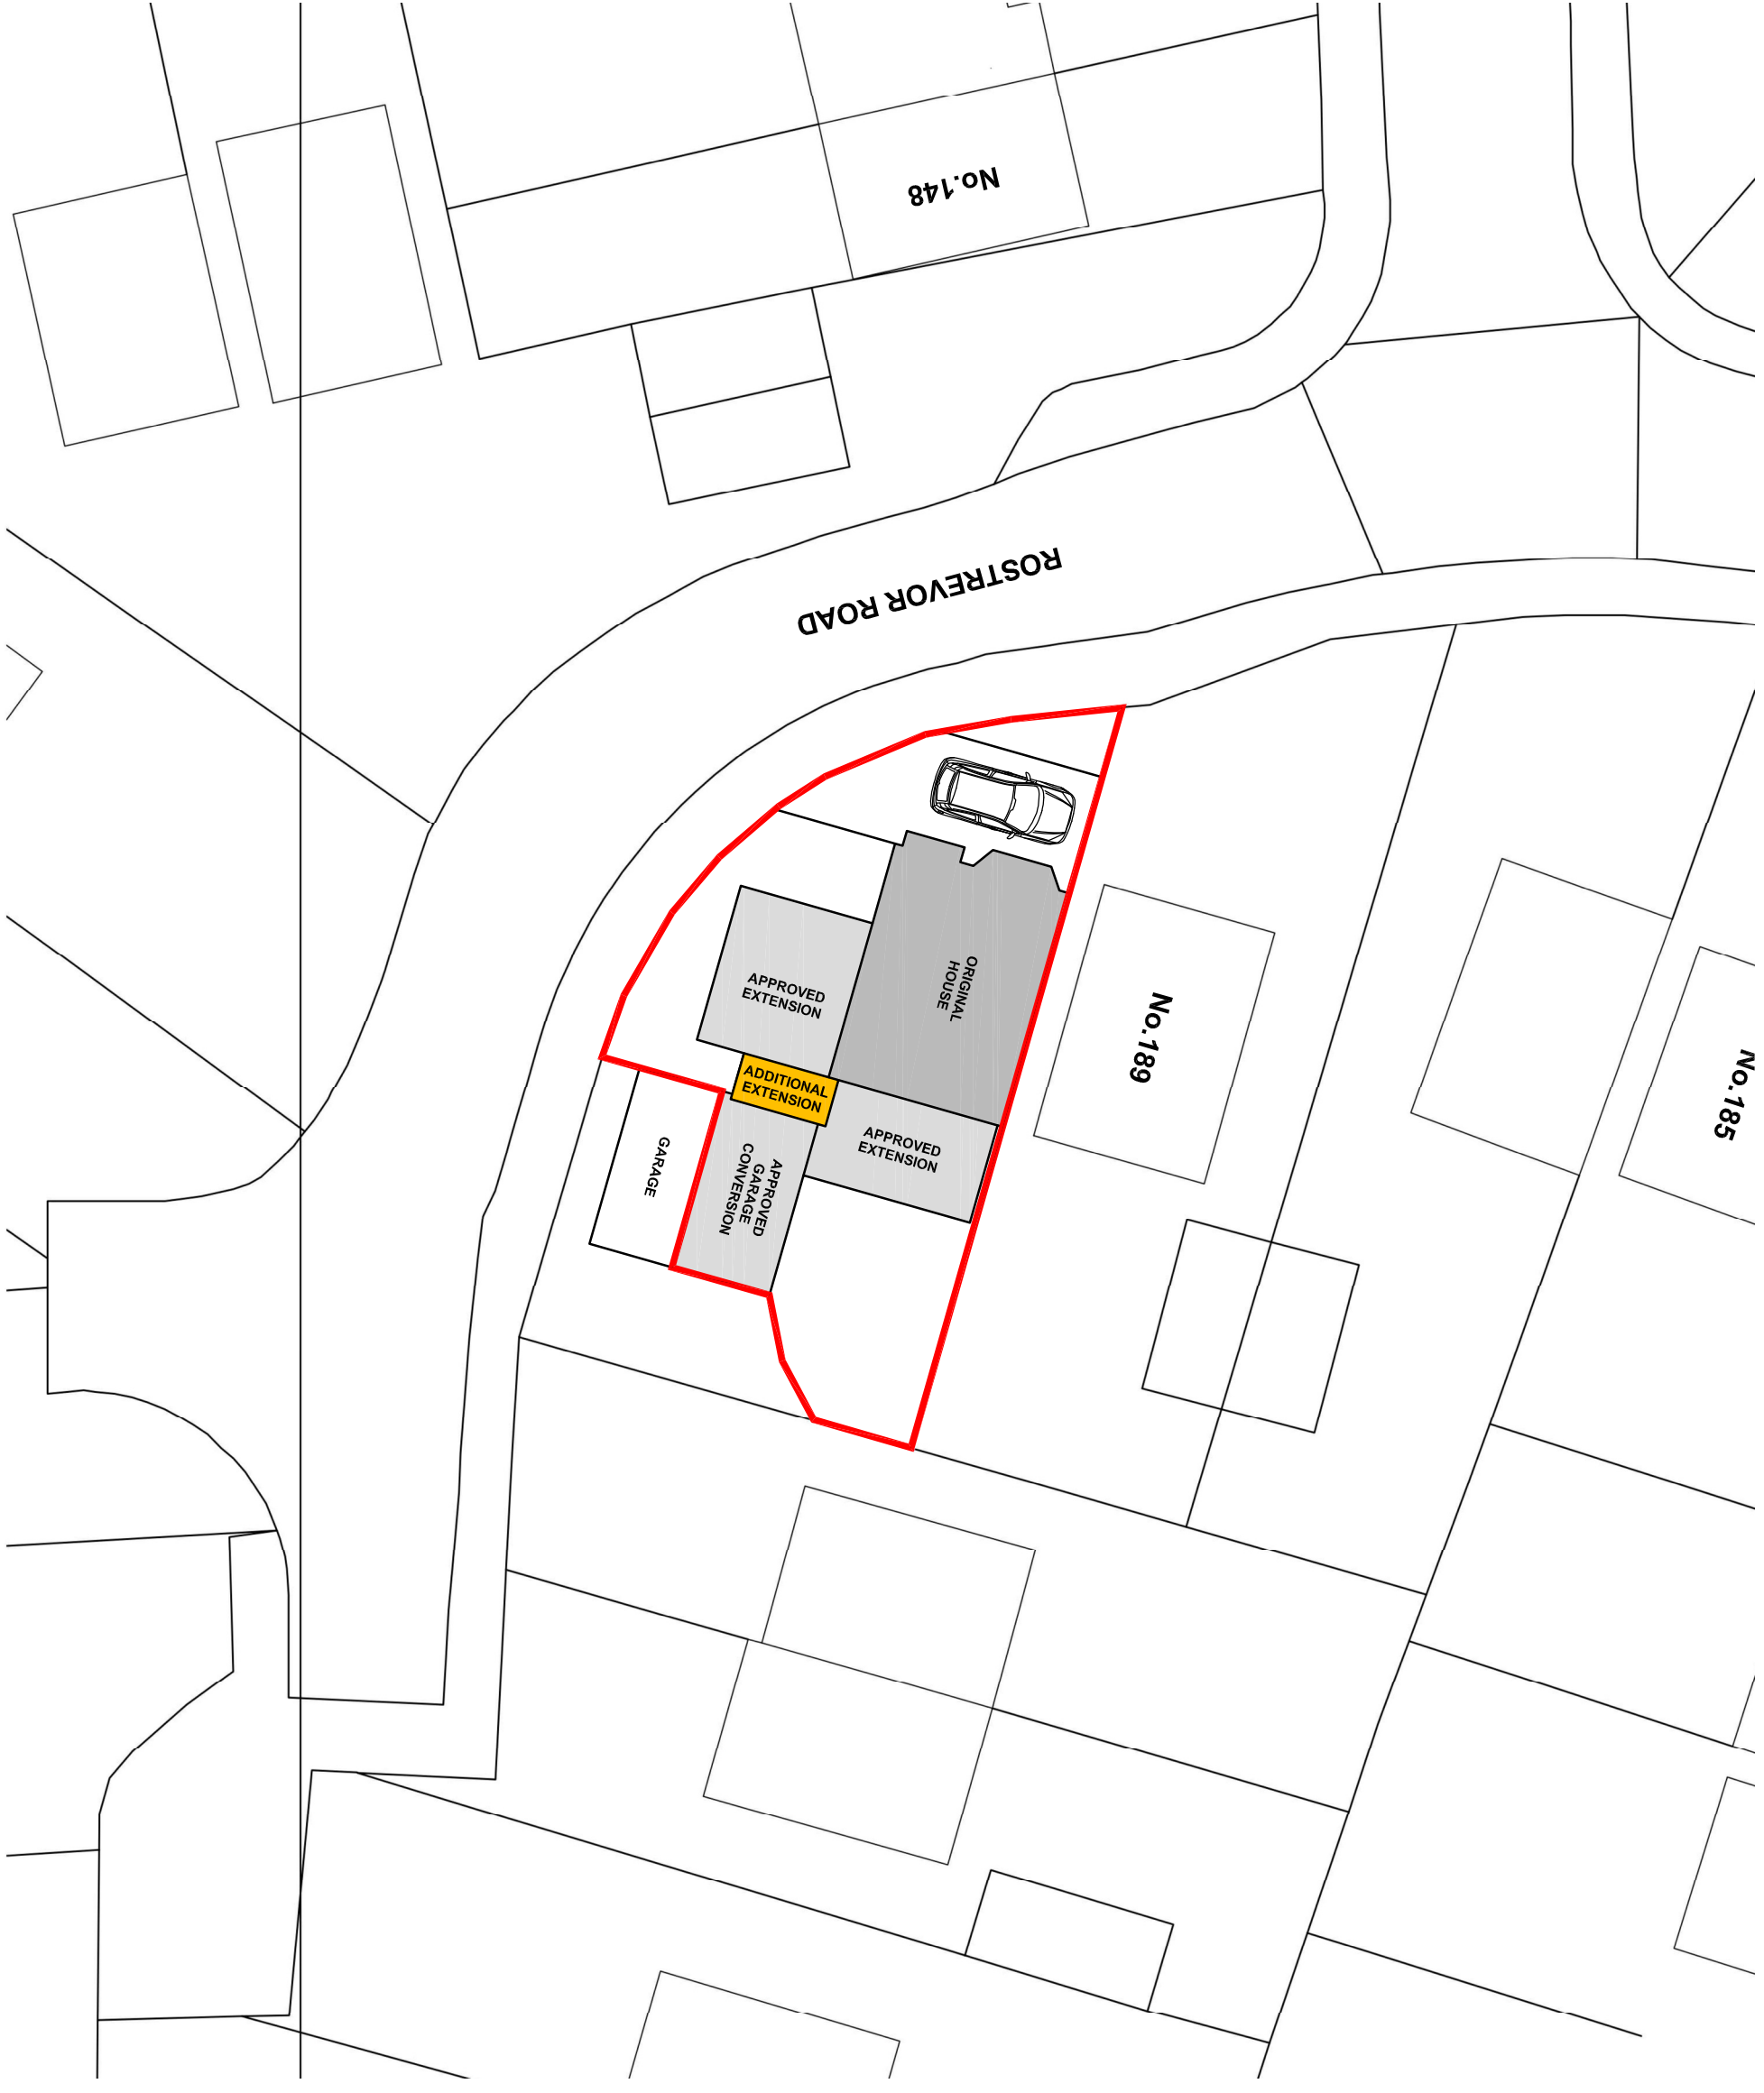

PLANNING

PROJECT TITLE: 191 ROSTREVOR RD DAVENPORT, SK3 8RE.
PROJECT NO: 2310_02
PROPOSED SIDE EXTENSION TO SEMI DETACHED HOUSE
REVISION:

DRAWING TITLE: AS-BUILT SITE PLAN
DRAWING NO: 003

SCALE: 1:200@A3
DATE: 25.09.23
DRAWN BY: AEP

pettifer architecture
tel: 07979629158
email: info@pettiferarchitecture.co.uk
www.pettiferarchitecture.co.uk