




Front Elevation

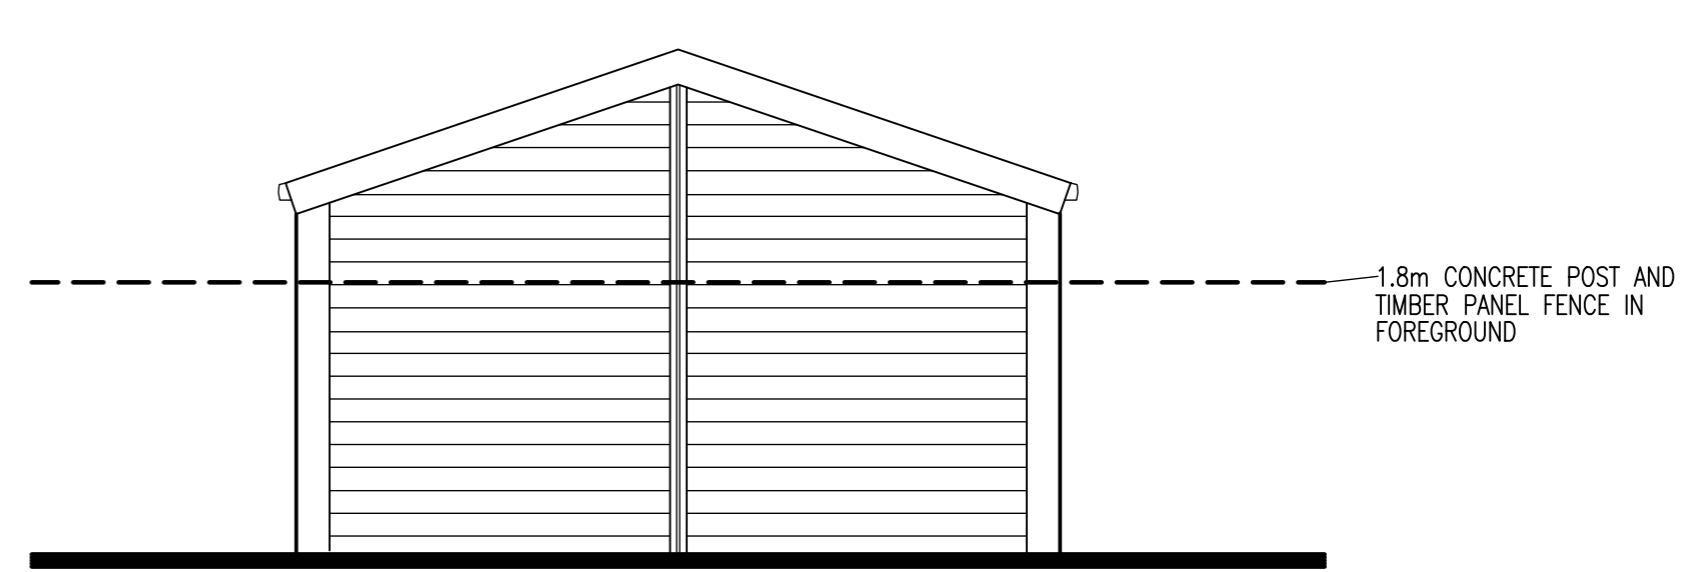


Rear Elevation

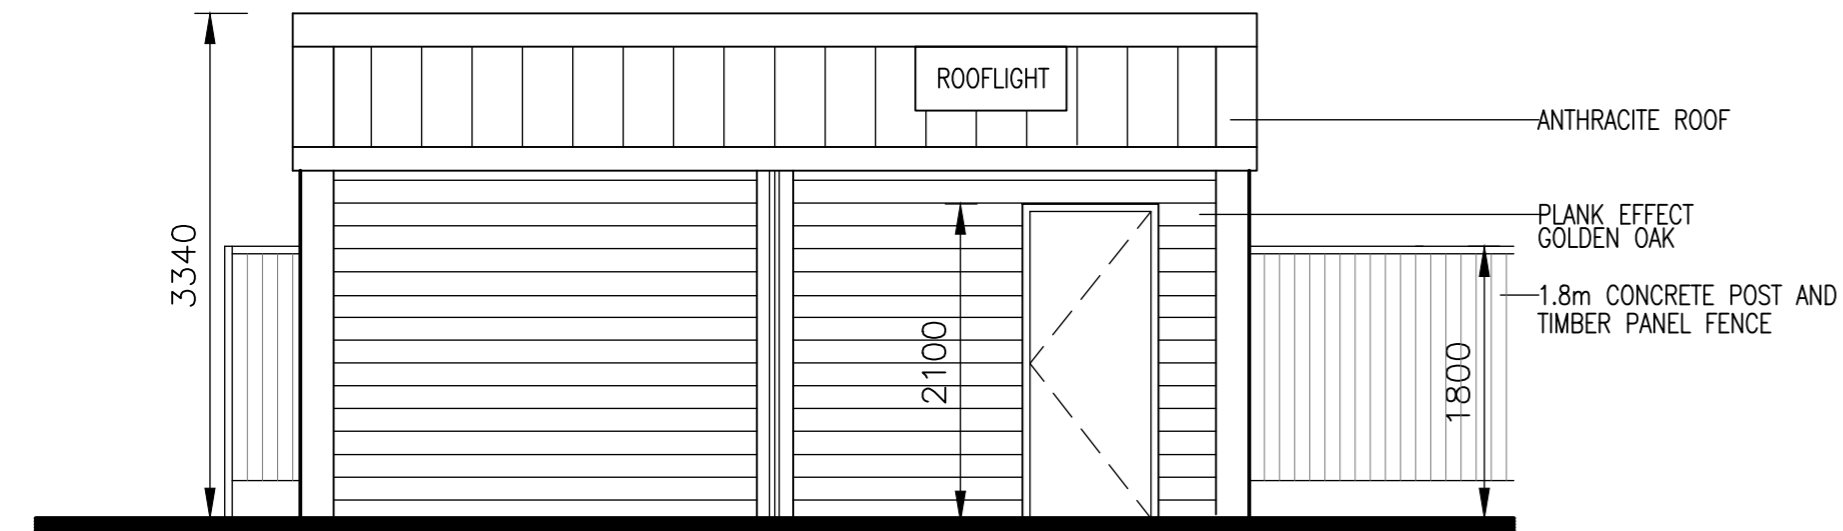

Side Elevation

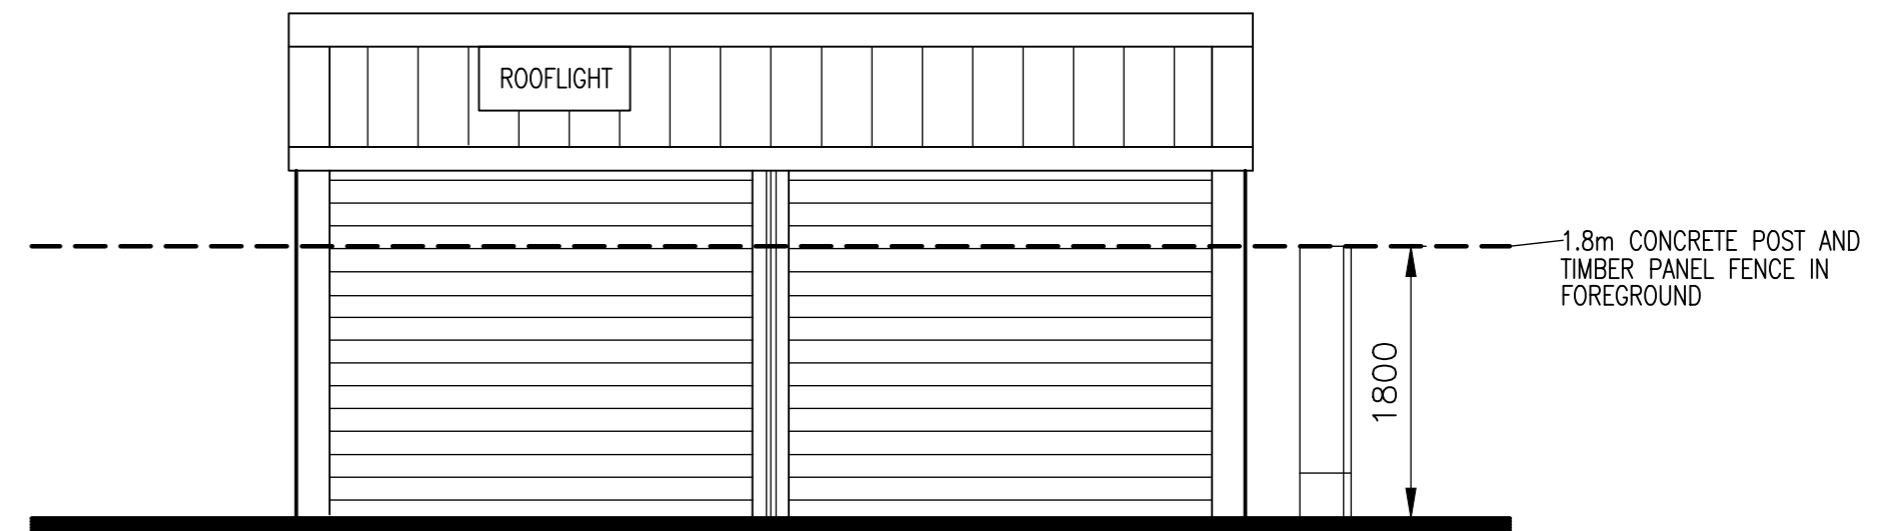

Side Elevation

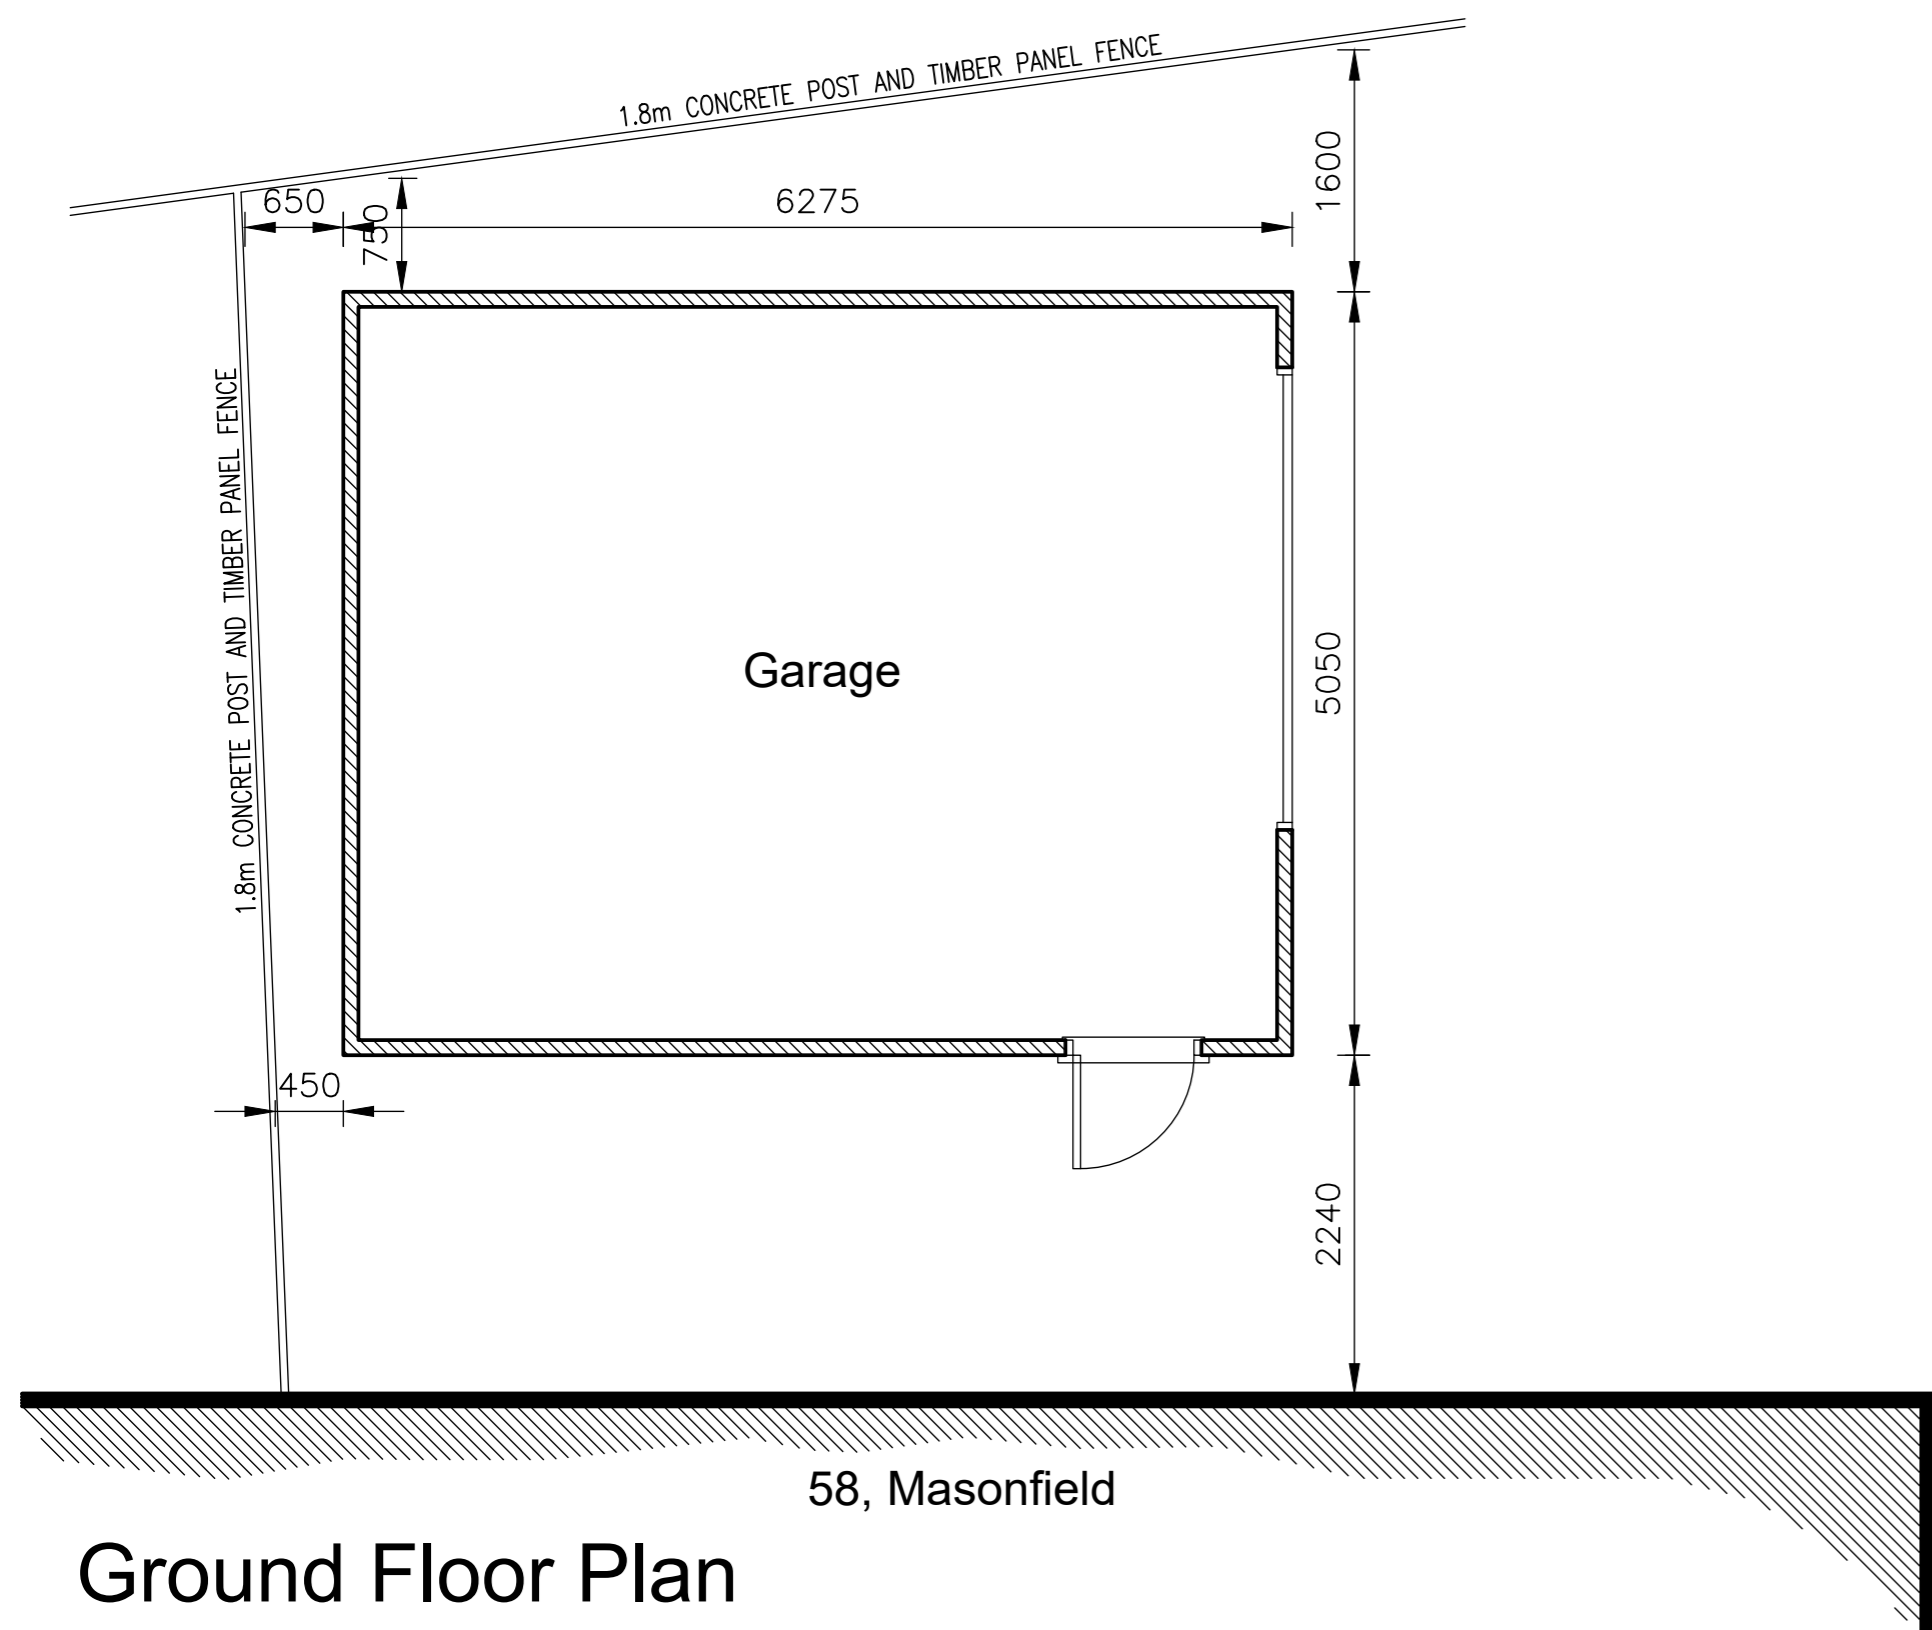

Ground Floor Plan



Rev.	Description	By	Date
Project Mr Wilkins 58, Masonfield Clayton-le-Woods Preston, Lancashire PR5 8HP		Drawing Title Existing Layouts As Built	
Drawing No. WILKINS/03		Rev.	
1. Figured dimensions to be followed in preference to scale. 2. All dimensions to be checked on site prior to the commencement of any work. Any discrepancies to be reported immediately & resolved prior to work commencing. 3. This drawing is the copyright of Mr Paul Erskine and may not be copied or used without prior consent.		Drawn by P.E.	Scale 1:50
		Date Nov '23	