


LEGEND


----- Downtakings in dashed red line

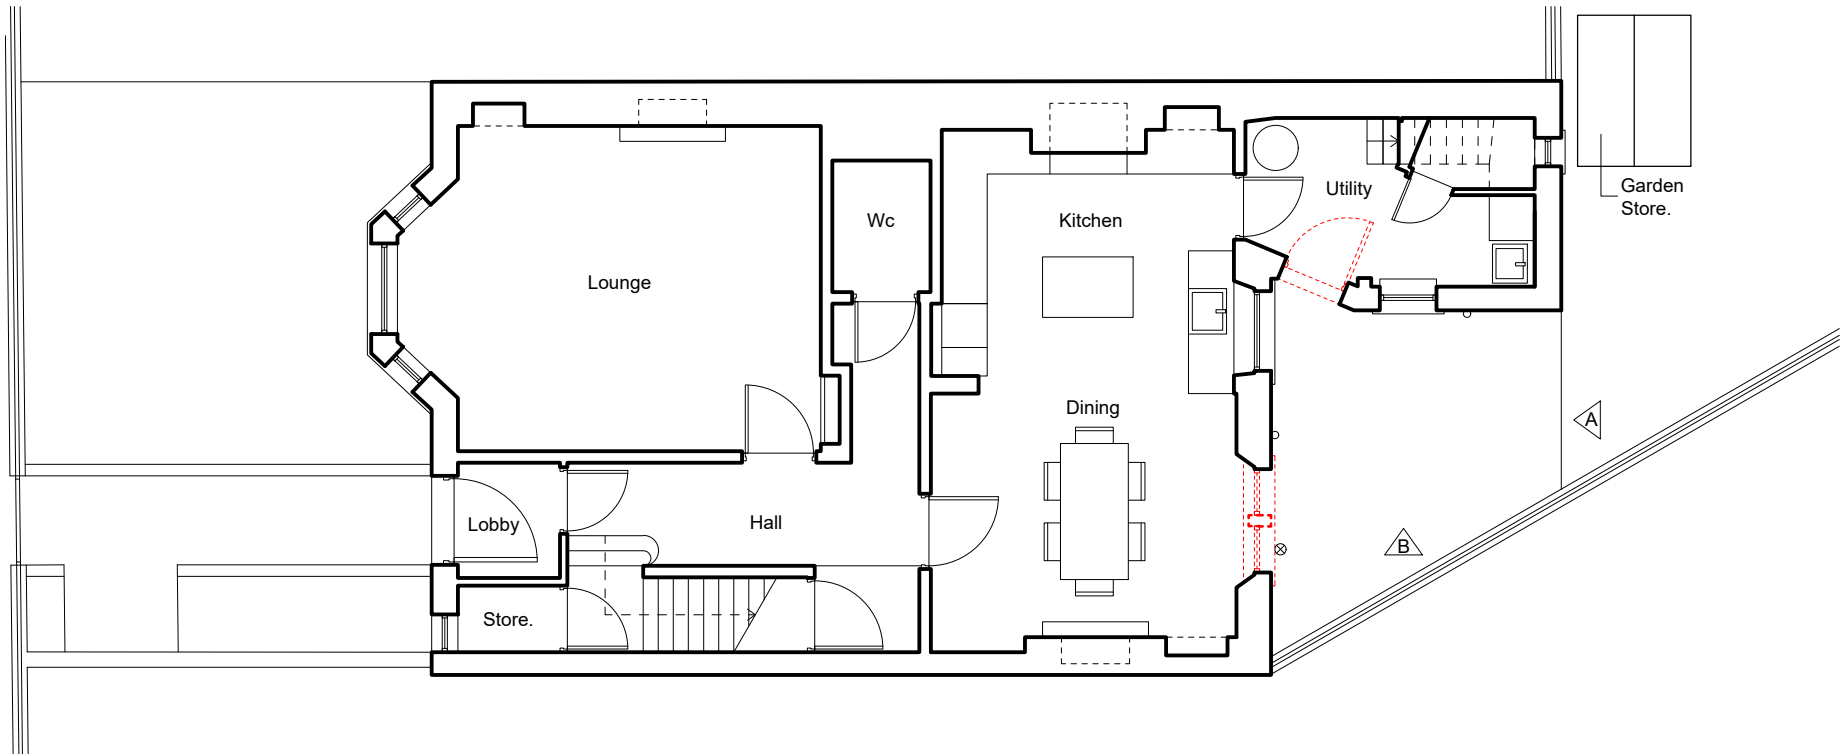

Ground Floor Plan



Rear Elevation A

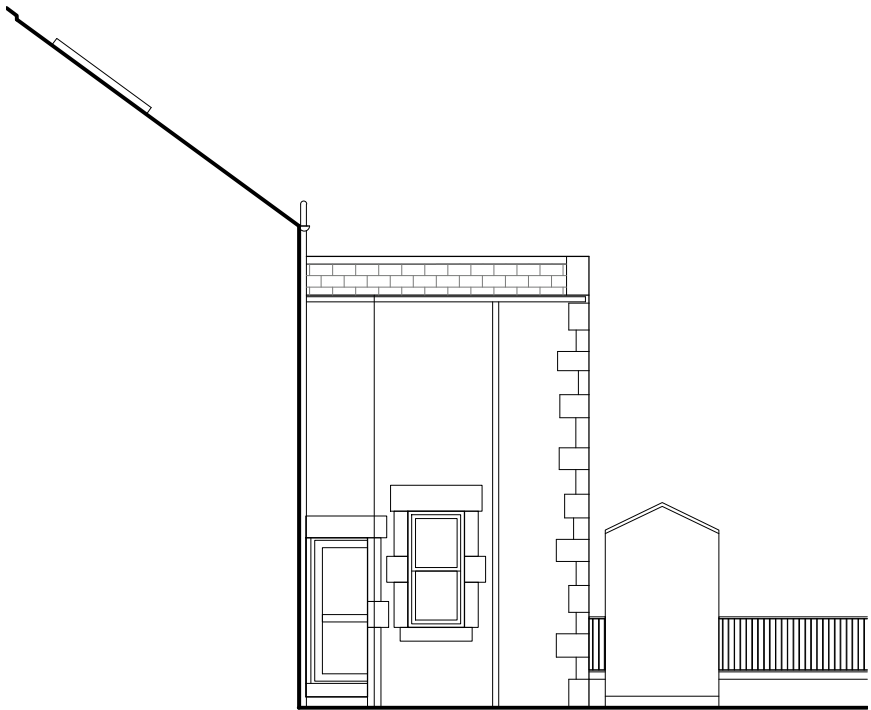

Rear Elevation B



Drawing Status  
**PLANNING**

**Neil Middleton architect**  
07930481144 / nm@neilmiddleton.net  
www.neilmiddleton.net

Project  
**069 - 58 South Trinity Road**

Drawing Name  
**Existing Plan with Downtakings and Existing  
Rear Elevations**

Scale	Date	Drawing Number	Revision
1:100 at A3	14.11.23	<b>EX100</b>	P1