




SITE PLAN PRIOR TO WORKS - SCALE 1:100

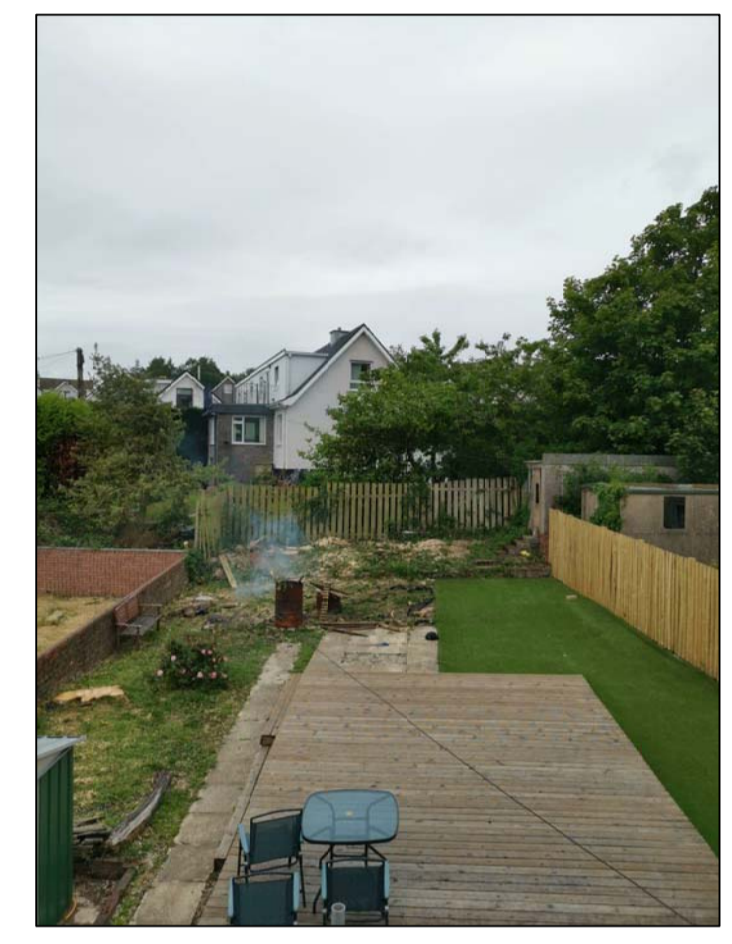


AREA PRIOR TO RAISED PATIO

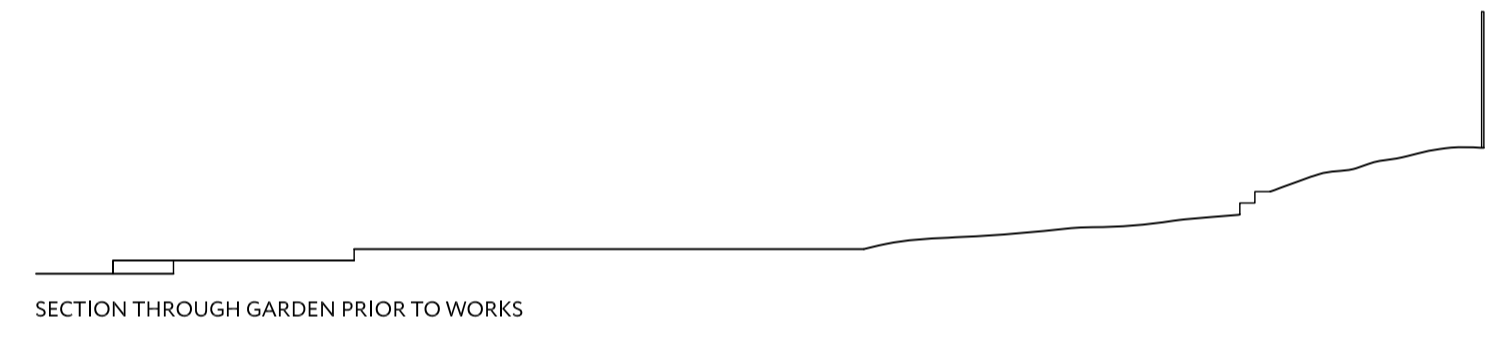

SECTION THROUGH GARDEN PRIOR TO WORKS

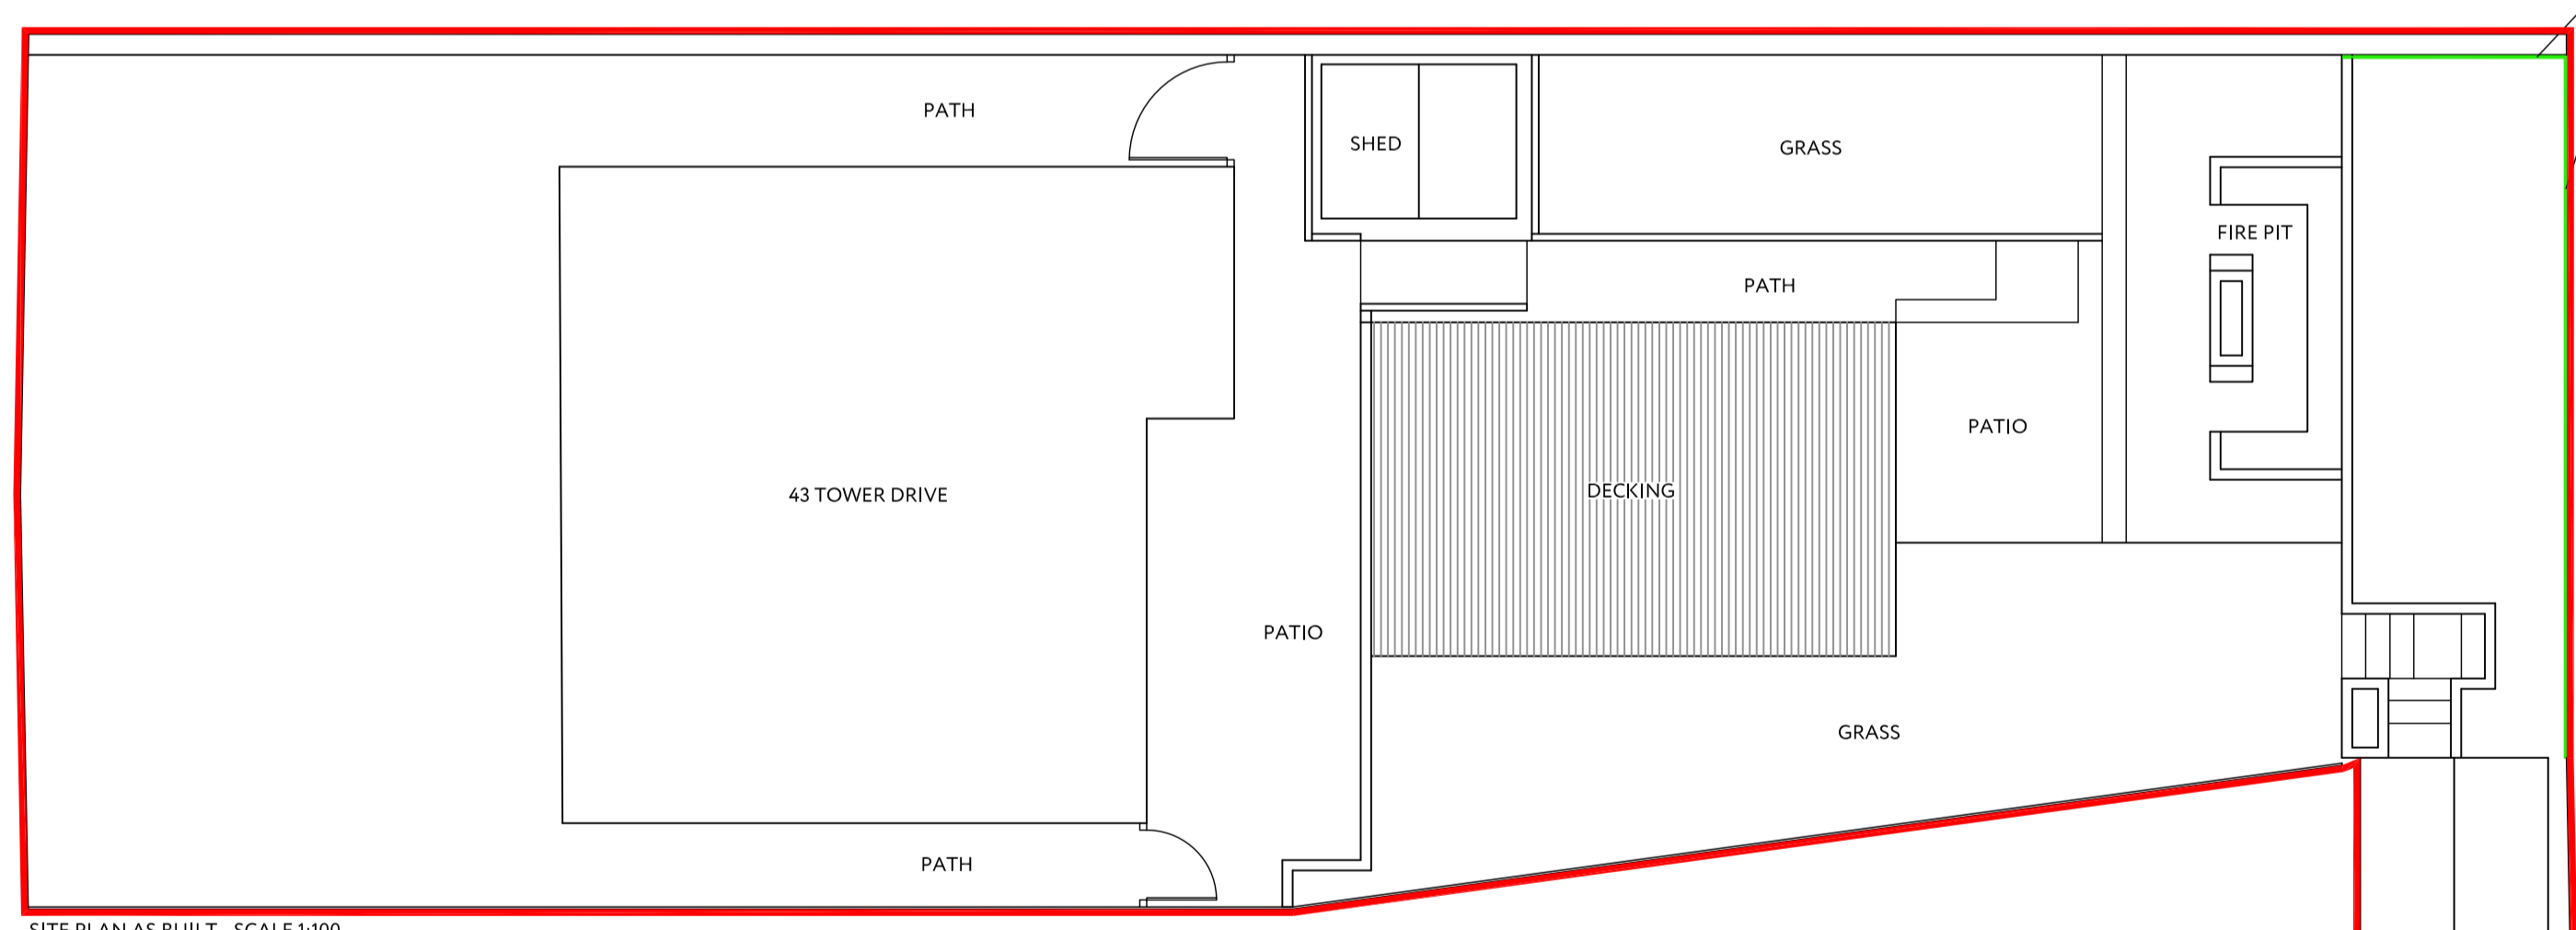


SITE PLAN AS BUILT - SCALE 1:100

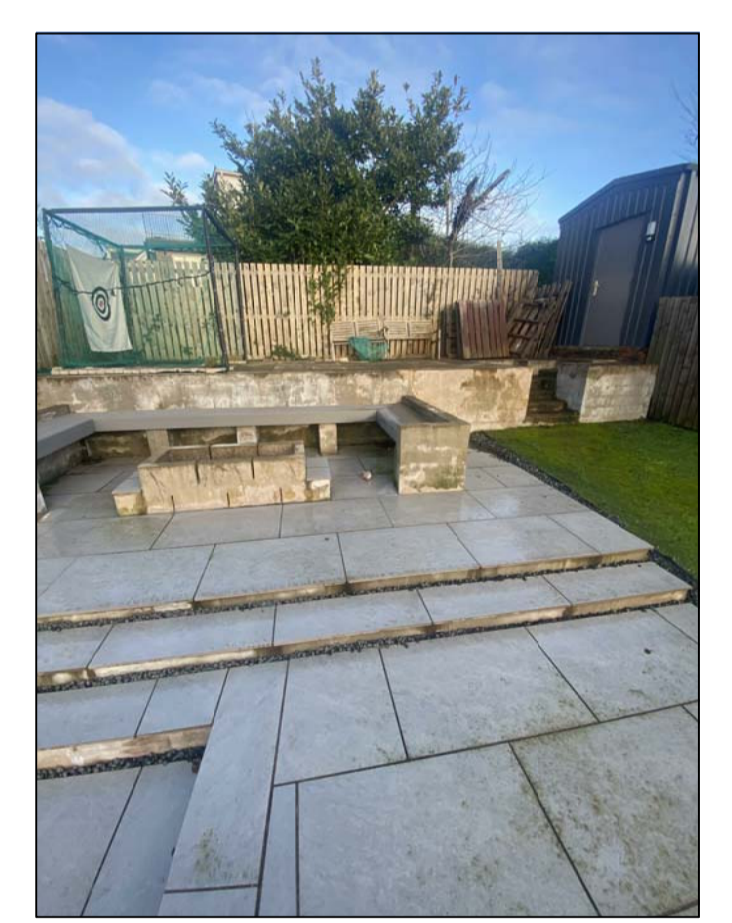


RAISED PATIO AS BUILT





RAISED PATIO AS BUILT

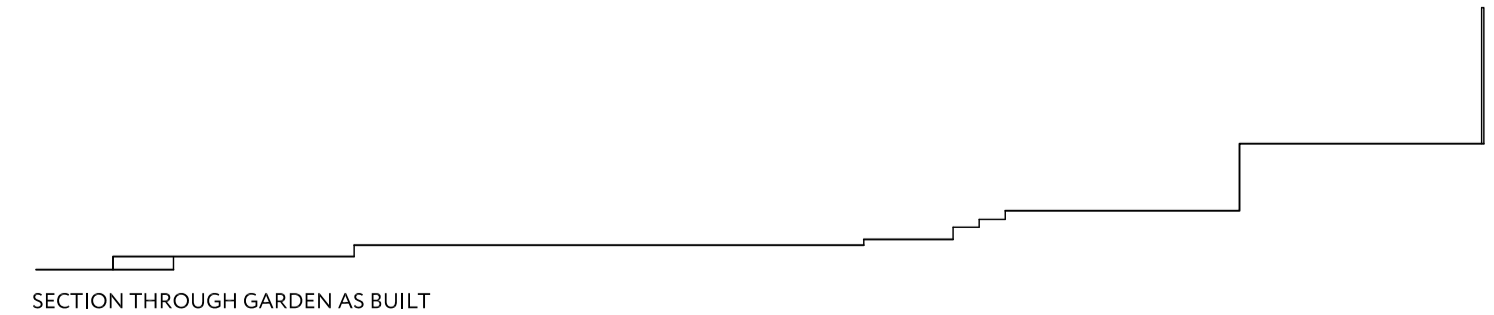

SECTION THROUGH GARDEN AS BUILT

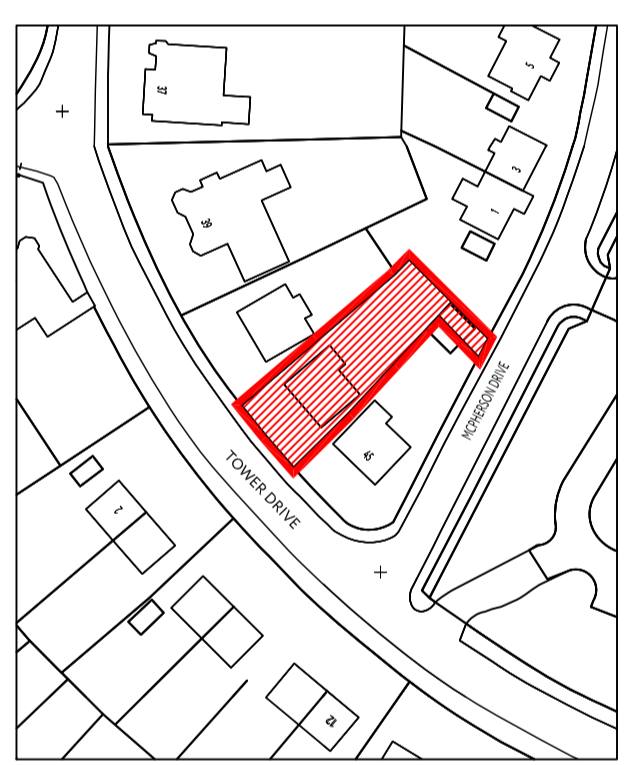

OS REPRODUCED UNDER LICENSE NUMBER - 100054476
SCALE 1:1250

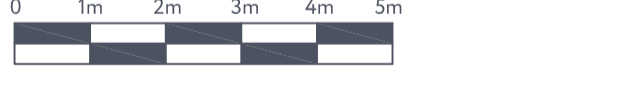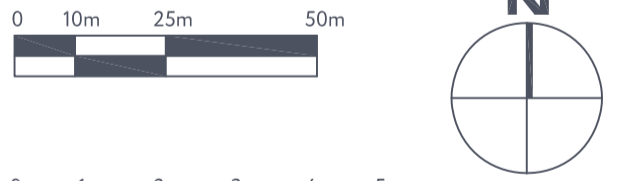

RA Rebecchi ARCHITECTURAL
32 Kempsck Street
Gourock
PA19 1NA
t - 01475 634844
e - marco@rebecchia.com
w - rebecchia.com

Client		
Chris Cleary		
Project Title		
Formation of Raised Patio & Erection of Boundary Fence in Retrospect at 43 Tower Drive, Gourock		
Drawing Title		
Existing and Proposed Site Plan and Sections		
Scale	Size	Date
1:100	A1	12-12-23
Job No.	Drawing No.	Revision
23-126	PL-001	-