


Issue:
REV - ISSUE FOR PLANNING

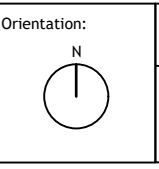

Project:
NICOLL FARM, ALLUM LANE, ELSTREE,
HERTFORDSHIRE, WD6 3NP

Drawing:
EXISTING:
FARMHOUSE - PLANS

Date:
NOV 2023

Scale:
1:100 @ A3

Drawing No:
E-101

Client:
VECTOR CAPITAL
PLC

Job No:
23-0302-NIC

Rev:

PLANNING & LISTED BUILDING APPLICATION



EXISTING: FARMHOUSE - NORTH ELEVATION

DATUM 7.00m

1980's door and frame to be removed.
(Opening to be infilled with matching
brickwork). Canopy over also to be
removed.

Gas boiler housing
to be removed.




EXISTING: FARMHOUSE - EAST ELEVATION

DATUM 7.00m

1980's timber windows and doors
to be replaced indicated in red

Masonry (1980's) to be removed to
accommodate new door opening

PLANNING & LISTED BUILDING APPLICATION

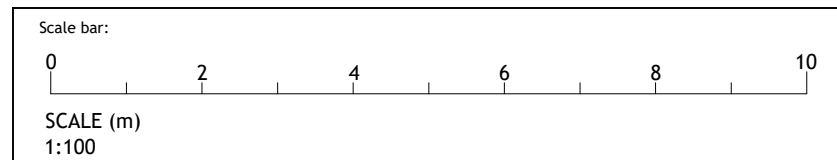

Issue:
REV - ISSUE FOR PLANNING

Project:
NICOLL FARM, ALLUM LANE, ELSTREE,
HERTFORDSHIRE, WD6 3NP

Date:
NOV 2023

Client:
VECTOR CAPITAL
PLC

Drawing:
EXISTING:
FARMHOUSE - NORTH & EAST
ELEVATIONS

Scale:
1:100 @ A3
Drawing No:
E-102

Job No:
23-0302-NIC
Rev:





EXISTING: FARMHOUSE - SOUTH ELEVATION

DATUM 7.00m

Inappropriate recent replacement windows to be removed indicated in red




EXISTING: FARMHOUSE - WEST ELEVATION

DATUM 7.00m

1980s timber windows to be replaced indicated in red

PLANNING & LISTED BUILDING APPLICATION

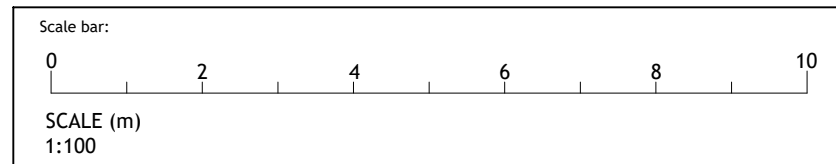

Issue:
REV - ISSUE FOR PLANNING

Project: NICOLL FARM, ALLUM LANE, ELSTREE, HERTFORDSHIRE, WD6 3NP	Date: NOV 2023	Client: VECTOR CAPITAL PLC
Drawing: EXISTING: FARMHOUSE - SOUTH & WEST ELEVATIONS	Scale: 1:100 @ A3	Job No: 23-0302-NIC
	Drawing No: E-103	Rev:

