


RETROSPECTIVE HOUSE HOLDER PLANNING  
APPLICATION FOR HARDSTANDING  
AS BUILT DRAWINGS 011

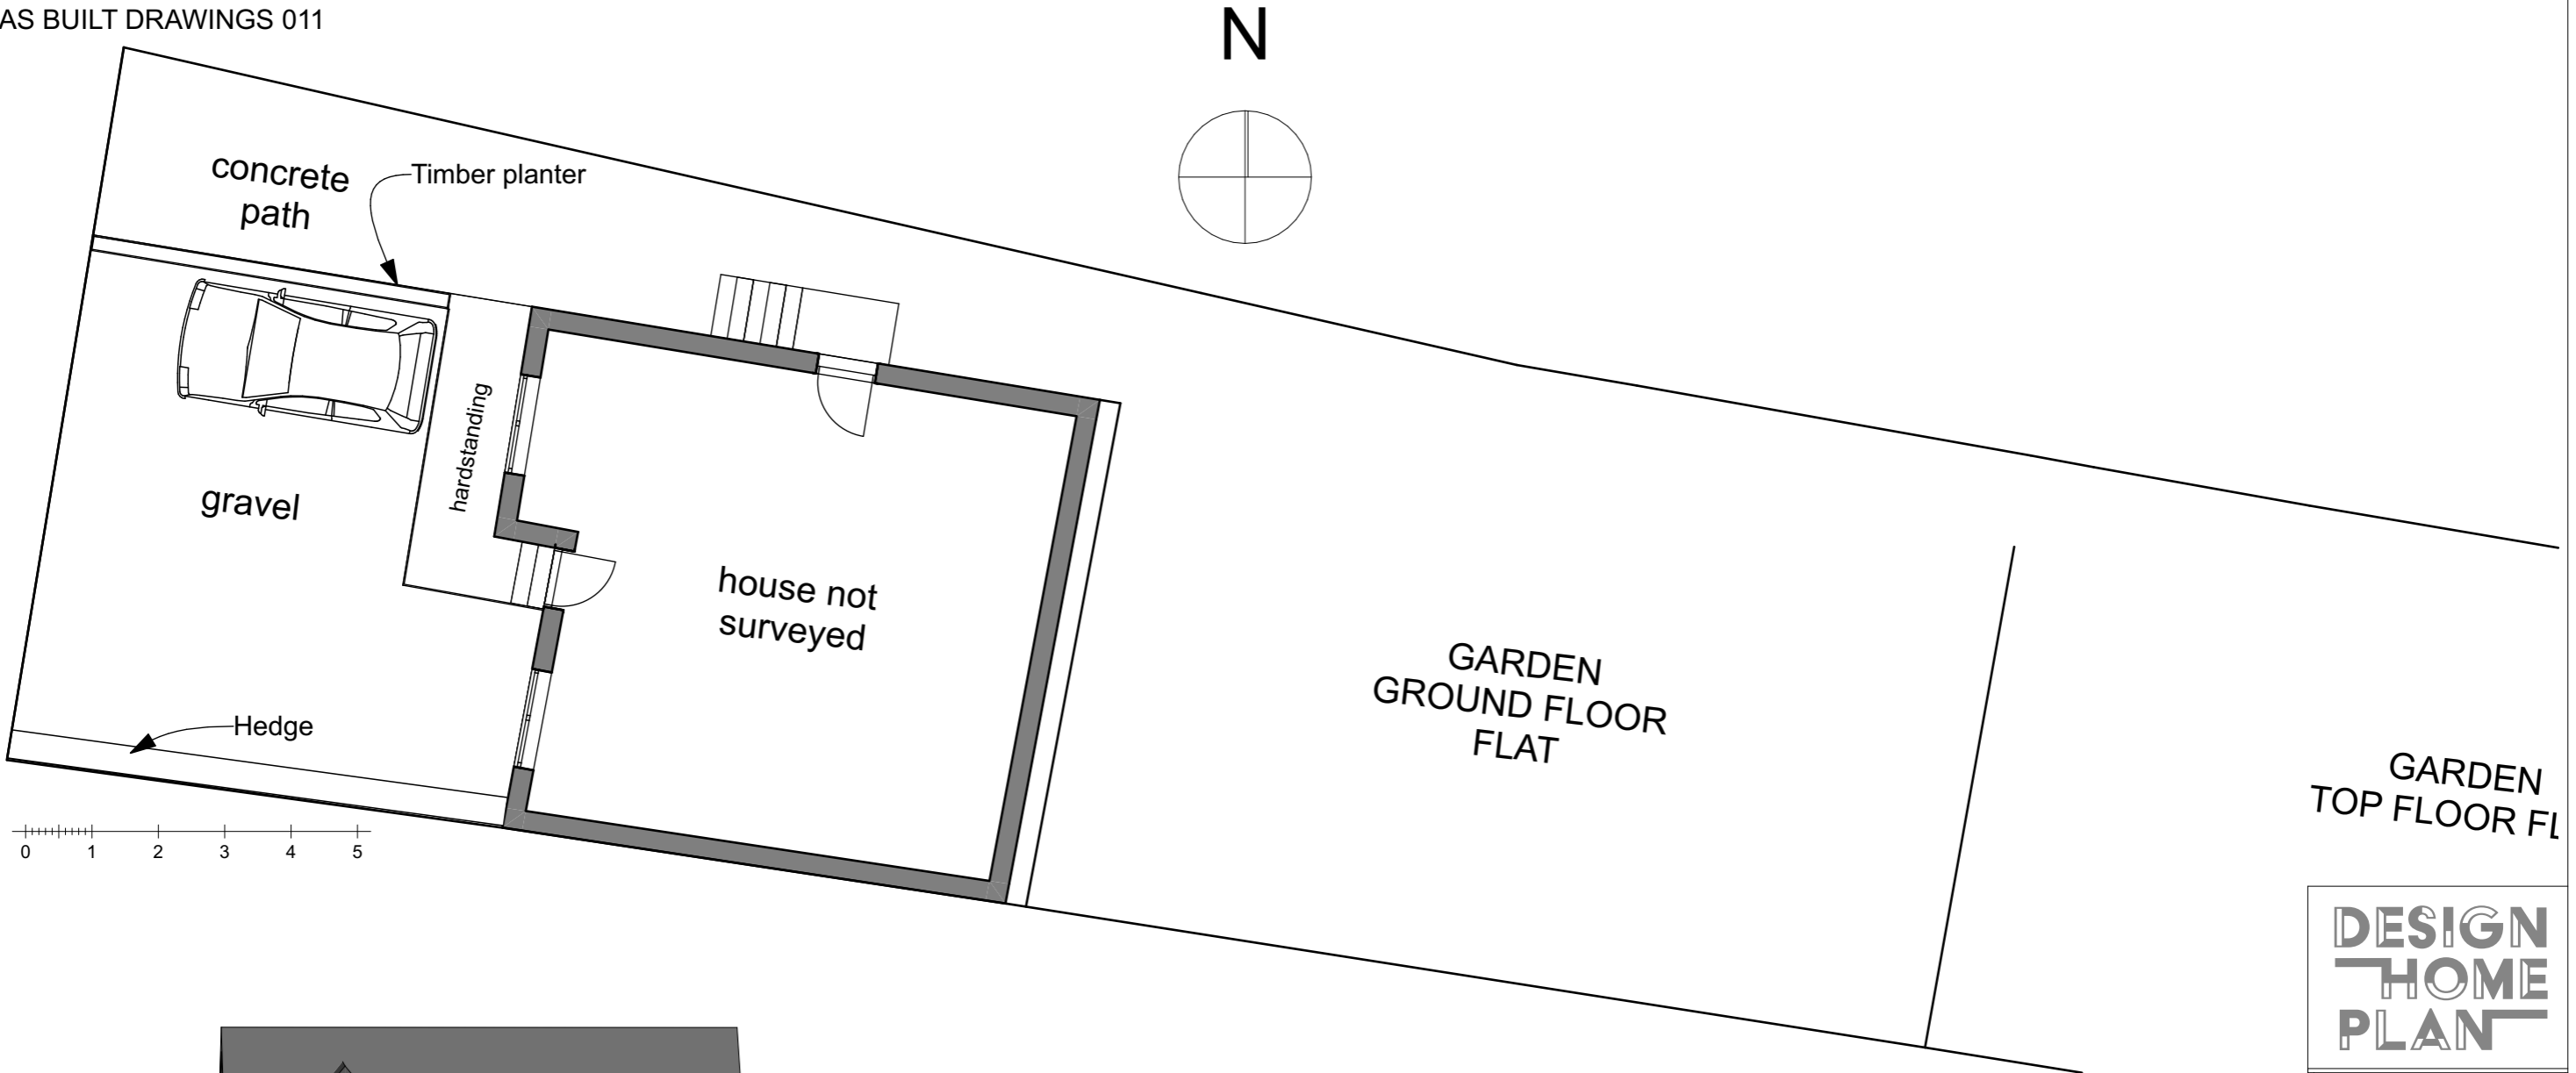

AS BUILT FRONT ELEVATION

**DESIGN  
HOME  
PLAN**

M: 07792781971  
e-mail:  
designhomeplan23@gmail.com  
Website: designhomeplan.co.uk

Client **Joseph Micallef**

**Site Location**  
50 St Johns Hill  
Sevenoaks TN13 3NU

**Dwg Desc:**  
AS BUILT

Job Ref 0823

Dwg No 011

Scale 1:100 @A3

Drawn By IT

Date - November 2023

Do not Scale from this drawing all dimensions to be checked on site before work commences. Copyright Reserved