



1:100

 AREA SUBJECT OF CHANGE OF USE

- HS DESIGN & DEVELOPMENT NOTES:
- THIS DRAWING IS ONLY TO BE USED FOR ITS INTENDED PURPOSE
 - THIS DRAWING IS TO BE READ IN CONJUNCTION WITH ALL RELEVANT DRAWINGS AND DOCUMENTS

**FOR USE OF -
PLANNING PURPOSES
ONLY**

A	FOR INFORMATION	HS	HS	20 AUG 2022
Rev	Description	Drm	Ch'kd	Date
Client				
MR. ROGER TURNER				


Project
**HOMWOOD FARM,
 89 NORTH CRAY ROAD,
 BEXLEY, DA14 5EP**

Drawing
**AS BUILT GROUND AND
 FIRST FLOOR
 PART COURTYARD PLAN**


Scale @ A3	Drawn By	Checked By
1:100	HS	HS
Project Name/Number.	Date	
HSDD-000247	20.08.2022	
Drawing Number	rev	
HSDD-0247-007	A	



www.hsdesignanddevelopment.com
 HS Design & Development Partnership. HSDD.

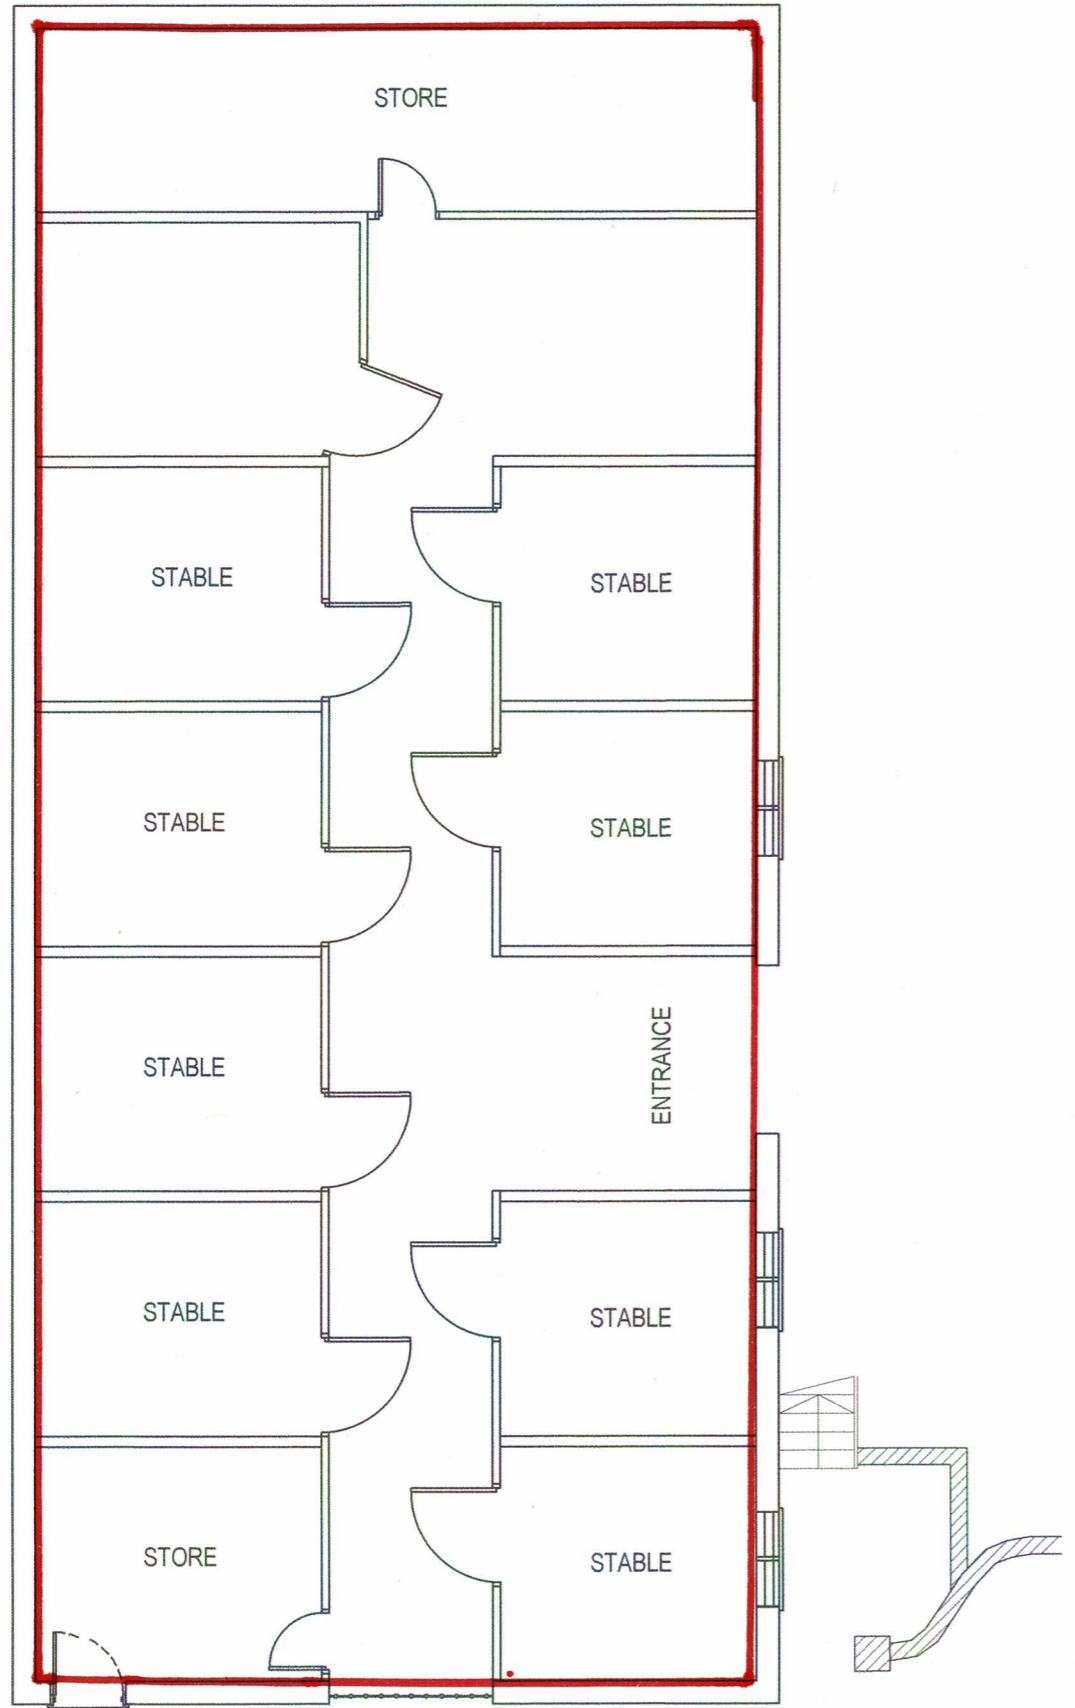

As Built Ground Floor Part Plan
 Scale 1:100

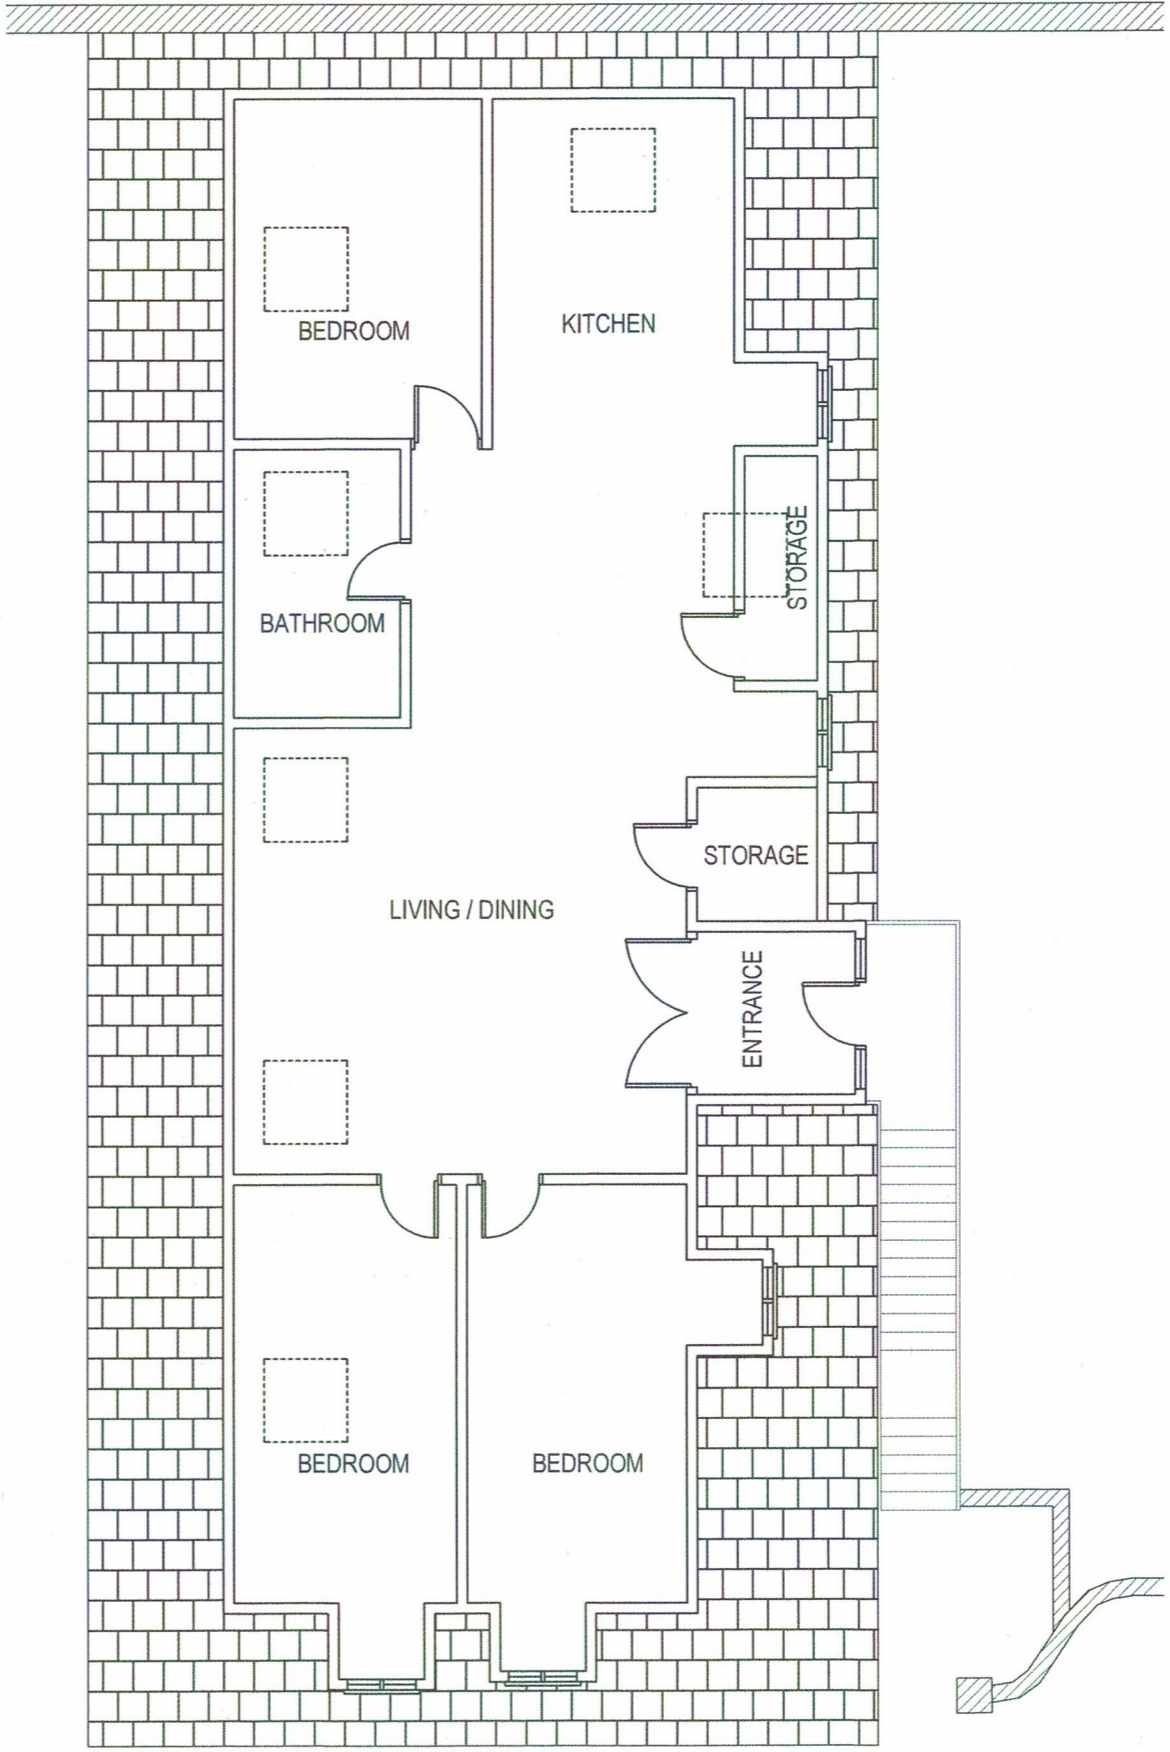

As Built First Floor Part Plan
 Scale 1:100