



EXISTING GROUND FLOOR PLAN



EXISTING REAR ELEVATION

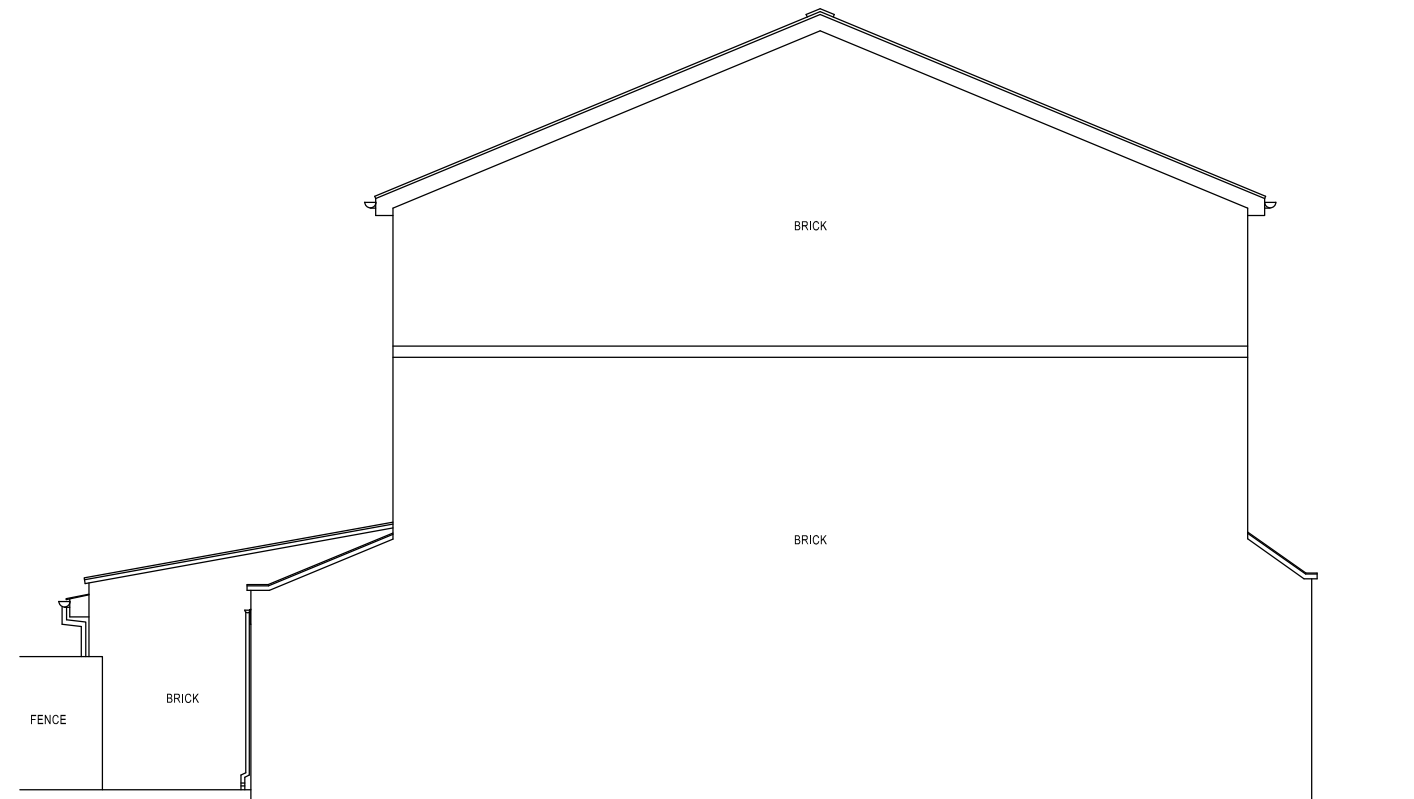

EXISTING SIDE ELEVATION

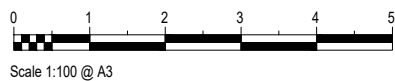

VITA MODULAR

Project **23A Church Rise SE23**

Drawing Title **AS BUILT FLOOR PLAN & ELEVATIONS**

Scale 1:100 & @ A3 Drawn BAS
Date October 2023 Job Number SE23

Drg.No. VM-SE23-01 Rev. -