
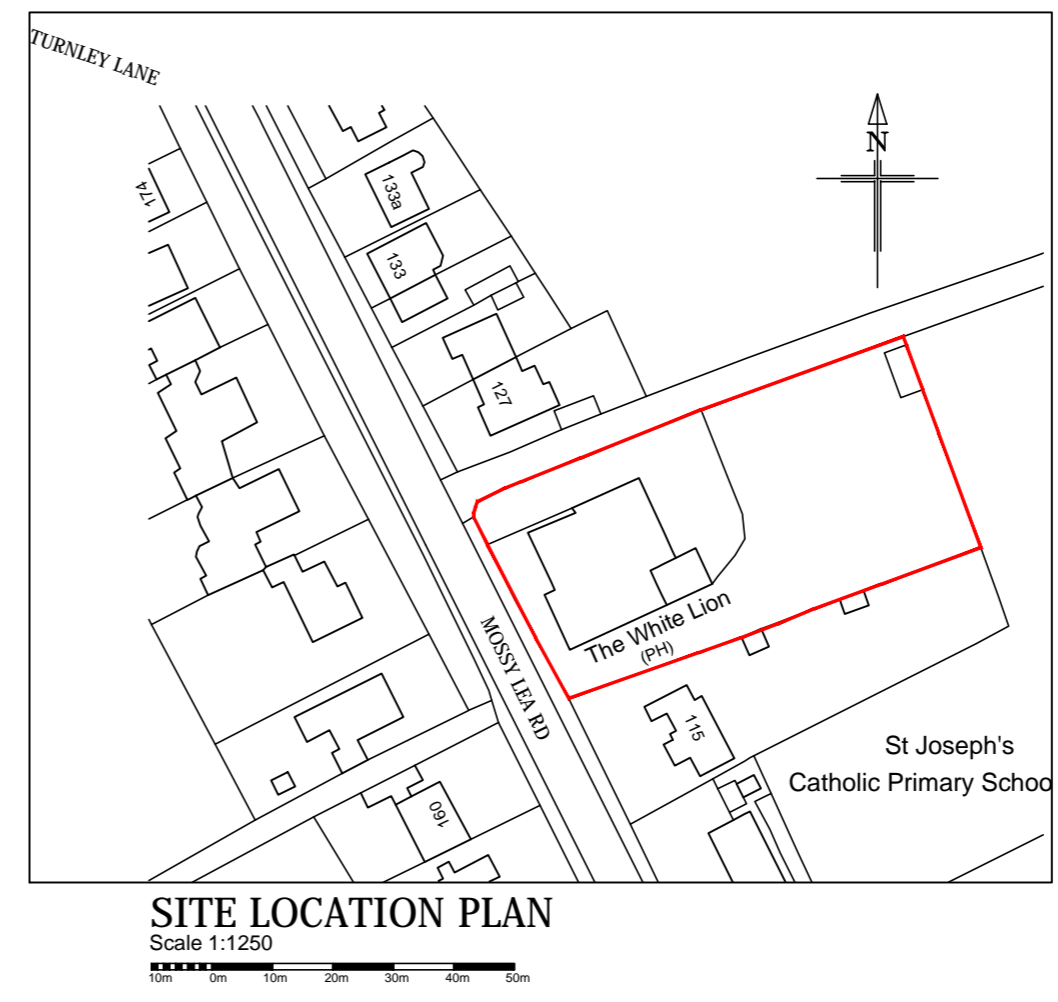
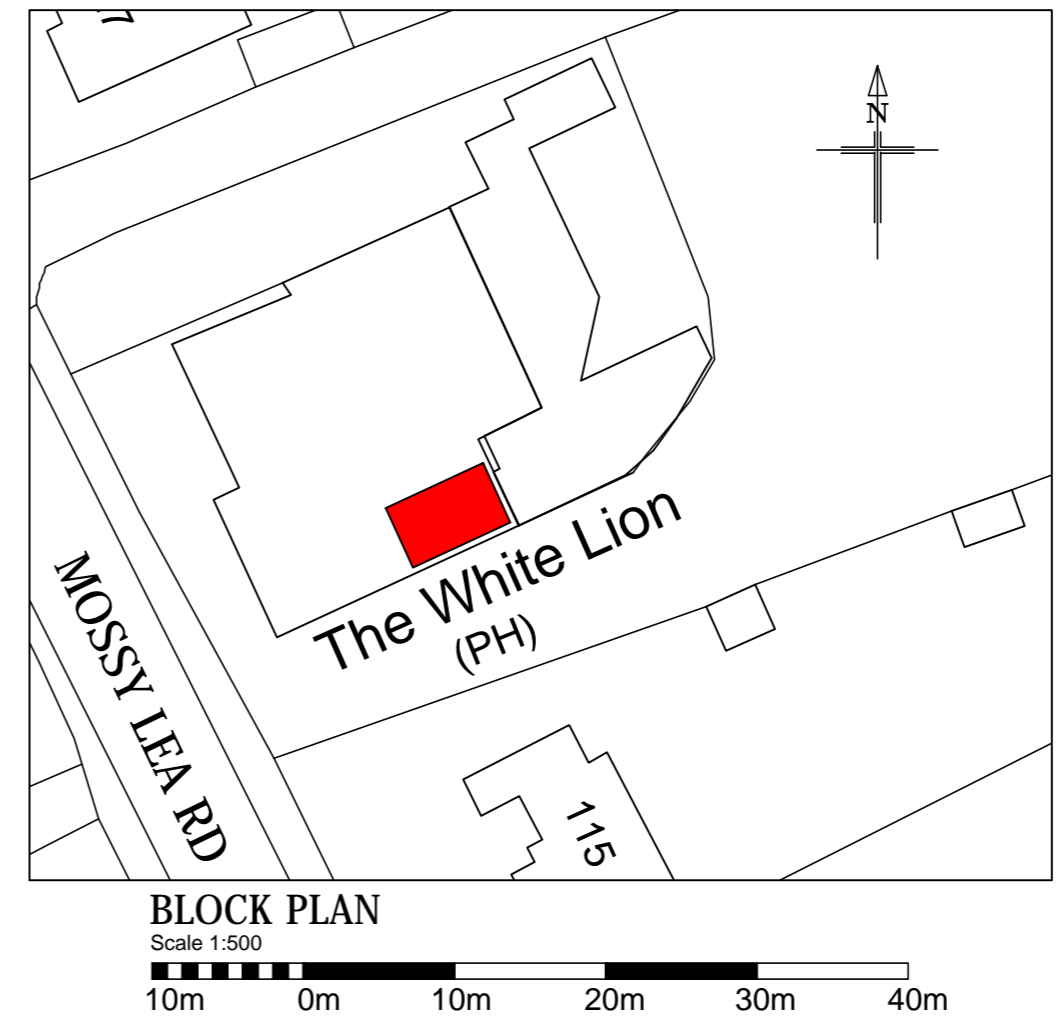
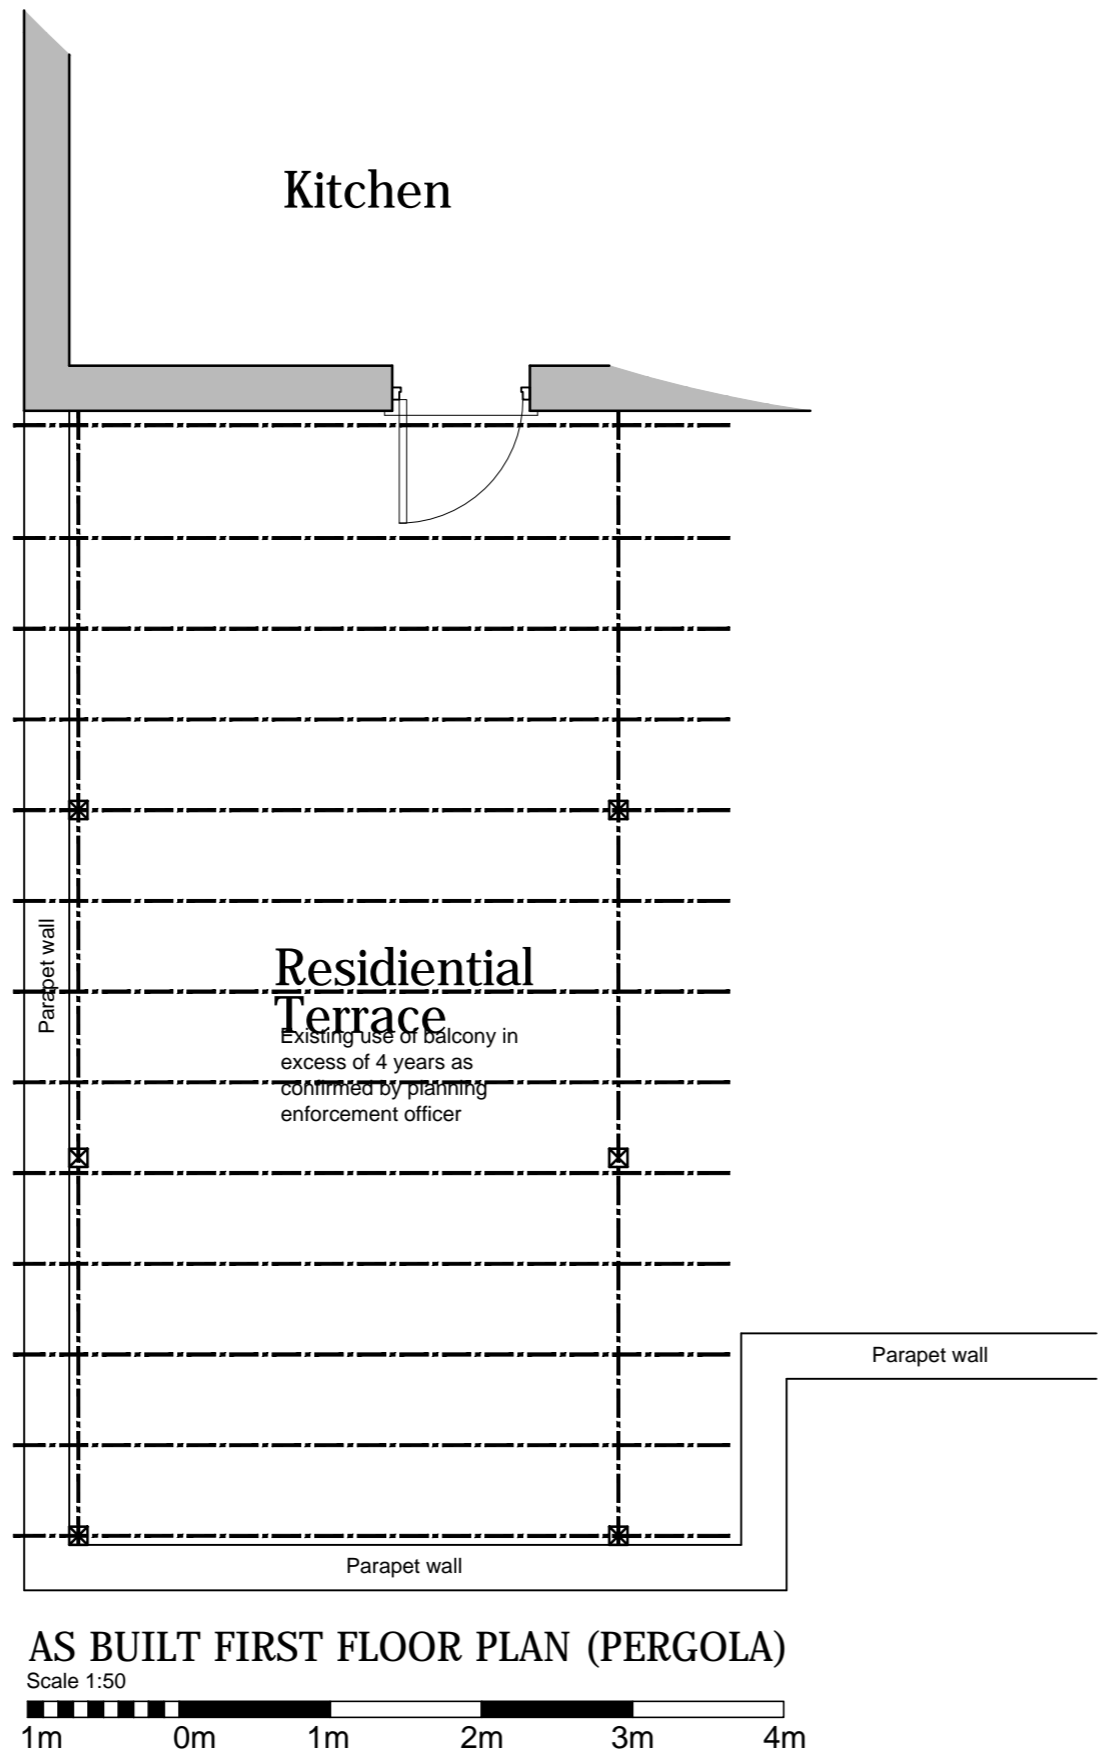
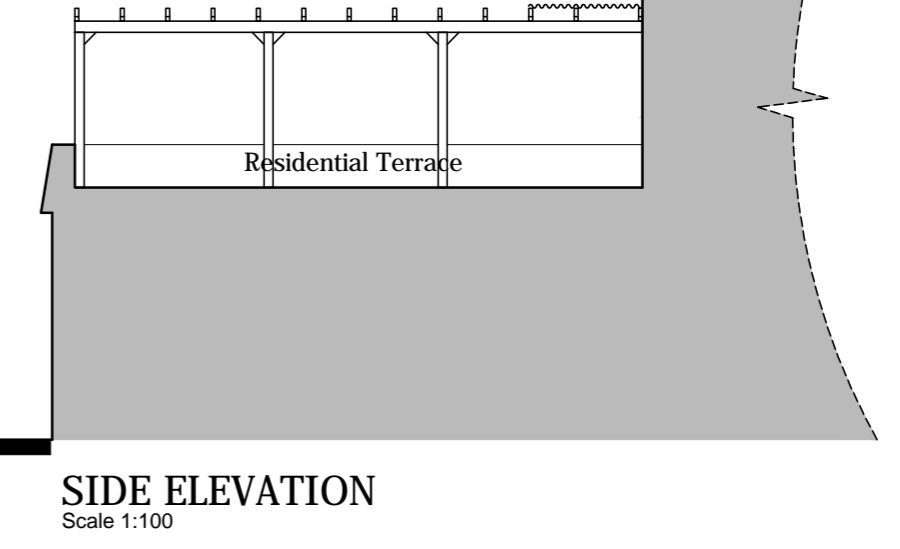
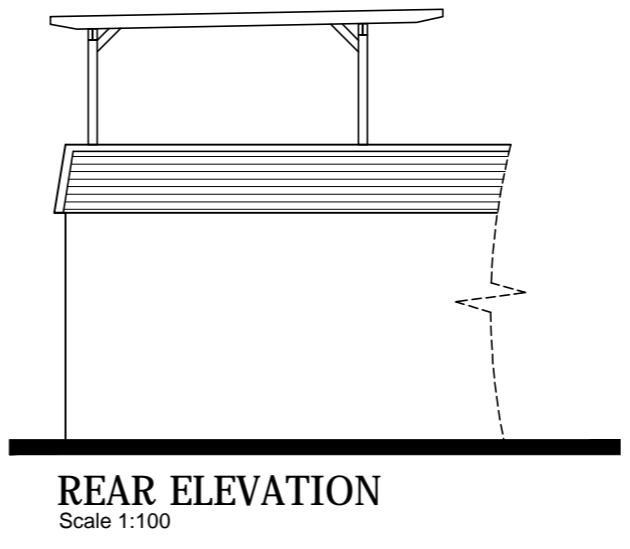



# THE WHITE LION, 117 MOSSY LEA RD

**THIS DRAWING IS FOR PLANNING SUBMISSION PURPOSES ONLY "RETENTION OF STRUCTURE"**

For the plan to be in scale, the above scale bar must measure correct. e.g. 5 centimetres when printed

**General Notes:**  
 This drawing/design is for use solely in connection with the project. This drawing/design is the copyright of the designer and must not be reissued, loaned or copied without written consent. All dimensions to be checked on site prior to commencement of work and any discrepancy shall be immediately reported and resolved prior to work commencing. This drawing is to be read in conjunction with all relevant drawings and specifications relating to the job whether or not indicated on the drawing.

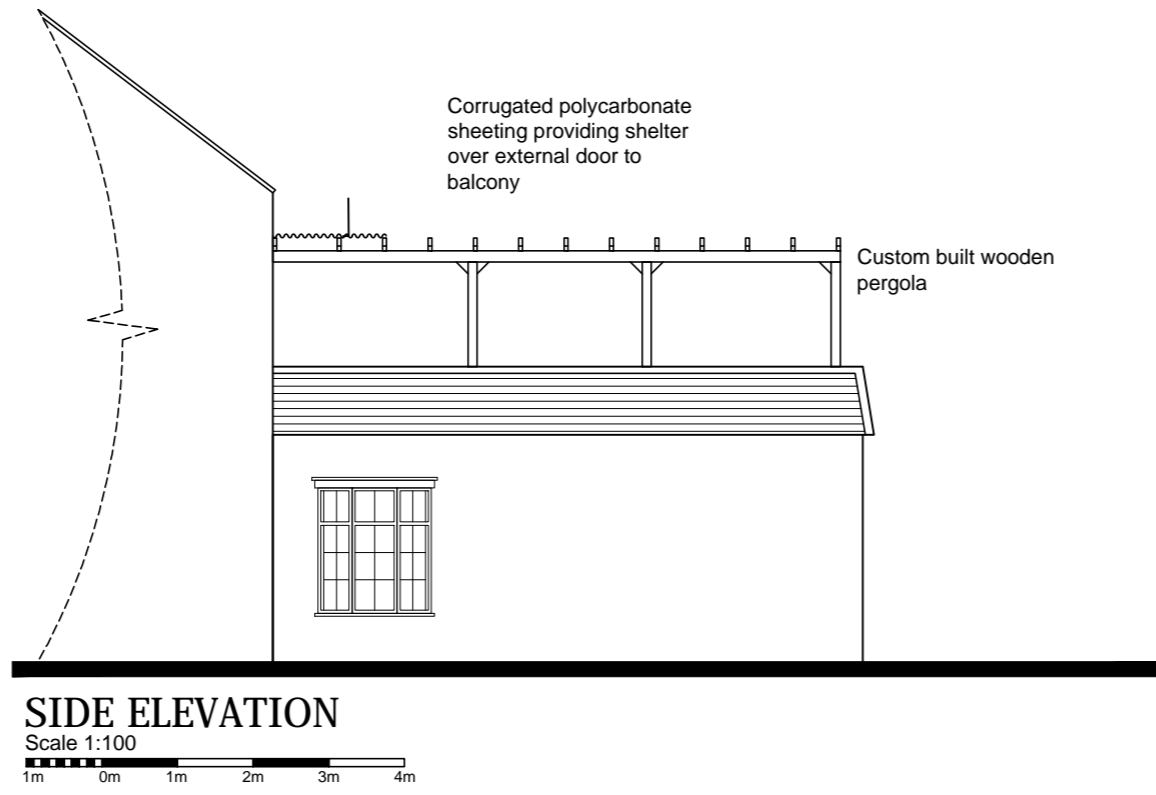

Rev.	Description	Date
 River Lodge, Walton Green, Walton Le Dale, Preston, PR5 4JL tel : 0780 3011130		
Client		
<b>THE WHITE LION</b>		
Project		
117 MOSSY LEA RD WRIGHTINGTON WIGAN WN6 9RE		
Drawing Title		
<b>AS BUILT FIRST FLOOR PLAN &amp; ELEVATIONS FOR PERGOLA OVER EXISTING BALCONY AREA</b>		
Scale	Date	
1:50 1:100 @ A2	NOV 2023	
Dwg No	Rev.	Job No
<b>PR-02</b>	-	<b>23-615</b>
Drawing Status		<b>PLANNING</b>