



FRONT ELEVATION

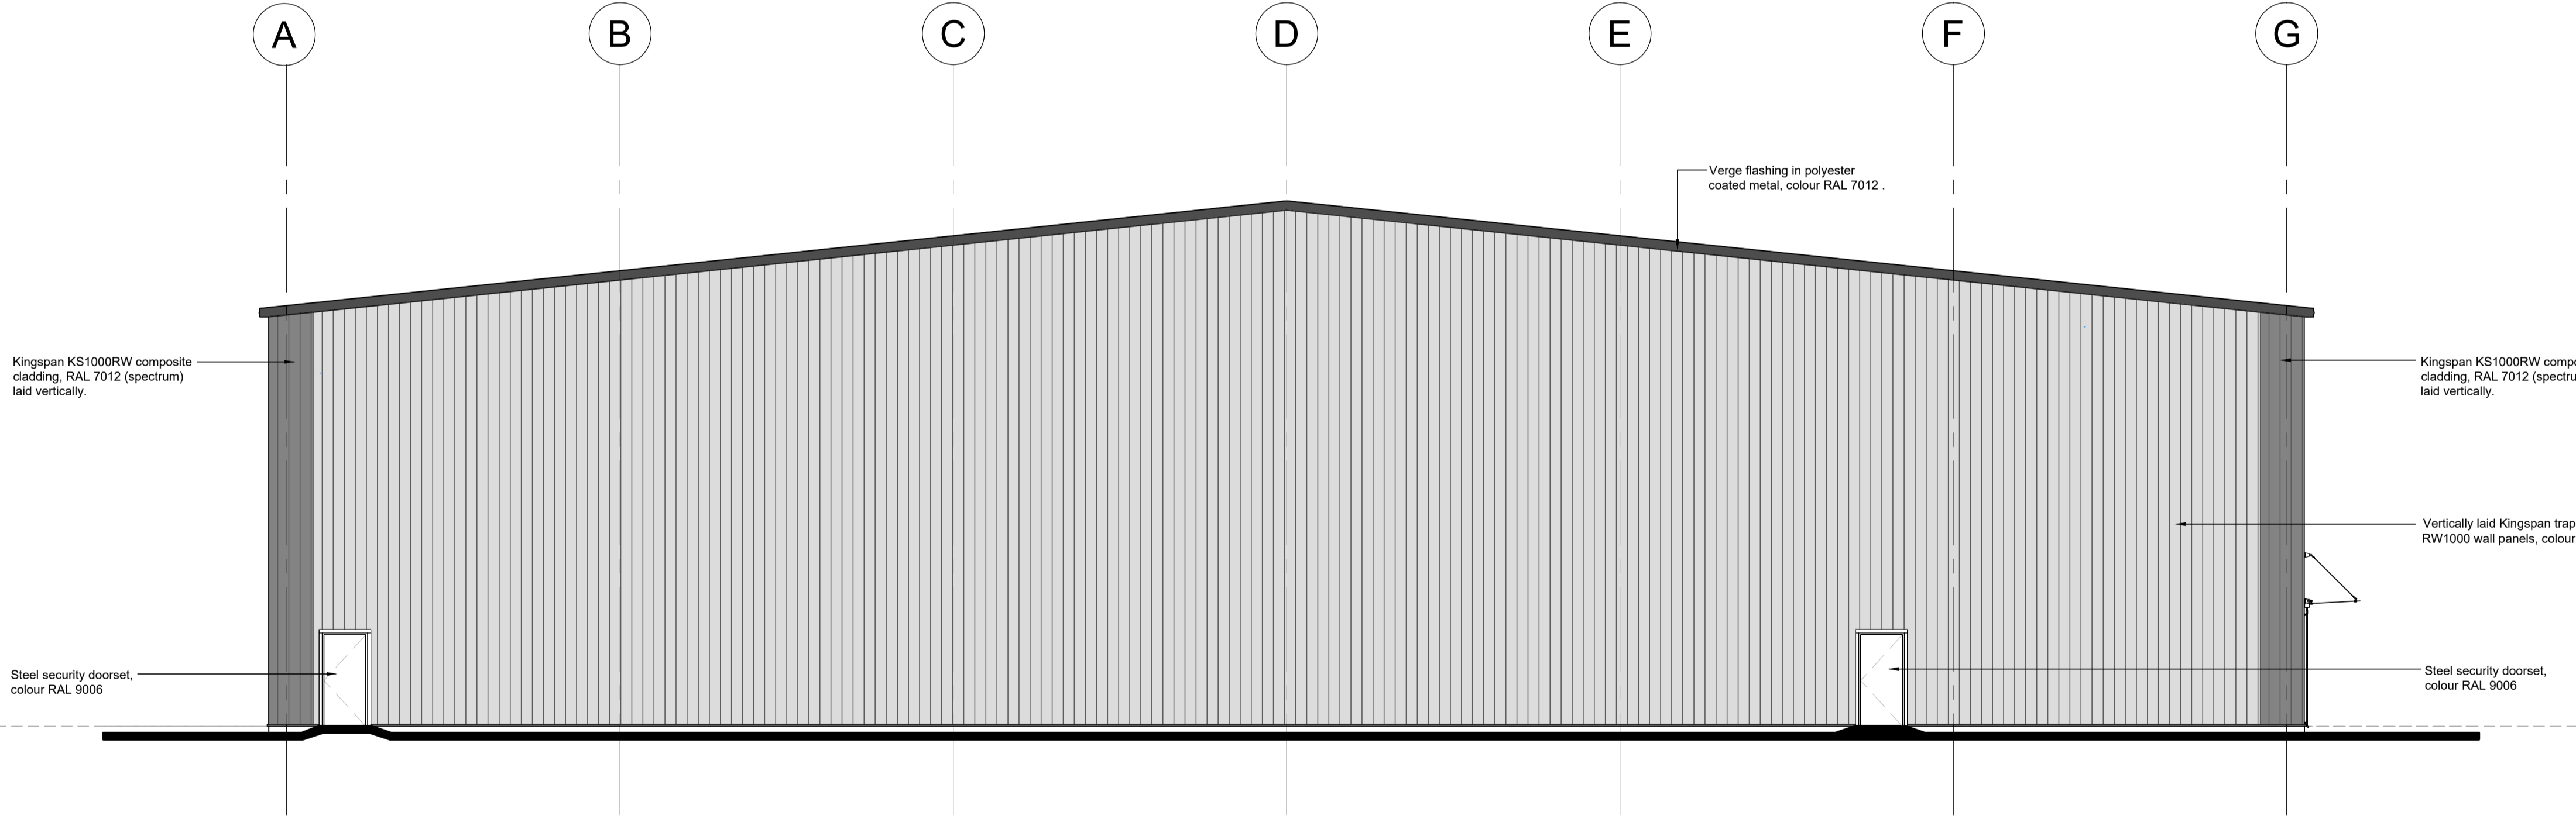

SIDE ELEVATION (FACING PLOT 8003)

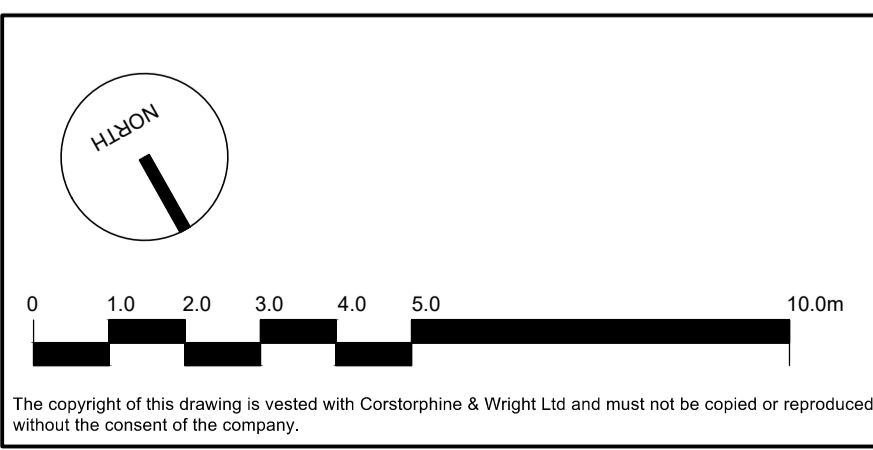

RECORD DRAWING

The information shown on this drawing reflects details originally incorporated or varied by Corstorphine + Wright and only such other variations as have been advised to them by other parties. Corstorphine + Wright cannot guarantee that such detail shown has been worked to.

Rev.	Description	Date	Drawn	Chk.
C-02	Record drawing issue.	26.01.22	TA	PH
C-01	RAL colour updated to loading doors.	28.08.21	TA	PH
C-00	Construction issue	22.07.21	TA	PH
P-00	Preliminary issue	25.06.21	TA	PH

Client
BENNIMAN

Project
**TOURNAMENT FIELDS
PLOT 8002 & 8003**

Drawing Title
**GA ELEVATIONS - SHEET 1
PLOT 8002**

Drawing Status
CONSTRUCTION

Corstorphine & Wright

Warwick Studio
Brook Hall, Brook Street, Warwick, CV34 4BL
01926 658 444
corstorphine-wright.com

Drawing No.
19562 - 2003

Revision
C-02

Drawn	Checked	Paper Size	Scale	Date
TA	PH	A1	1:100	07.06.21