
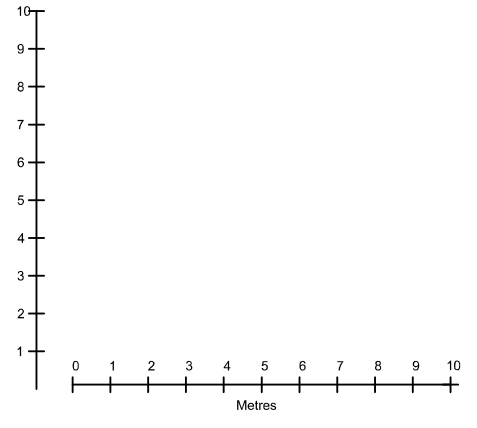


Pye Corner

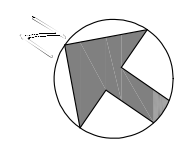

As Built Block Plan 1/200

Drawing No. NH/172/06