



Front Elevation

Rear Elevation

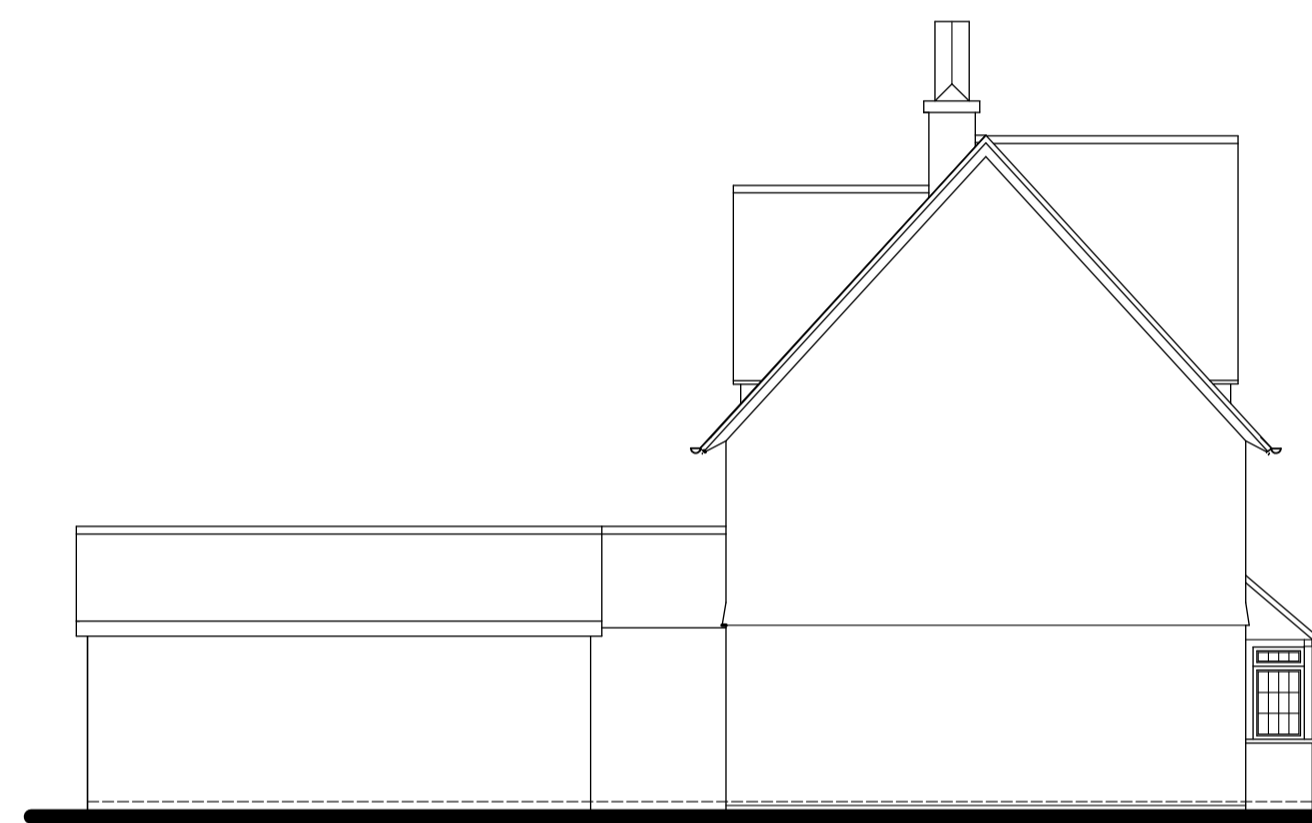


Side Elevation

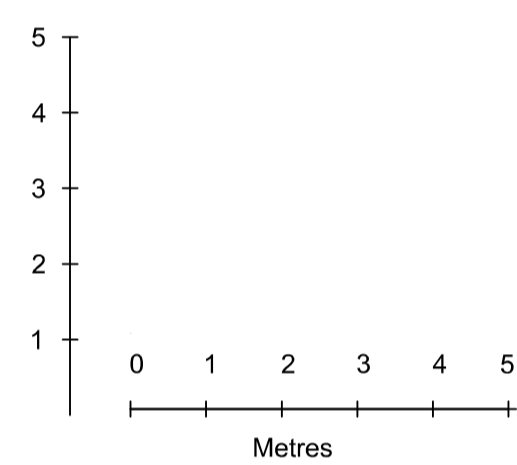


Side Elevation


**Elevational Materials**  
 Walls :- Tile hanging and render  
 to match existing  
 Roof :- Plain tiles to match existing on main roof  
 Slates to match existing on single storey roof

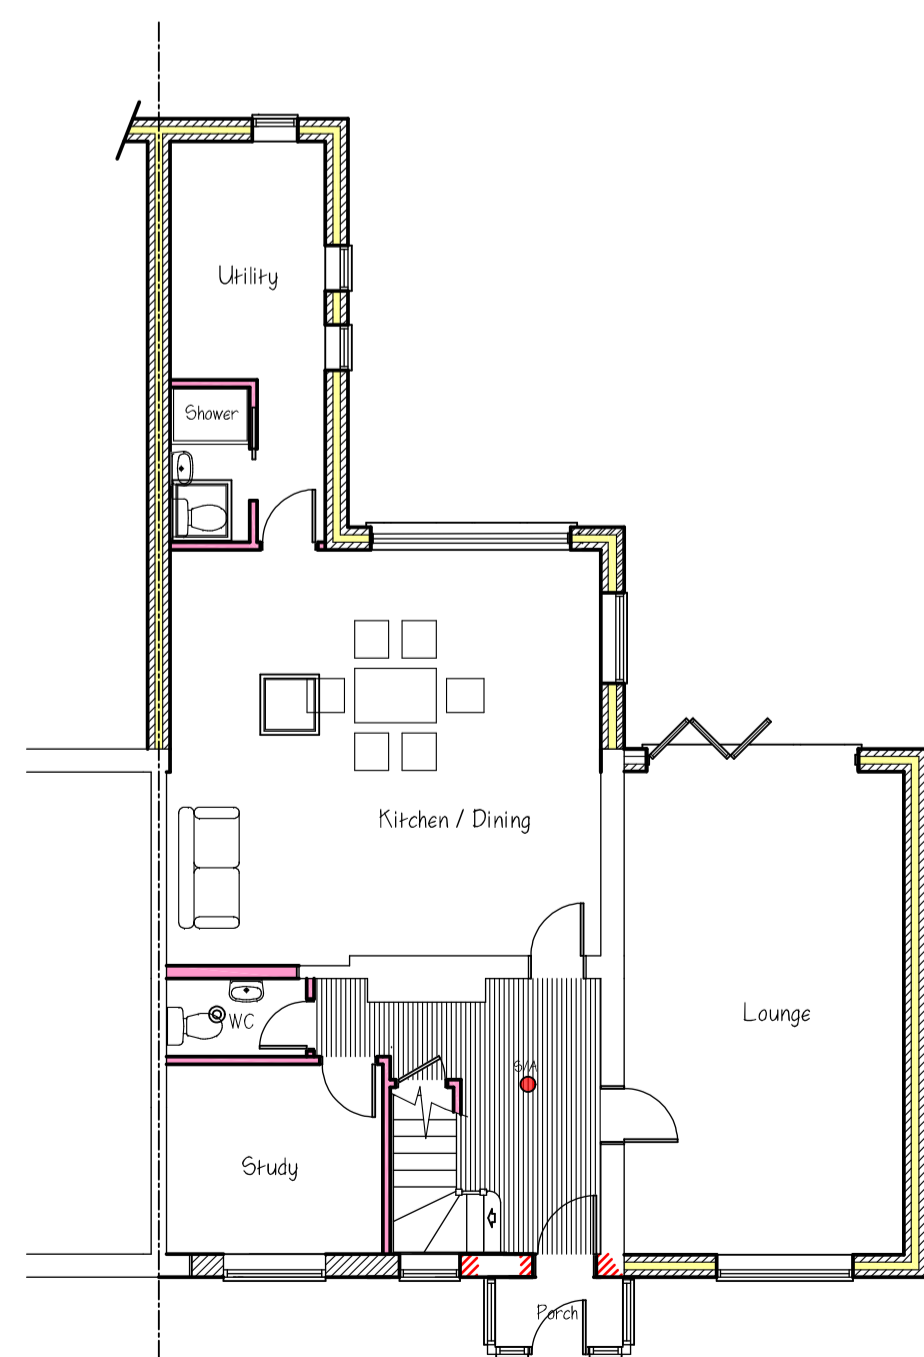


Ground Floor Plan

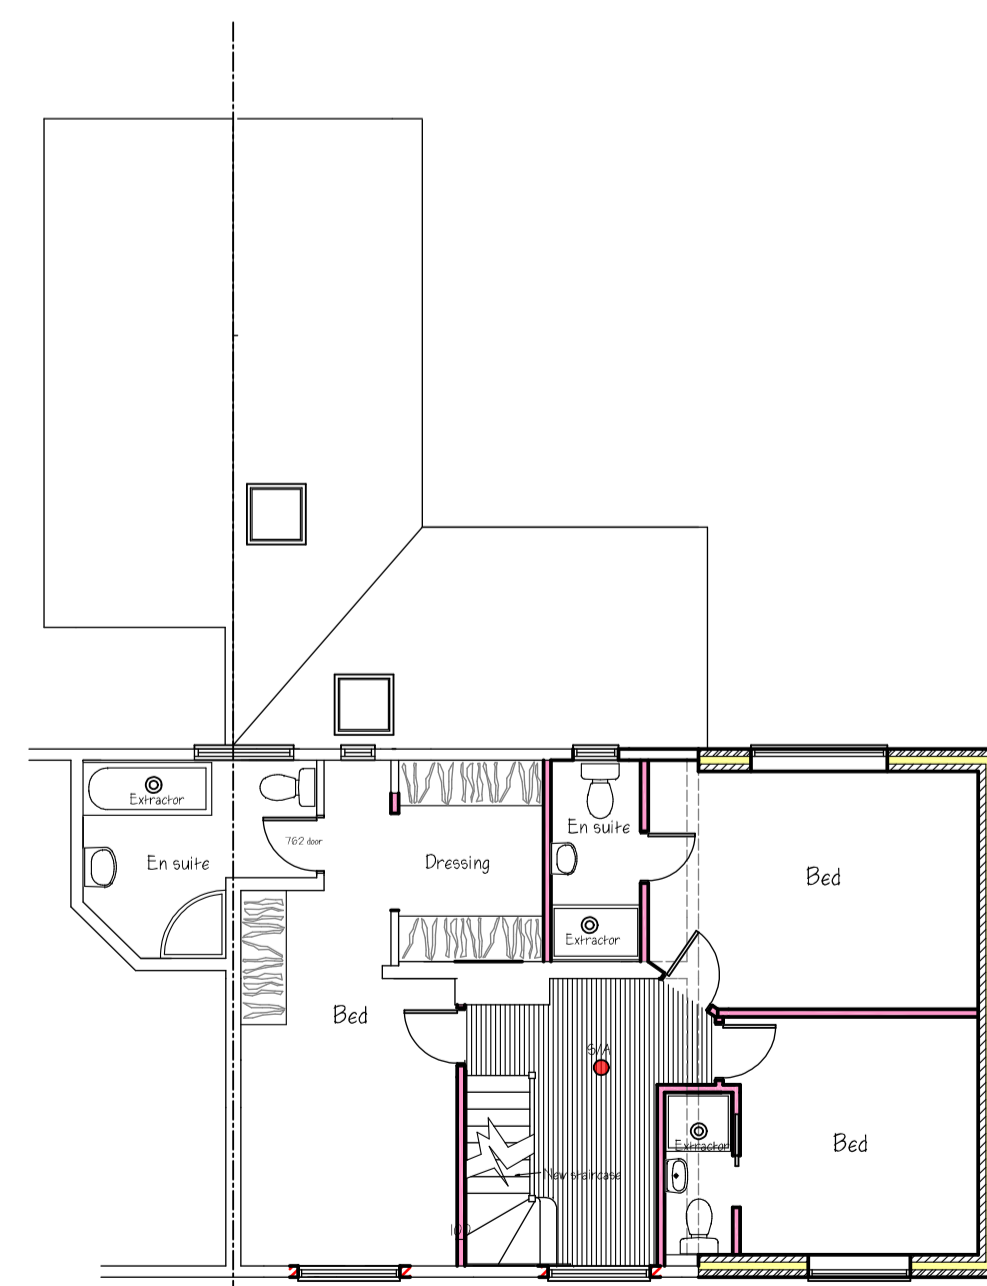

First Floor Plan

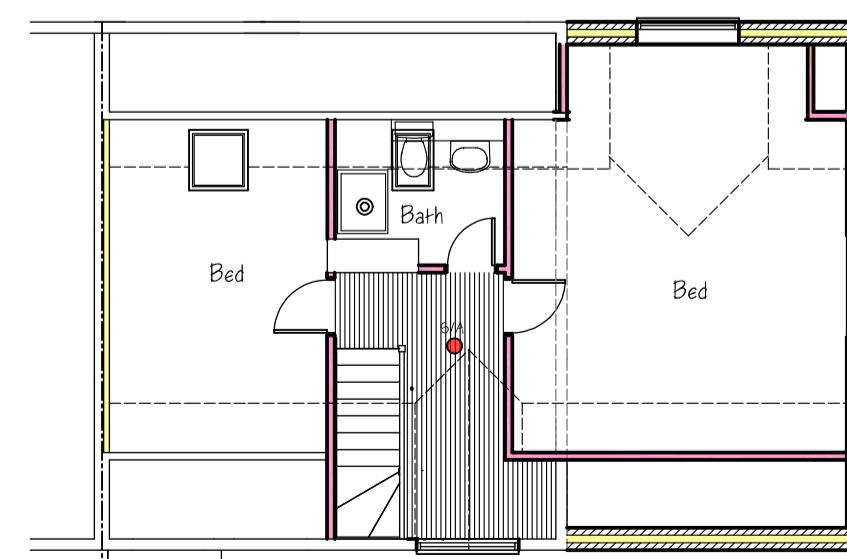

Second Floor Plan

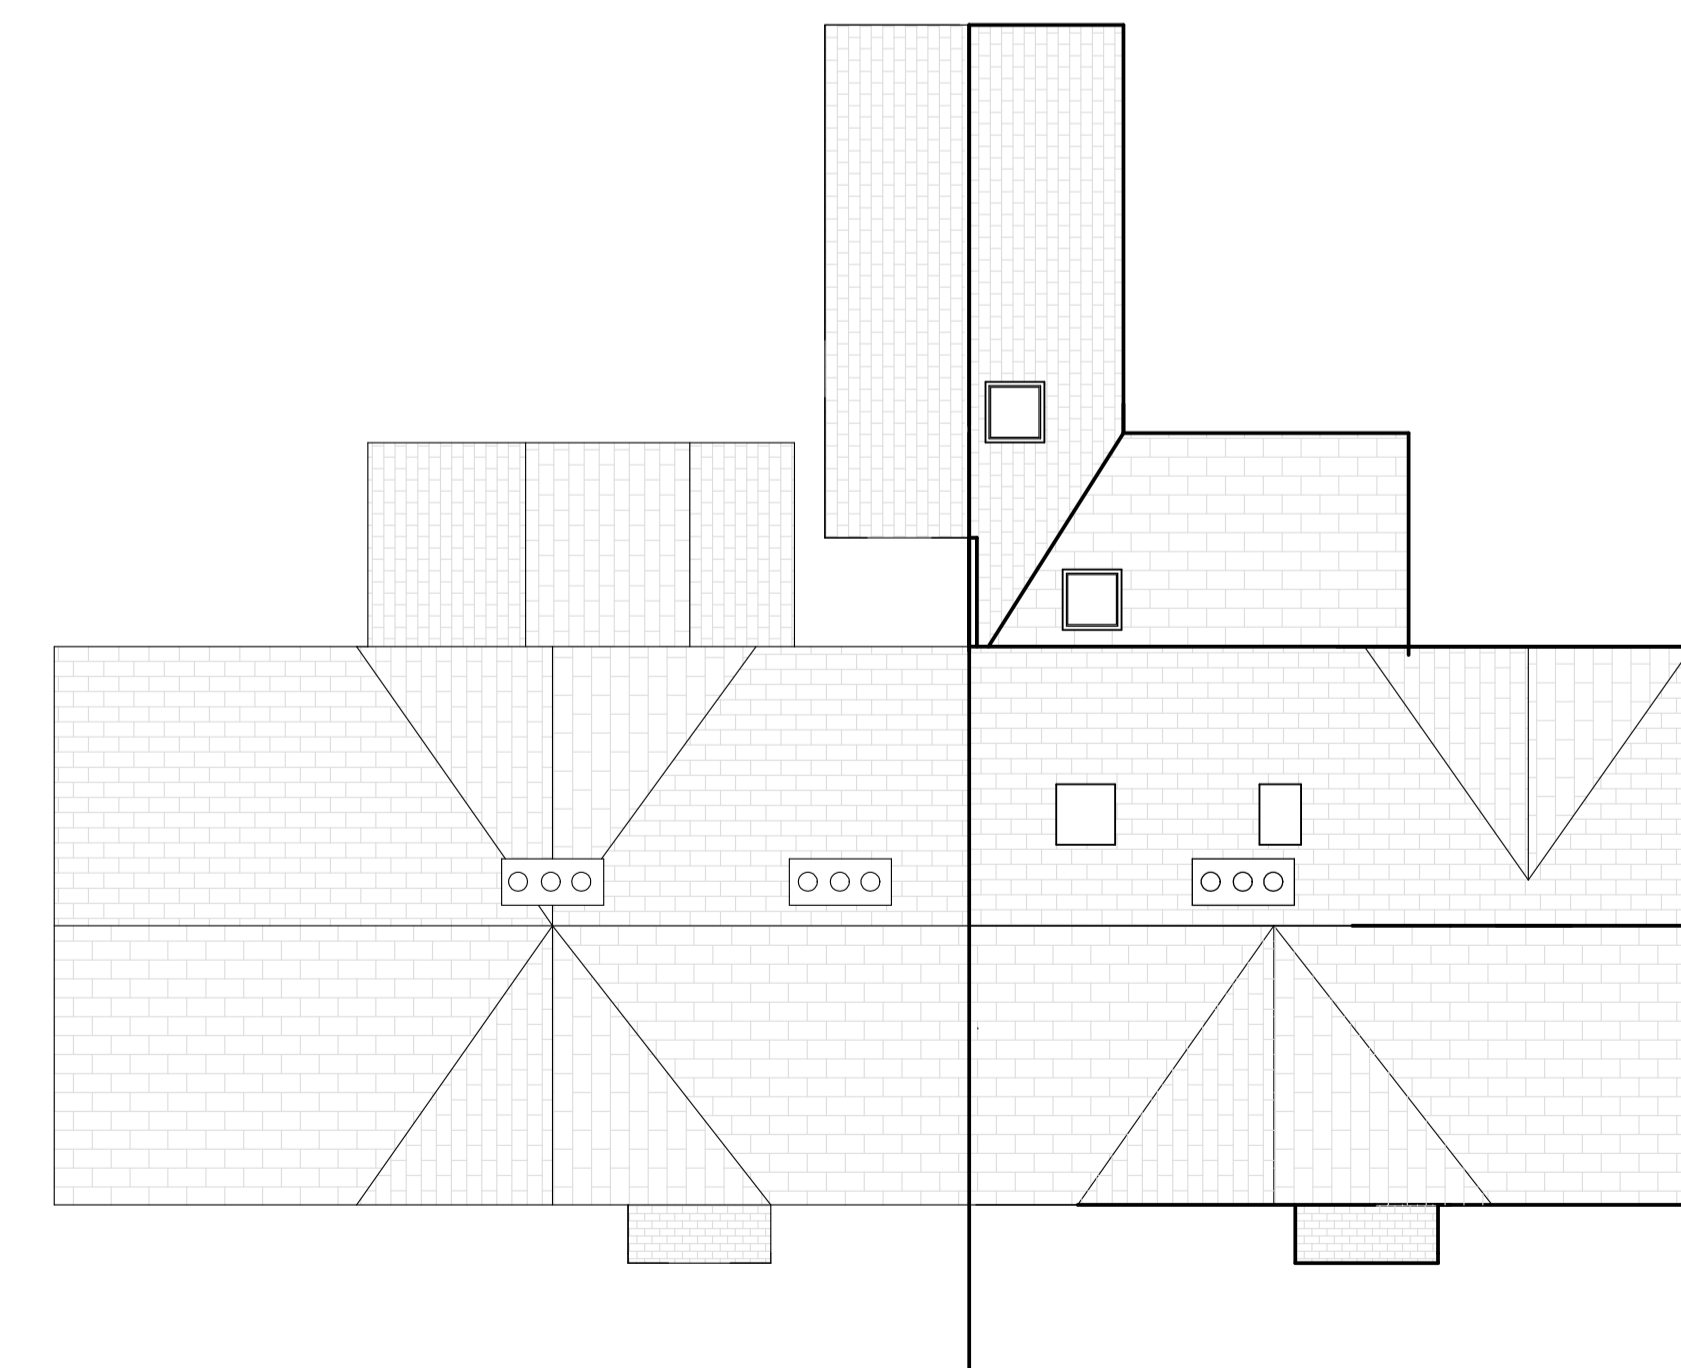

Proposed revision to as built  
 Roof Plan

**MONARCH**  
 Design and Build Ltd

9 Bury Lane  
 Bramfield  
 Hertfordshire  
 SG14 2QL  
 Tel: 01992 500008  
 Mobile: 07812 243399  
 Email: nethankins@hotmail.com

**Project**  
 Proposed two storey side and  
 single storey rear extensions  
 36 Pye Corner  
 Gilston  
 Herts

**Drawing Title**  
 Proposed revision to As built :-  
 Plans and Elevations  
 Roof Plan

Scale 1/100 @ A1	Date Nov 2023	Drawn by NH
---------------------	------------------	----------------

Drawing No. NH/172103	Rev.
--------------------------	------