



Pye Corner

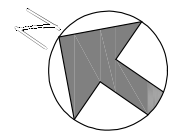

Drawing No. NH/172/07

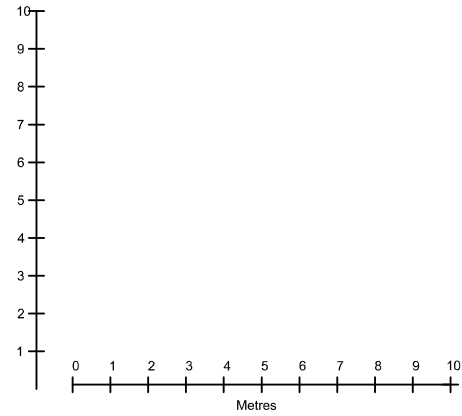

Proposed revision to as built Block Plan 1/200