



Front Elevation

Rear Elevation


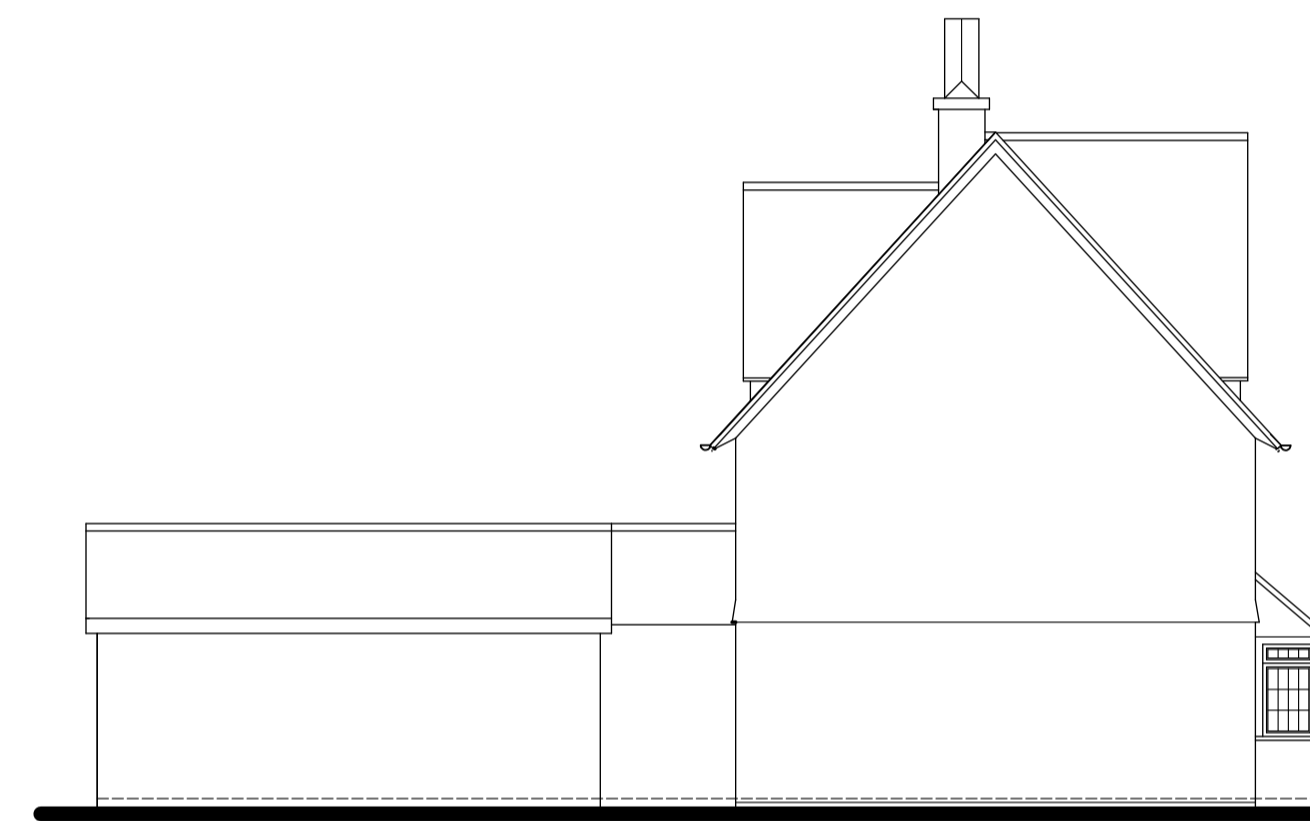


Side Elevation

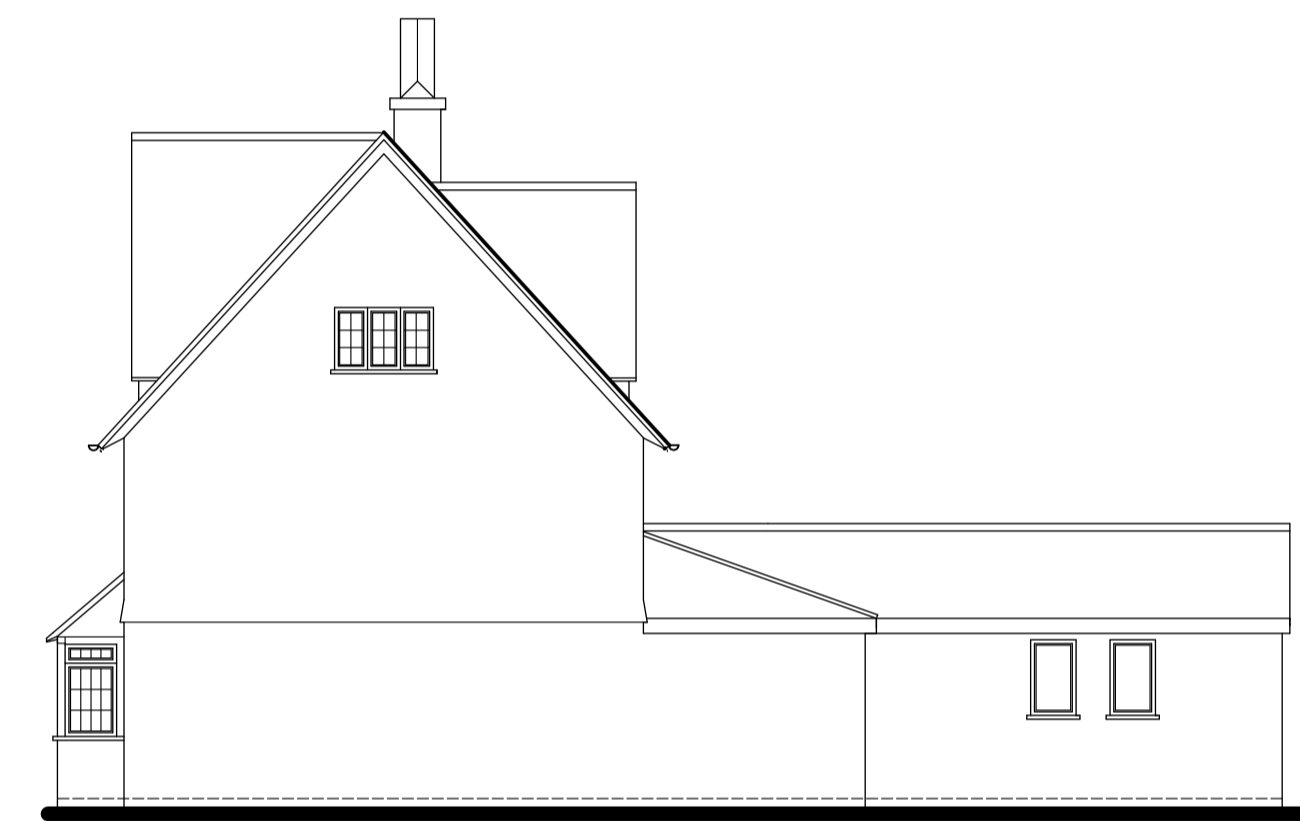


Side Elevation


Elevational Materials
 Walls :- Tile hanging and render to match existing
 Roof :- Plain tiles to match existing on main roof
 Slates to match existing on single storey roof

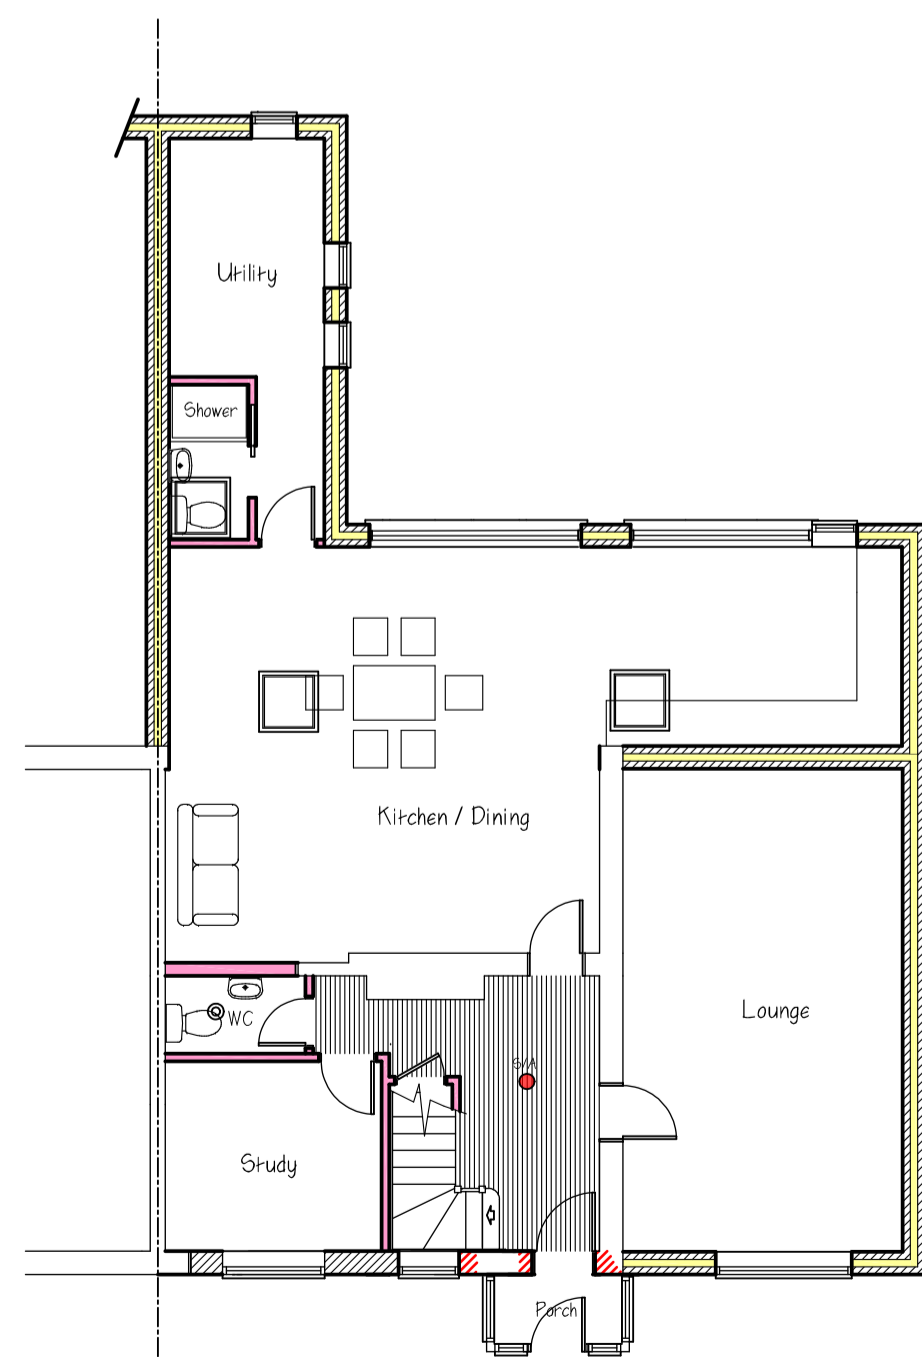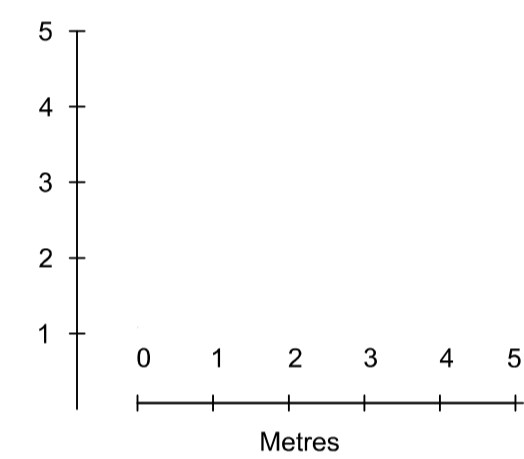


Ground Floor Plan

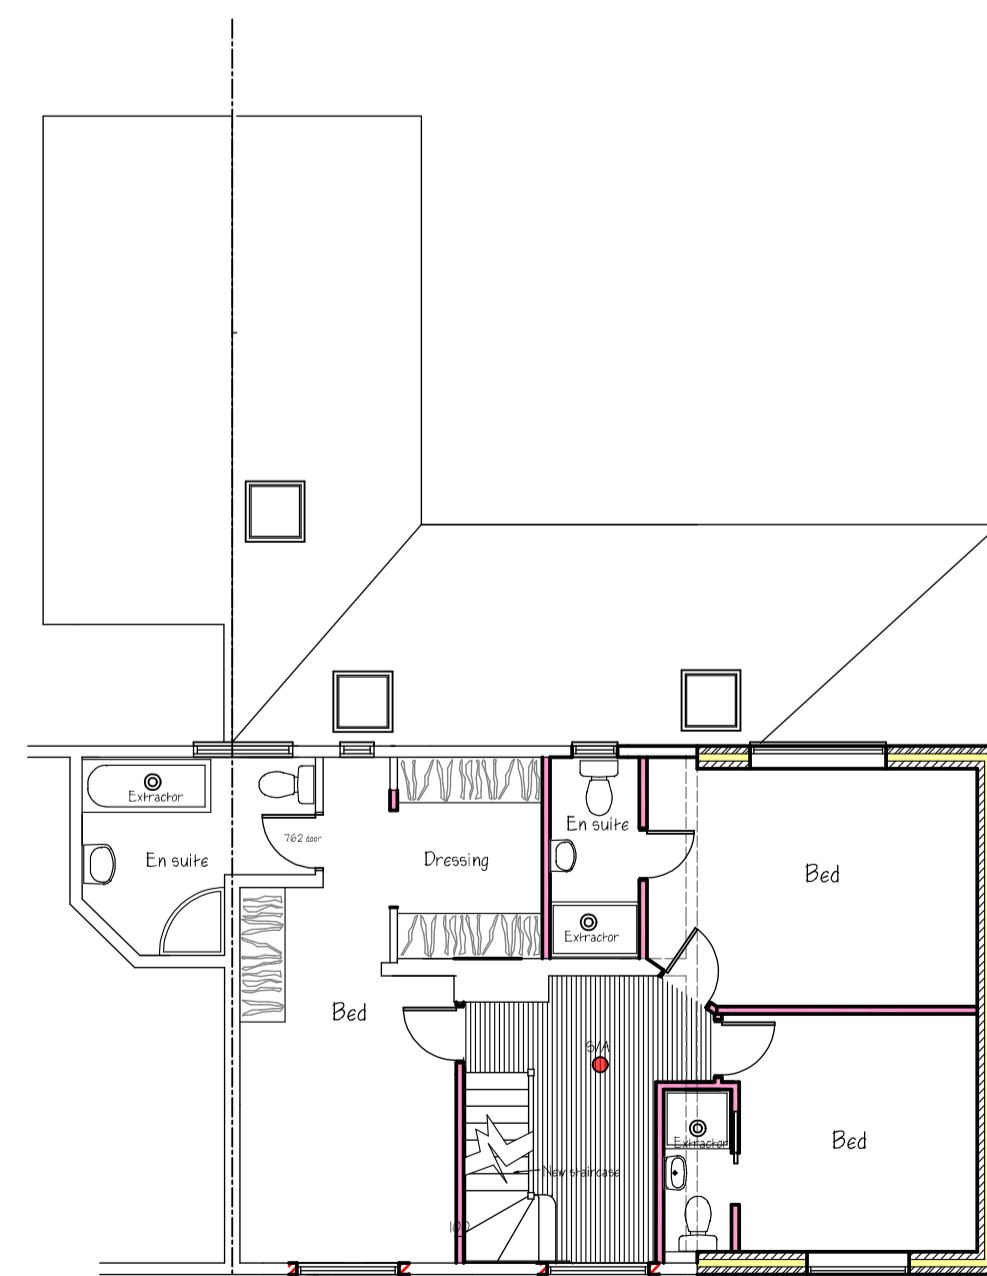

First Floor Plan

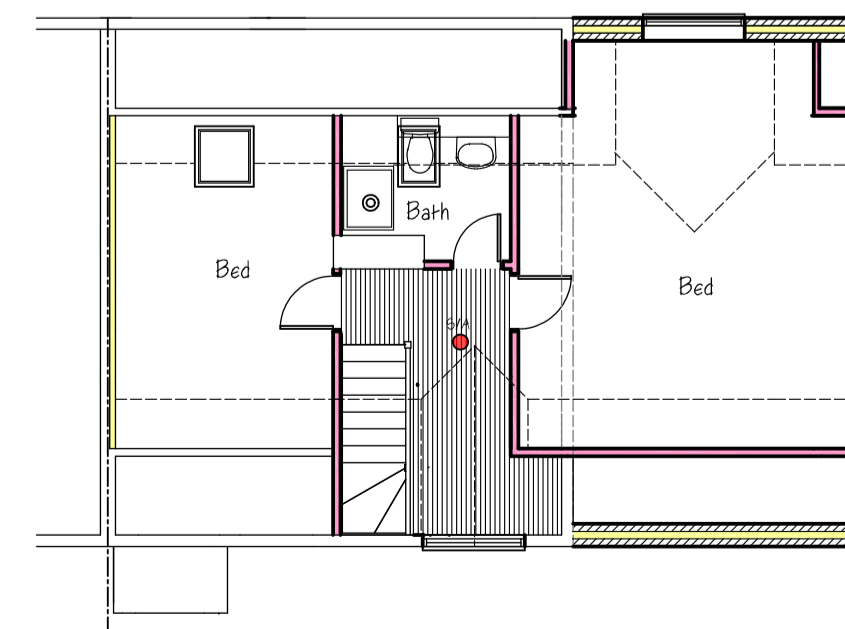

Second Floor Plan

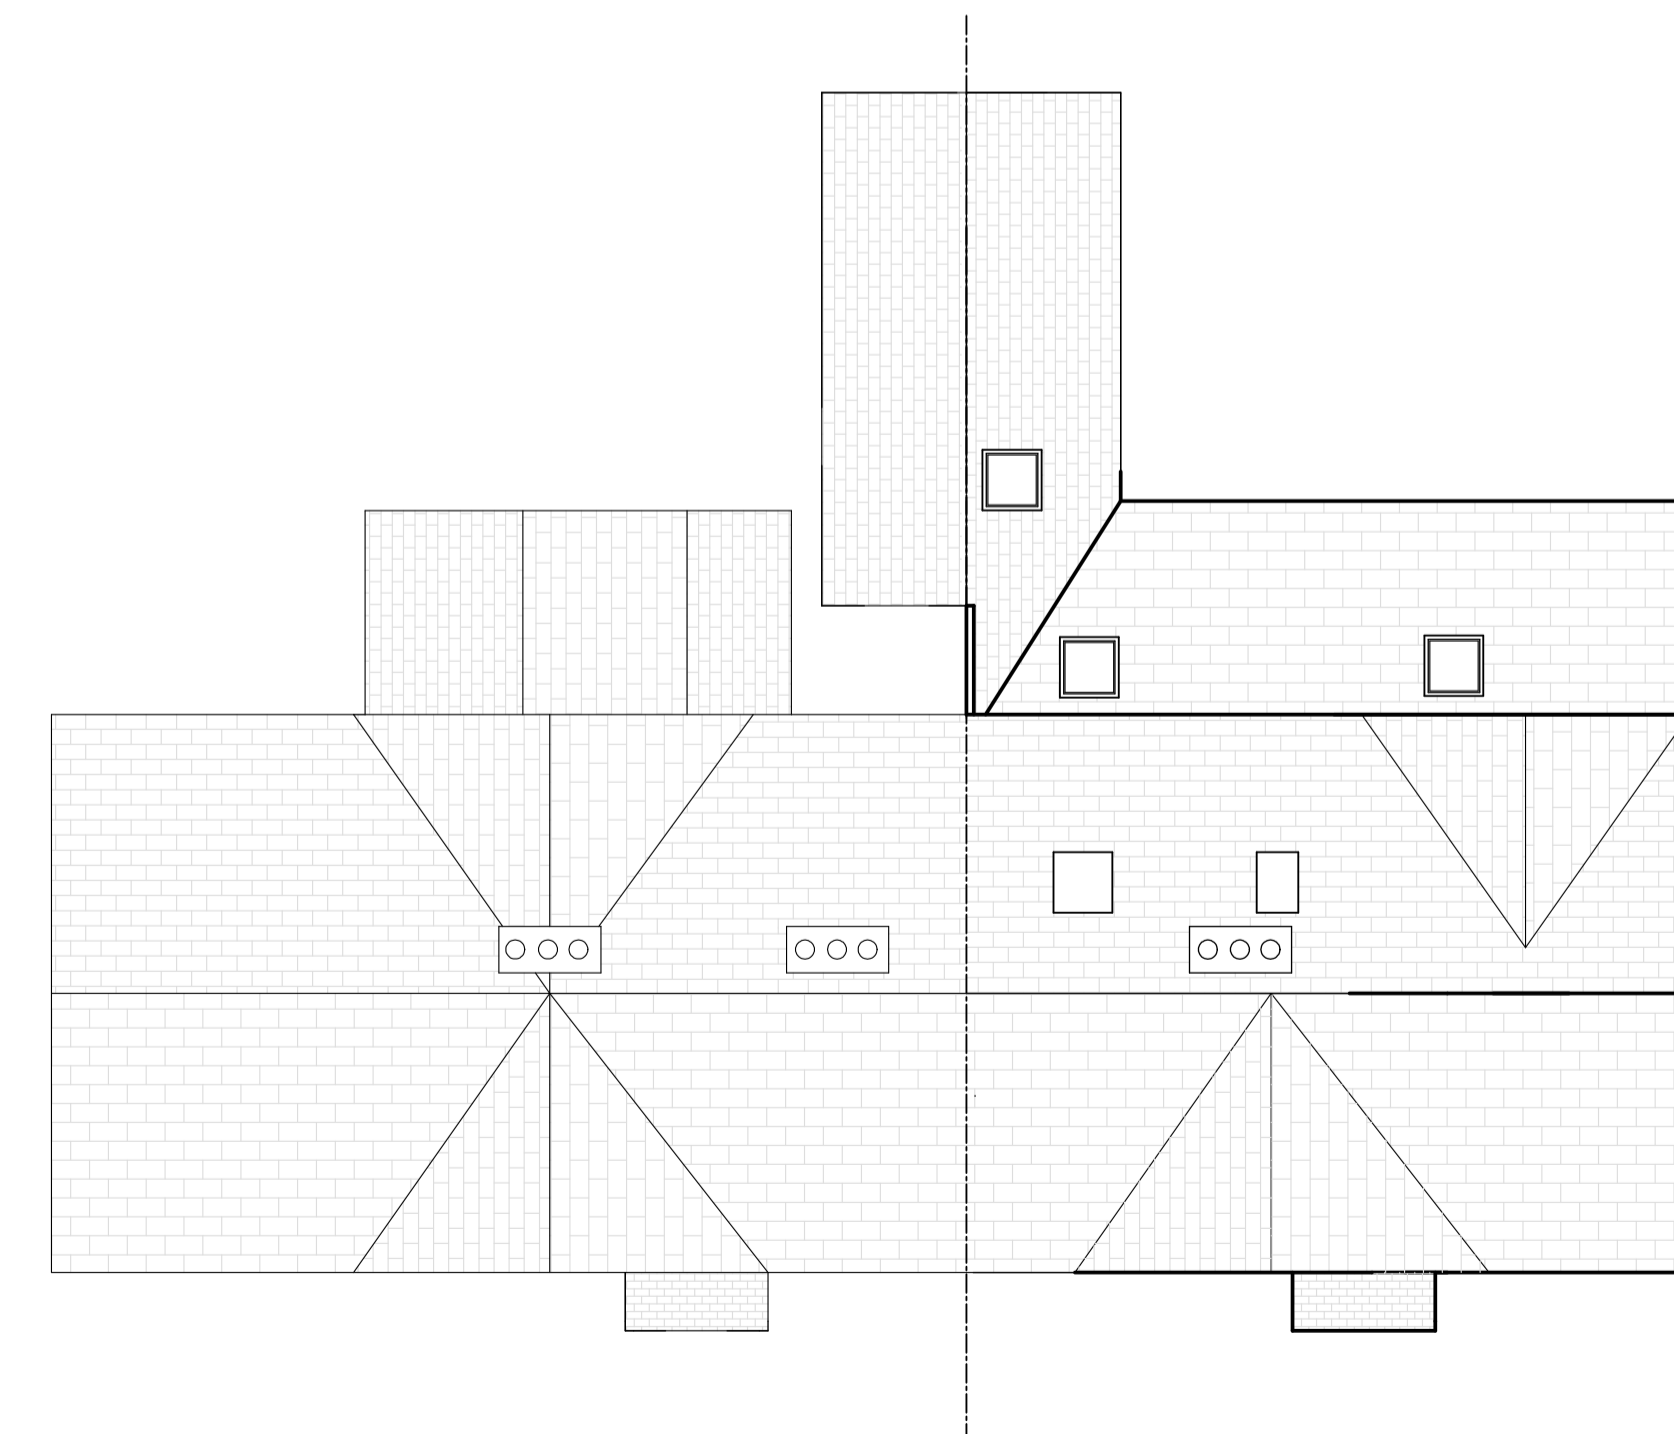

As Built Roof Plan

MONARCH Design and Build Ltd

9 Bury Lane
 Bramfield
 Hertfordshire
 SG14 2QL
 Tel: 01992 500008
 Mobile: 07812 243399
 Email: nethankins@hotmail.com

Project
 Proposed two storey side and single storey rear extensions
 36 Pye Corner
 Gilston
 Herts

Drawing Title
 As built :-
 Plans and Elevations
 Roof Plan

Scale 1/100 @ A1	Date Nov 2023	Drawn by NH
Drawing No. NH/172/102		Rev.