

© Copyright Gforce Surveys

Grid North
Datum Reference = Ordnance Survey

Topographical Survey Legend



- Bank Top: Dashed orange line
- Bank Bottom: Dashed purple line
- Contour Line Major: Solid red line (100.00)
- Contour Line Minor: Dashed yellow line (50.00)
- Fence Line: Dashed red line
- Kerb Line: Dashed blue line
- Overhead Cables: Dashed red line with 'x' marks
- Road Centre: Dashed blue line
- Hard Surface Edge: Dashed blue line
- Wall: Solid blue line
- Vegetation: Wavy green line
- Tree: Green circle with a red dot
- Gate: Red rectangle
- Lamp Post: Circle with a cross
- Electricity Pole: Circle with a cross and a dot
- Telegraph Pole: Circle with a cross and a dot
- Spot Level: Circle with a cross and a dot
- Bore Hole: Circle with a cross and a dot
- Trial Hole: Circle with a cross and a dot
- BT: British Telecom
- CATV: Cable Tv
- ER: Earth Rod
- FH: Fire Hydrant
- FP: Flag Pole
- GAS: Gas Cover
- GY: Gully
- IC: Inspection Cover
- Manhole: Circle with a cross
- UTL: Unable To Lift
- MKR: Marker
- RE: Rodding Eye
- RWP: Rain Water Pipe
- SC: Skip Cook
- SVP: Soil Vent Pipe
- TK: Top Of Kerb
- TWL: Top Of Wall
- WAT: Water Cover
- UTL: Unable To Lift
- Survey Station: Triangle with a cross

Building Survey Legend

- Building Line: Solid black line
- Barge Board: Dashed red line
- Bathroom: Dashed blue line
- Beams: Dashed blue line
- Rain Water Pipe: Dashed blue line
- Ground: Solid grey area
- Heating: Dashed red line
- Kitchen: Dashed blue line
- Pipes: Dashed green line
- Roof Line: Dashed blue line
- Steps: Dashed red line
- Storage: Dashed blue line
- Ventilation: Dashed blue line
- Windows: Dashed blue line


Survey Control List

Station Type	Easting	Northing	Elevation
ST01 Nail	###	###	###
ST02 Nail	###	###	###
ST03 Nail	###	###	###

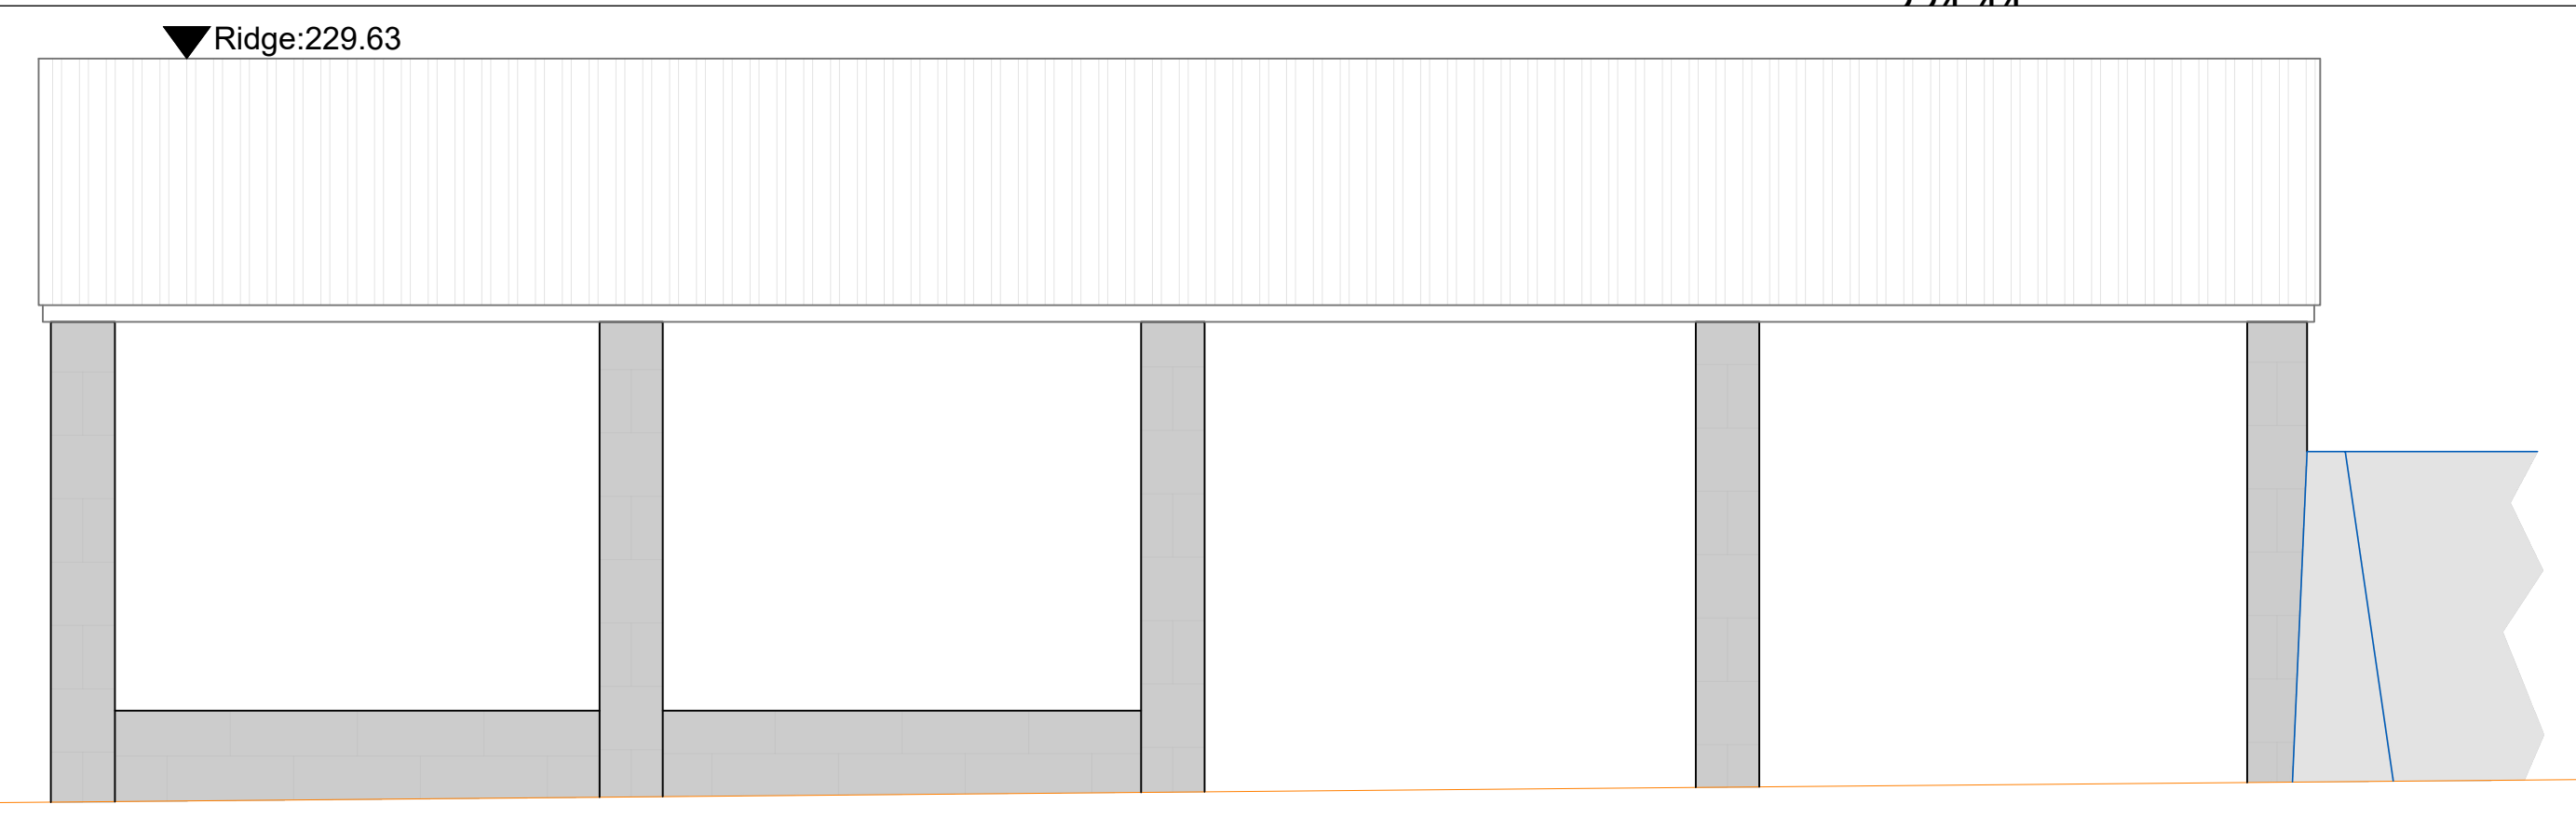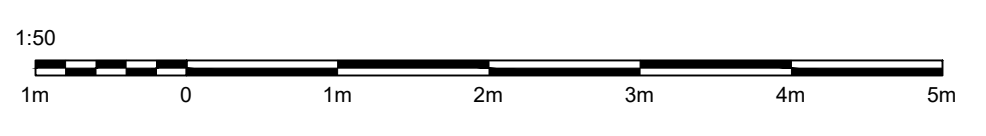


Datum : 223.00 AOD

NORTH EAST ELEVATION

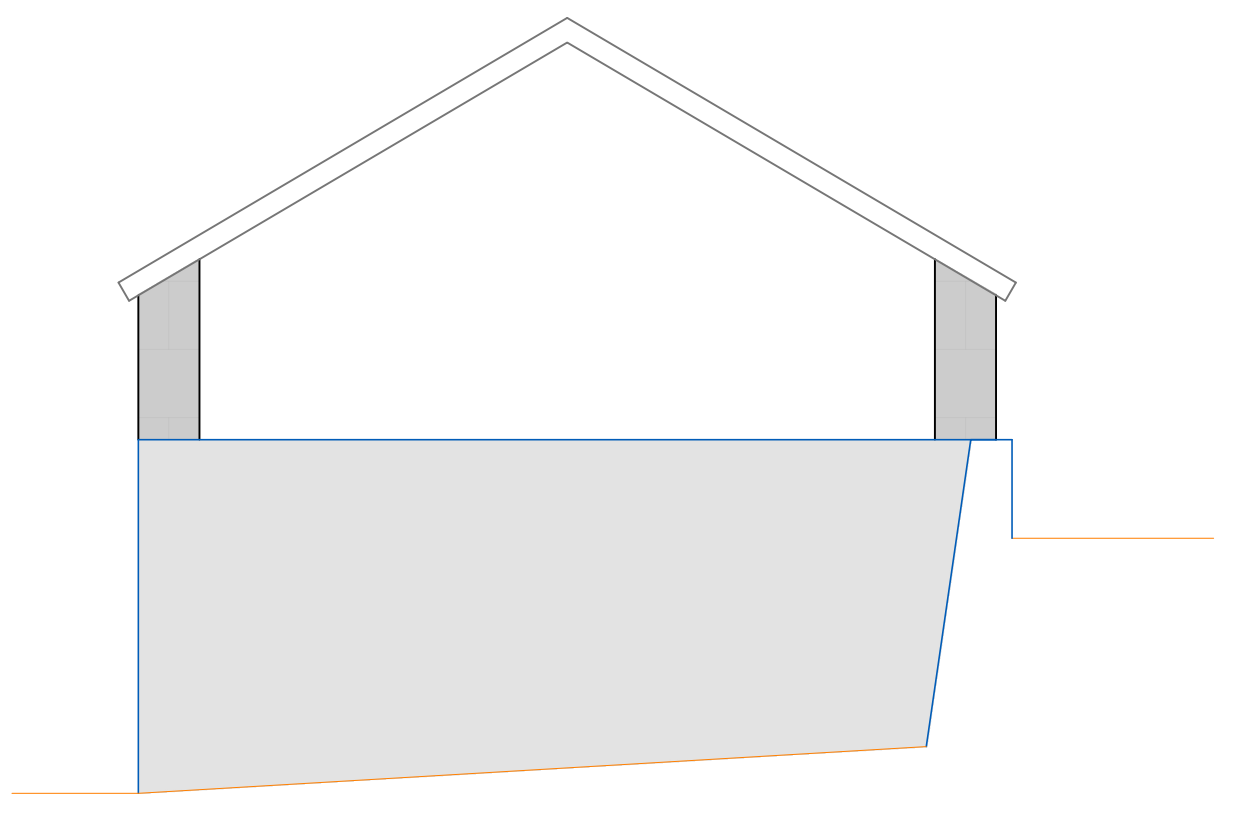


Datum : 223.00 AOD

NORTH WEST ELEVATION

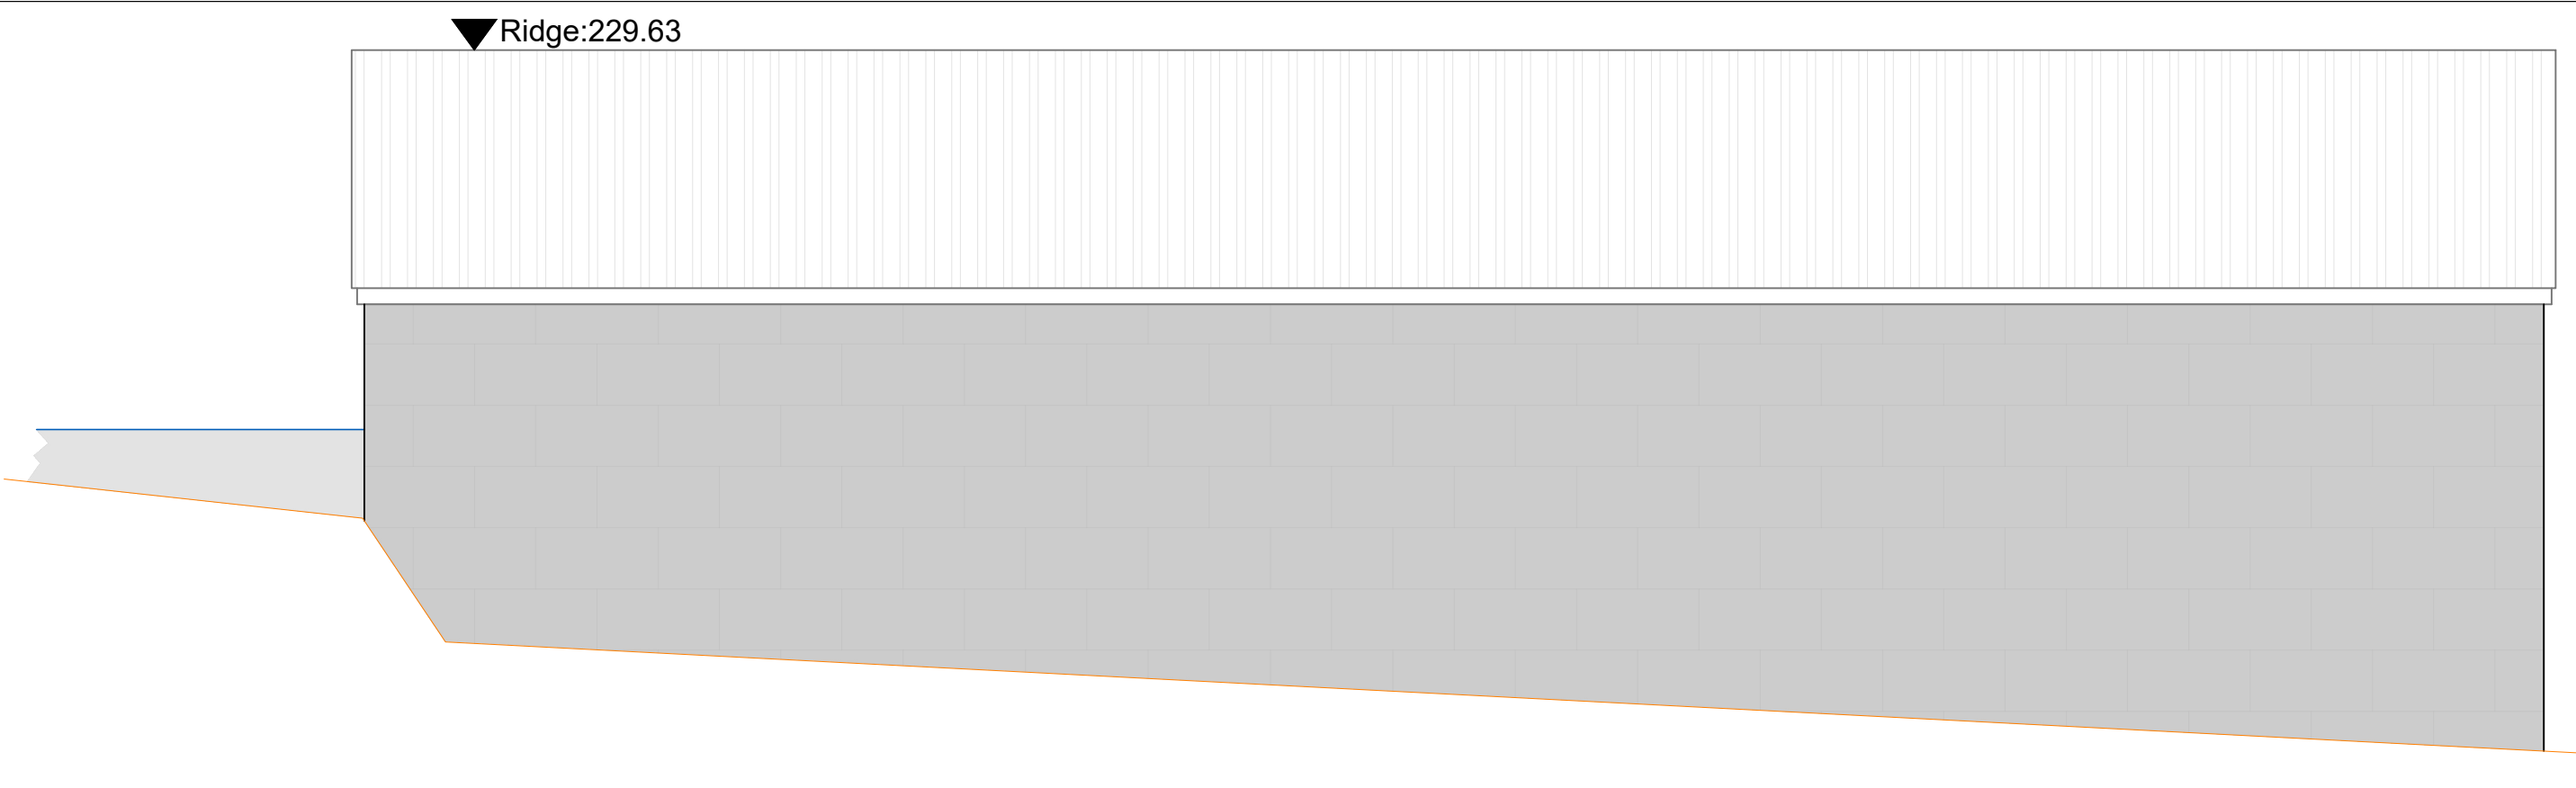


Datum : 223.00 AOD

SOUTH WEST ELEVATION

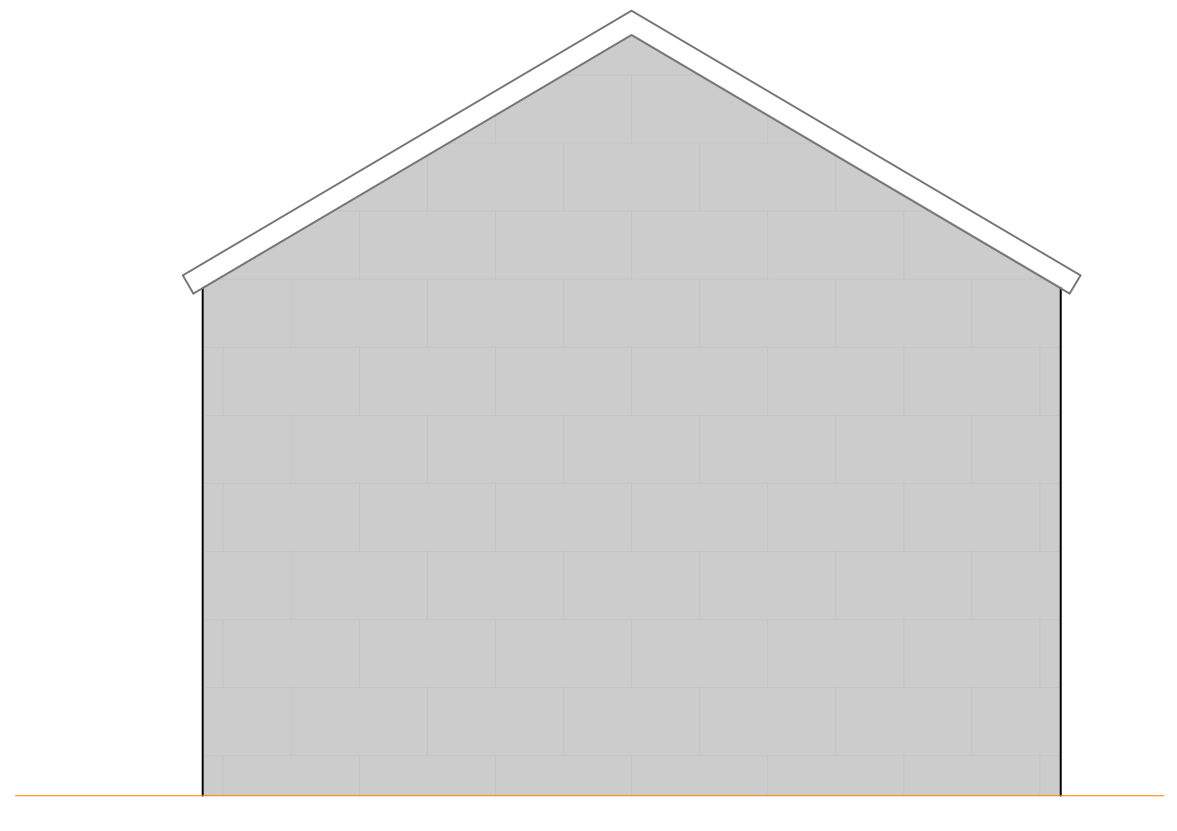

Datum : 223.00 AOD

SOUTH EAST ELEVATION

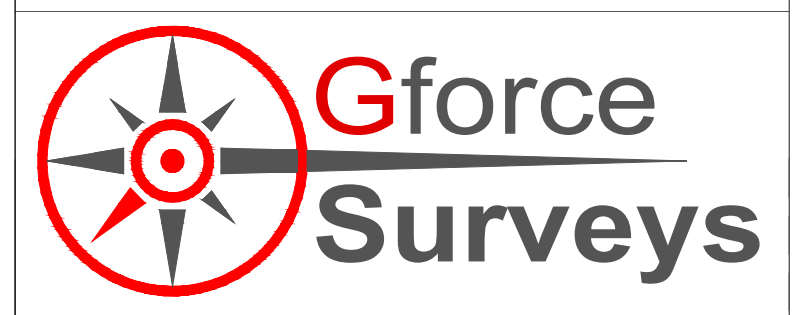

TOPOGRAPHICAL SURVEYS - MEASURED BUILDING SURVEYS -
BOUNDARY SURVEYS - VOLUMETRIC SURVEYS -
3D LASER SCANNING - POINT CLOUDS -
SITE ENGINEERING - SETTING OUT - MONITORING

1 ORCHARD GROVE
ST AUSTELL
CORNWALL
PL25 5TW
01726 68846
enquiries@gforcesurveys.com
www.gforcesurveys.com

Client:
Hamatethy Fram LLP

Project:
**Hamatethy Farm
St Breward
Bodmin**

Title:
**Measured Building
Survey
Agricultural Barn**

Date: 03/04/2023 Scale: 1:50@A1 Grid: Ordnance Svy
Surveyor: GN Drawn: GN Issue Date 03.04.23

Drawing Number: 0423-1037-003 Rev