




Previous Eastern Elevation

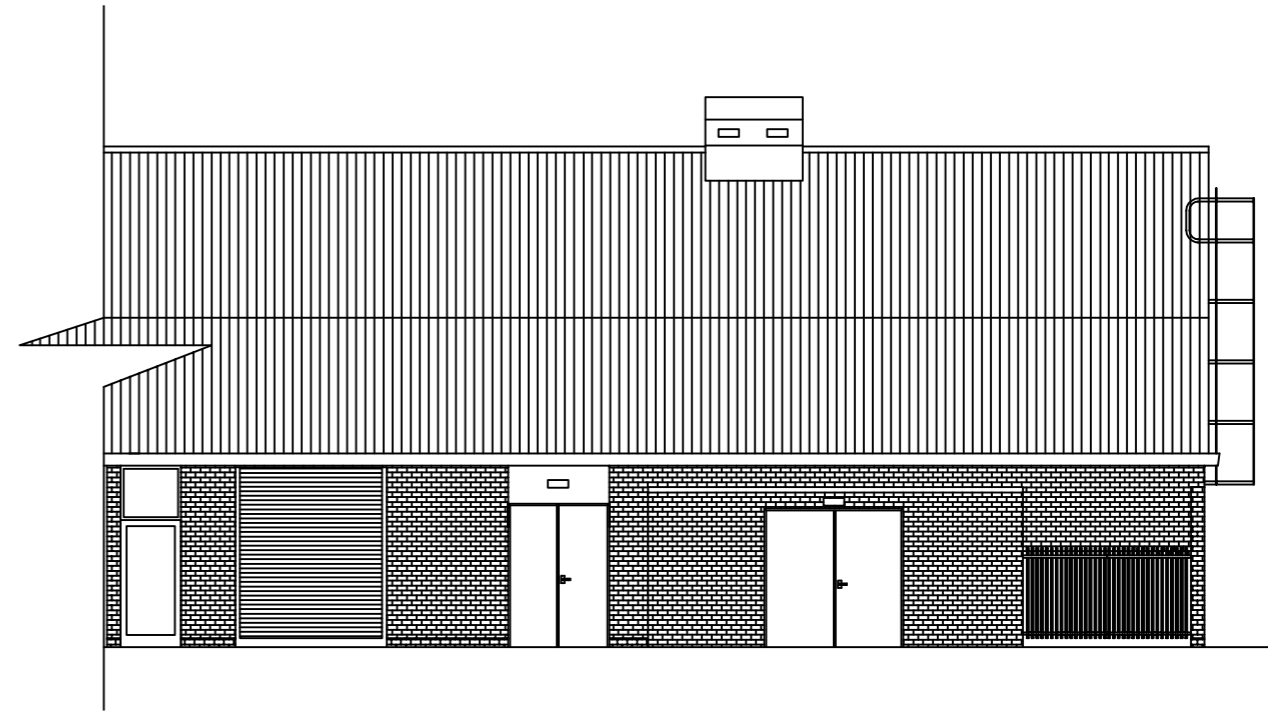

Previous Western Elevation

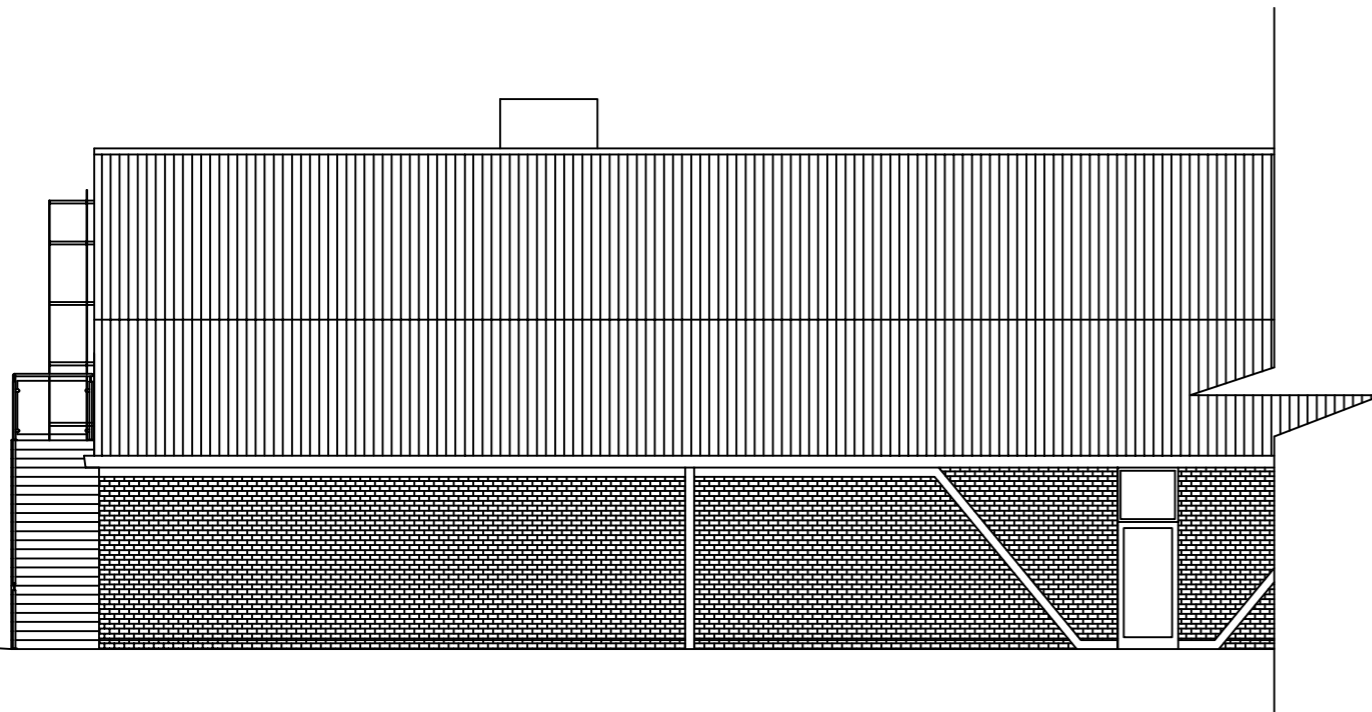

As - Built Eastern Elevation

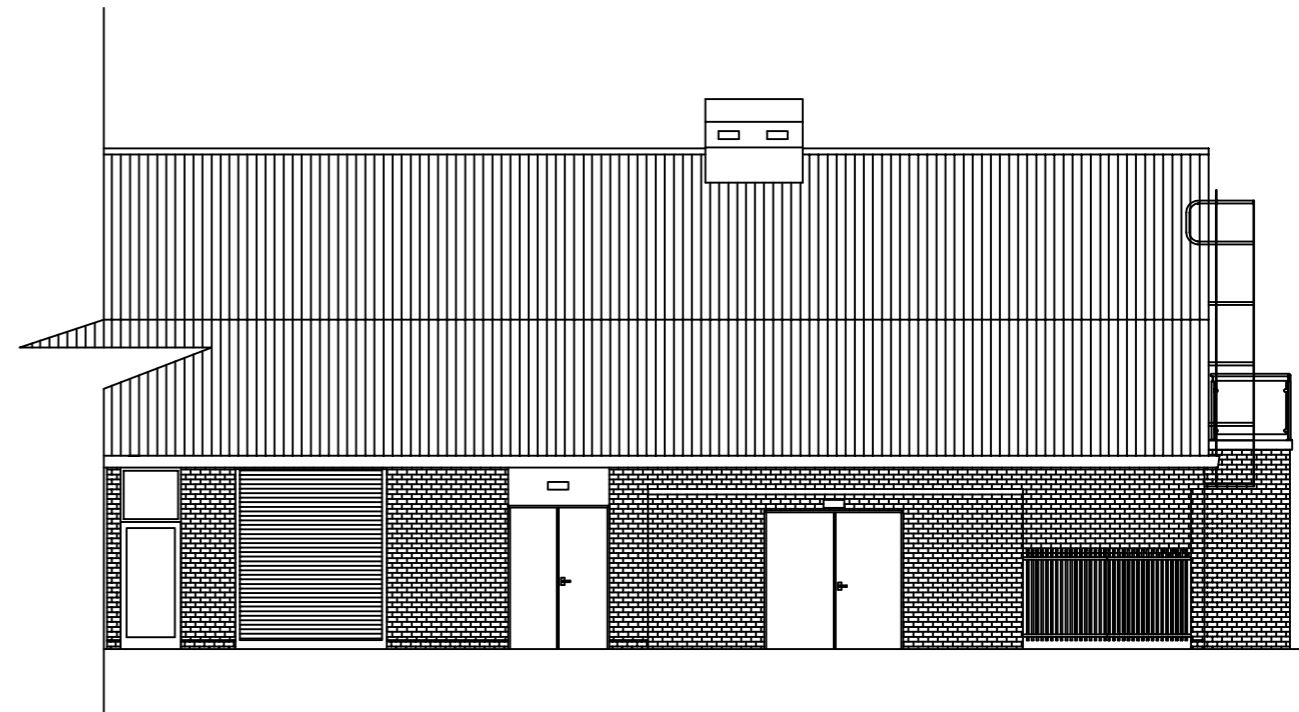

As - Built Western Elevation



<p>PROJECT NAME: External Staircase to 1st Floor, Unit 81 & J Tweedside Park, Tweedbank, TD1 3TE.</p>	<p>DRAWING NAME: Previous and As-Built Elevations East and West</p>	<p>DRAWING NUMBER: TB/PP/ExtSC/003</p> <p>REVISIONS:</p>	<p>DATE: DEC 2023</p> <p>SCALE: 1:125 @ A3</p>	<p>DRAWN: CRC</p> <p>CHECKED:</p>	<p>REVISION AMENDMENTS</p>	<p>J. S. Crawford Properties (Borders) Ltd. Estate Office, Pavilion Farm, Melrose, Scotland. TD6 9BN TEL: 01896 820555 info@jscestates.co.uk</p>
---	---	--	--	---------------------------------------	----------------------------	--