




Ormiston House, Kirknewton

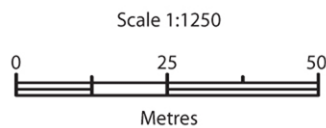

Reproduction in whole or in part is prohibited without the prior permission of Ordnance Survey.

Ordnance Survey and the OS Symbol are registered trademarks and OS MasterMap® is a trademark of Ordnance Survey, the national mapping agency of Great Britain.

The representation of a road, track or path is no evidence of a right of way.

The representation of features as lines is no evidence of a property boundary.

Date Of Issue: 15 September 2020
Supplied By: Getmapping
Supplier Plan Id: 244206_1250
OS License Number: 100030848
Applicant: Gonzalo Navarro
Application Reference: BHO



KEY
 Slapping / dountaking

Former Ground Floor
 Scale 1:100

0 1 2 3 4 5m 1:100@a3

Note:
 Former floor plans and elevations as per information provided to Meta architecture

REV. DATE DETAILS BY
 Listed Building Consent


META
 architecture

40 CONSTITUTION ST. EDINBURGH EH6 6RS
 0131 6297838 info@metaarchitecture.co.uk
 Ormiston House
 Bentley States

Former ground floor plan

BHO6(LBC)002
 Revision: Scale/format: 1:100 @A3
 Drawn by: GN Date: 15.12.23

1. This drawing is intended for Listed Building Consent only.
 © META Architecture Ltd. All rights reserved

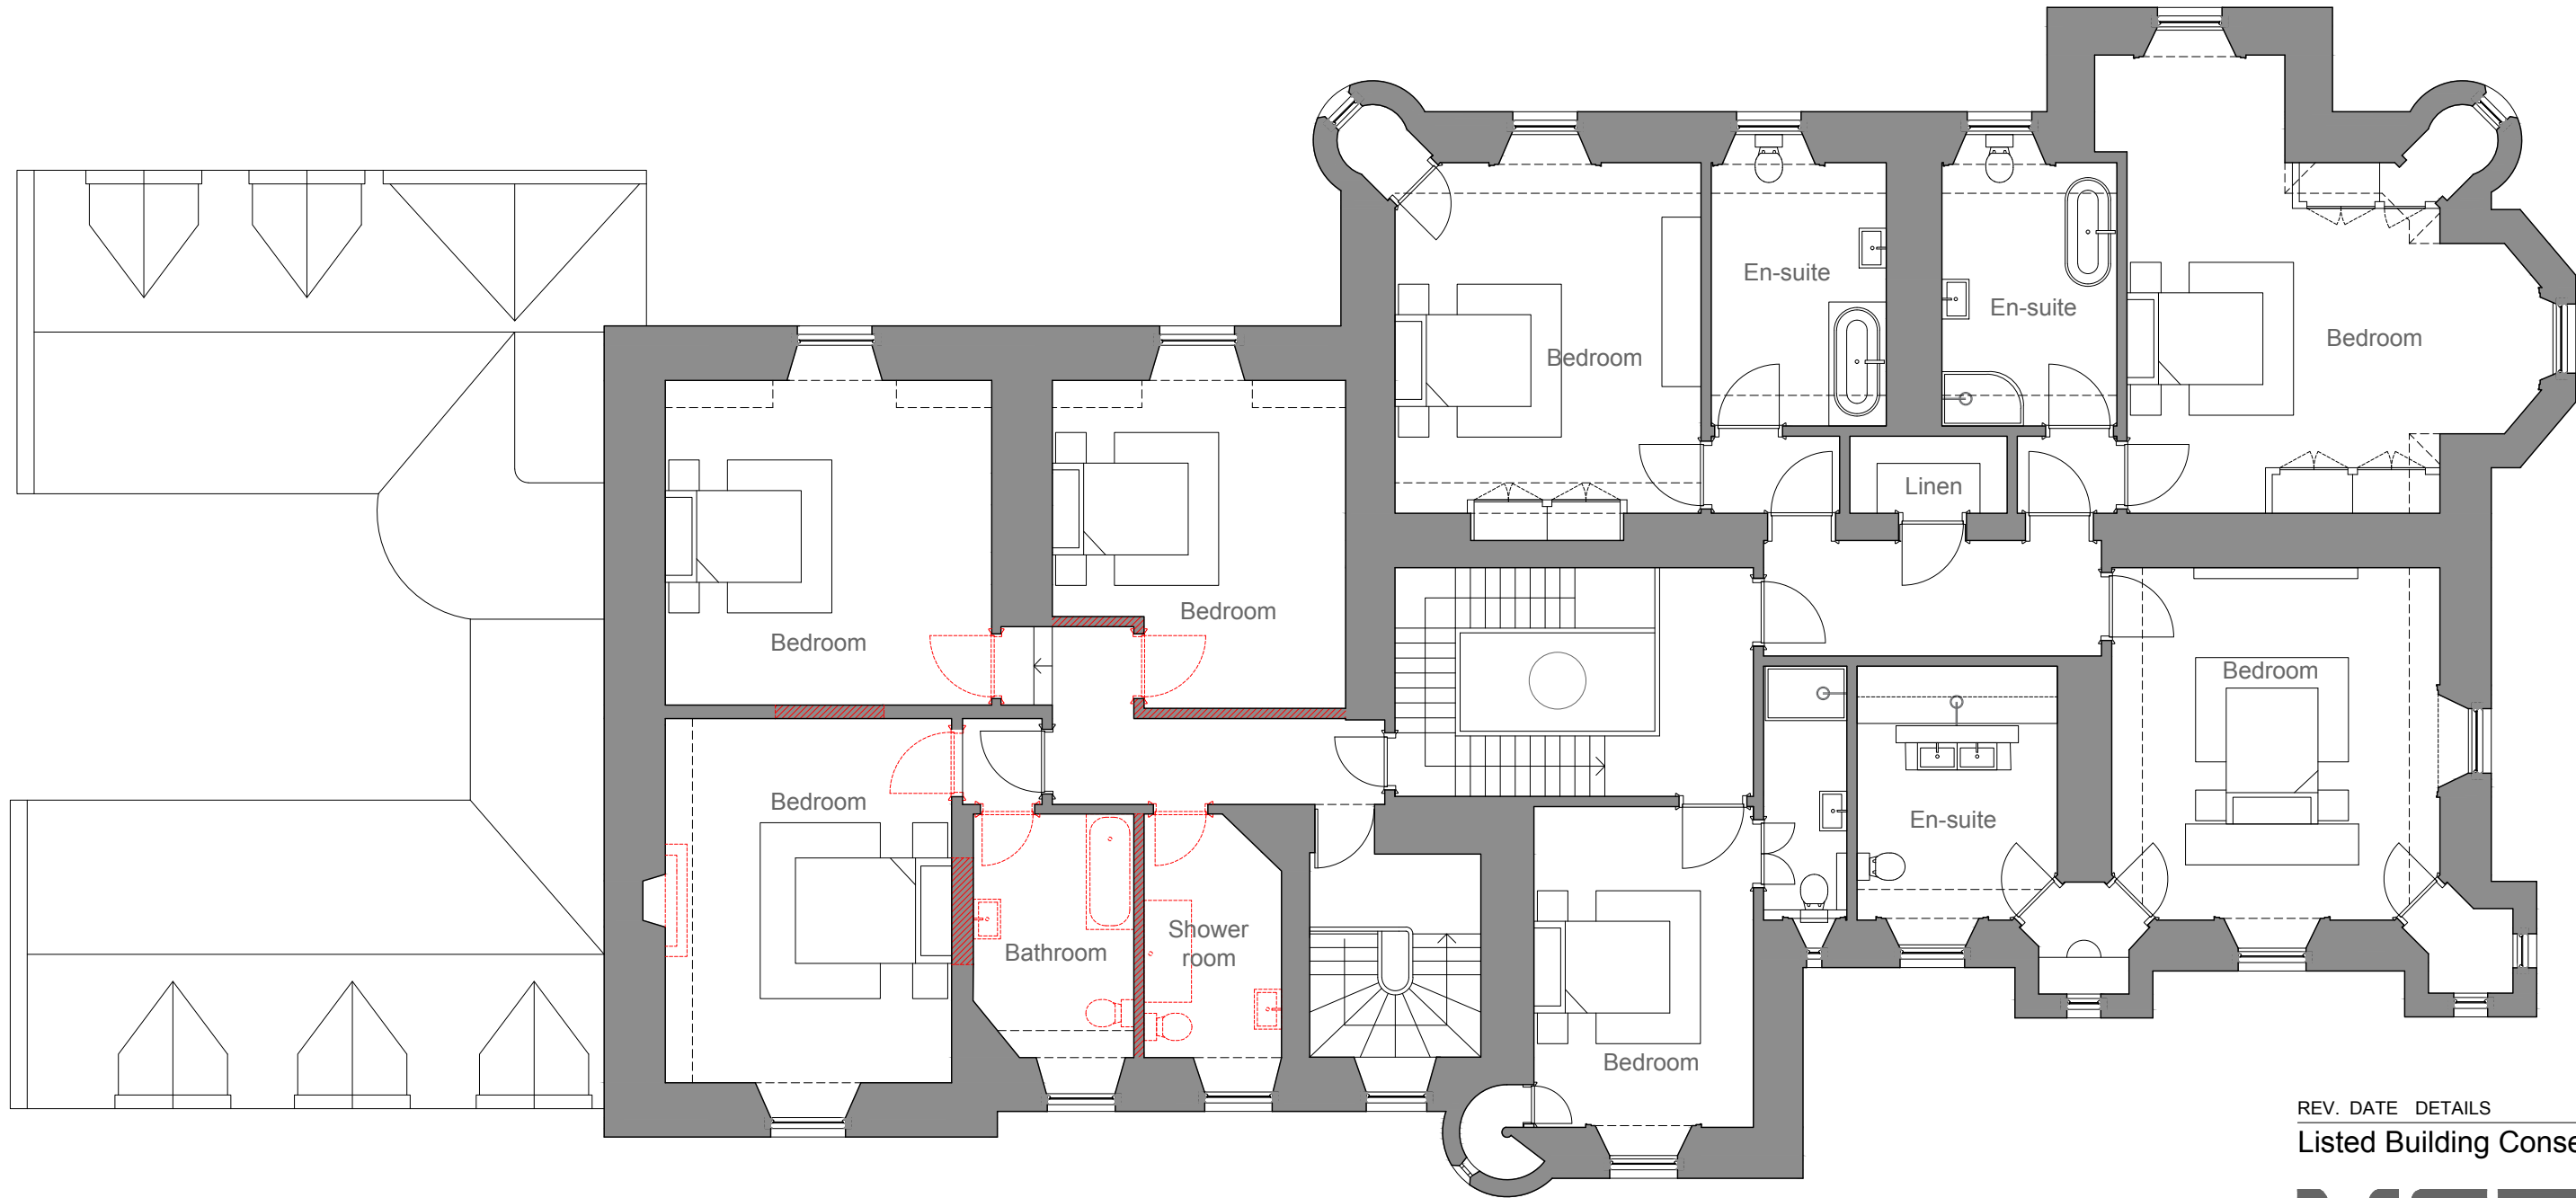

KEY
 // // // // // Slapping / dountaking

Former First Floor
 Scale 1:100

0 1 2 3 4 5m 1:100@a3

Note:
 Former floor plans and elevations as per information provided to Meta architecture

REV. DATE DETAILS BY
 Listed Building Consent

META
 architecture

40 CONSTITUTION ST. EDINBURGH EH6 6RS
 0131 6297838 info@metaarchitecture.co.uk

Ormiston House
 Bentley States


Former first floor plan

BHO6(LBC)003


Revision: Scale/format: 1:100 @A3 Drawn by: GN Date: 15.12.23

1. This drawing is intended for Listed Building Consent only.


© META Architecture Ltd. All rights reserved

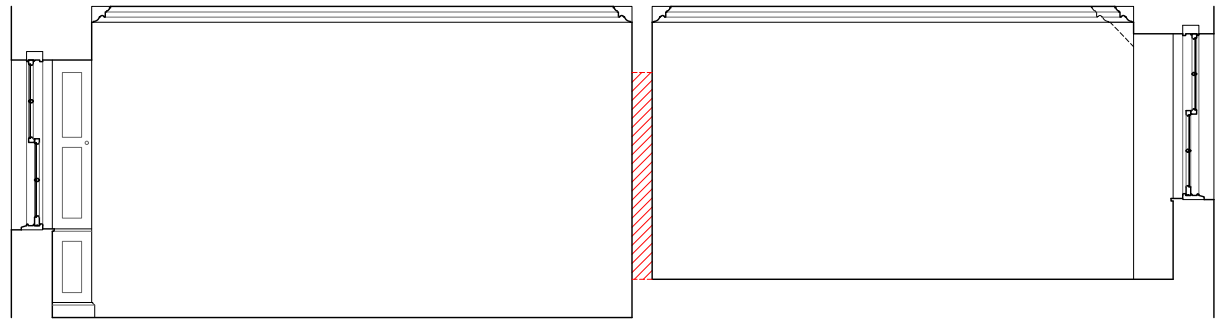


Internal elevation A

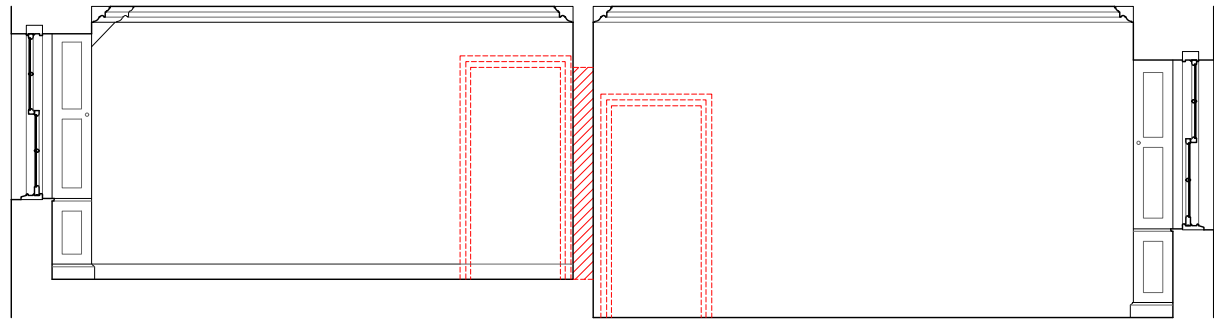


Internal elevation B

KEY
 Slapping / dewatering


Note:
 Former floor plans and elevations as per information provided to Meta architecture

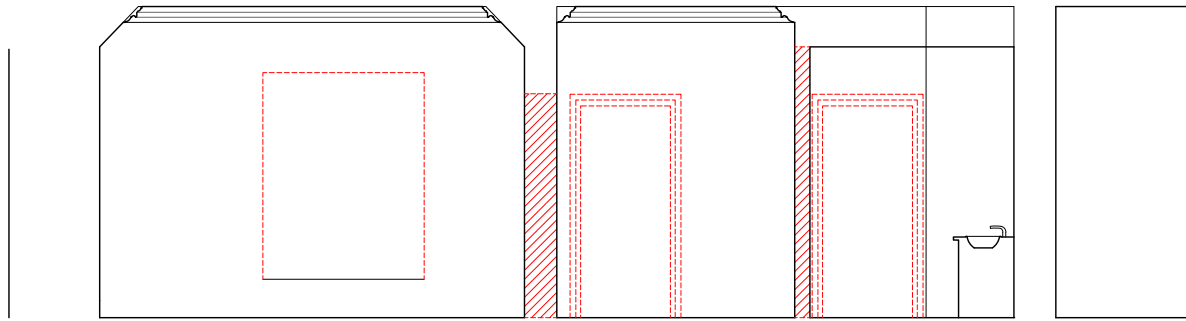


Internal elevation C

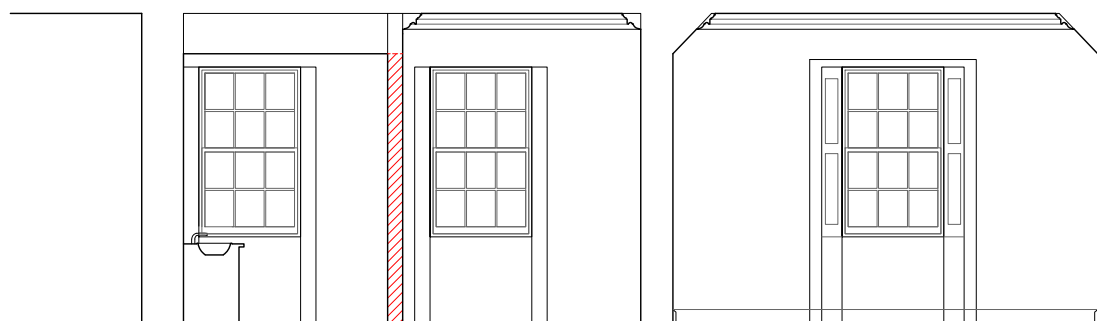


Internal elevation D

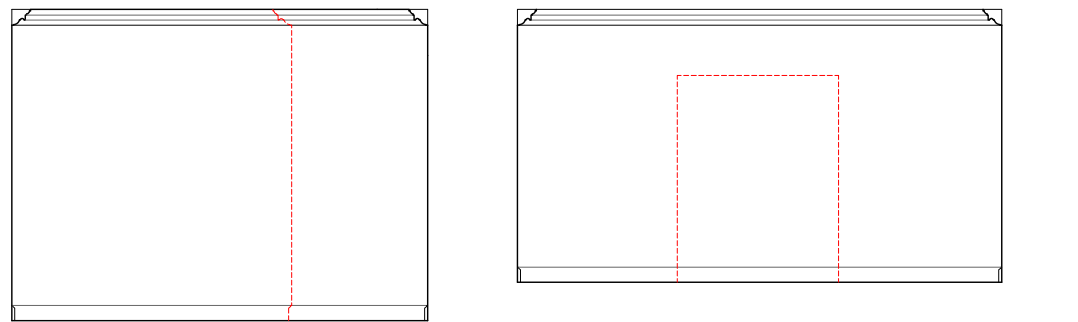


Internal elevation E

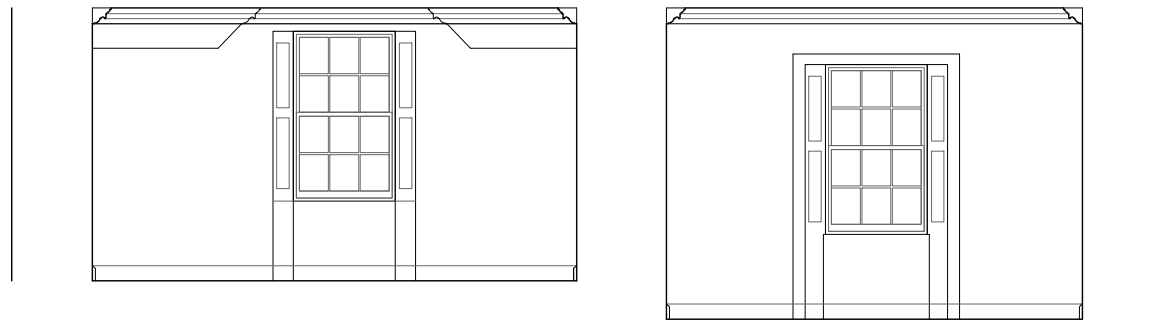

Internal elevation F

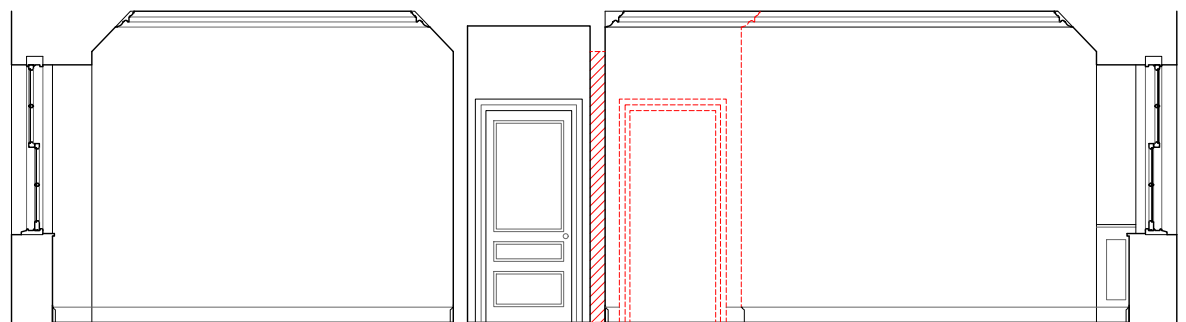

Internal elevation G

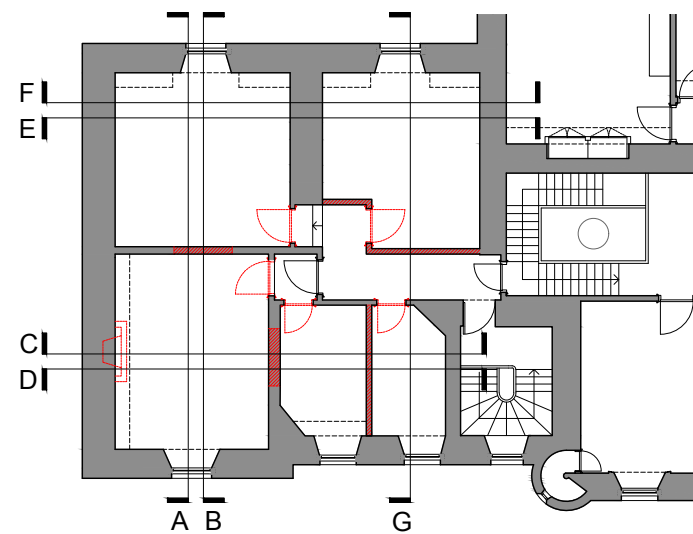

REV. DATE DETAILS BY
 Listed Building Consent

META
 architecture
 40 CONSTITUTION ST. EDINBURGH EH6 6RS
 0131 6297838 info@metaarchitecture.co.uk
 Ormiston House
 Bentley States


Former internal elevations
 First floor

BHO6(LBC)004
 Revision: Drawn by: GN
 Scale/format: 1:100 @A3 Date: 15.12.23
 1. This drawing is intended for Listed Building Consent only.

Former internal elevations
First floor
 Scale 1:75



1:75@A3

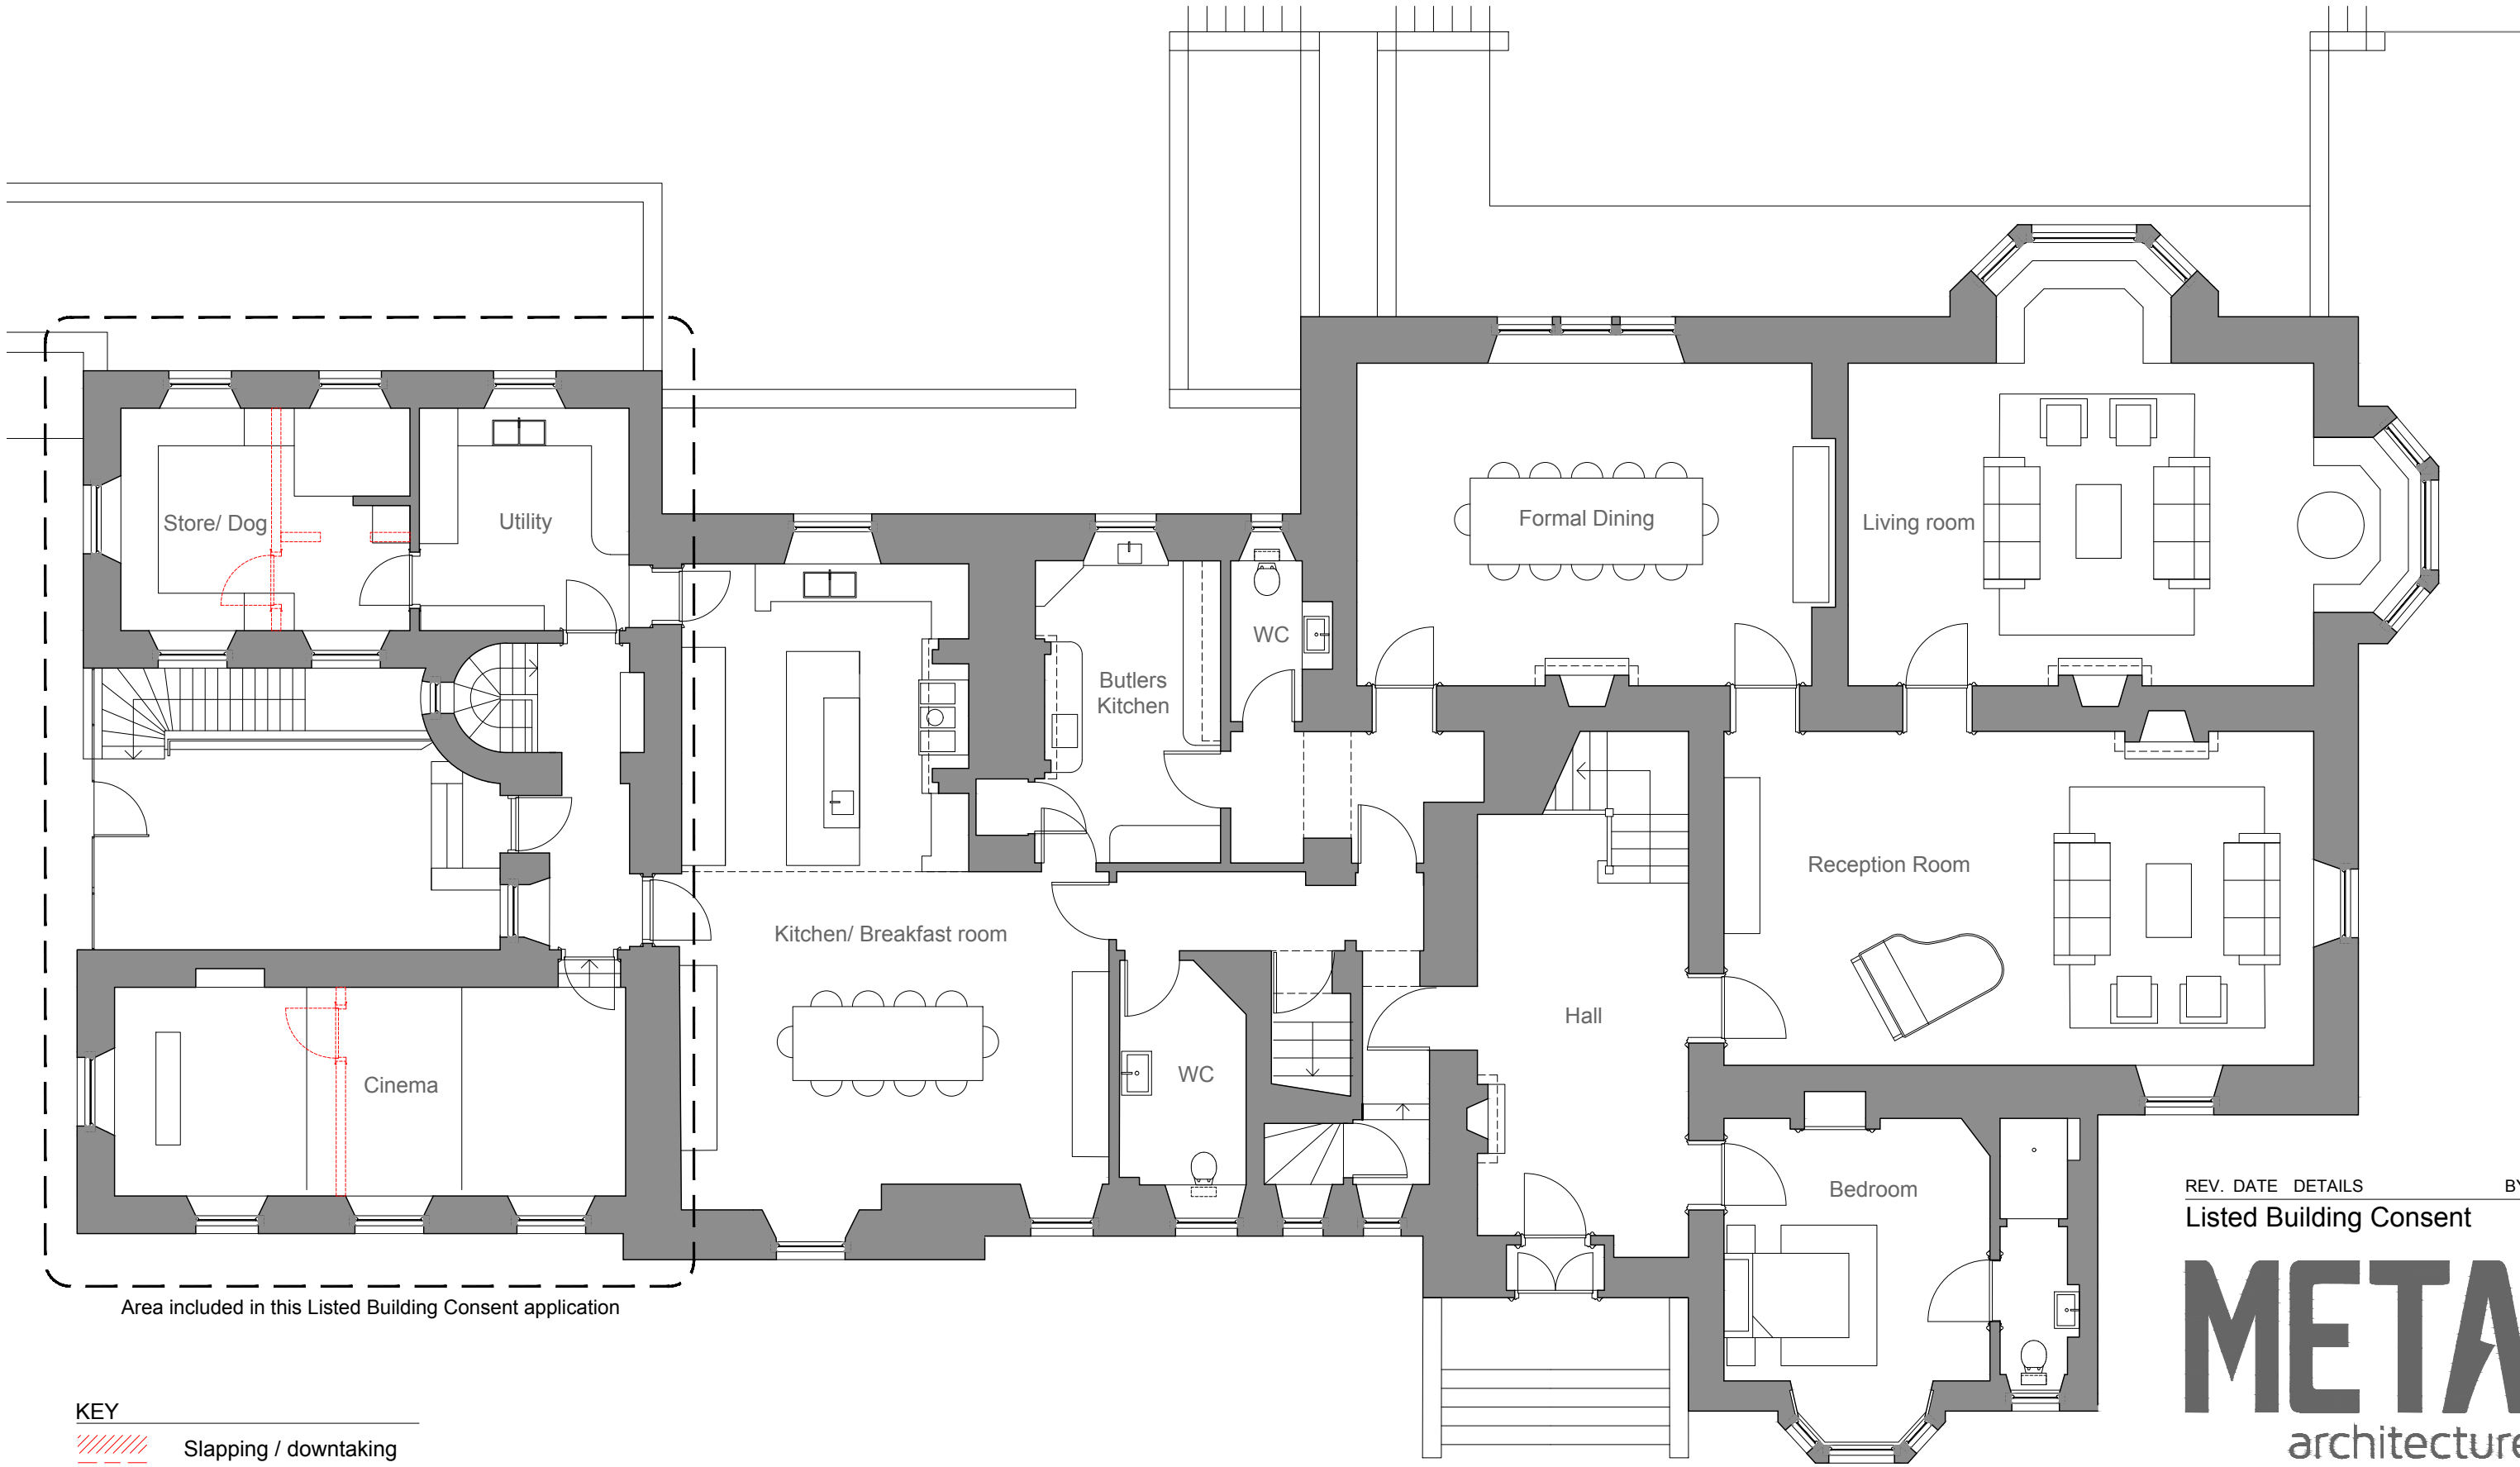

Area included in this Listed Building Consent application

KEY
 // Slapping / downtaking

Ground floor plan
 Scale 1:100

0 1 2 3 4 5m 1:100@a3

REV. DATE DETAILS BY
 Listed Building Consent

META
 architecture

40 CONSTITUTION ST. EDINBURGH EH6 6RS
 0131 6297838 info@metaarchitecture.co.uk

Ormiston House
 Bentley States


Ground floor plan
 As built

BHO6(LBC)005

Revision: Drawn by: GN
 Scale/format: 1:100 @A3 Date: 15.12.23

1. This drawing is intended for Listed Building Consent only.

© META Architecture Ltd. All rights reserved

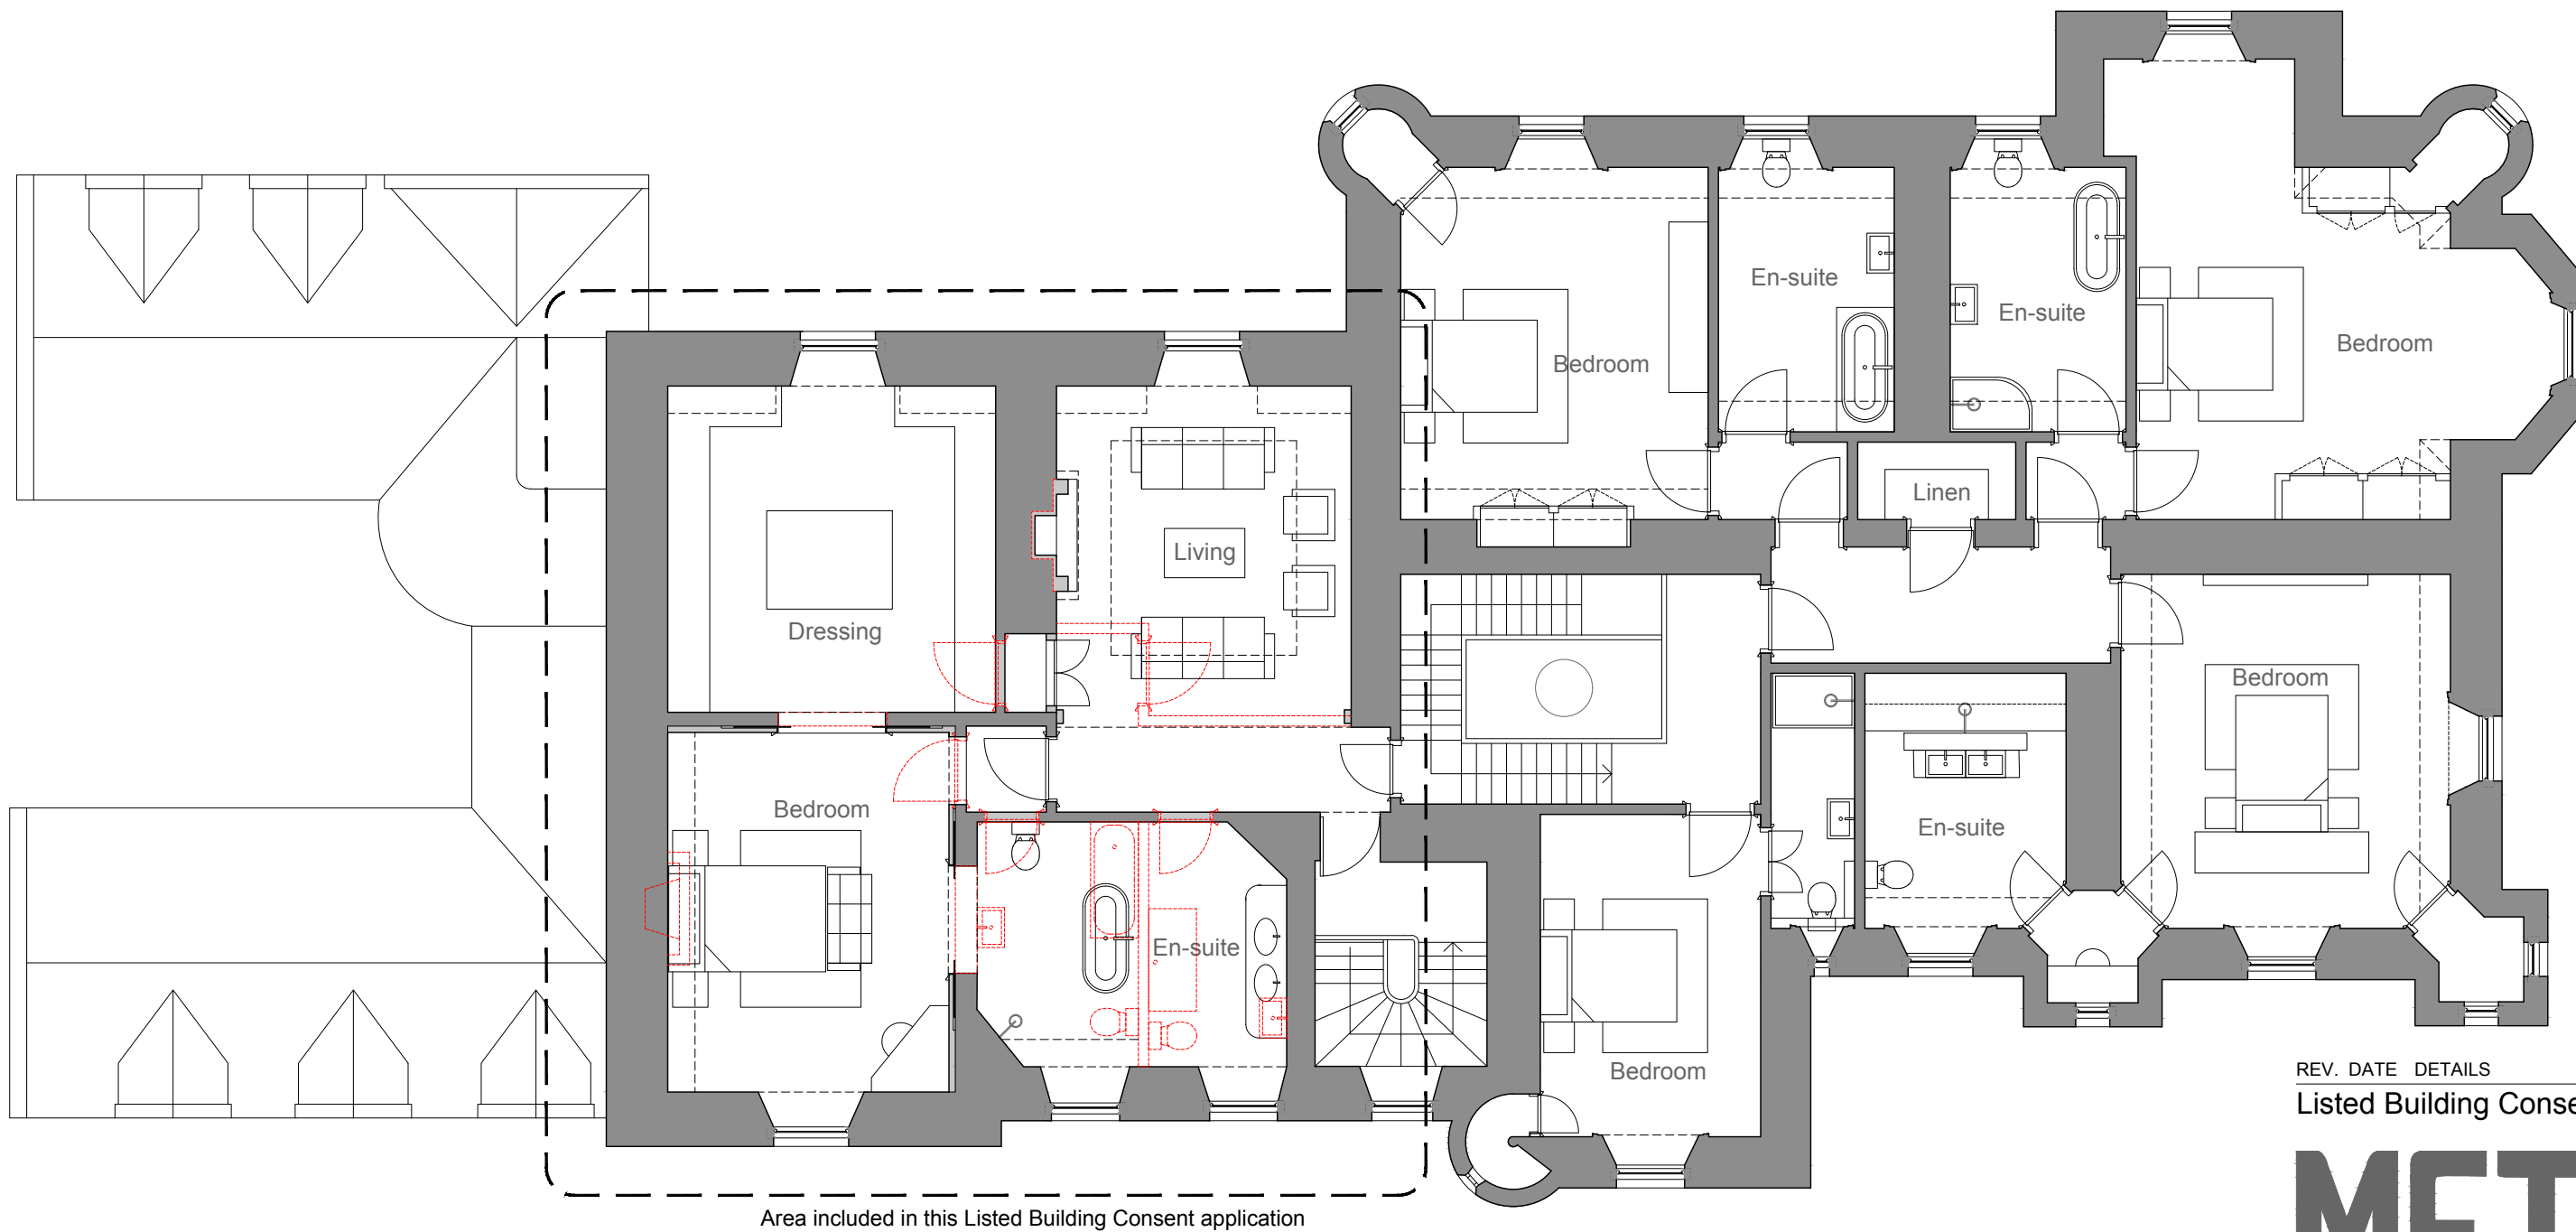

KEY
 // // // // // Slapping / dountaking

First floor plan
 Scale 1:100



REV. DATE DETAILS BY
 Listed Building Consent

META
 architecture

40 CONSTITUTION ST. EDINBURGH EH6 6RS
 0131 6297838 info@metaarchitecture.co.uk

Ormiston House
 Bentley States


First floor plan
 As built

BHO6(LBC)006


Revision: Drawn by: GN
 Scale/format: 1:100 @A3 Date: 15.12.23

1. This drawing is intended for Listed Building Consent only.


© META Architecture Ltd. All rights reserved

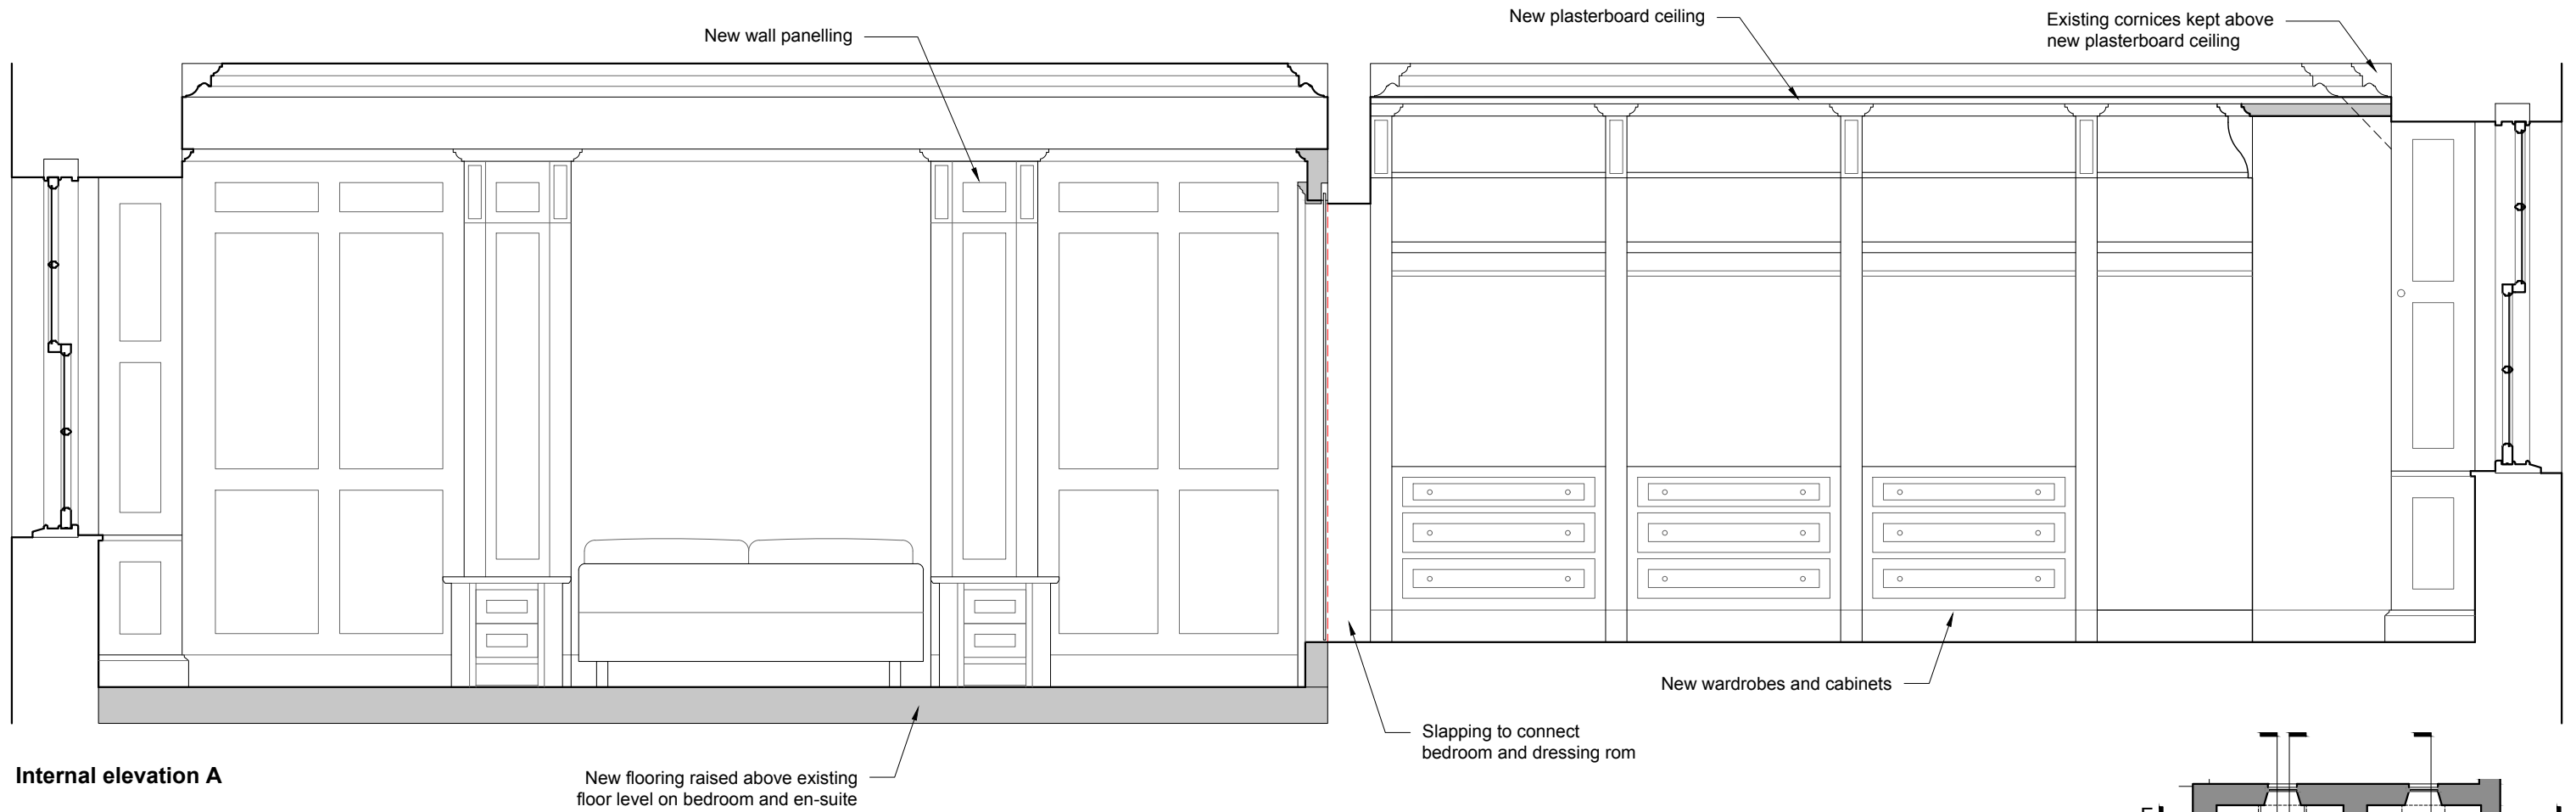

Internal elevation A

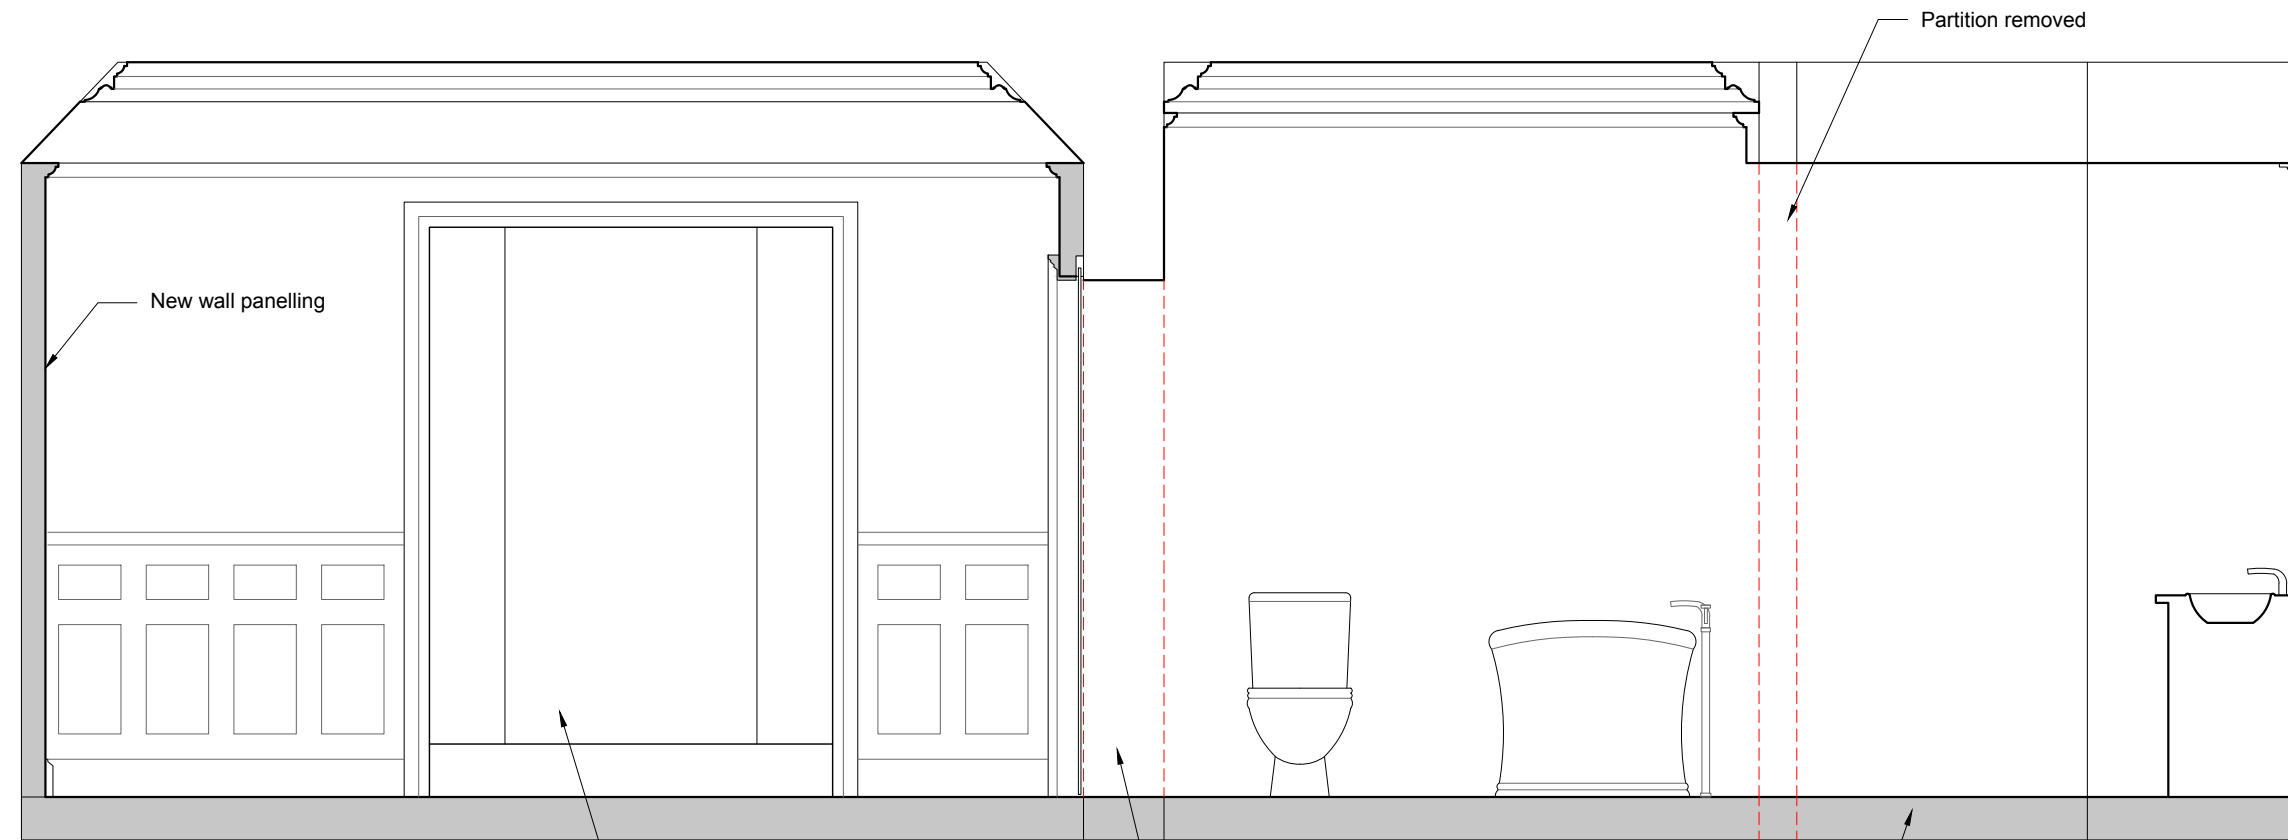

Internal elevation C

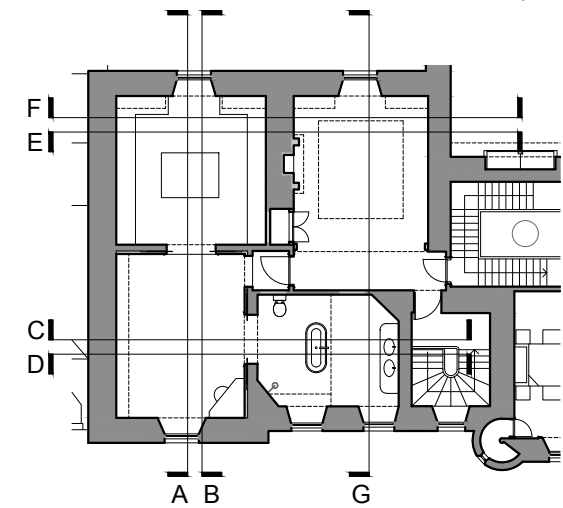

REV. DATE DETAILS BY

Listed Building Consent

META
architecture

40 CONSTITUTION ST. EDINBURGH EH6 6RS
0131 6297838 info@metaarchitecture.co.uk

Ormiston House
Bentley States

Internal elevations
First floor
1 of 3

BHO6(LBC)007

Revision: Drawn by: GN
Scale/format: 1:30 @A3 Date: 15.12.23

1. This drawing is intended for information only.


© META Architecture Ltd. All rights reserved

Internal elevations
First floor
Scale 1:50

0 0.2 0.4 0.6 0.8 1m 1:30@a3

KEY


//// Slapping / dunting
■ Added elements

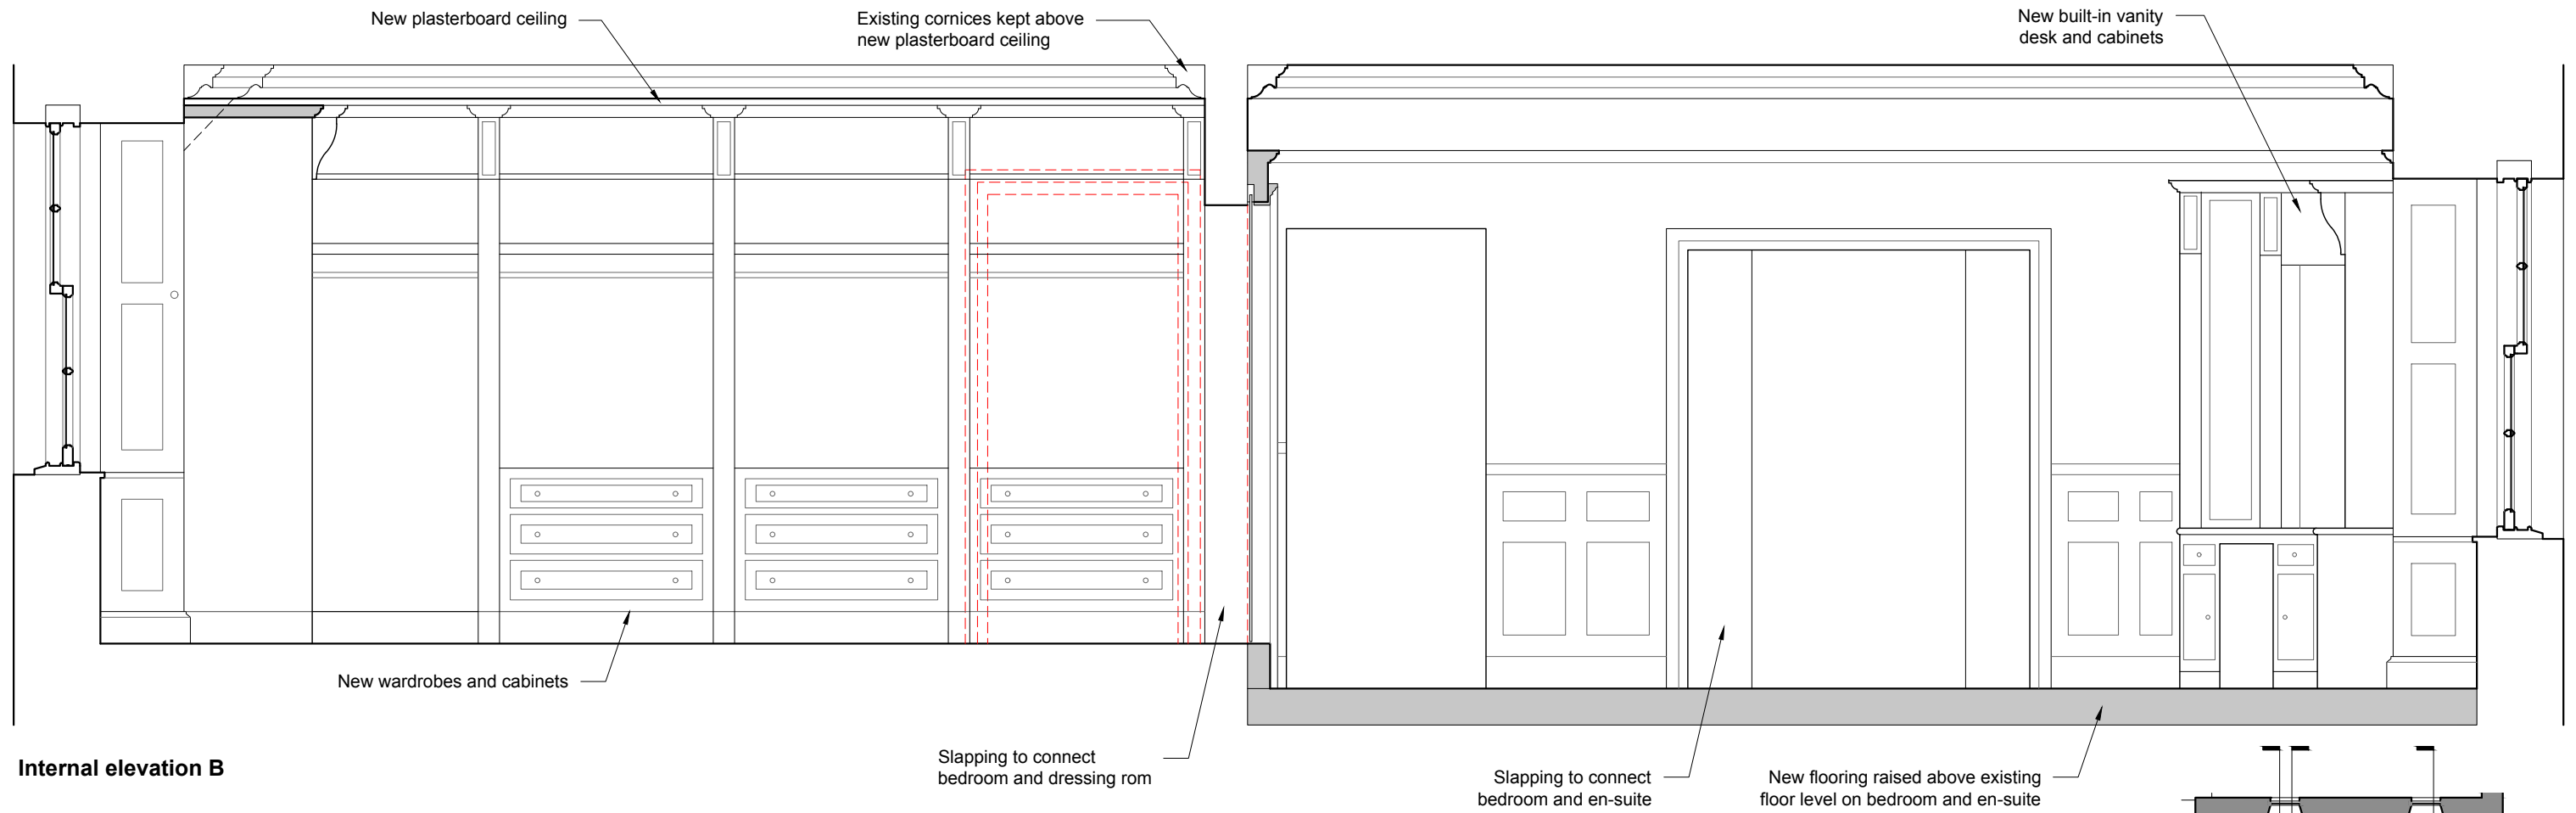

Internal elevation B



Internal elevation D

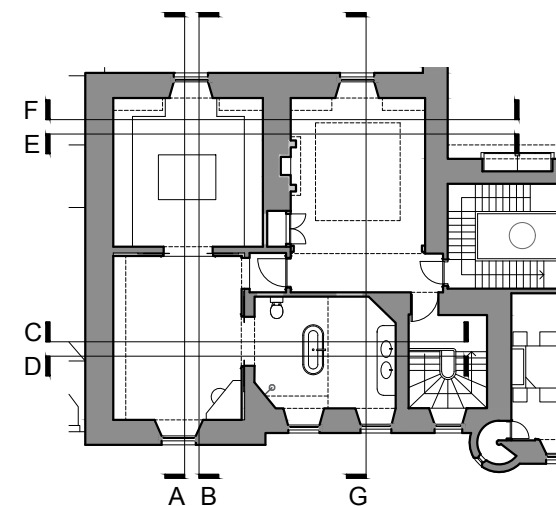

REV. DATE DETAILS BY
Listed Building Consent

META
architecture

40 CONSTITUTION ST. EDINBURGH EH6 6RS
0131 6297838 info@metaarchitecture.co.uk
Ormiston House
Bentley States

Internal elevations
First floor
2 of 3

BHO6(LBC)008


Revision: Drawn by: GN
Scale/format: 1:30 @A3 Date: 15.12.23

1. This drawing is intended for Listed Building Consent only.
© META Architecture Ltd. All rights reserved

Internal elevations
First floor
Scale 1:50




KEY
 Slapping / dntaking
 Added elements

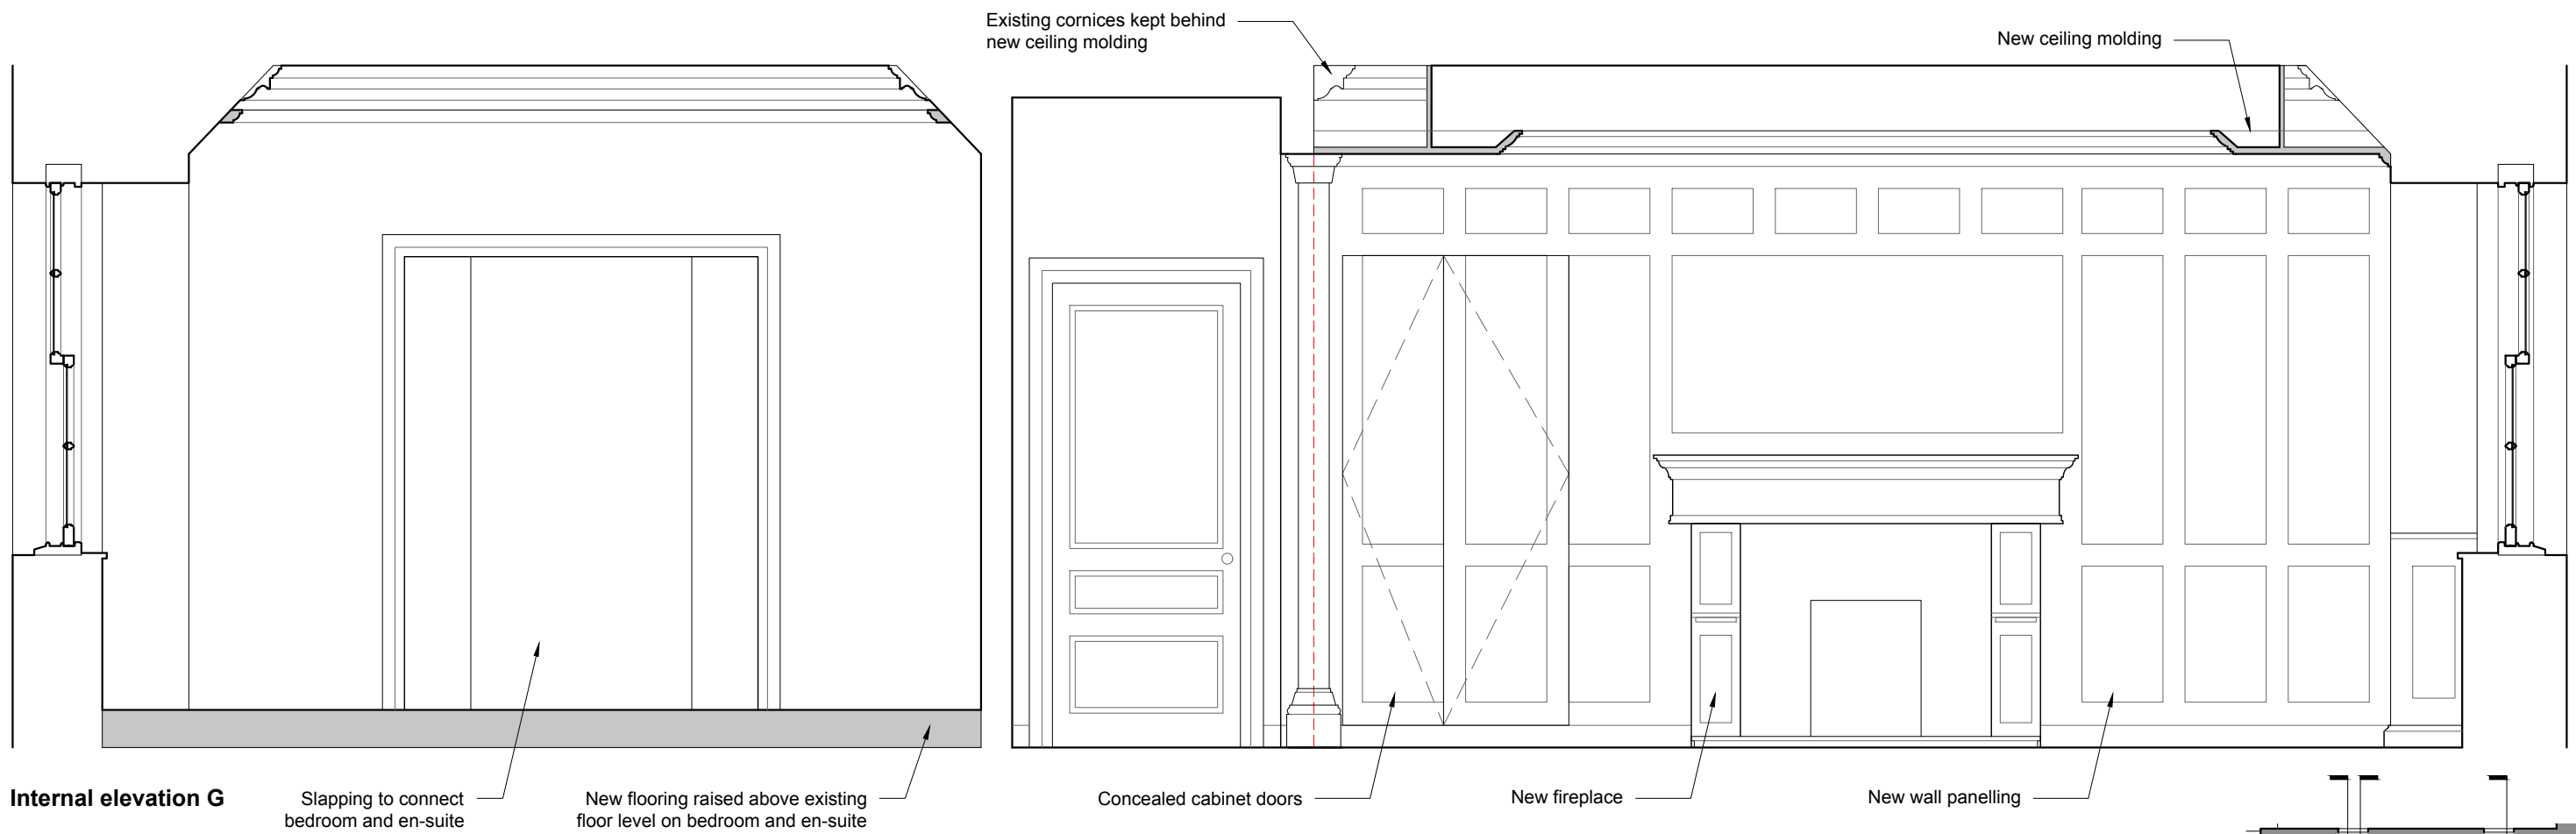

Internal elevation G


Slapping to connect bedroom and en-suite
 New flooring raised above existing floor level on bedroom and en-suite

Existing cornices kept behind new ceiling molding
 New ceiling molding
 Concealed cabinet doors
 New fireplace
 New wall panelling

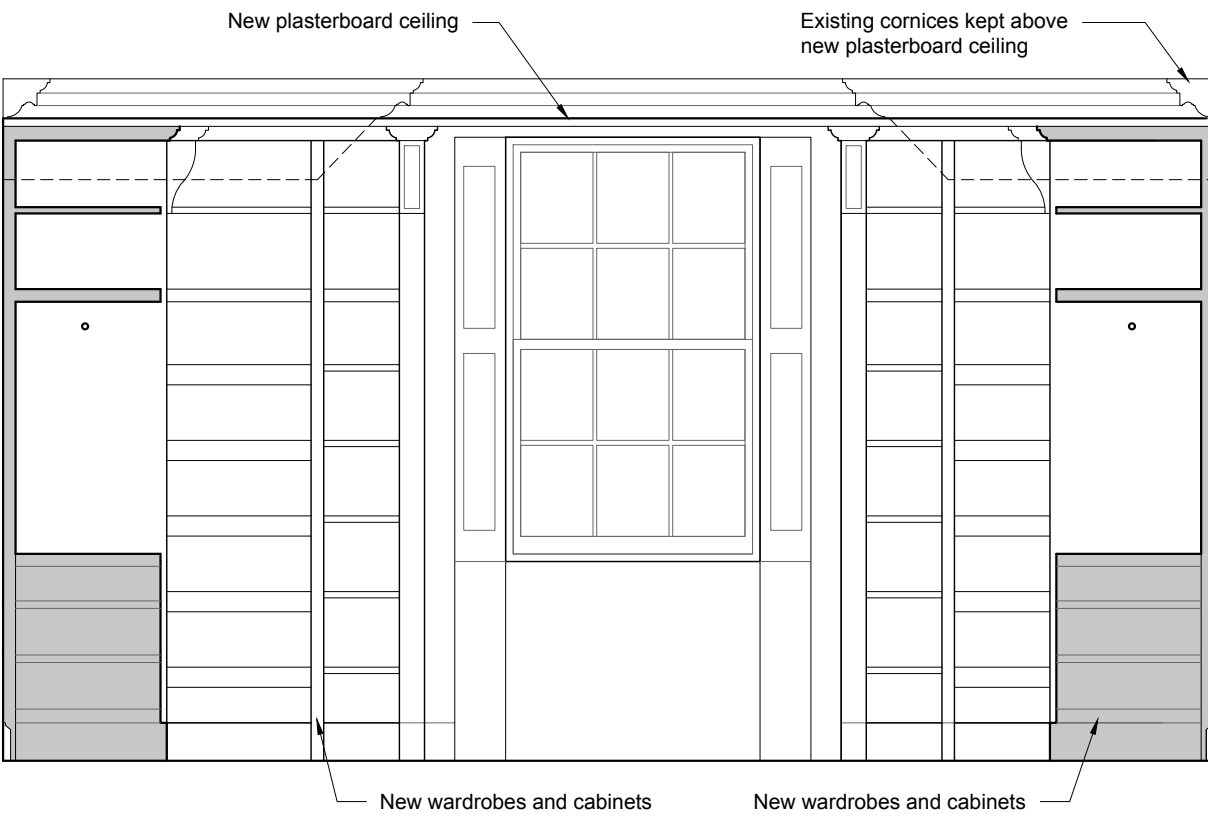

Internal elevation F

New plasterboard ceiling
 Existing cornices kept above new plasterboard ceiling
 New wardrobes and cabinets
 New wardrobes and cabinets

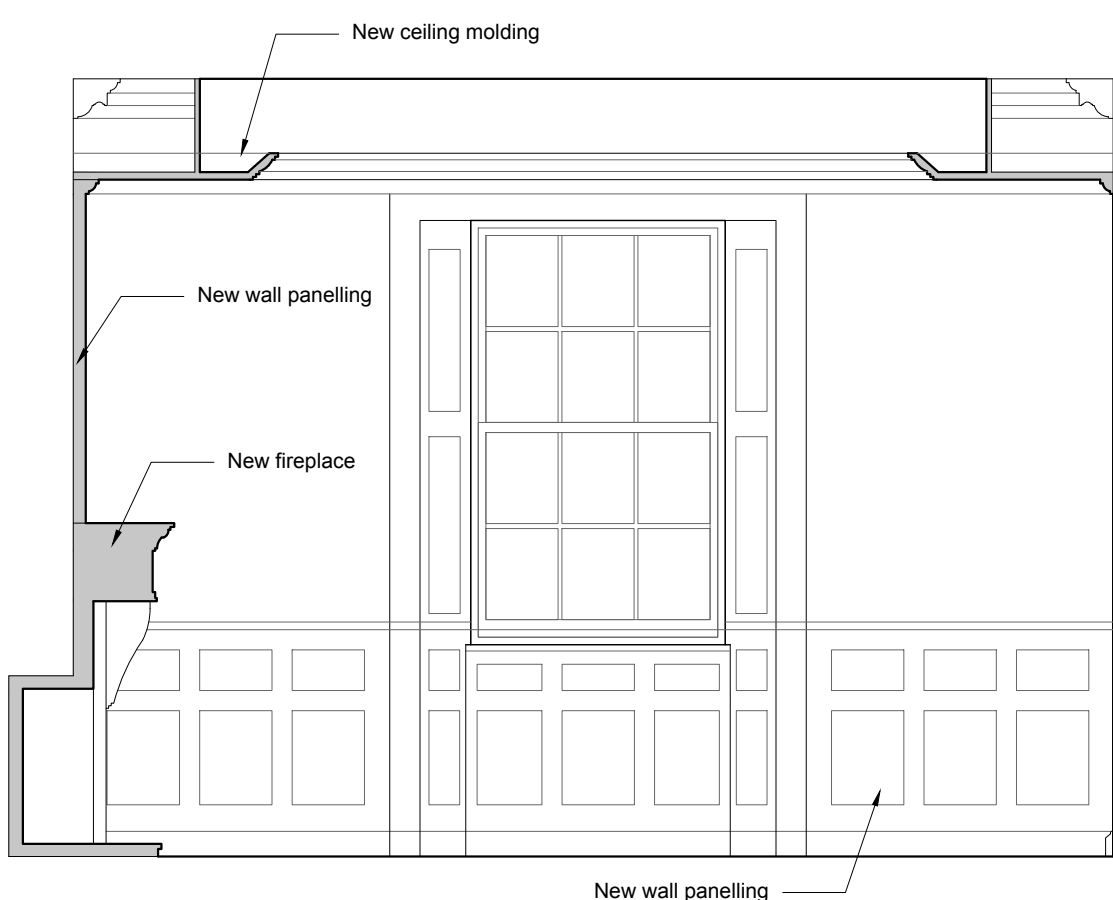


New ceiling molding

New wall panelling

New fireplace

New wall panelling

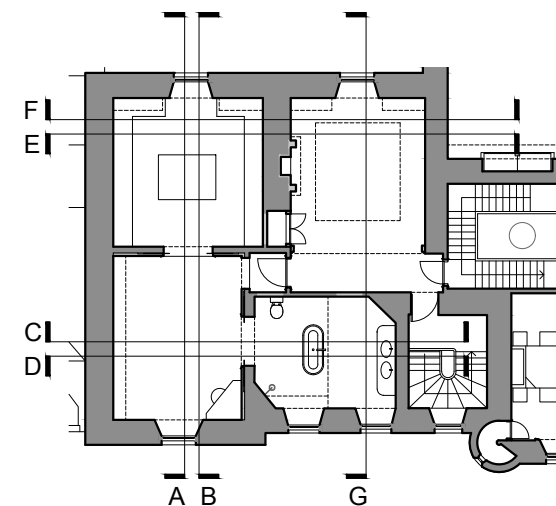

REV. DATE DETAILS BY

Listed Building Consent

META
 architecture

40 CONSTITUTION ST. EDINBURGH EH6 6RS
 0131 6297838 info@metaarchitecture.co.uk

Ormiston House
 Bentley States

Internal elevations
 First floor
 3 of 3

BHO6(LBC)009

Revision: Drawn by: GN
 Scale/format: 1:30 @A3 Date: 15.12.23

1. This drawing is intended for Listed Building Consent only.

© META Architecture Ltd. All rights reserved

Internal elevations
First floor
 Scale 1:50



KEY

	Slapping / dntaking
	Added elements