
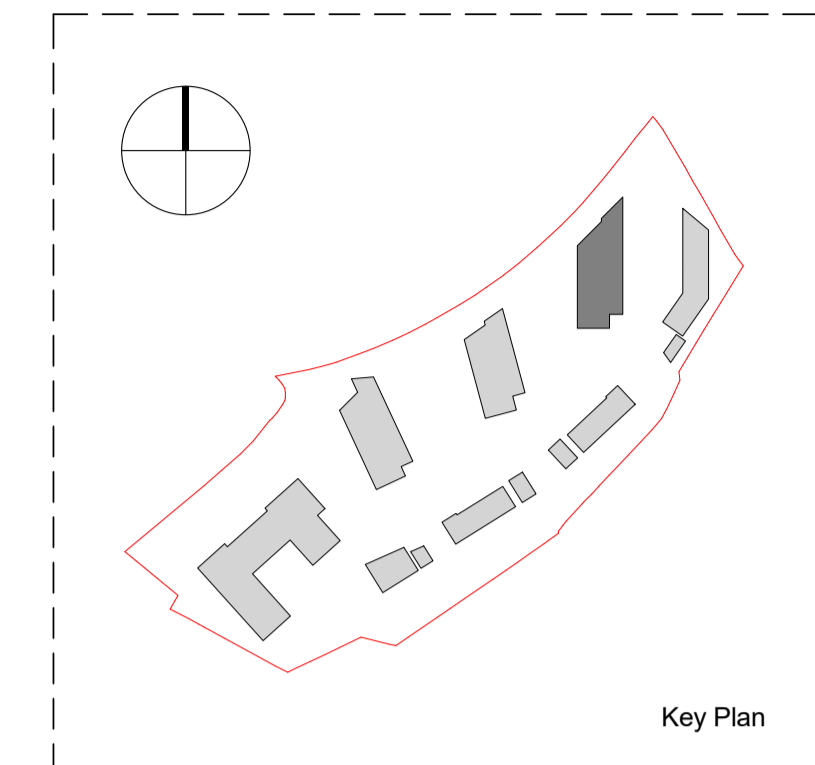


The contractor is responsible for checking dimensions, tolerances and references. Any discrepancy to be verified with the Architect before proceeding with the works. Where an item is covered by drawings to different scales the larger scale drawing is to be worked to.

Do not scale drawing. Figured dimensions to be worked to in all cases.


CDM REGULATIONS 2015. All current drawings and specifications for the project must be read in conjunction with the Designer's Hazard and Environment Assessment Record

All intellectual property rights reserved.

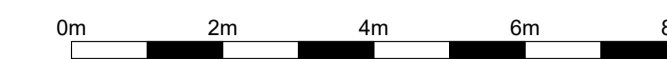

Level 01 (+31.600 m)
1: 100

Flat Types by Level		
Level	Flat Type	Unit Count
Level B1	1B2P	3
Level B1	2B4P	2
Level B1		5
Level 00	1B2P	4
Level 00	2B4P	2
Level 00		6
Level 01	1B2P	3
Level 01	2B4P	4
Level 01		7
Level 02	1B2P	3
Level 02	2B4P	2
Level 02		5
Level 03	1B2P	2
Level 03	2B4P	3
Level 03		5
Grand total		28

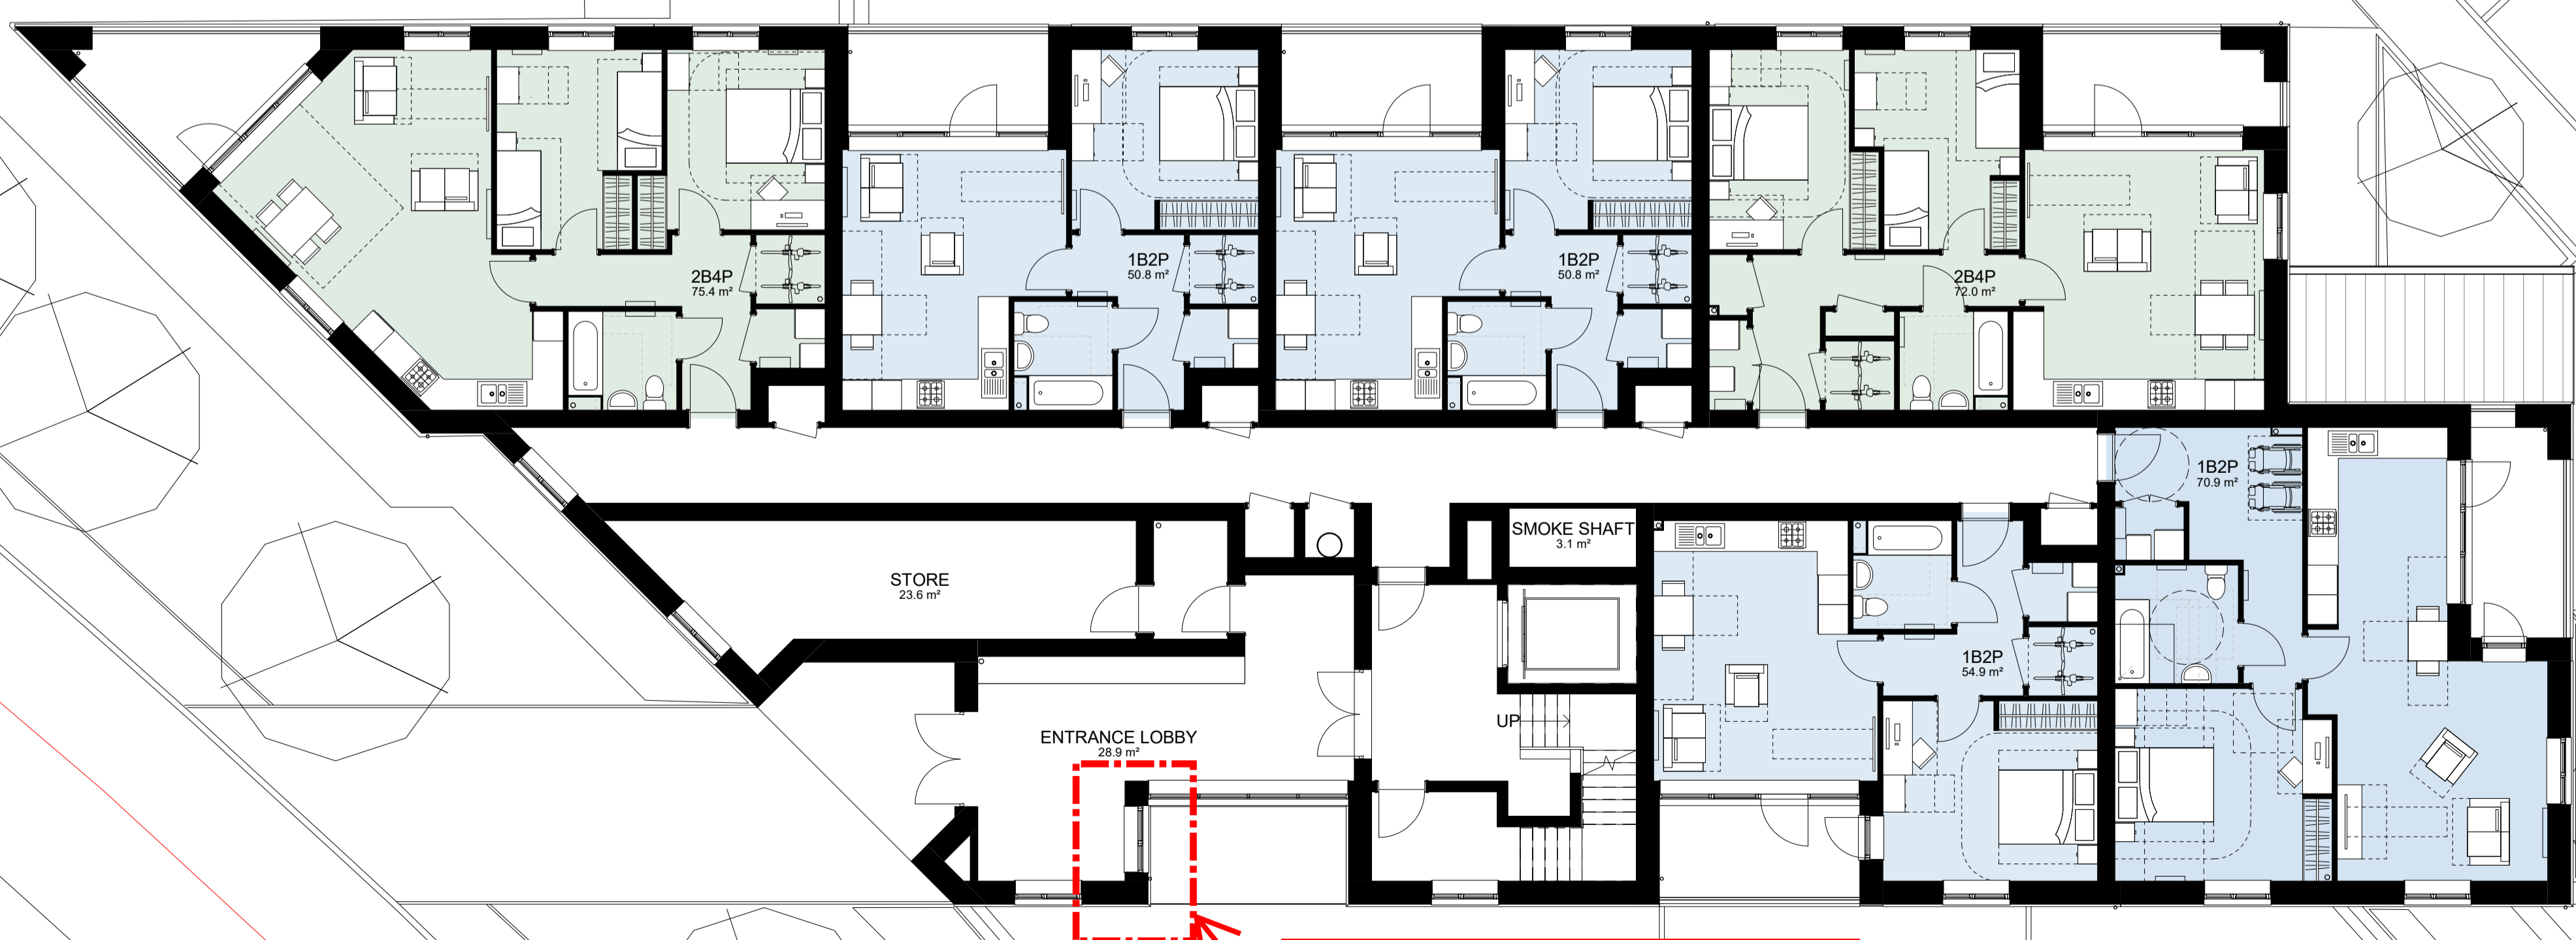

Level 00 (+28.600 m)
1: 100

Window W-00.22 (as referenced on the construction drawings from AWW Architects)

20/12/23 - HCL mark-up

29/10/20 Issue for Planning RC: IBB
Rev Date Description Dwn Crd

Talbot Gardens, Plymouth
Block A Plans (2 of 4)

AA8696-2104 REV -
PLANNING
Drawn RC Checked ST Date OCT 2020 Scale @ A1 As indicated

PRP prp-co.uk
London 020 7653 1200