



Note :-
This drawing must not be scaled. For
Planning Purposes only



Proposed Elevation to Courtyard

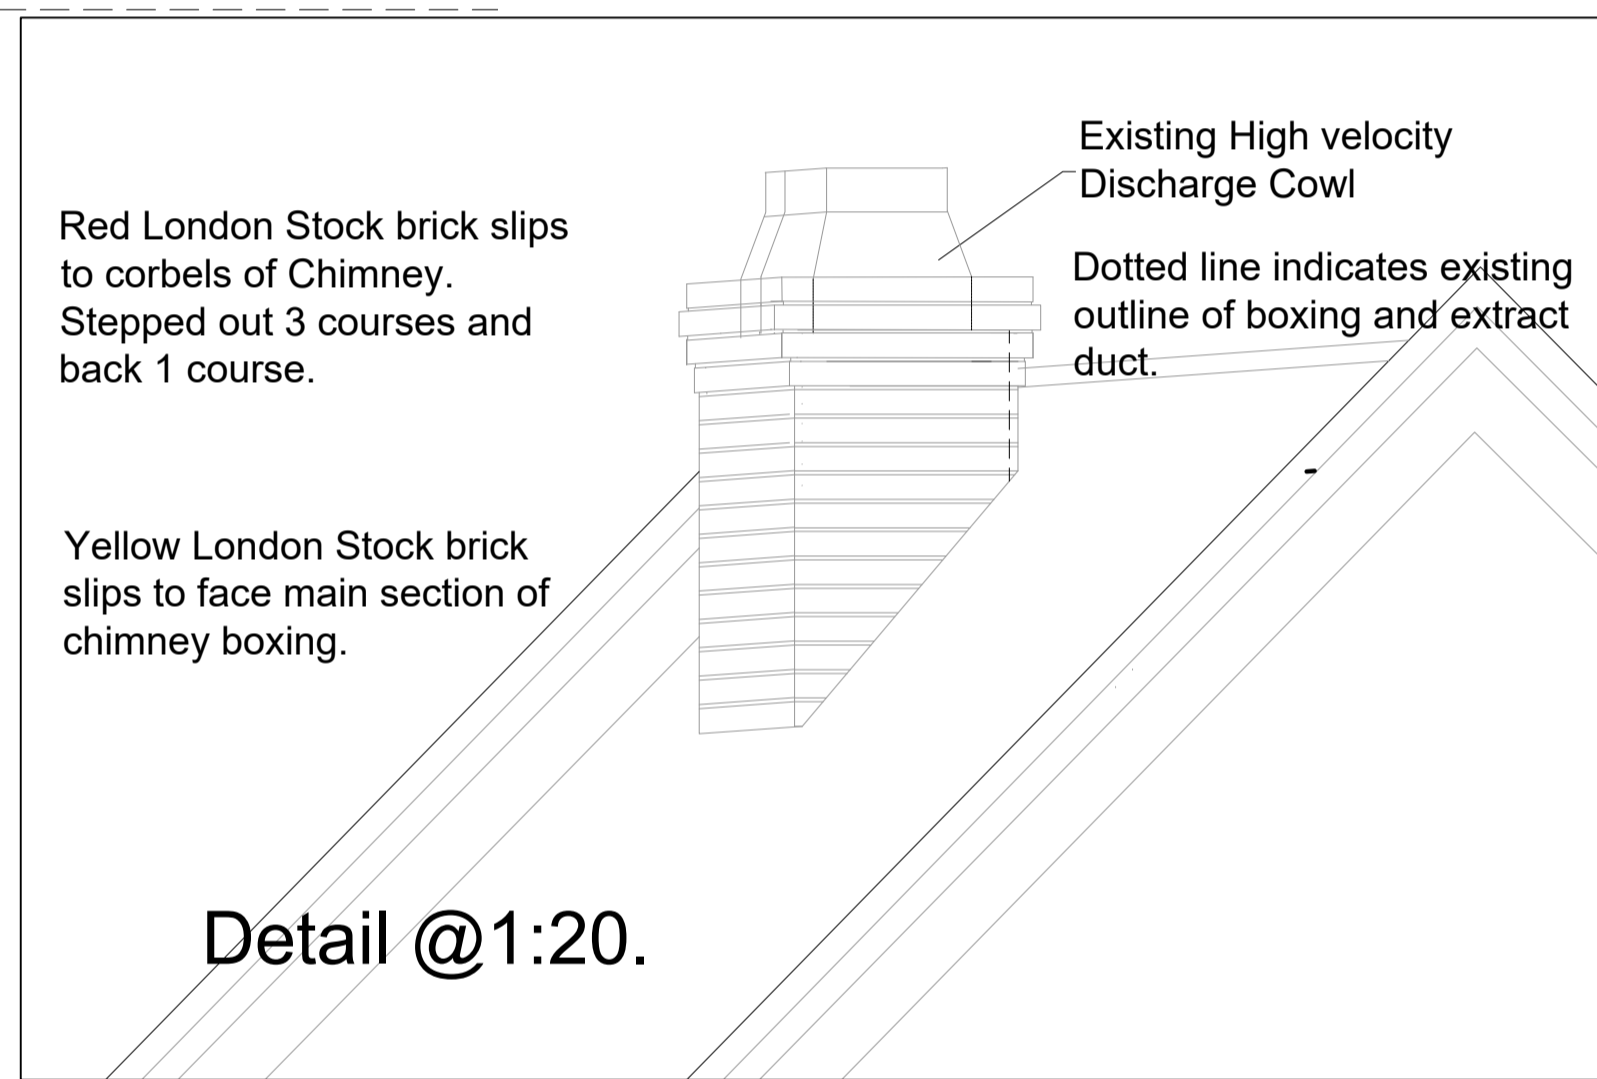

Proposed Elevation to Harbour Road.

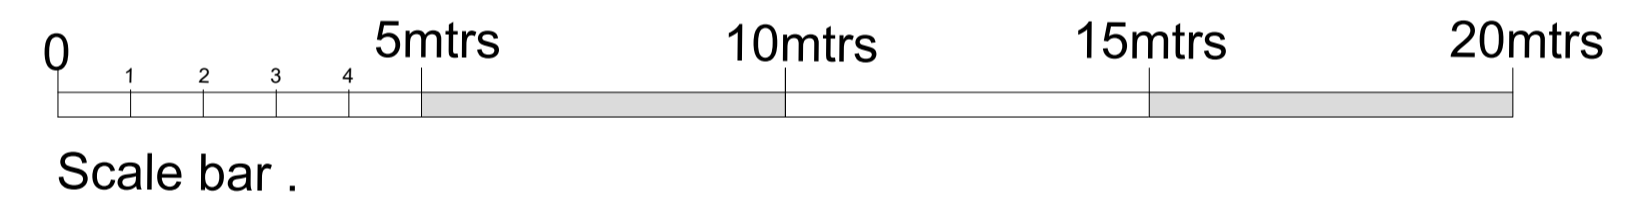

As Built Elevation to Courtyard



As Built Elevation to Harbour Road.

A. Dec 04. Detail added.

Rev	Date

JACKDAW

Tel: 07919415895 or 07961104958
Sandridge Road
St Albans
AL1 4AQ

CLIENT
Shepherd Neame Limited

PROJECT
Duke of Cumberland Hotel
High Street ,Whitstable,
Kent, CT5 1AP

TITLE
Extg/Proposed Regularisation
to installed Extract.

ISSUE
Planning

Scale: 1:100.	Drawing No.	Rev.
Date: 07.10.23	1066/PL05	A.
Drawn:		