



As Built Section Detail 1:10.

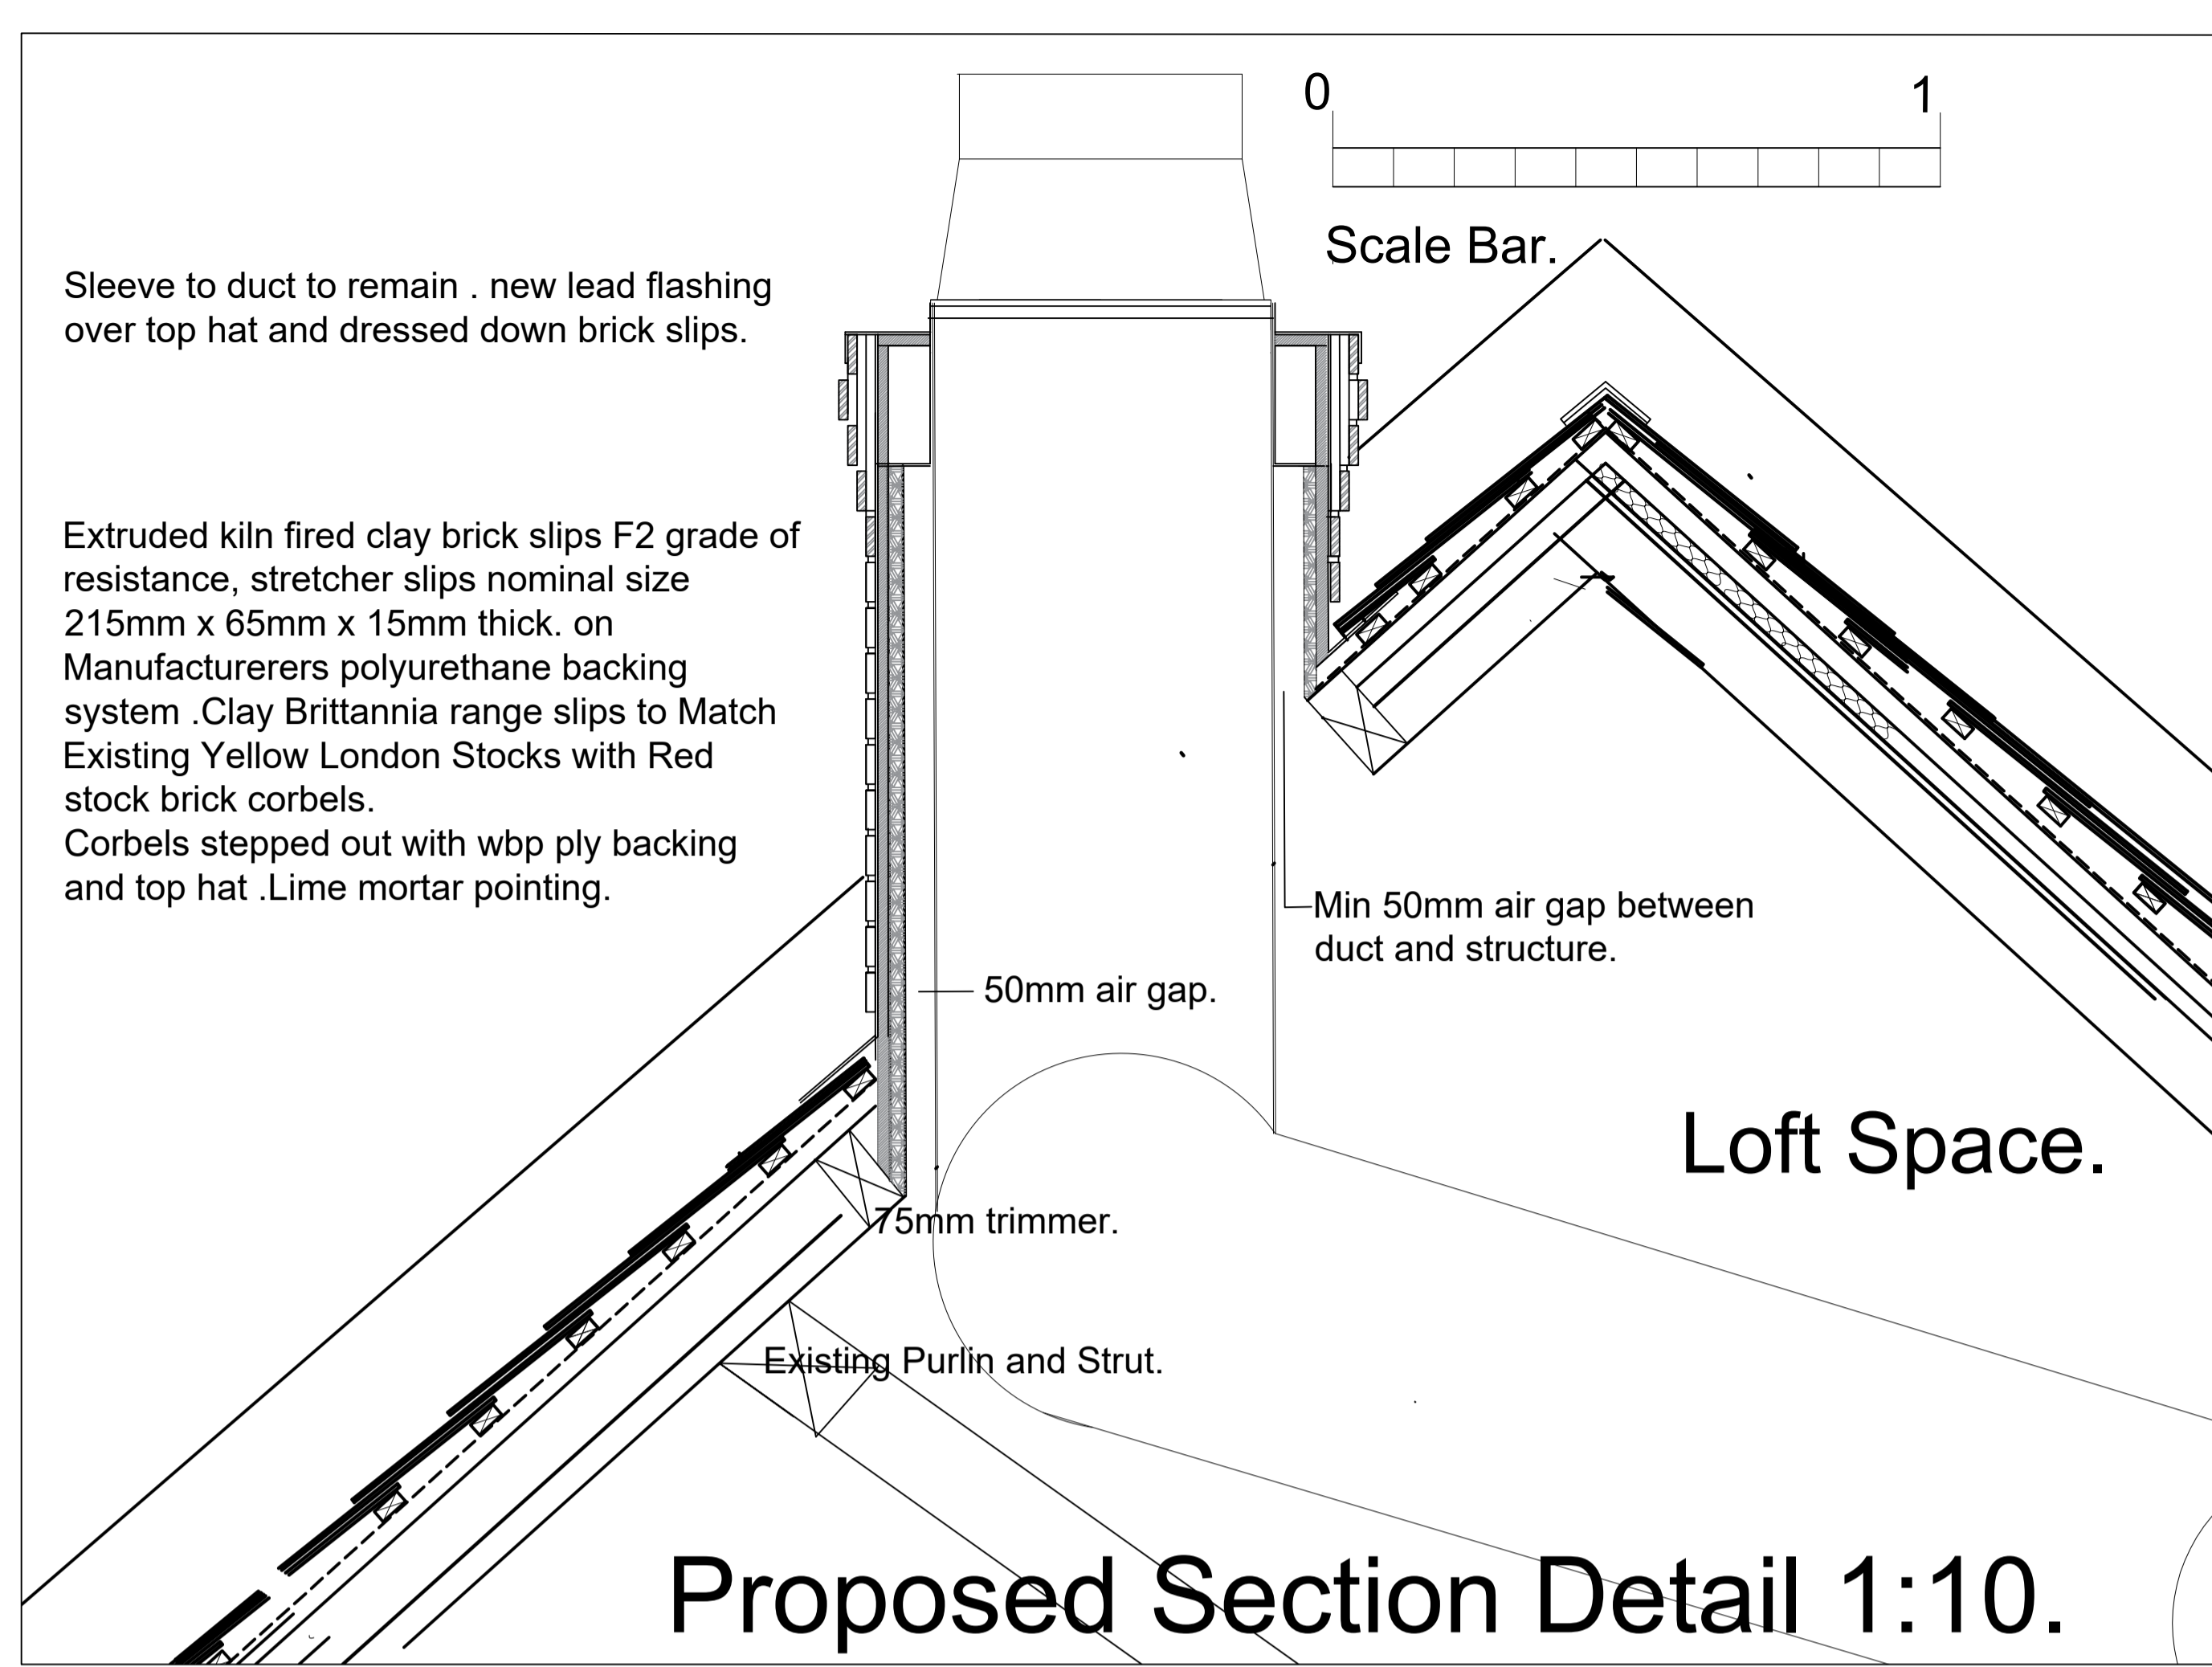


Proposed Section Detail 1:10.

Note :-  
This drawing must not be scaled. For Planning Purposes only

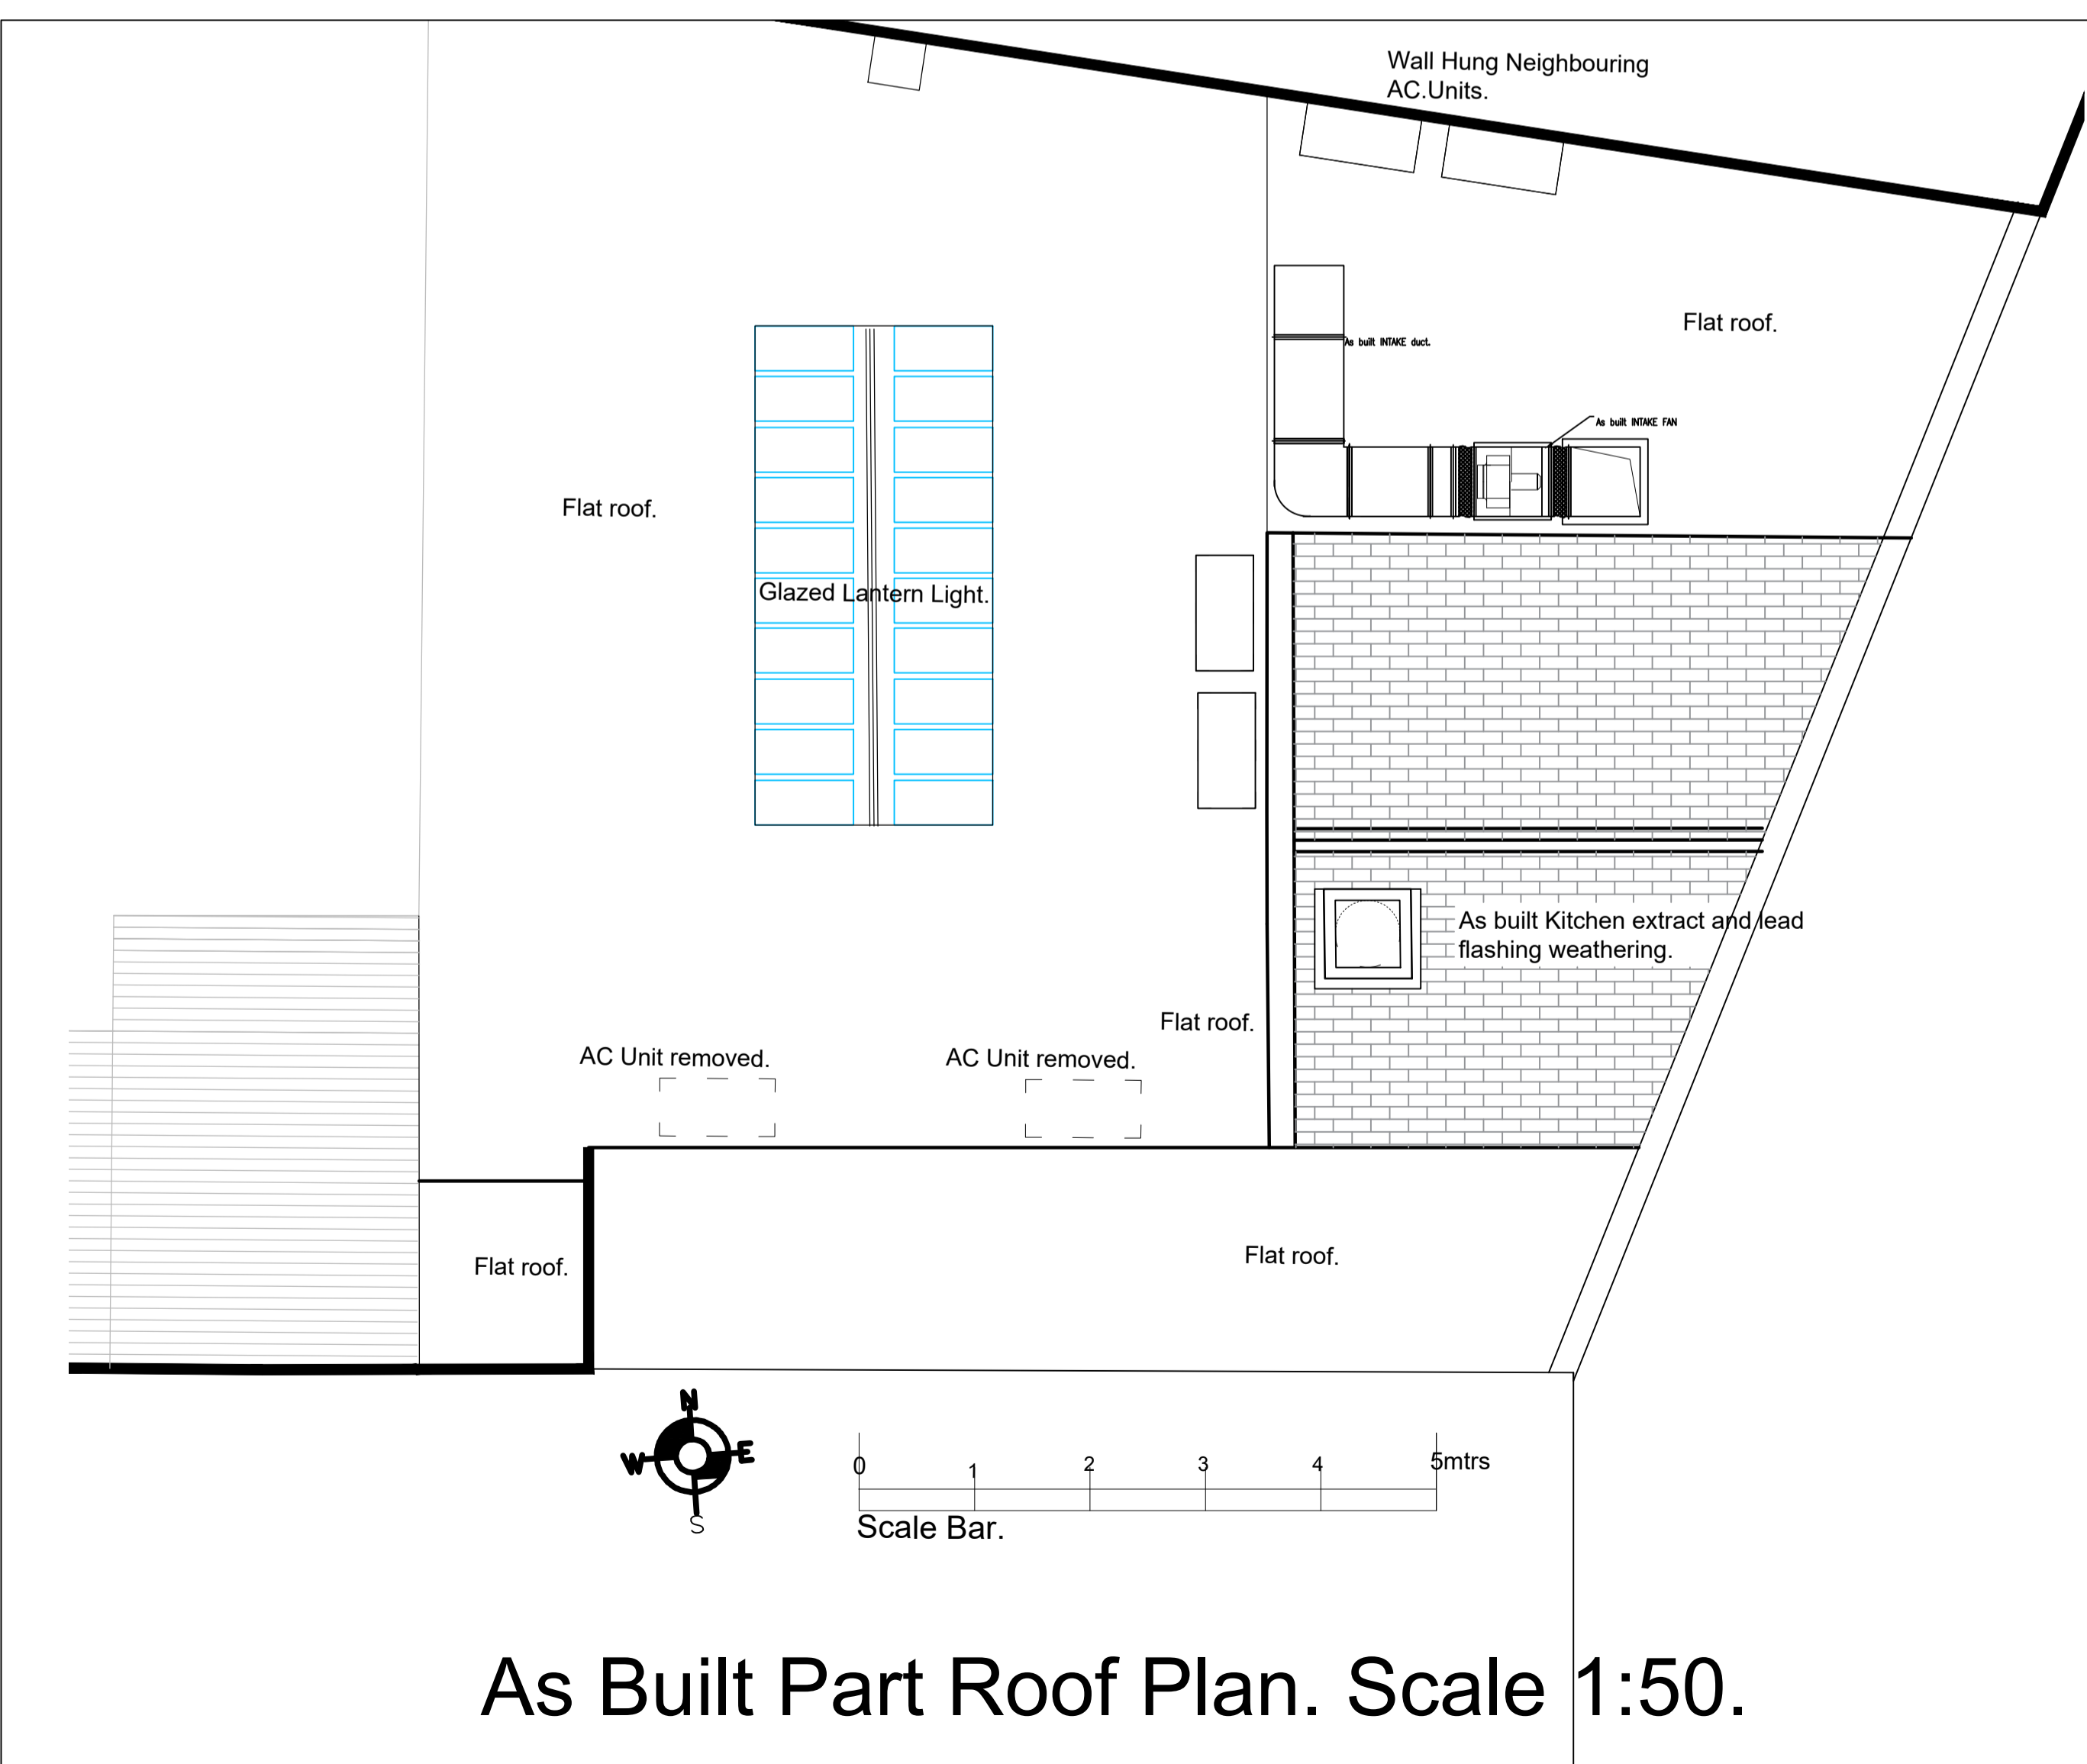

As Built Part Roof Plan. Scale 1:50.

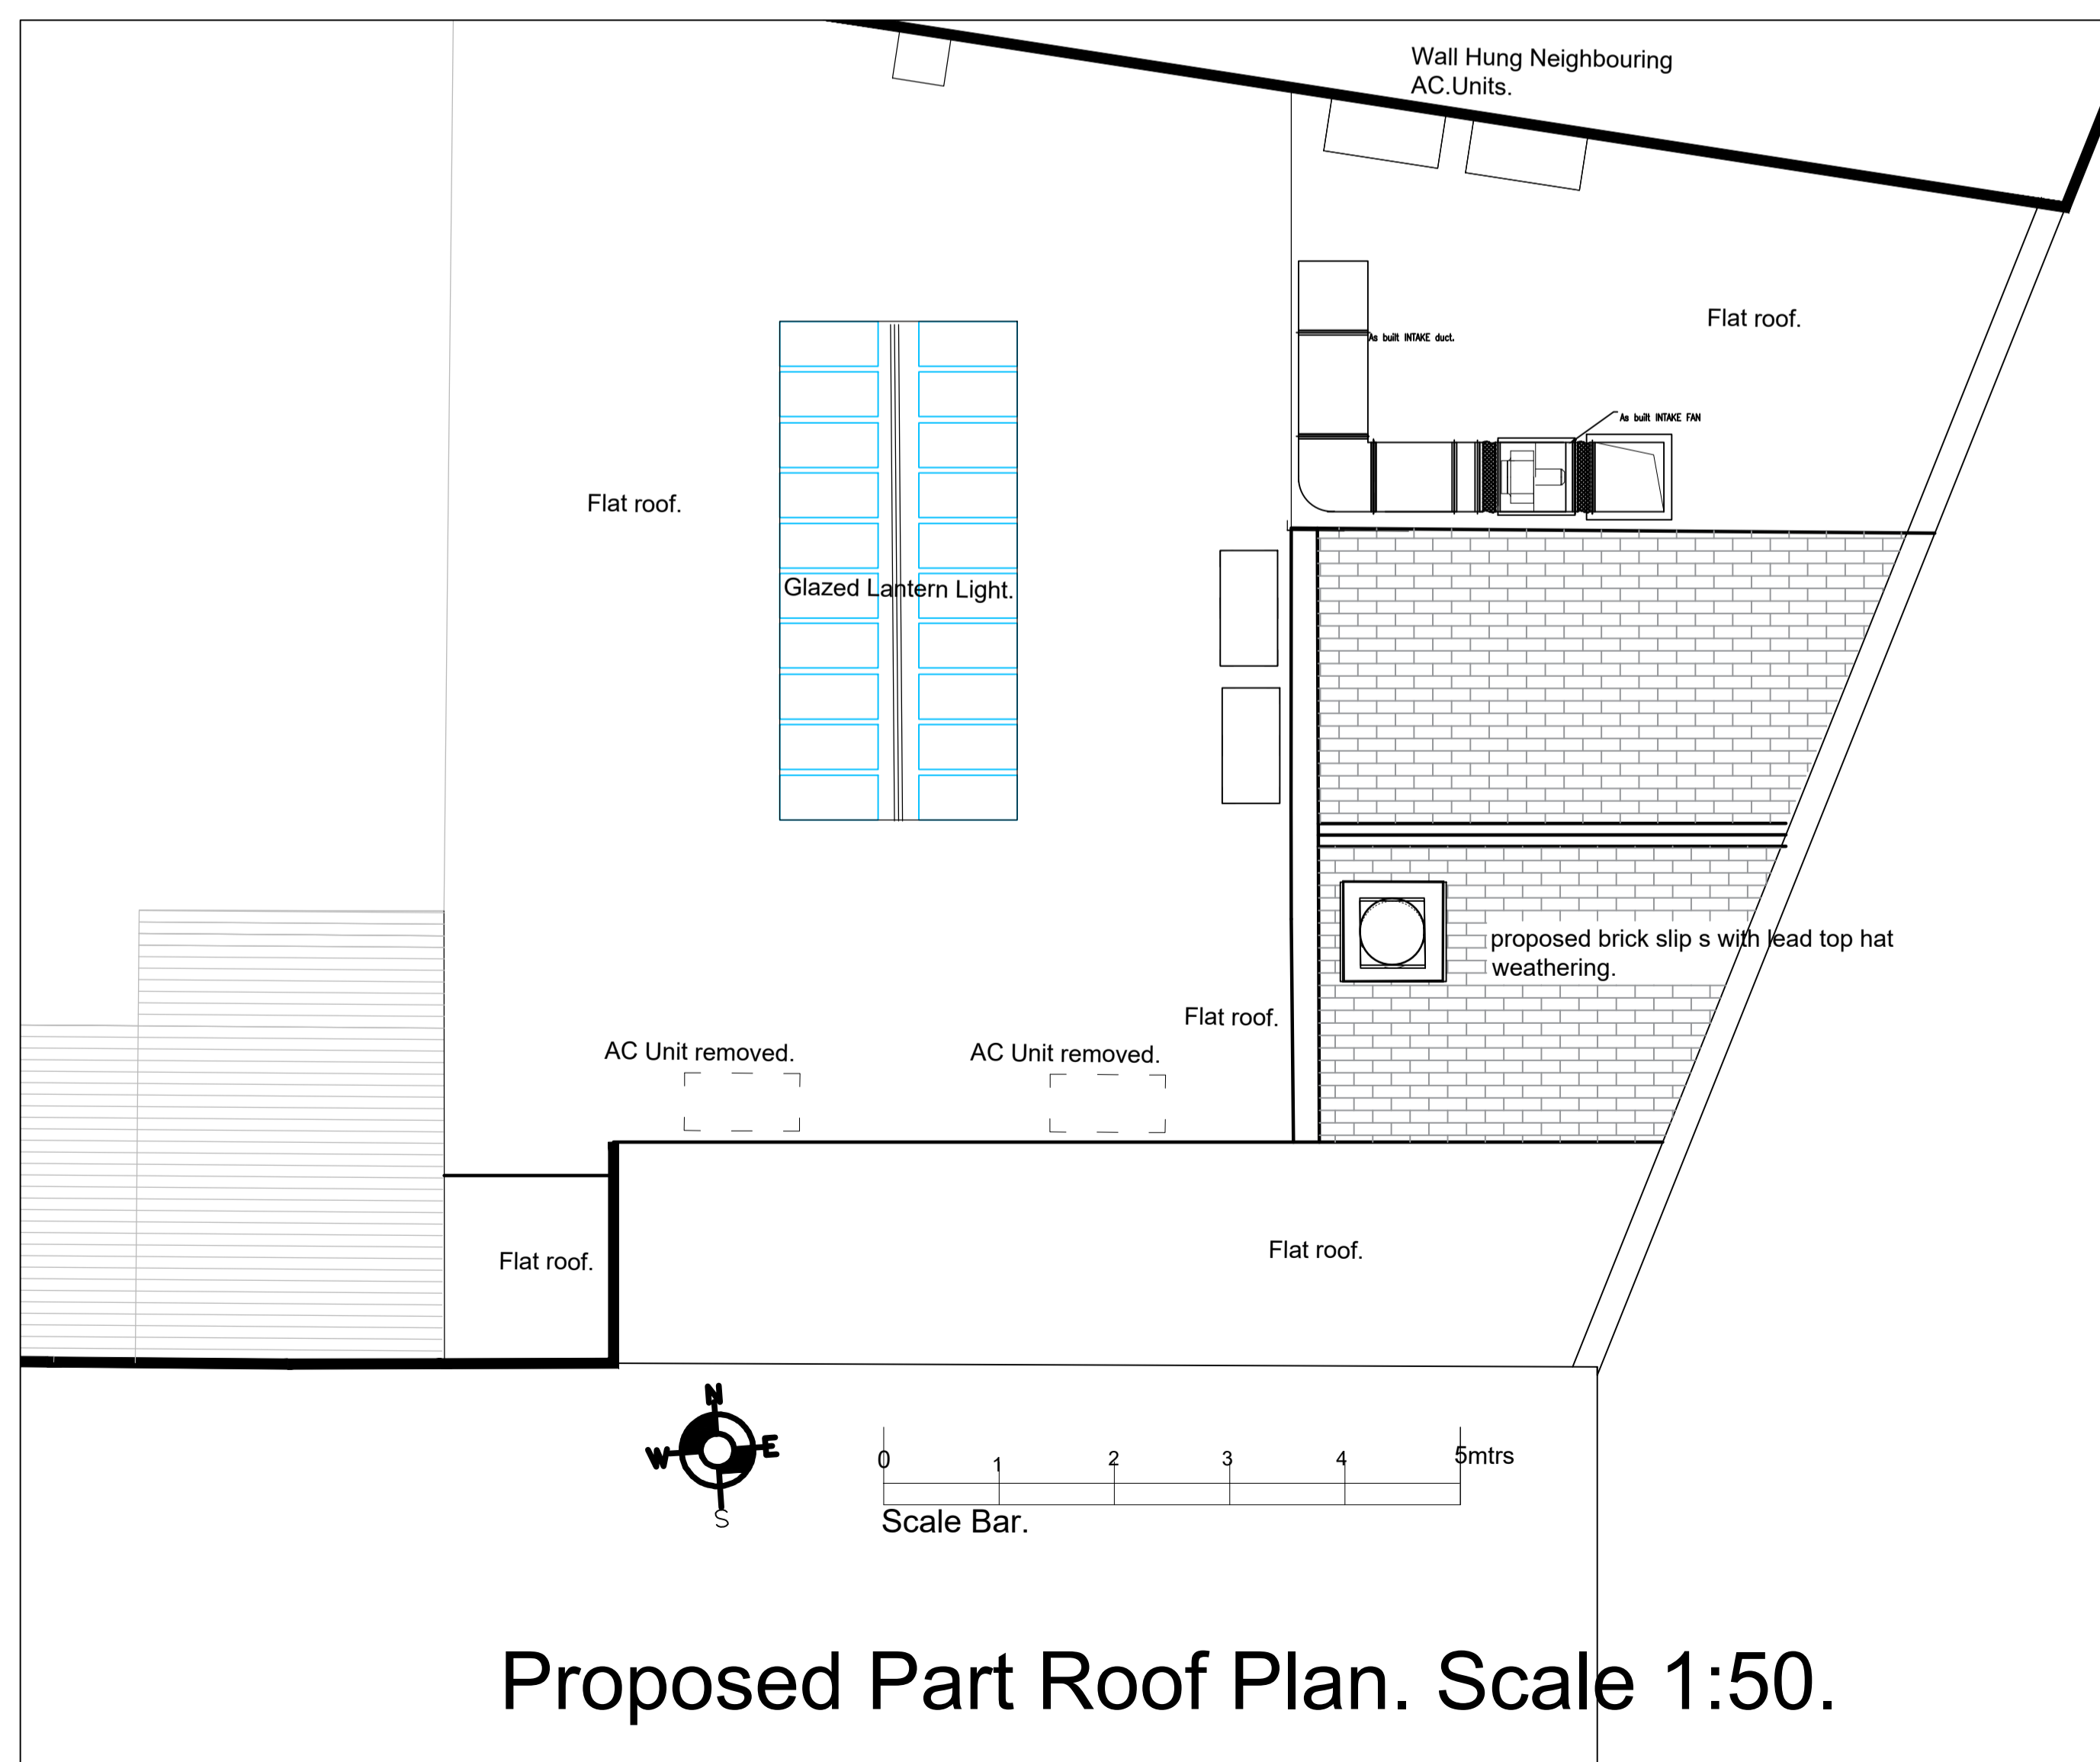

Proposed Part Roof Plan. Scale 1:50.

Rev	Date
Tel: 07919415895 or 07961104958 Sandridge Road St Albans AL1 4AQ	
CLIENT	
Shepherd Neame Limited	
PROJECT	
Duke of Cumberland Hotel High Street ,Whitstable, Kent, CT5 1AP	
TITLE	
Extg/Proposed Regularisation Roof Plans & Detail to Extract.	
ISSUE	
Planning	
Scale: 1:50&1:10	Drawing No.
Date: 07.10.23	1066/PL06
Drawn:	Rev.