




Location Plan - Scale 1:10000

Location Plan - Scale 1:1250

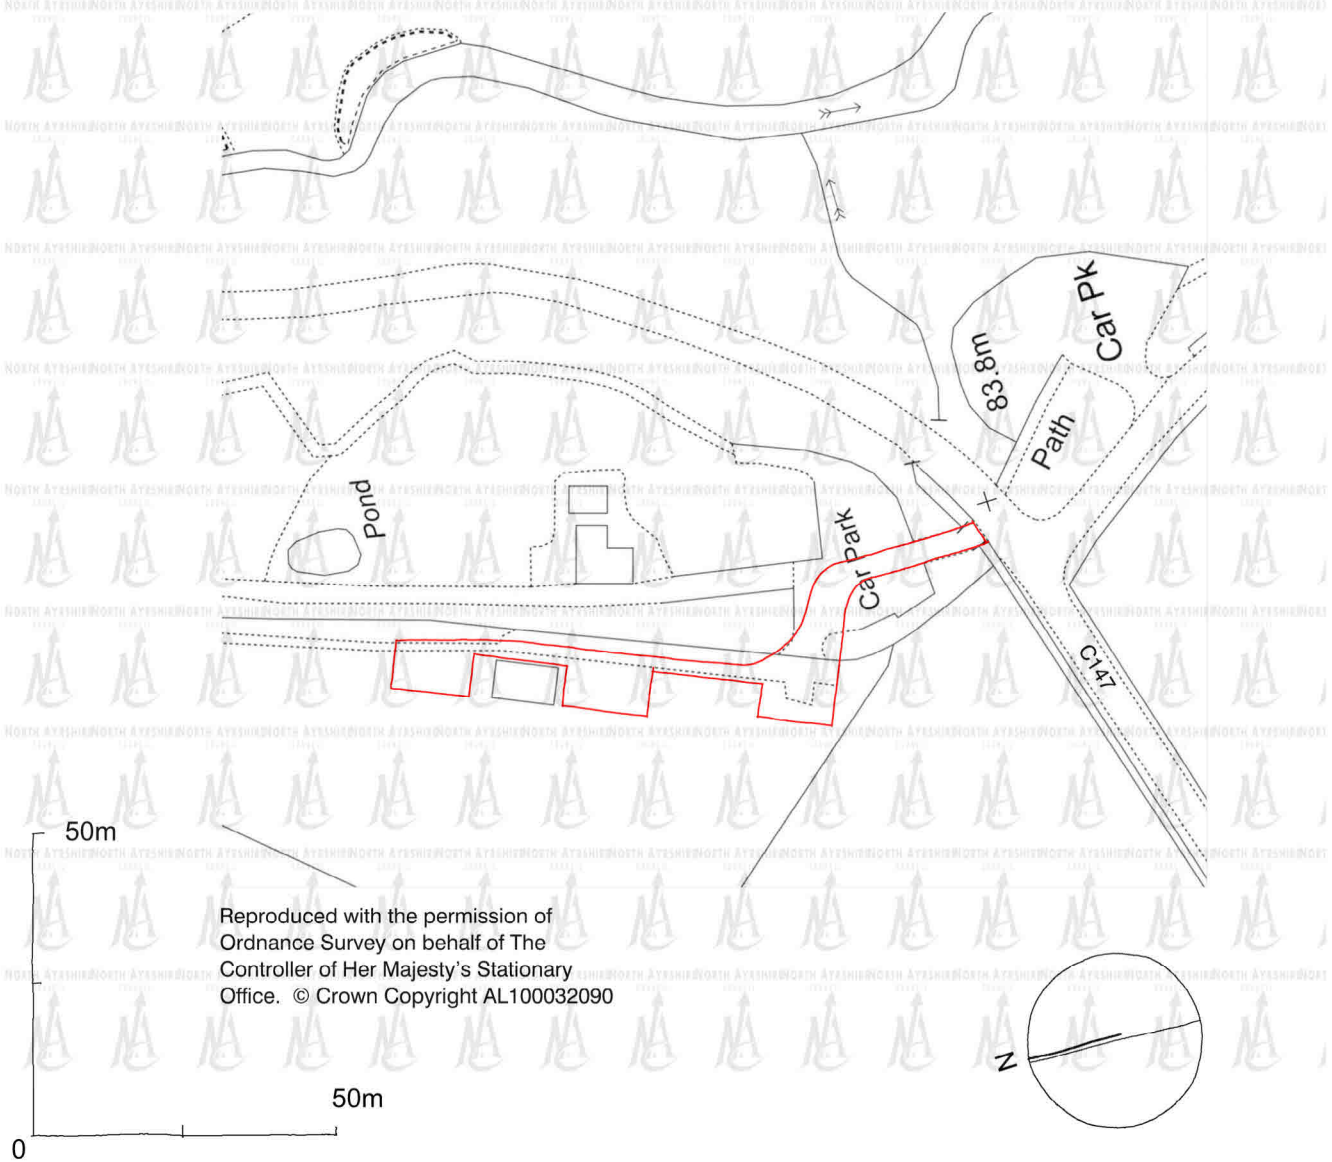

Reproduced with the permission of Ordnance Survey on behalf of The Controller of Her Majesty's Stationary Office. © Crown Copyright AL100032090

Revisions:
A - 3.1.24 - Red line revised for staff accommodation

Do not scale from drawing. Work to figured dimensions only. In event of discrepancy contact architect for clarification before proceeding. If in doubt ASK Dimensions in millimetres.

Drg No Project: Eas Mor Ecology, Kildonan, Isle of Arran

ALASTAIR HOWE ARCHITECT

Title Location Plan

www.alastairhowe.co.uk

L-01a Scale 1:10,000 / 1250 FS @ A4 Date Aug 2023

T. 0 7 9 7 3 5 3 1 4 1 2