SCOTT BROWNRIGG[†]



OXFORD SCIENCE PARK PLOT 23-26

S.73 AMENDMENT APPLICATION REPORT DECEMBER 2023

PREPARED FOR OXFORD CITY COUNCIL 20034-SBR-ZZ-XX-RP-A-80002 REVISION 03

CONTENT

| Approved | | | |
|-----------|--|--|--|
| Signature | | | |
| Date | | | |

© Scott Brownrigg. All right reserved

© Crown Copyright. All right reserved. The OS drawings included in the document are reproduced based on the Ordinance Survey Map with the permission of the Controller of Her Majesty's Stationary Office. Licence No. 100020449. Aerial Photos from Google Earth.

| 1.0 | INTRODUCTION |
|-----|---------------------|
| | |
| | |
| 2 0 | PROPOSED AMENDMENTS |

| Revision | Description | Issued by | Date | Checked |
|----------|----------------------------|-----------|------------|---------|
| 04 | S.73 Amendment Application | LZ | 11/12/2023 | SH |
| | | | | |
| | | | | |

This report has been prepared for the sole benefit, use and information of client for the purposes set out in the report or instructions commissioning it. This report, together with further reports accompanying this application relate to the present situation and may be subject to supplementary information as discussions progress with the local authority.

SBR project number 20034.

1.0 INTRODUCTION

1.0 INTRODUCTION

1.1 S.73 Amendment Application Introduction

This document has been prepared in support of an S.73 Amendment Application for Buildings 1, 2 and 3 on Plots 23-26 Oxford Science Park. The site is located on Grenoble Road, Oxford Science Park, Oxford, OX4 4GE.


The original planning application was submitted for planning to Oxford City Council in September 2022, application Ref 22/02168/FUL.

The complete development comprises of 3 life science buildings with a total of 41,700 sqm GIA along with a multi-storey car park and 2 levels of undercroft parking. The detailed application is accessed from Heatley Road and includes hard and soft landscaping on the site and access and circulation routes through the site for pedestrians, cyclists, cars and servicing. The scheme received full support from the Local Planning Authority.

Following approval, extensive detailed analysis of the ground water levels has been undertaken on site. These water levels surveys have shown that the water table levels are higher than was understood at planning application stage.

This has identified the need for an application for an abstraction licence from the Environment Authority to allow for construction. Due to the time scales associated with the application for this licence, the decision was taken to amend the design from two undercroft levels to one.

Alongside the risk of future flooding, the construction of this level would be prohibitively complex and carbon intense.

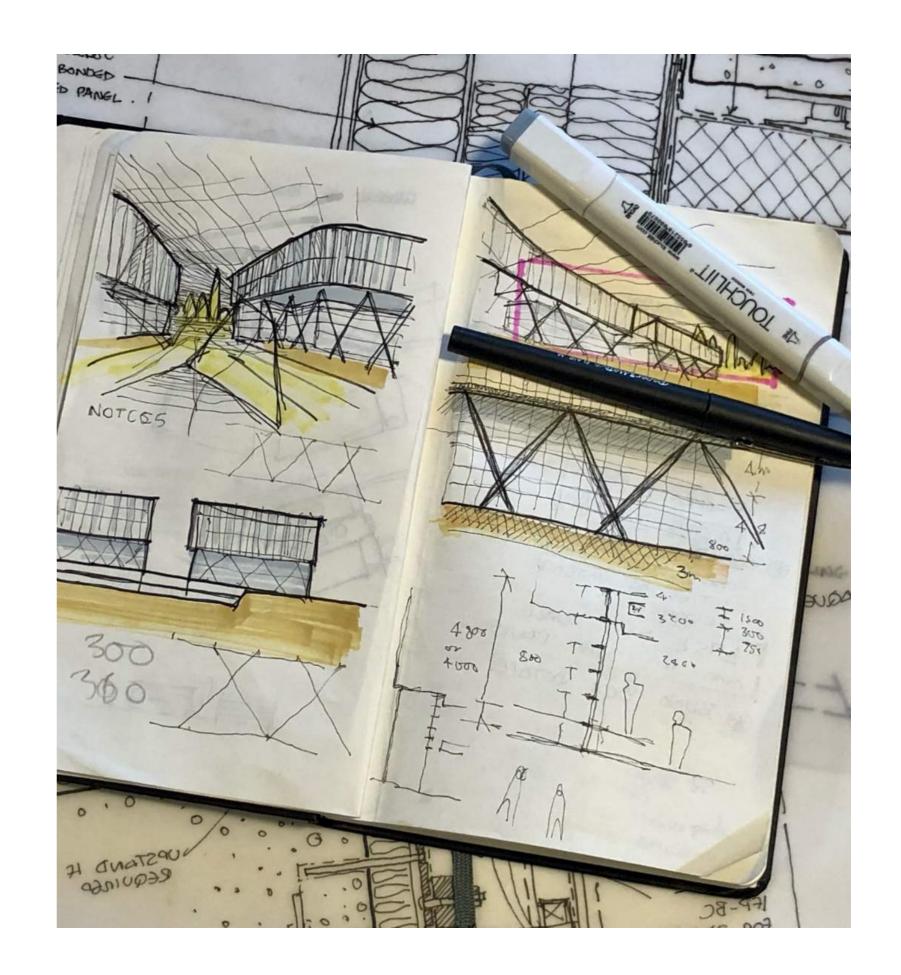



2.0 PROPOSED




2.0 SCHEDULE OF CHANGES

2.1 Key Changes


The key changes discussed in this document comprise of the following:

- The planning was granted for approx. 41,700 sqm GIA mass split across 3 buildings. 2 levels of undercroft car park where proposed below Buildings 1 & 2 without nothing below Building 3. The undercroft car parking at Level -2 of Buildings 1 & 2 has been removed due to the higher water table level which would increase the risk of flooding.
- 2. The level -1 of the undercroft has been extended to incorporate Building 3 resulting in 1 level of undercroft across the 3 buildings.
- 3. The Building 3 shower block at Ground level approved at planning stage has been moved to undercroft to keep consistency across the 3 buildings.
- 4. To be able to deliver above amendments, minor changes to landscape have been proposed.

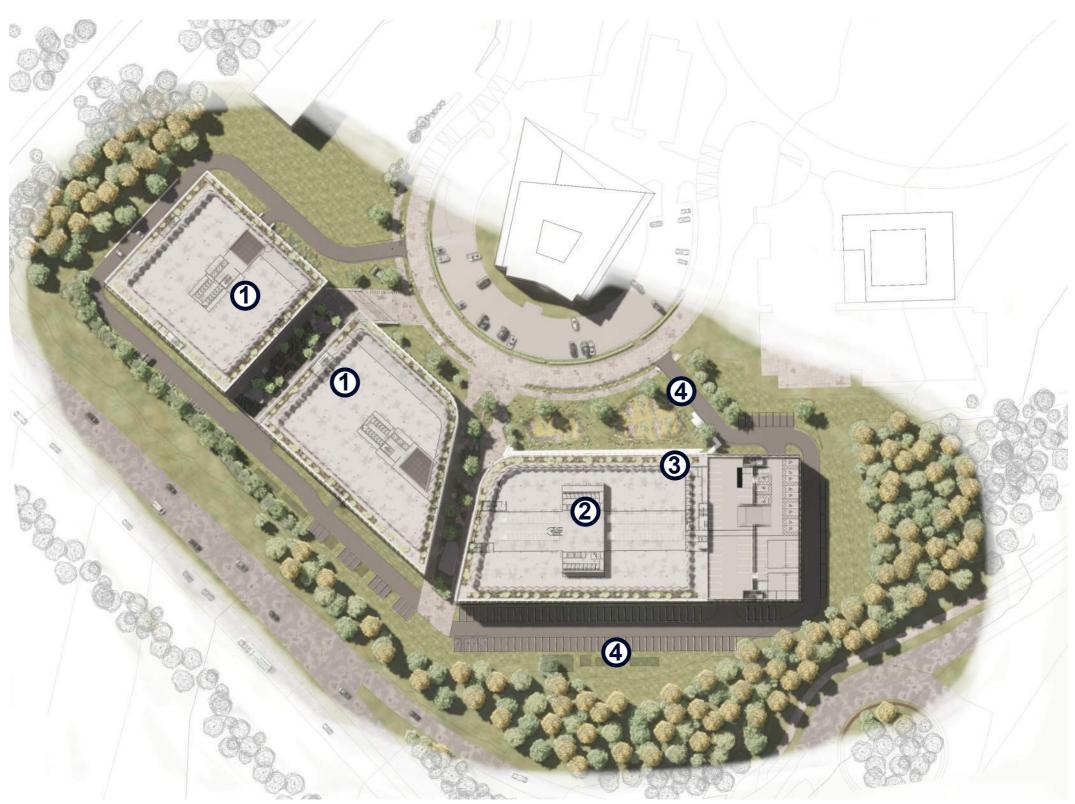


Plots 23-26 Oxford Science Park Masterplan - Planning Approved Plan

2 LEVELS AND 1 LEVEL UNDERCROFT COMPARISON WITH WATER TABLE

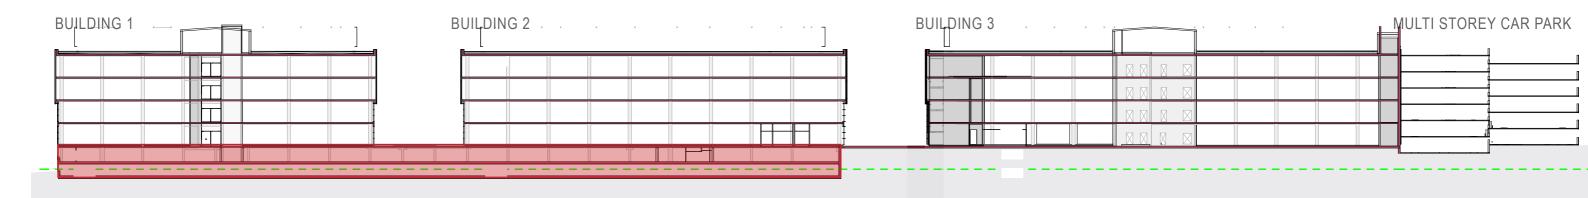

SECTION THROUGH APPROVED SCHEME

SHOWING 2 LEVEL UNDERCROFT AGAINST WATER TABLE LEVEL

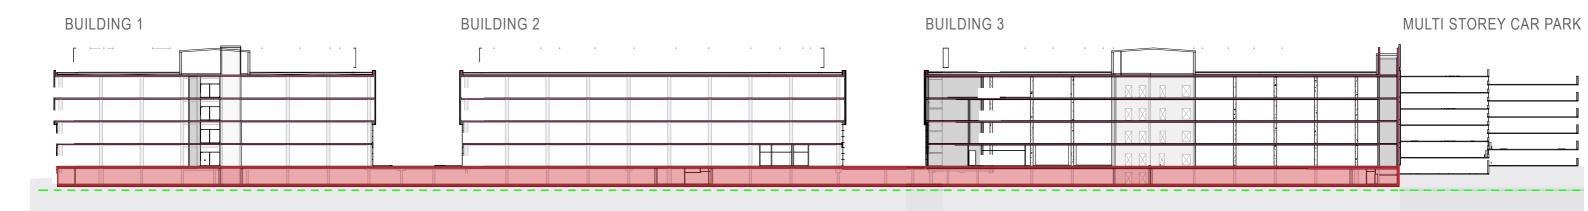

SECTION THROUGH PROPOSED SCHEME


SHOWING 1 LEVEL UNDERCROFT AGAINST WATER TABLE LEVEL

WATER LEVELS SECTIONS


HIGH WATER LEVEL 58920 — — — —



BUILDING 1&2 APPROVED UNDERCROFT PLANS

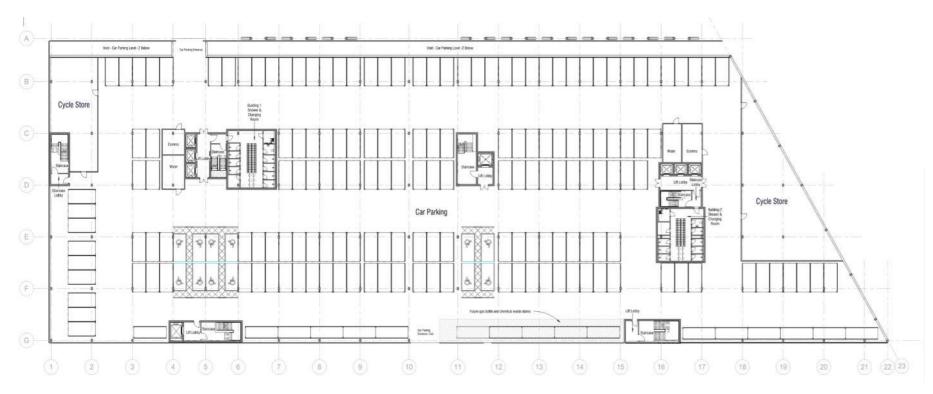


APPROVED BUILDING 1 & 2 LEVEL -1

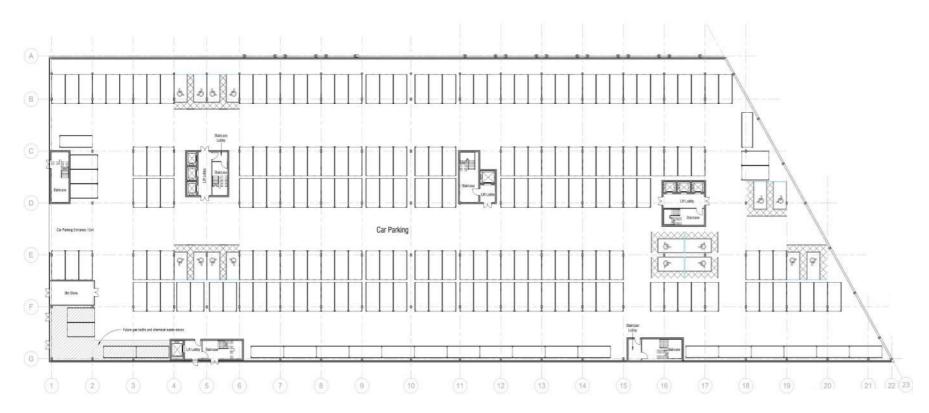


APPROVED BUILDING 1 & 2 LEVEL -2


BUILDING 1, 2 & 3 PROPOSED UNDERCROFT PLAN

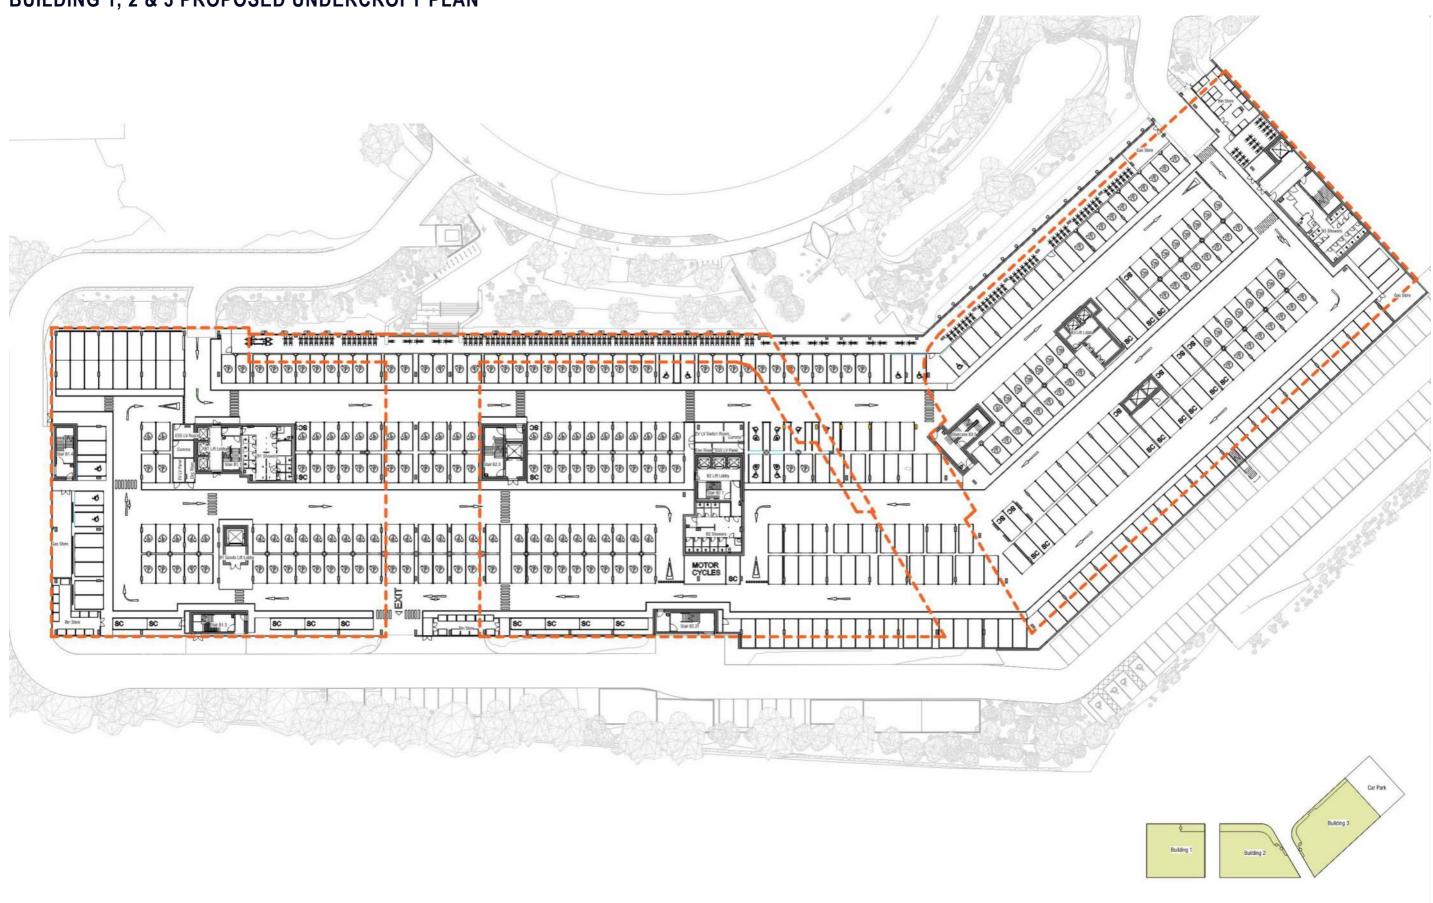

BUILDING 3 APPROVED VS PROPOSED GROUND FLOOR PLAN

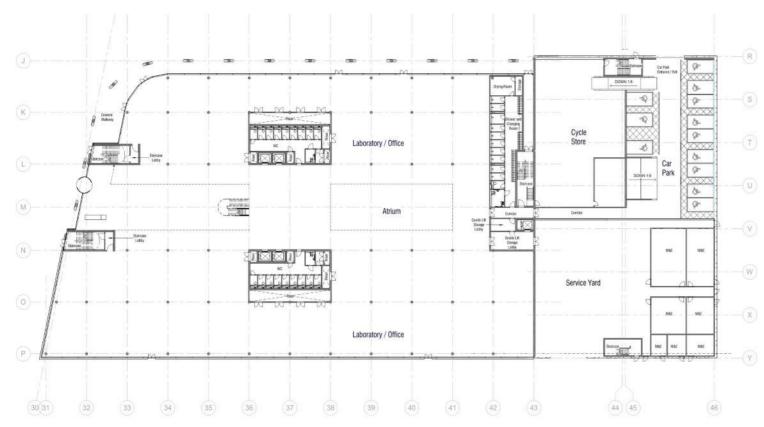

APPROVED BUILDING 3 GROUND FLOOR PLAN

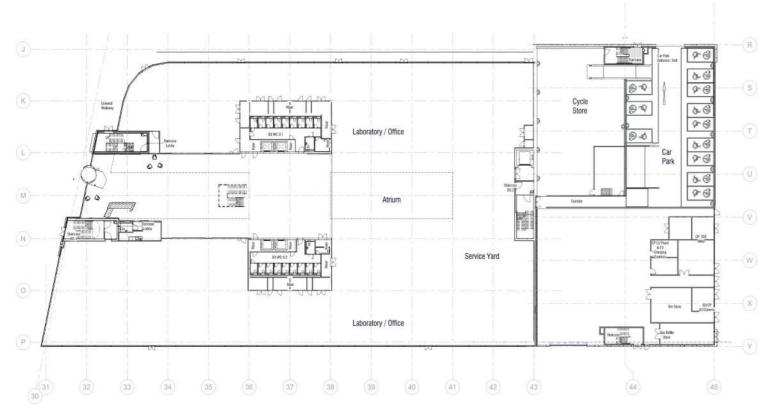


PROPOSED BUILDING 3 GROUND FLOOR PLAN

APPROVED SITE MASTERPLAN



Red Line Boundary Planning Application

PROPOSED SITE MASTERPLAN

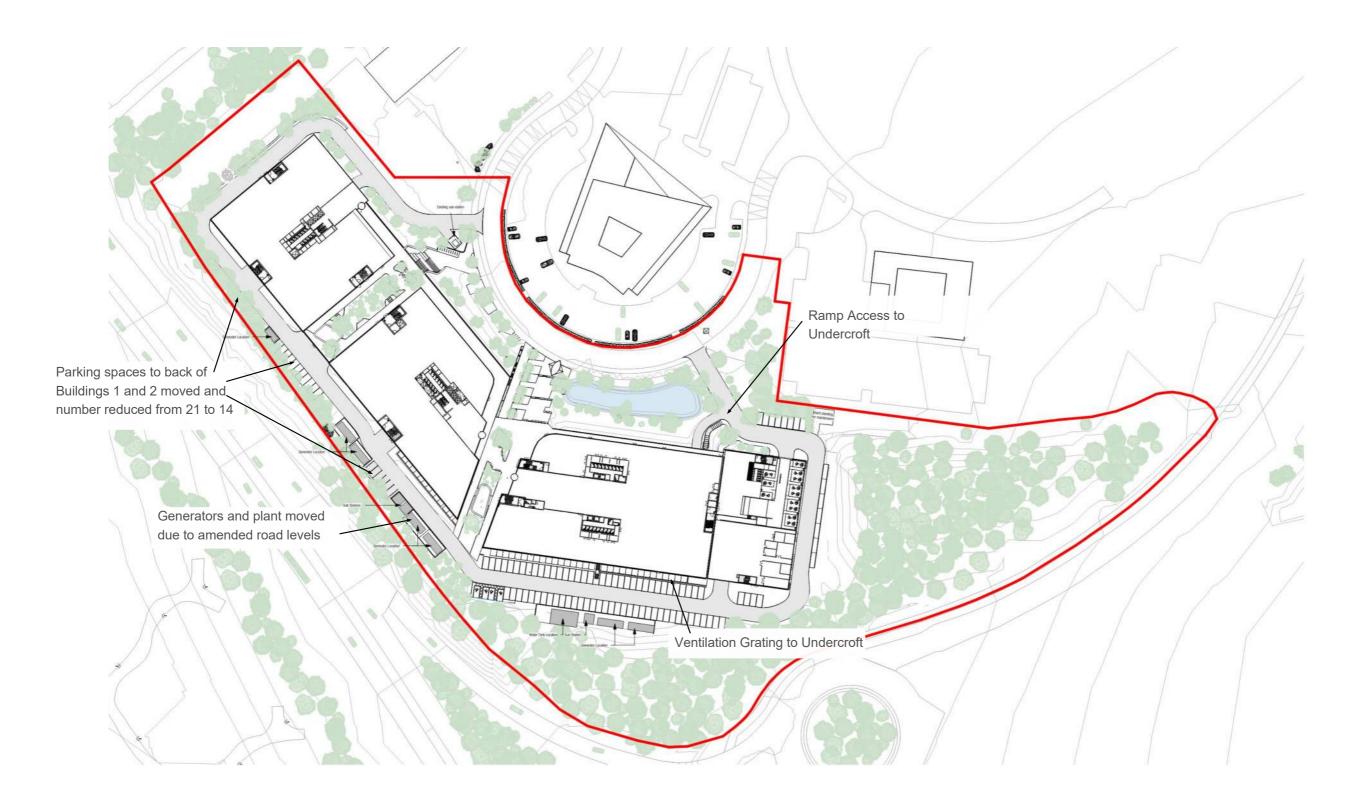

Red Line Boundary Planning Application

APPROVED VS PROPOSED CYCLE STORE NUMBERS

APPROVED CYCLE STORE NUMBERS


UNDERCROFT

Total cycle parking spaces proposed : 312 indoors + 14 outdoors NOTE: ALL CYCLING SPACES IN SHEFFIELD HOOPS

MSCP

Total cycle parking spaces proposed : 211 indoors

OVERALL TOTAL PROPOSED: 523 indoor + 14 outdoor = 537 cycle parking spaces

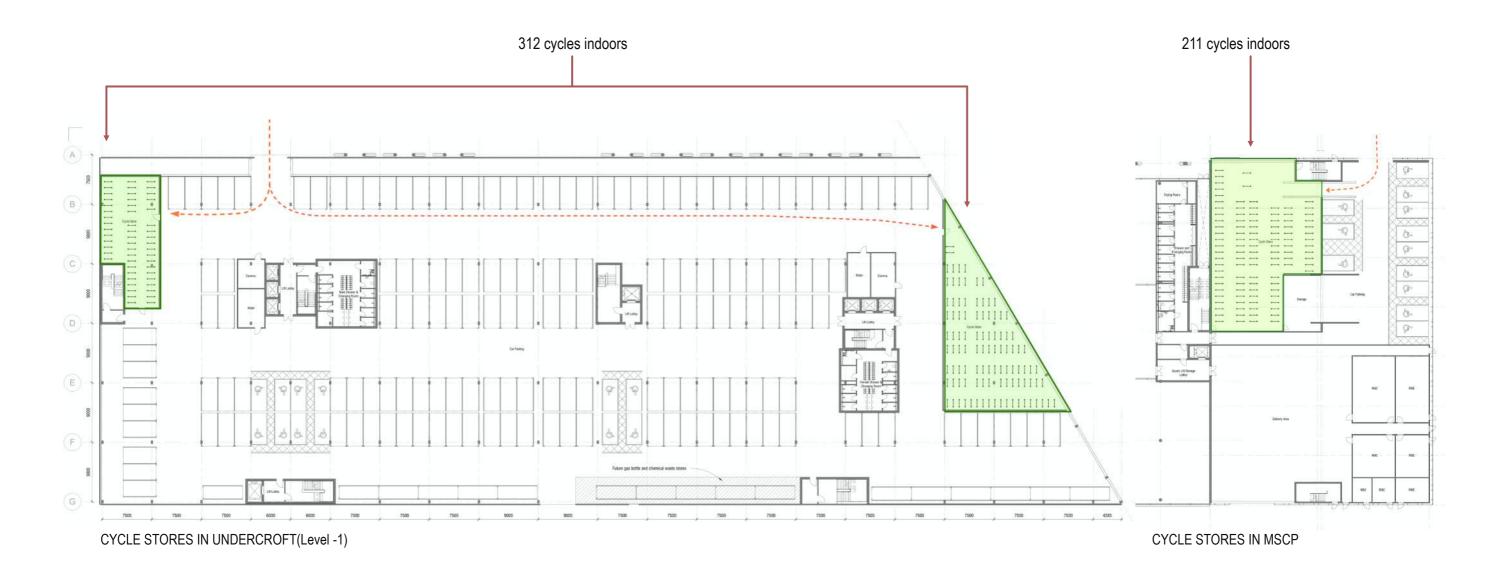

APPROVED VS PROPOSED CYCLE STORE NUMBERS

PROPOSED CYCLE STORE NUMBERS

UNDERCROFT

NOTE: ALL CYCLING SPACES IN SHEFFIELD HOOPS

211 cycles indoors

P Q

9-0

Car Park


Total cycle parking spaces proposed : 312

MSCP

Total cycle parking spaces proposed : 211

ON GRADE

Total cycle parking spaces proposed: 14

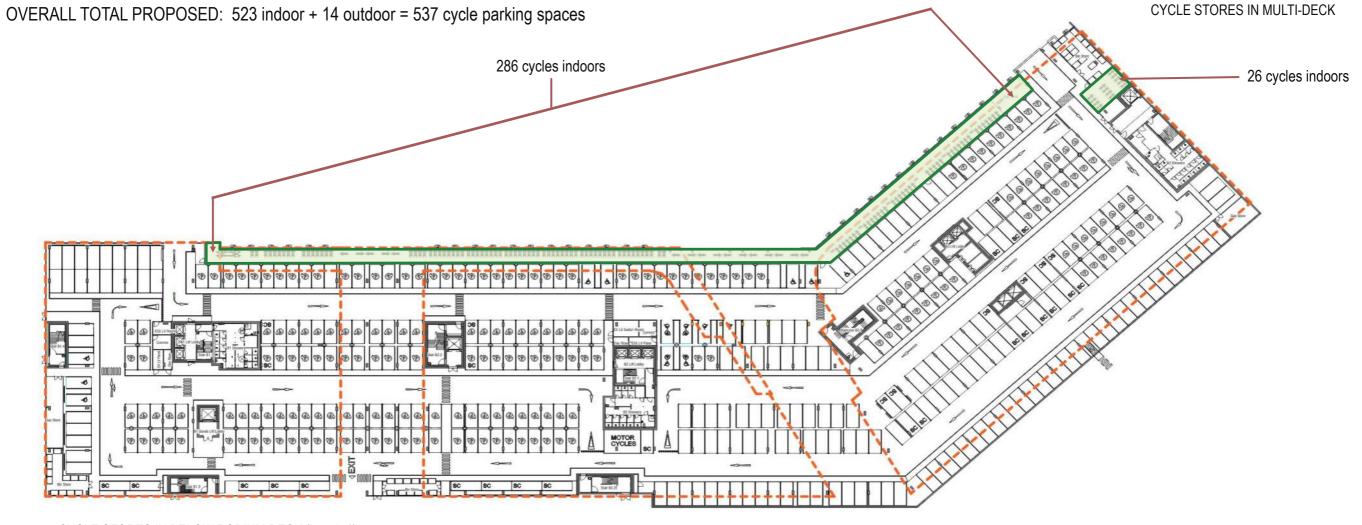

CYCLE STORES IN BELOW PODIUM DECK (Level -1)

APPROVED VS PROPOSED CAR PARKING NUMBERS


APPROVED CAR PARKING SCHEDULE

| PARKING | TOTAL | ACCESIBLE |
|---------------------|-------|-----------|
| Under Croft Parking | 427 | 28 |
| External Parking | 125 | 6 |
| Multi Storey Deck | 340 | 10 |
| TOTAL | 892 | 44 |

APPROVED CAR PARKING DRAWINGS




BUILDING 1&2_ LEVEL -1 BELOW PODIUM DECK

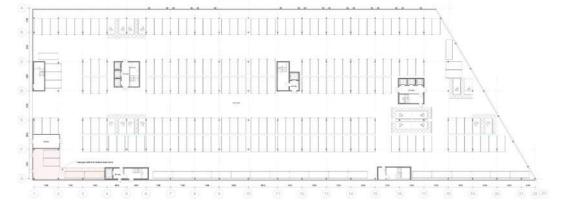



BUILDING 1&2_ LEVEL -2 BELOW PODIUM DECK




BUILDING 3_ LEVEL 0

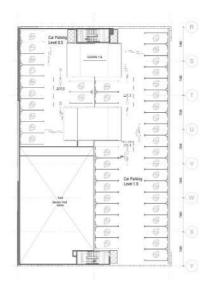

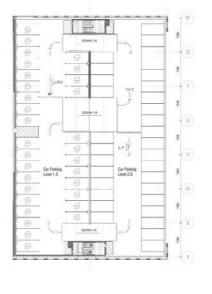

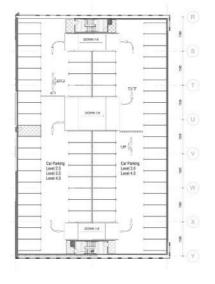

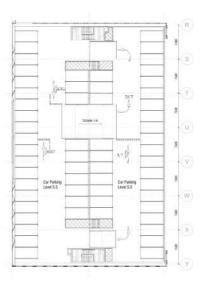

BUILDING 3_ LEVEL 0.5 & 1

BUILDING 3_ LEVEL 1.5 & 2

BUILDING 3_ Typical Floor

BUILDING 3_ LEVEL 5 & 5.5


[•]Level 2.5 •Level 3.0 •Level 3.5

[•]Level 4.0


[•]Level 4.5

APPROVED VS PROPOSED CAR PARKING NUMBERS


PROPOSED CAR PARKING SCHEDULE

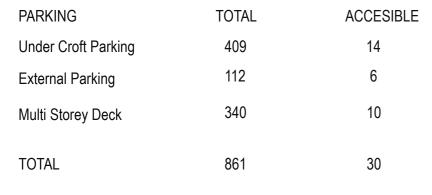



PROPOSED CAR PARKING DRAWINGS

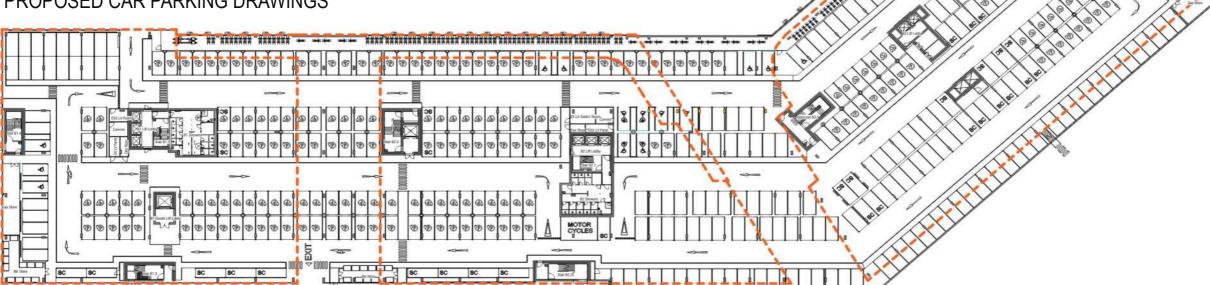



BUILDING 1&2_ LEVEL -1 BELOW PODIUM DECK

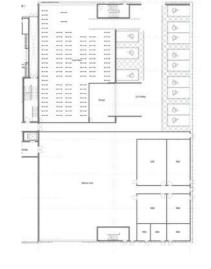

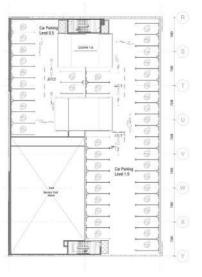

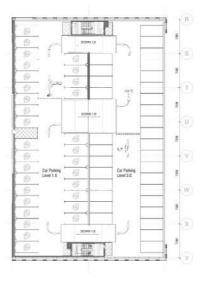

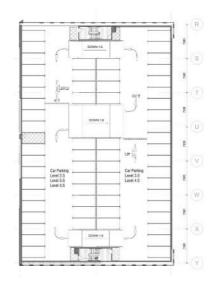

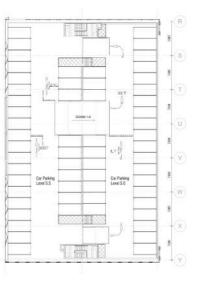

BUILDING 3_ LEVEL 0 BUILDING 3_ LEVEL 0.5 & 1

BUILDING 3_ LEVEL 1.5 & 2

BUILDING 3_ Typical Floor

BUILDING 3_ LEVEL 5 & 5.5


•Level 4.0 •Level 4.5

[•]Level 2.5 •Level 3.0

[•]Level 3.5



BUILDING 1, 2 & 3 APPROVED SITE SECTIONS VS PROPOSED SITE SECTIONS

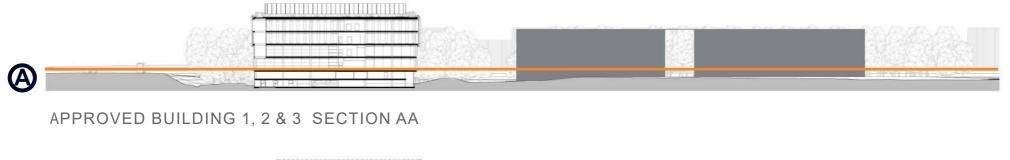




PROPOSED BUILDING 1, 2 & 3 SECTION AA



APPROVED BUILDING 1, 2 & 3 SECTION BB




PROPOSED BUILDING 1, 2 & 3 SECTION BB

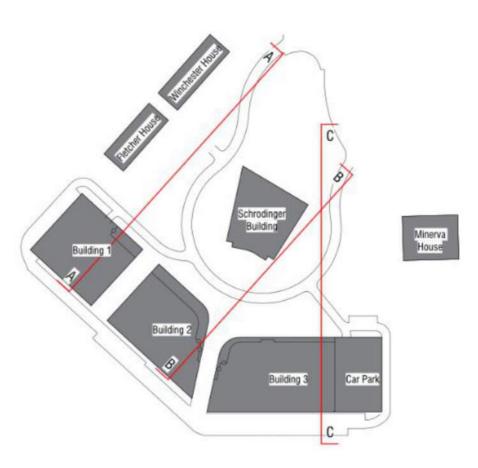


BUILDING 1, 2 & 3 APPROVED SITE SECTIONS VS PROPOSED SITE SECTIONS




PROPOSED BUILDING 1, 2 & 3 SECTION CC

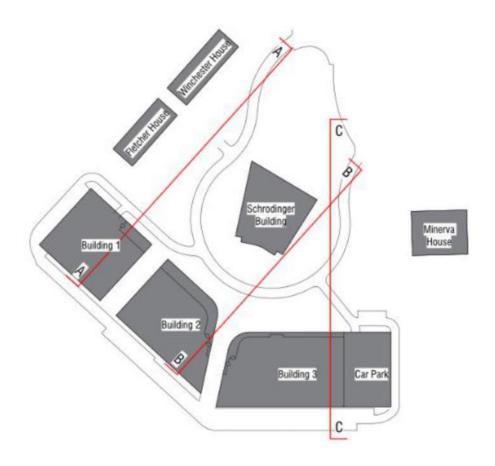

BUILDING 1 APPROVED ELEVATIONS VS PROPOSED ELEVATIONS

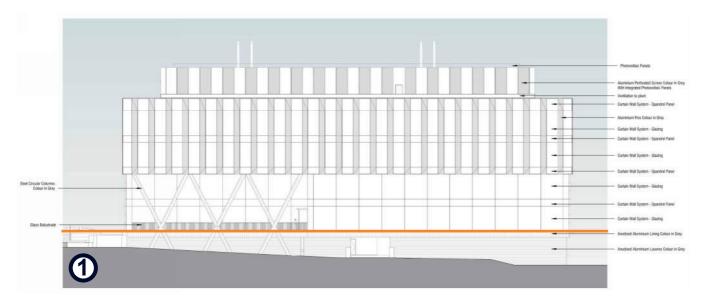

APPROVED BUILDING 1 NORTH EAST ELEVATION

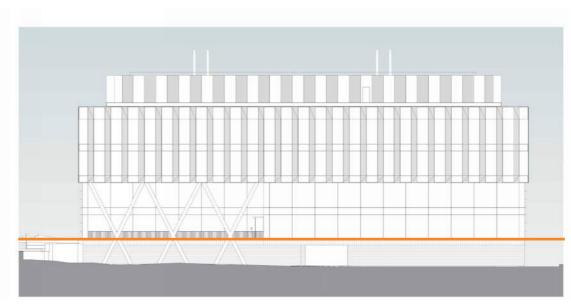


PROPOSED BUILDING 1 NORTH EAST ELEVATION



APPROVED BUILDING 1 NORTH WEST ELEVATION



PROPOSED BUILDING 1 NORTH WEST ELEVATION

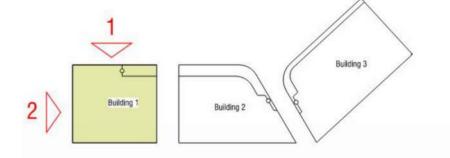

BUILDING 1 APPROVED ELEVATIONS VS PROPOSED ELEVATIONS



APPROVED BUILDING 1 SOUTH EAST ELEVATION




APPROVED BUILDING 1 SOUTH WEST ELEVATION







PROPOSED BUILDING 1 SOUTH EAST ELEVATION

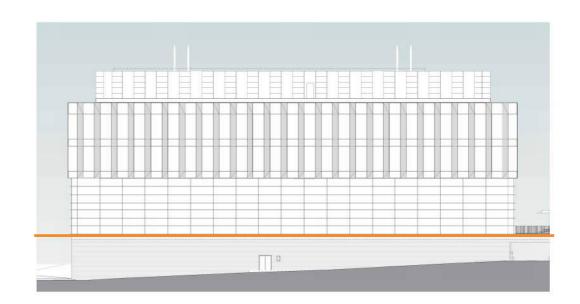

PROPOSED BUILDING 1 SOUTH WEST ELEVATION

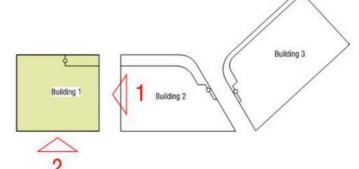


BUILDING 2 APPROVED ELEVATIONS VS PROPOSED ELEVATIONS

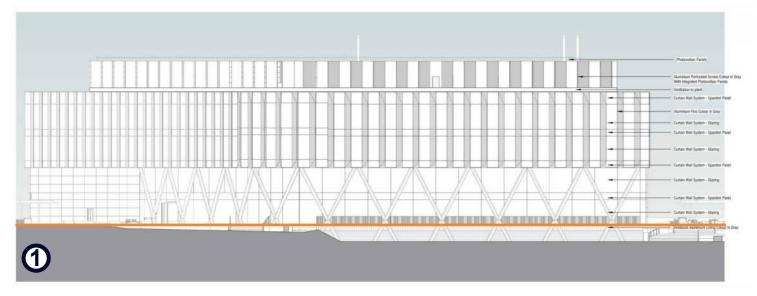




APPROVED BUILDING 2 NORTH EAST ELEVATION

PROPOSED BUILDING 2 NORTH EAST ELEVATION

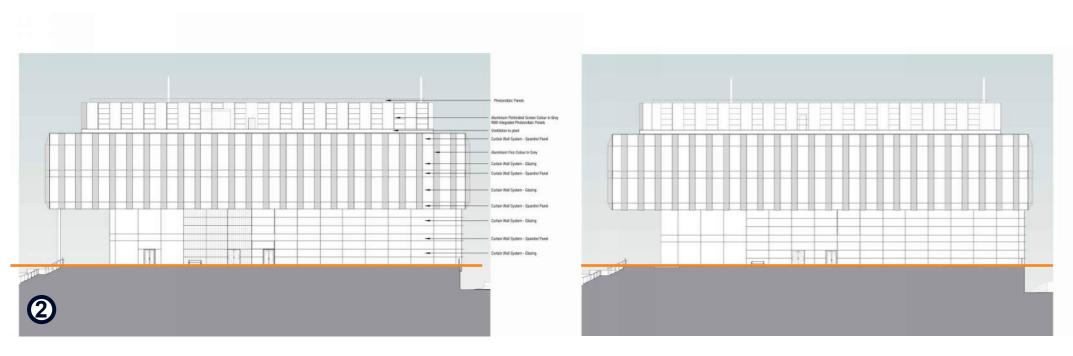


APPROVED BUILDING 2 NORTH WEST ELEVATION

PROPOSED BUILDING 2 NORTH WEST ELEVATION

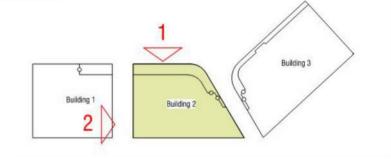


BUILDING 2 APPROVED ELEVATIONS VS PROPOSED ELEVATIONS

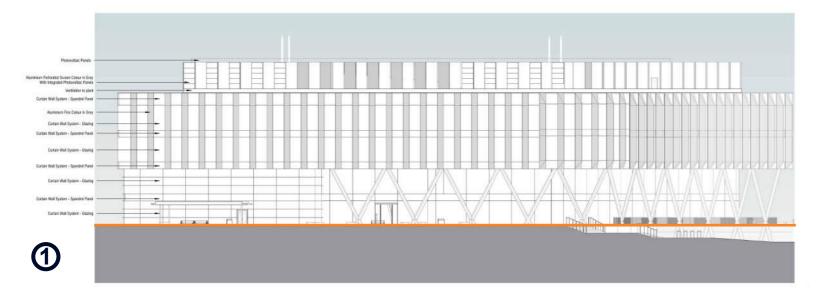





APPROVED BUILDING 2 SOUTH EAST ELEVATION

PROPOSED BUILDING 2 SOUTH EAST ELEVATION

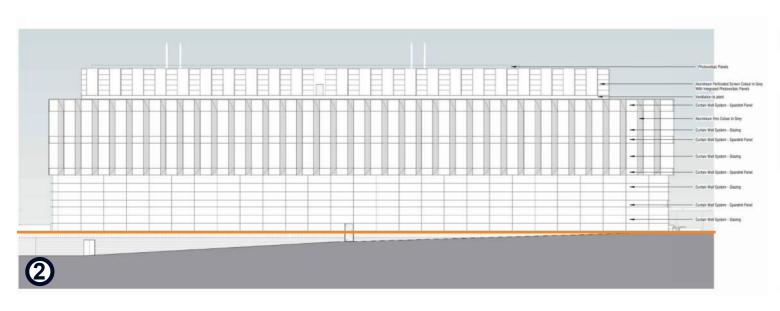


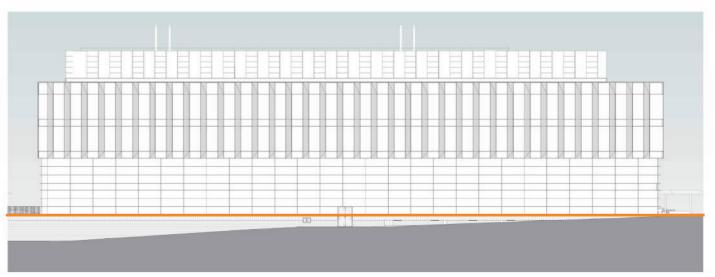


APPROVED BUILDING 2 SOUTH WEST ELEVATION

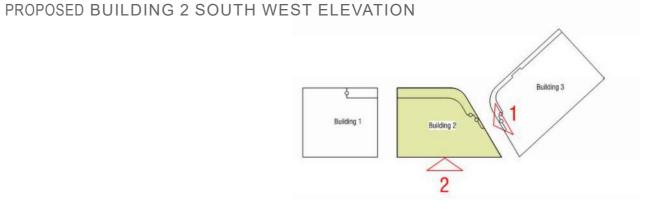


BUILDING 3 APPROVED ELEVATIONS VS PROPOSED ELEVATIONS

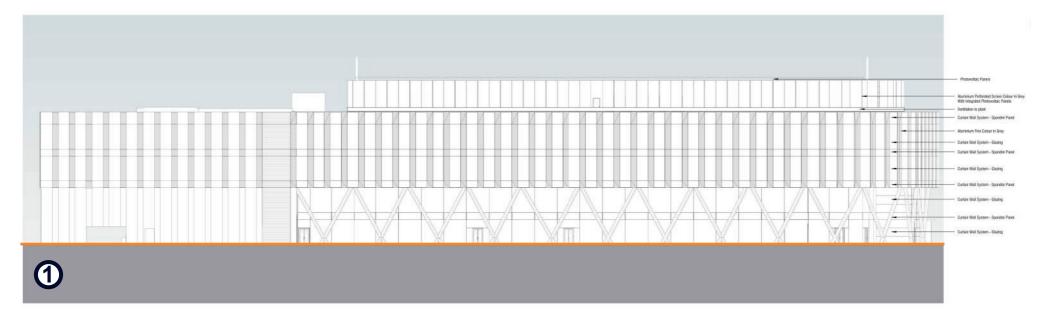

APPROVED BUILDING 3 NORTH EAST ELEVATION

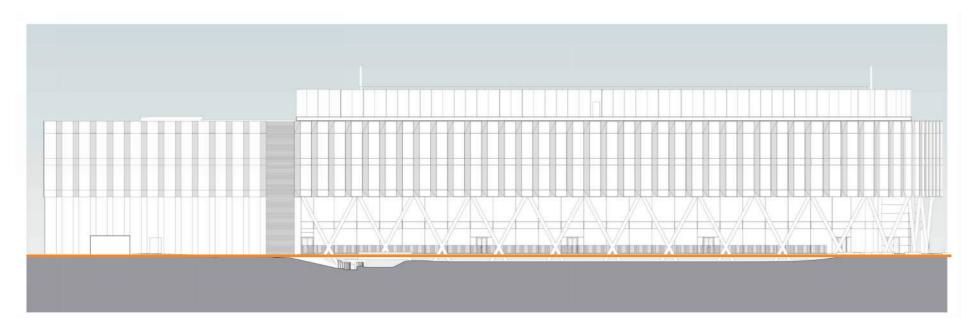


PROPOSED BUILDING 3 NORTH EAST ELEVATION

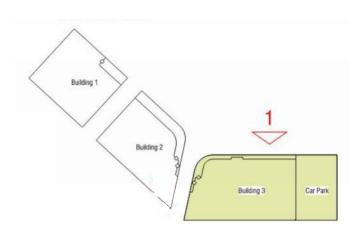


BUILDING 3 APPROVED ELEVATIONS VS PROPOSED ELEVATIONS




APPROVED BUILDING 3 SOUTH EAST ELEVATION

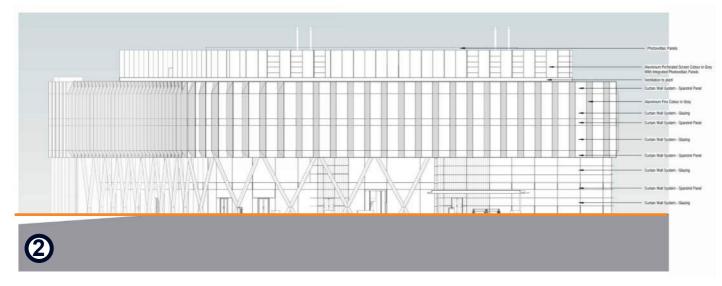


APPROVED BUILDING 3 NORTH WEST ELEVATION

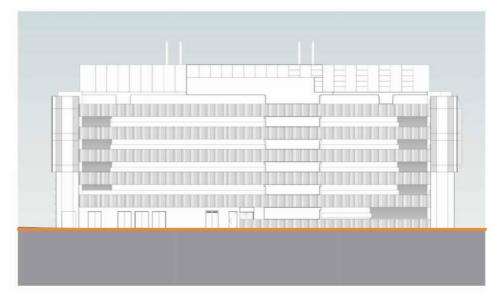

PROPOSED BUILDING 3 SOUTH EAST ELEVATION

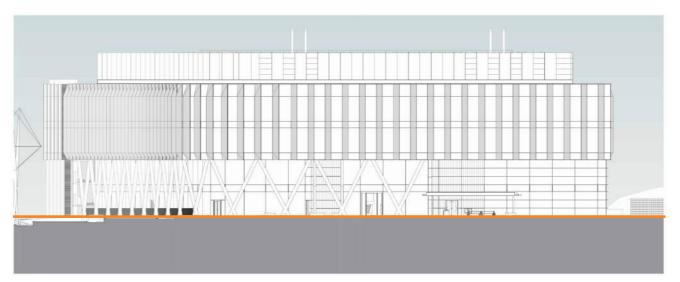

PROPOSED BUILDING 3 NORTH WEST ELEVATION

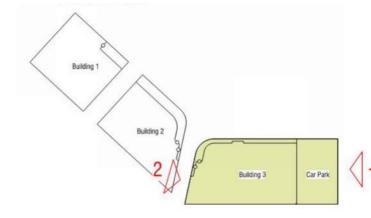


BUILDING 3 APPROVED ELEVATIONS VS PROPOSED ELEVATIONS



APPROVED BUILDING 3 SOUTH WEST ELEVATION




PROPOSED BUILDING 3 SOUTH WEST ELEVATION

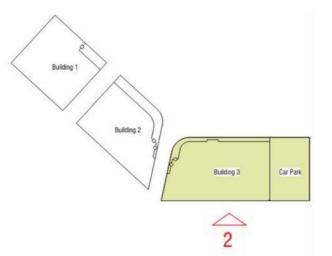




BUILDING 1 APPROVED SECTIONS VS PROPOSED SECTIONS

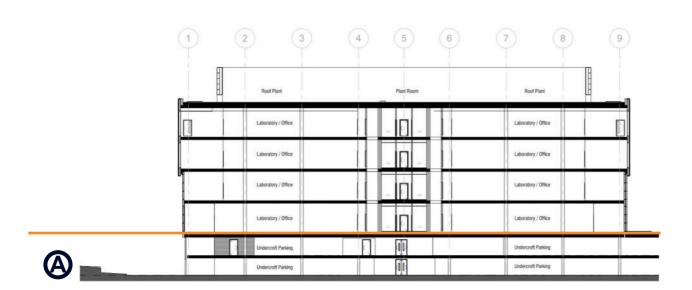


APPROVED BUILDING 1 SECTION AA

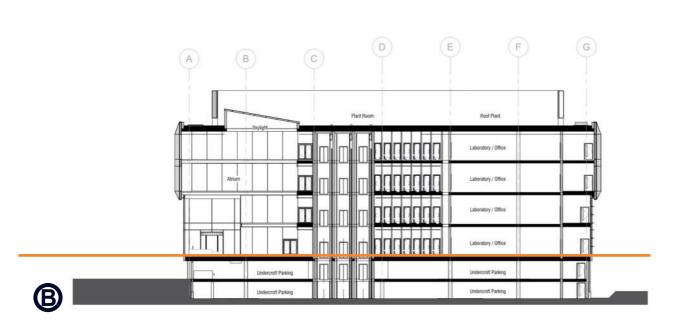


APPROVED BUILDING 1 SECTION BB




PROPOSED BUILDING 1 SECTION AA

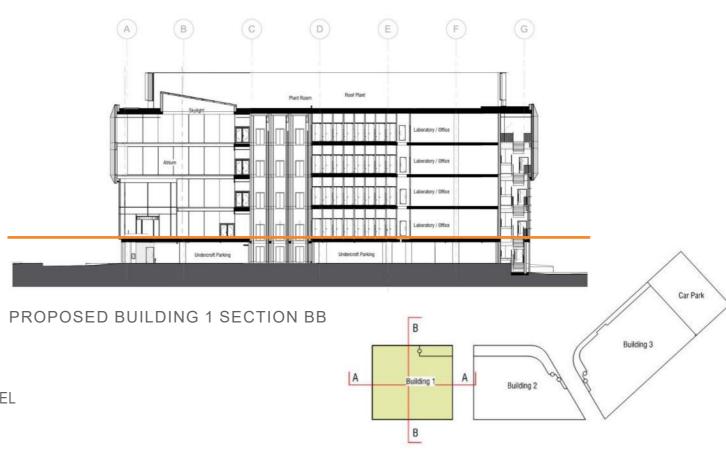


BUILDING 1 APPROVED SECTIONS VS PROPOSED SECTIONS

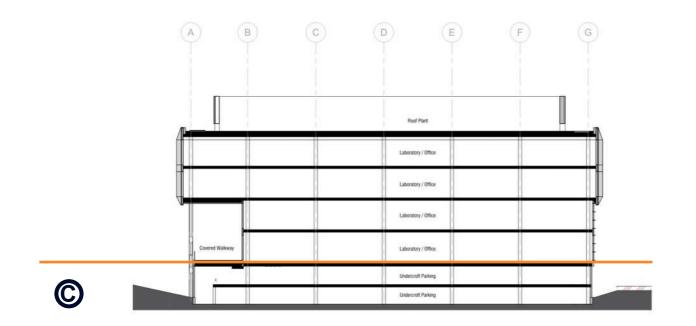

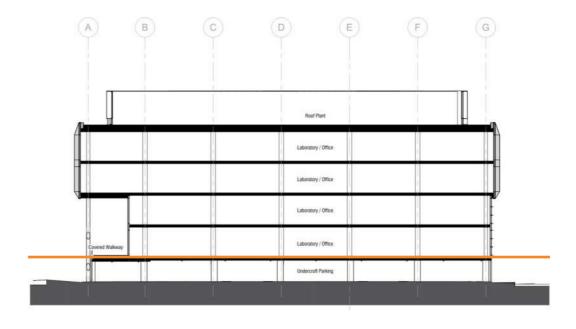


APPROVED BUILDING 1 SECTION CC


PROPOSED BUILDING 1 SECTION CC

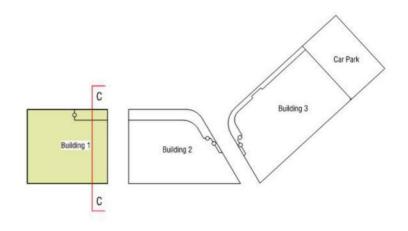


BUILDING 2 APPROVED SECTIONS VS PROPOSED SECTIONS

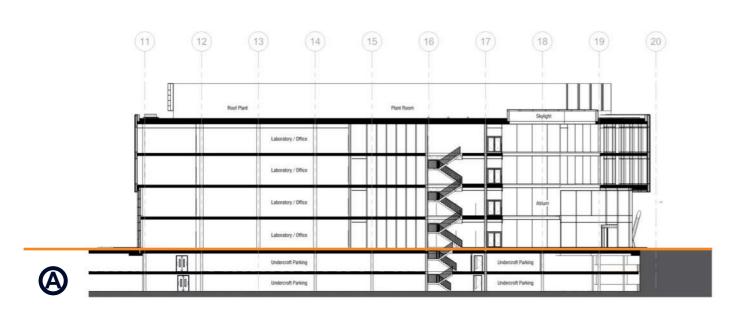


APPROVED BUILDING 2 SECTION AA

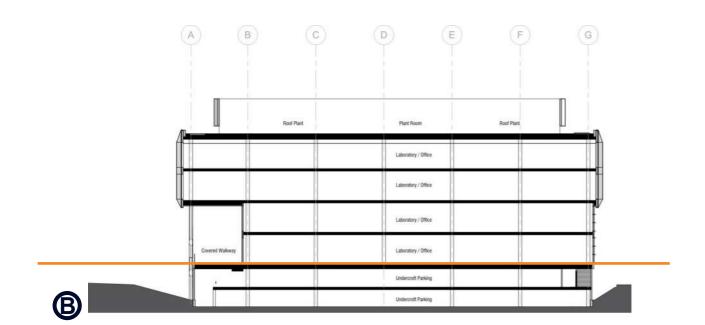


APPROVED BUILDING 2 SECTION BB

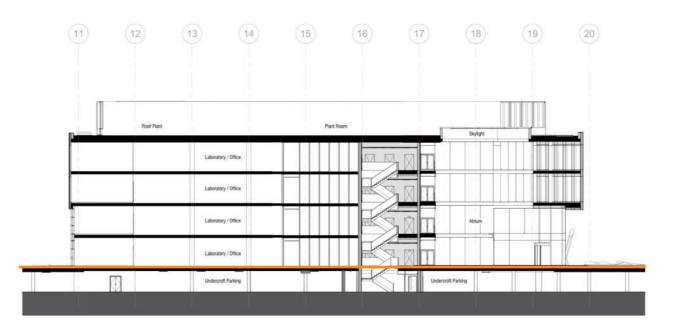


PROPOSED BUILDING 2 SECTION AA

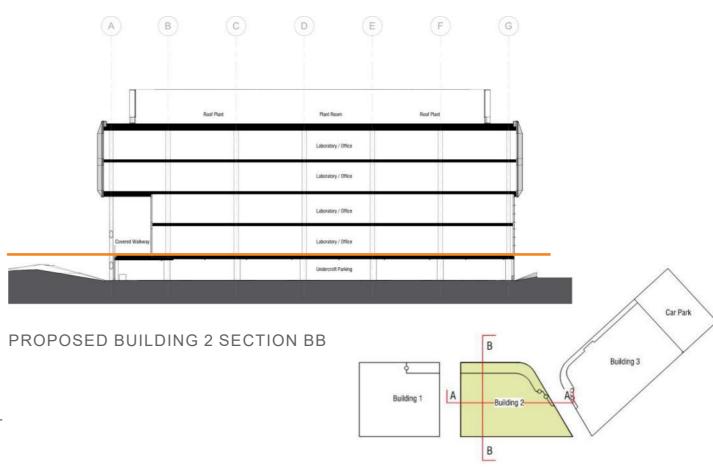

BUILDING 2 APPROVED SECTIONS VS PROPOSED SECTIONS

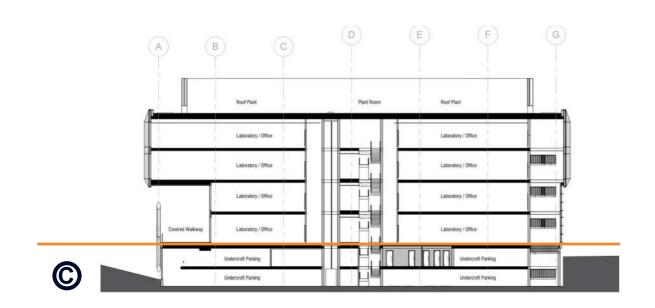

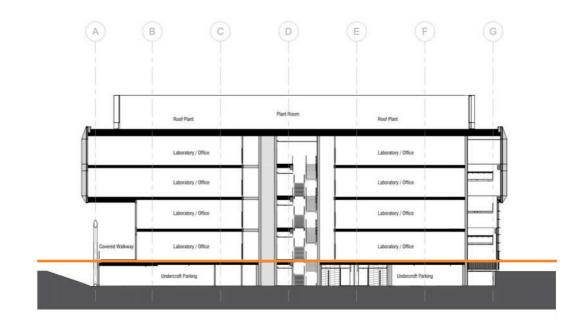


APPROVED BUILDING 2 SECTION CC


PROPOSED BUILDING 2 SECTION CC




BUILDING 3 APPROVED SECTIONS VS PROPOSED SECTIONS

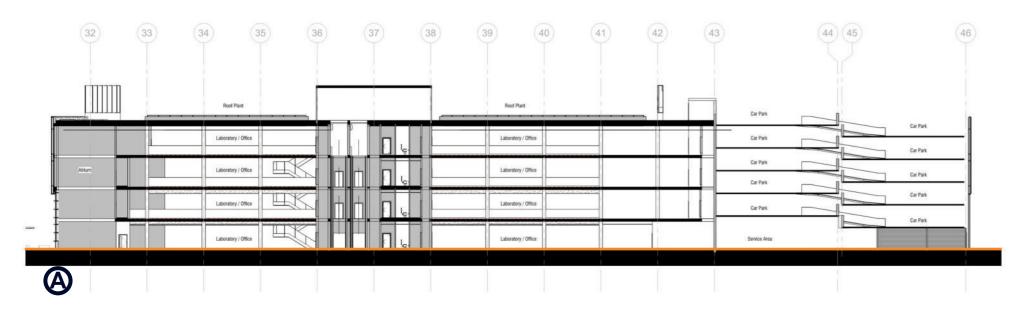


APPROVED BUILDING 3 SECTION AA

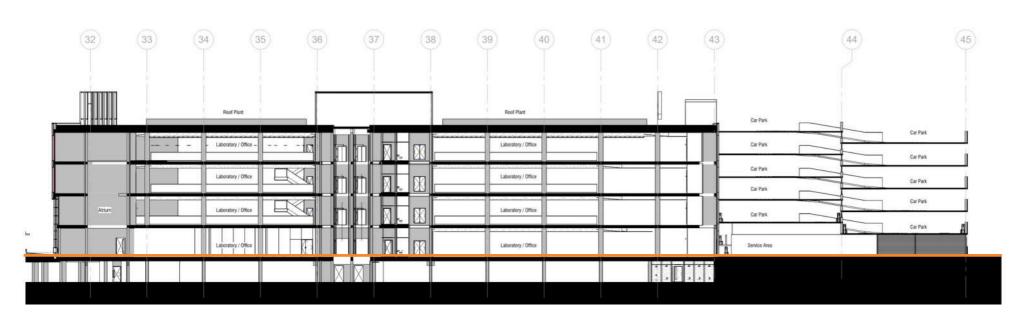


PROPOSED BUILDING 3 SECTION AA

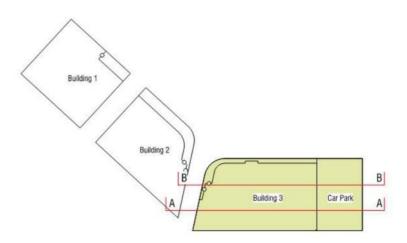


BUILDING 3 APPROVED SECTIONS VS PROPOSED SECTIONS

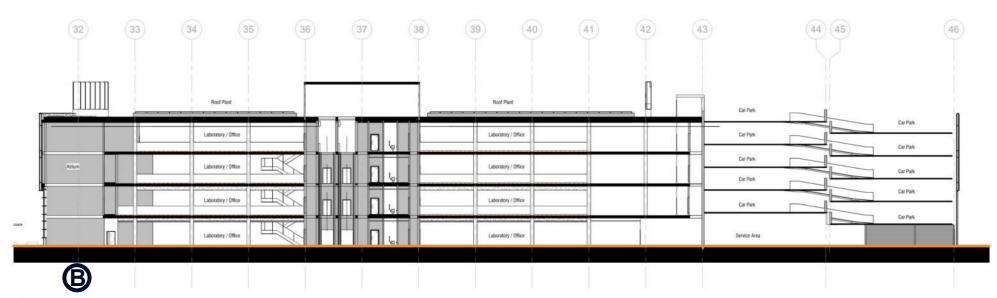


APPROVED BUILDING 3 SECTION BB

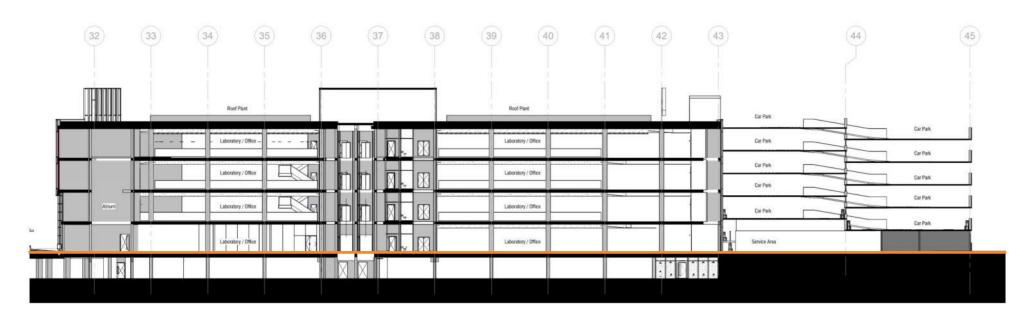

PROPOSED BUILDING 3 SECTION BB

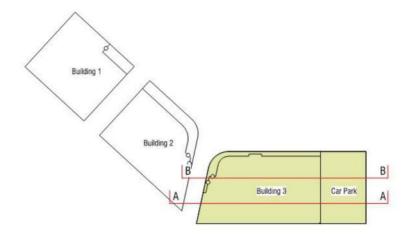


BUILDING 3 APPROVED SECTIONS VS PROPOSED SECTIONS

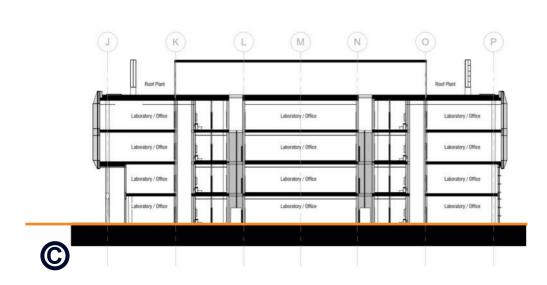


APPROVED BUILDING 3 SECTION CC



PROPOSED BUILDING 3 SECTION CC

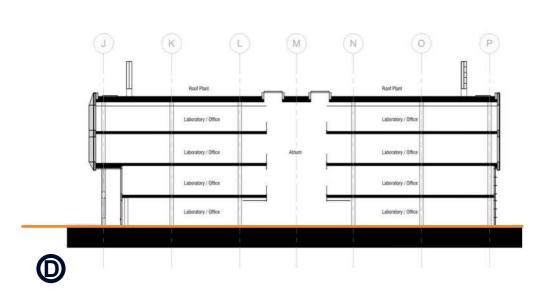

APPROVED BUILDING 3 SECTION DD

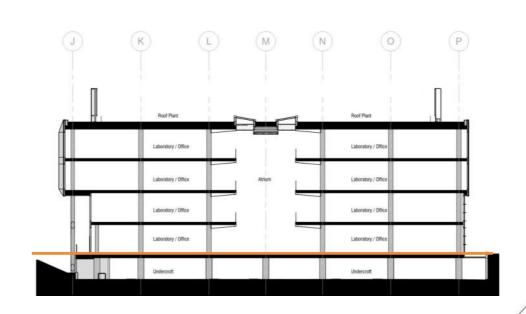

PROPOSED BUILDING 3 SECTION DD

Building 2

Building 3

Car Park





scottbrownrigg.com