




EXISTING REAR (3) ELEVATION
(AS-APPROVED PLANNING APPLICATION 20/01018/APP)
Scale 1:50

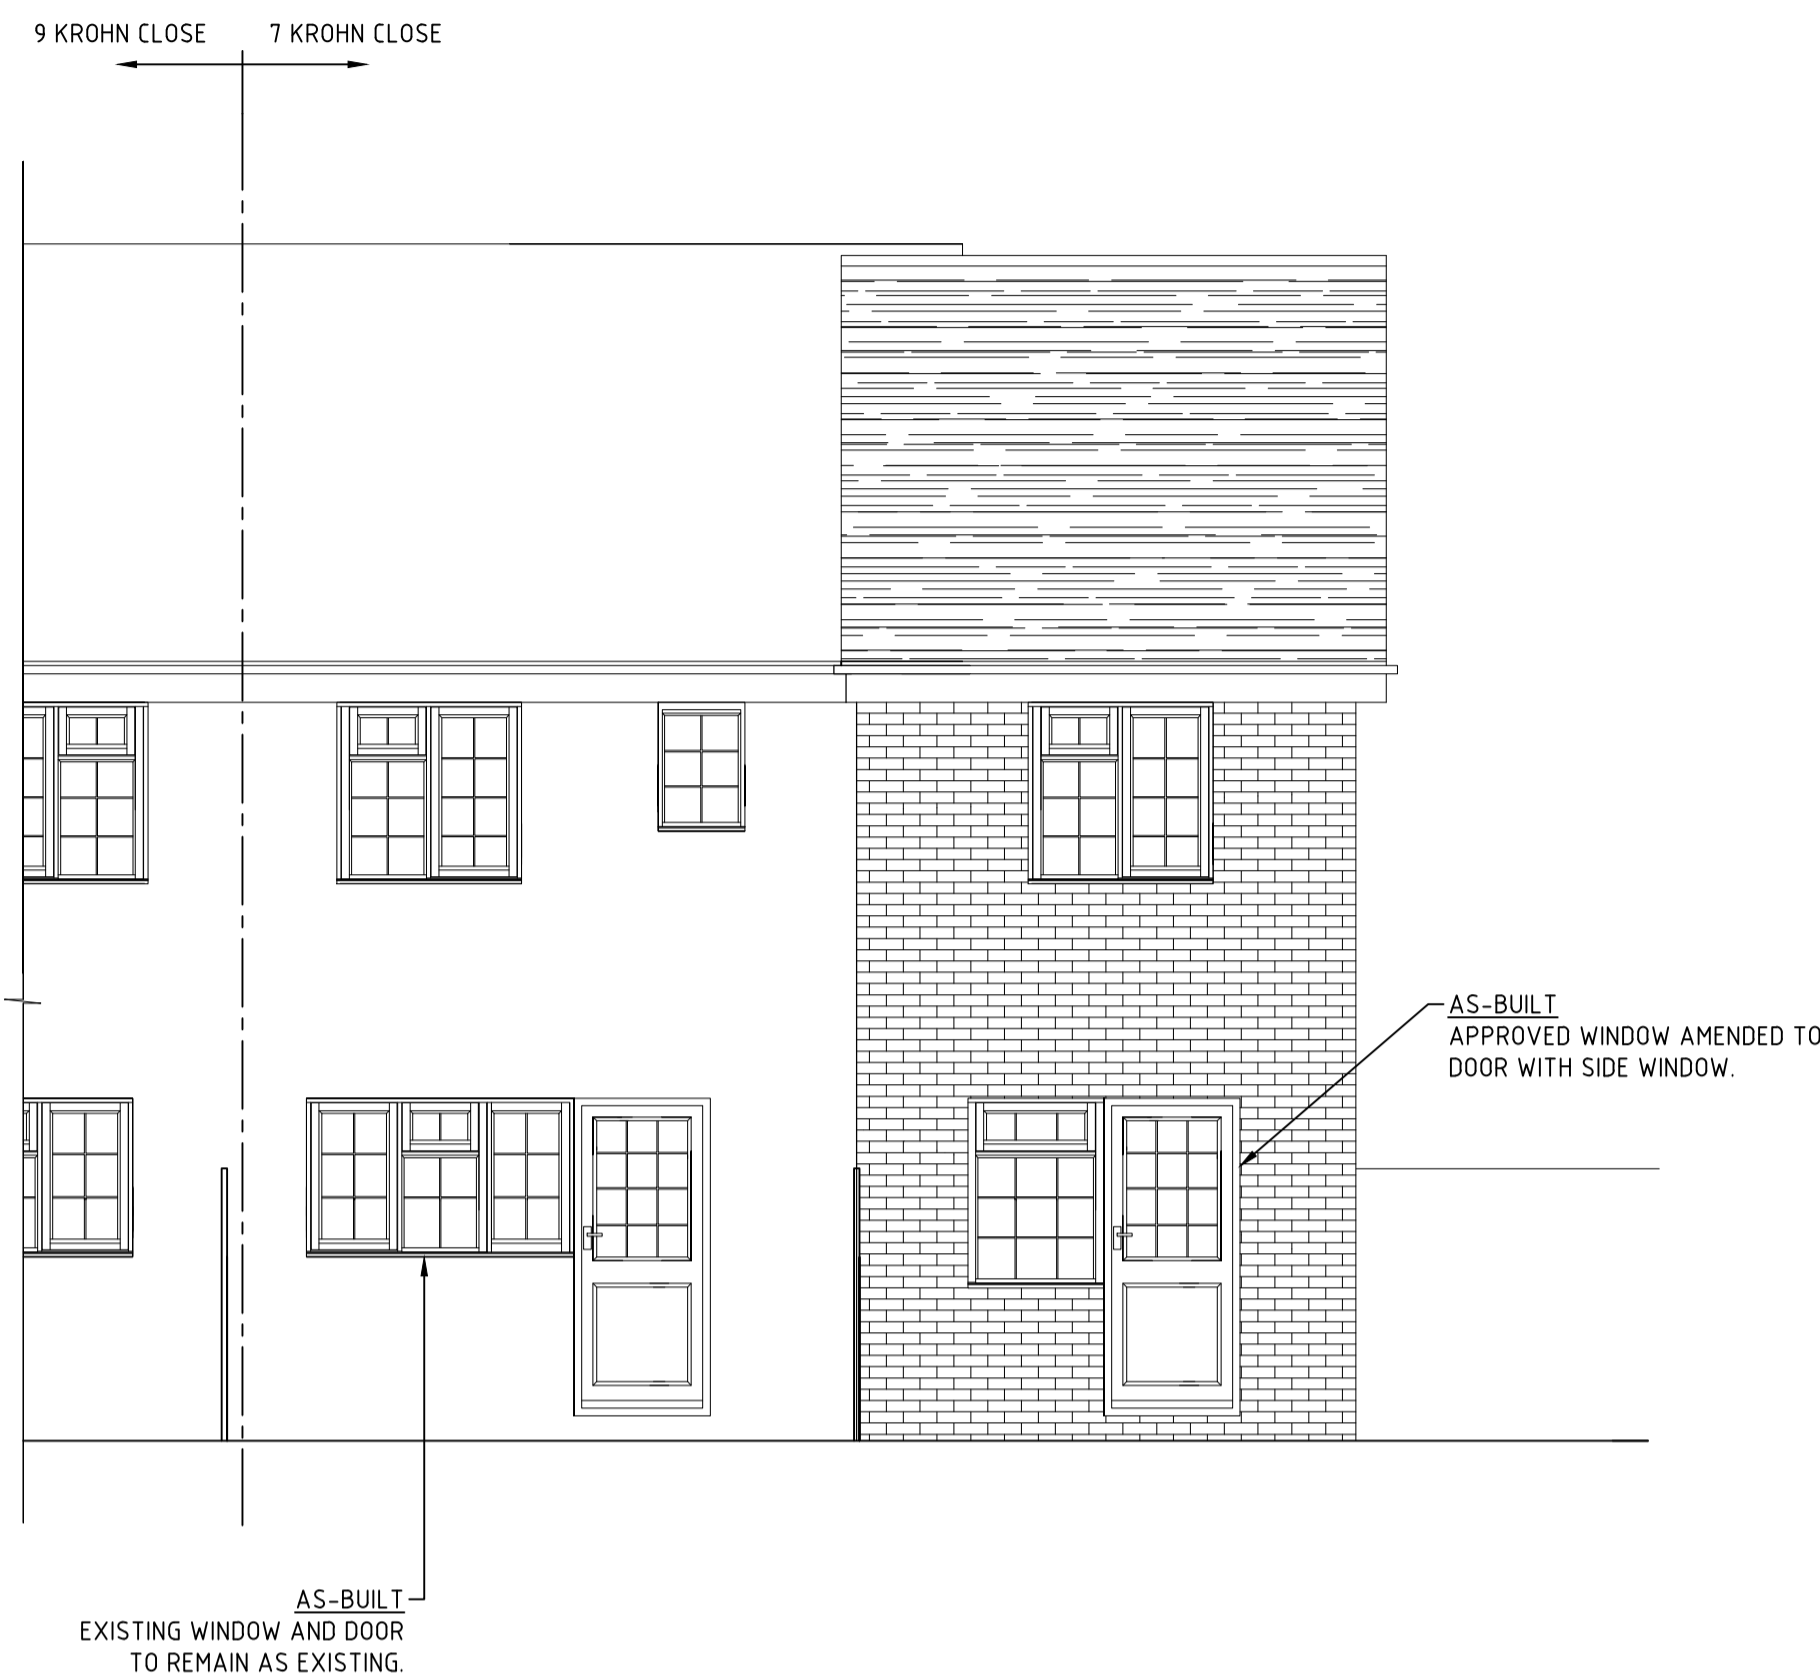


PROPOSED REAR (3) ELEVATION (AS-BUILT)
Scale 1:50

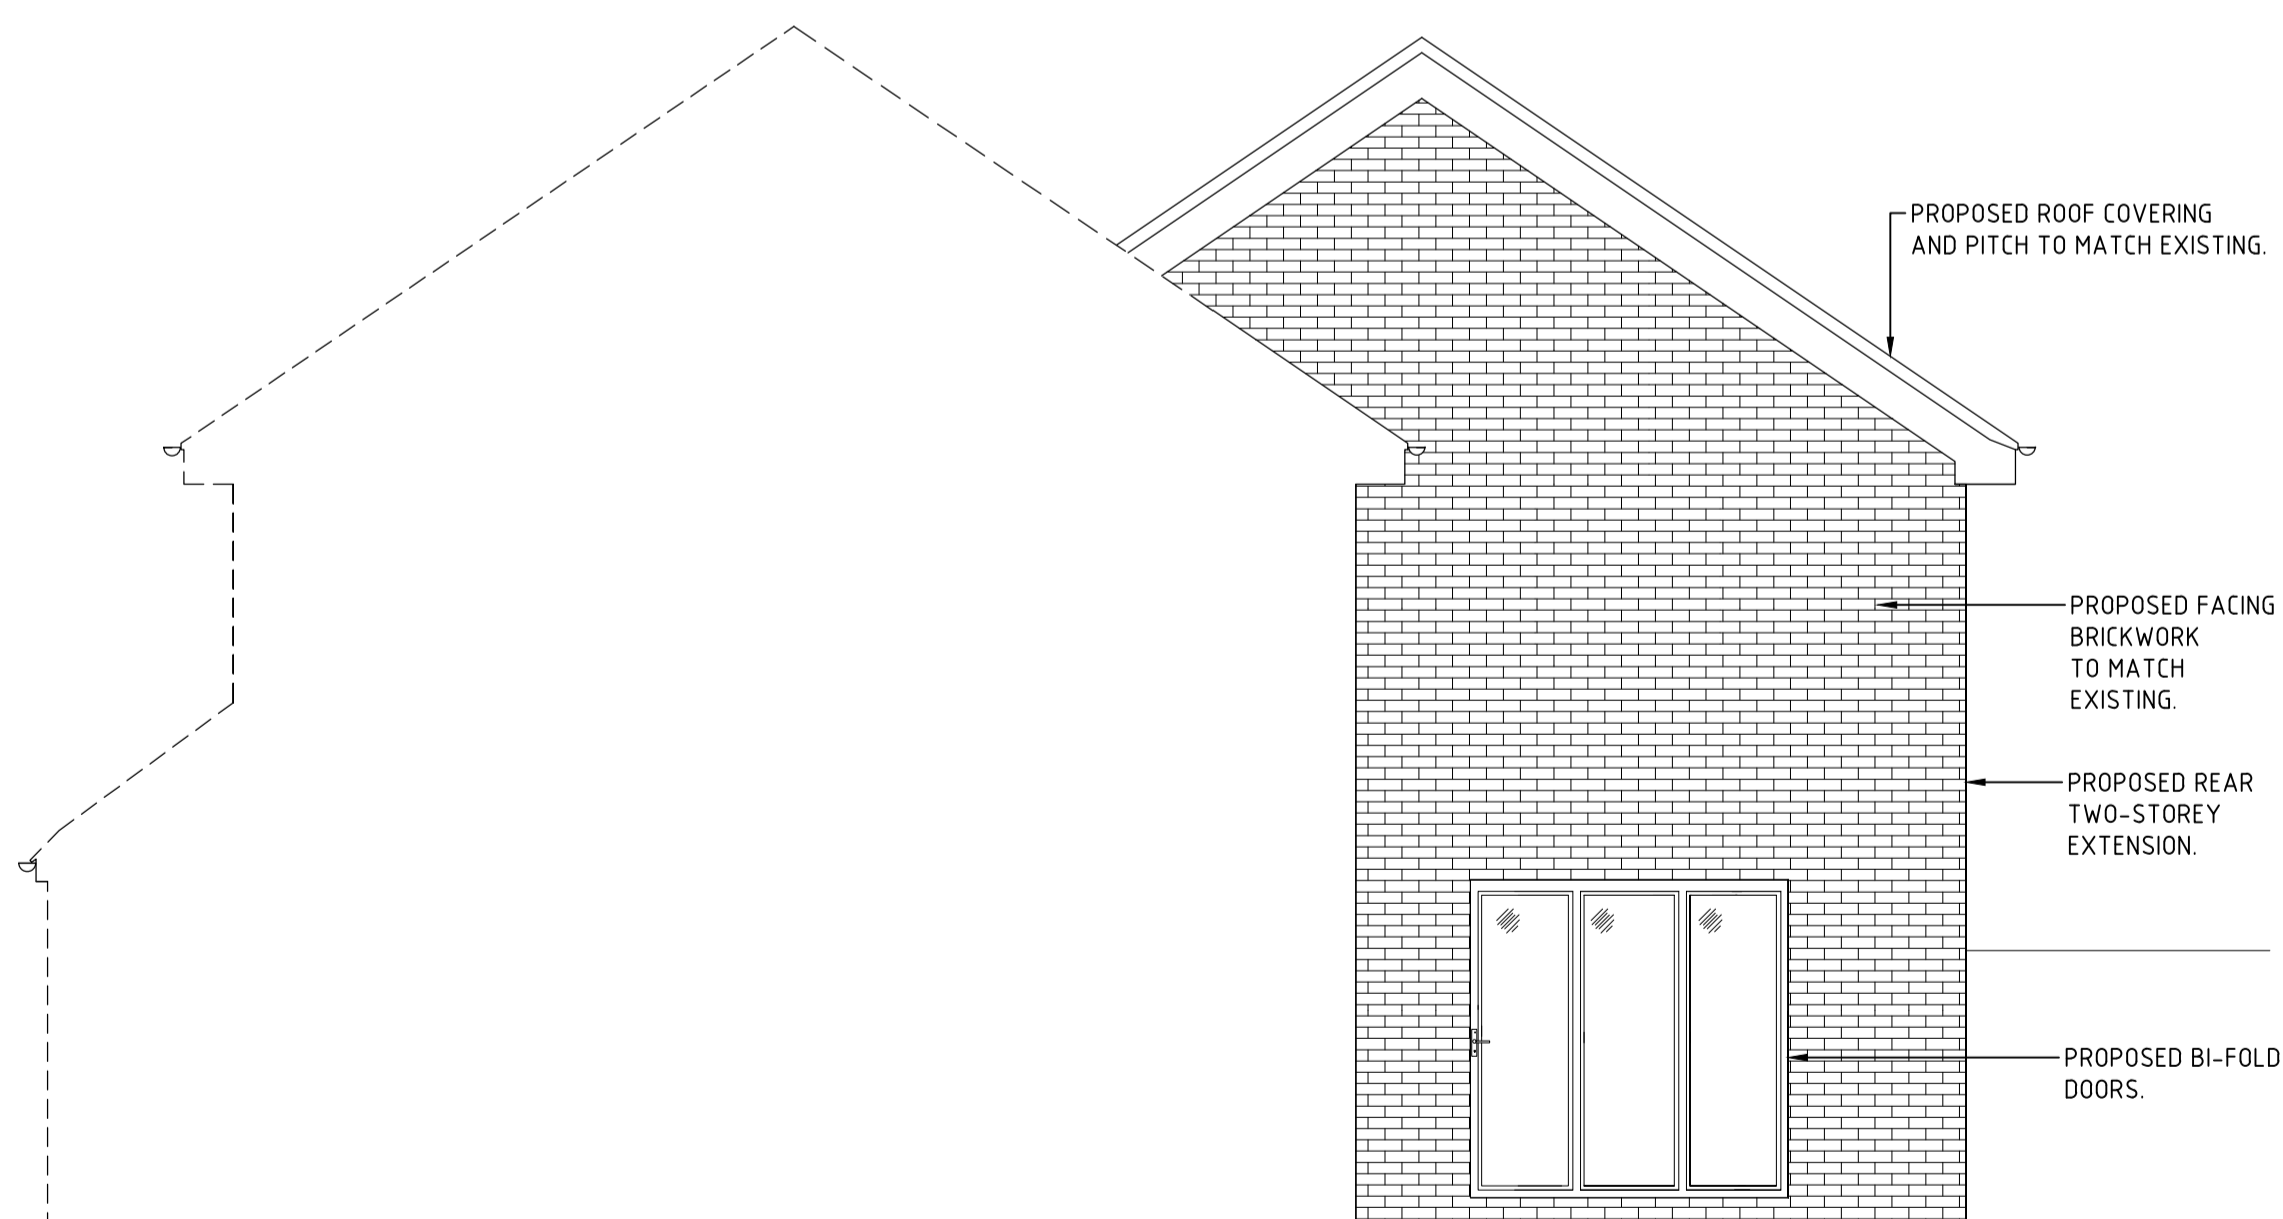

EXISTING SIDE (4) ELEVATION
(AS-APPROVED PLANNING APPLICATION 20/01018/APP)
Scale 1:50

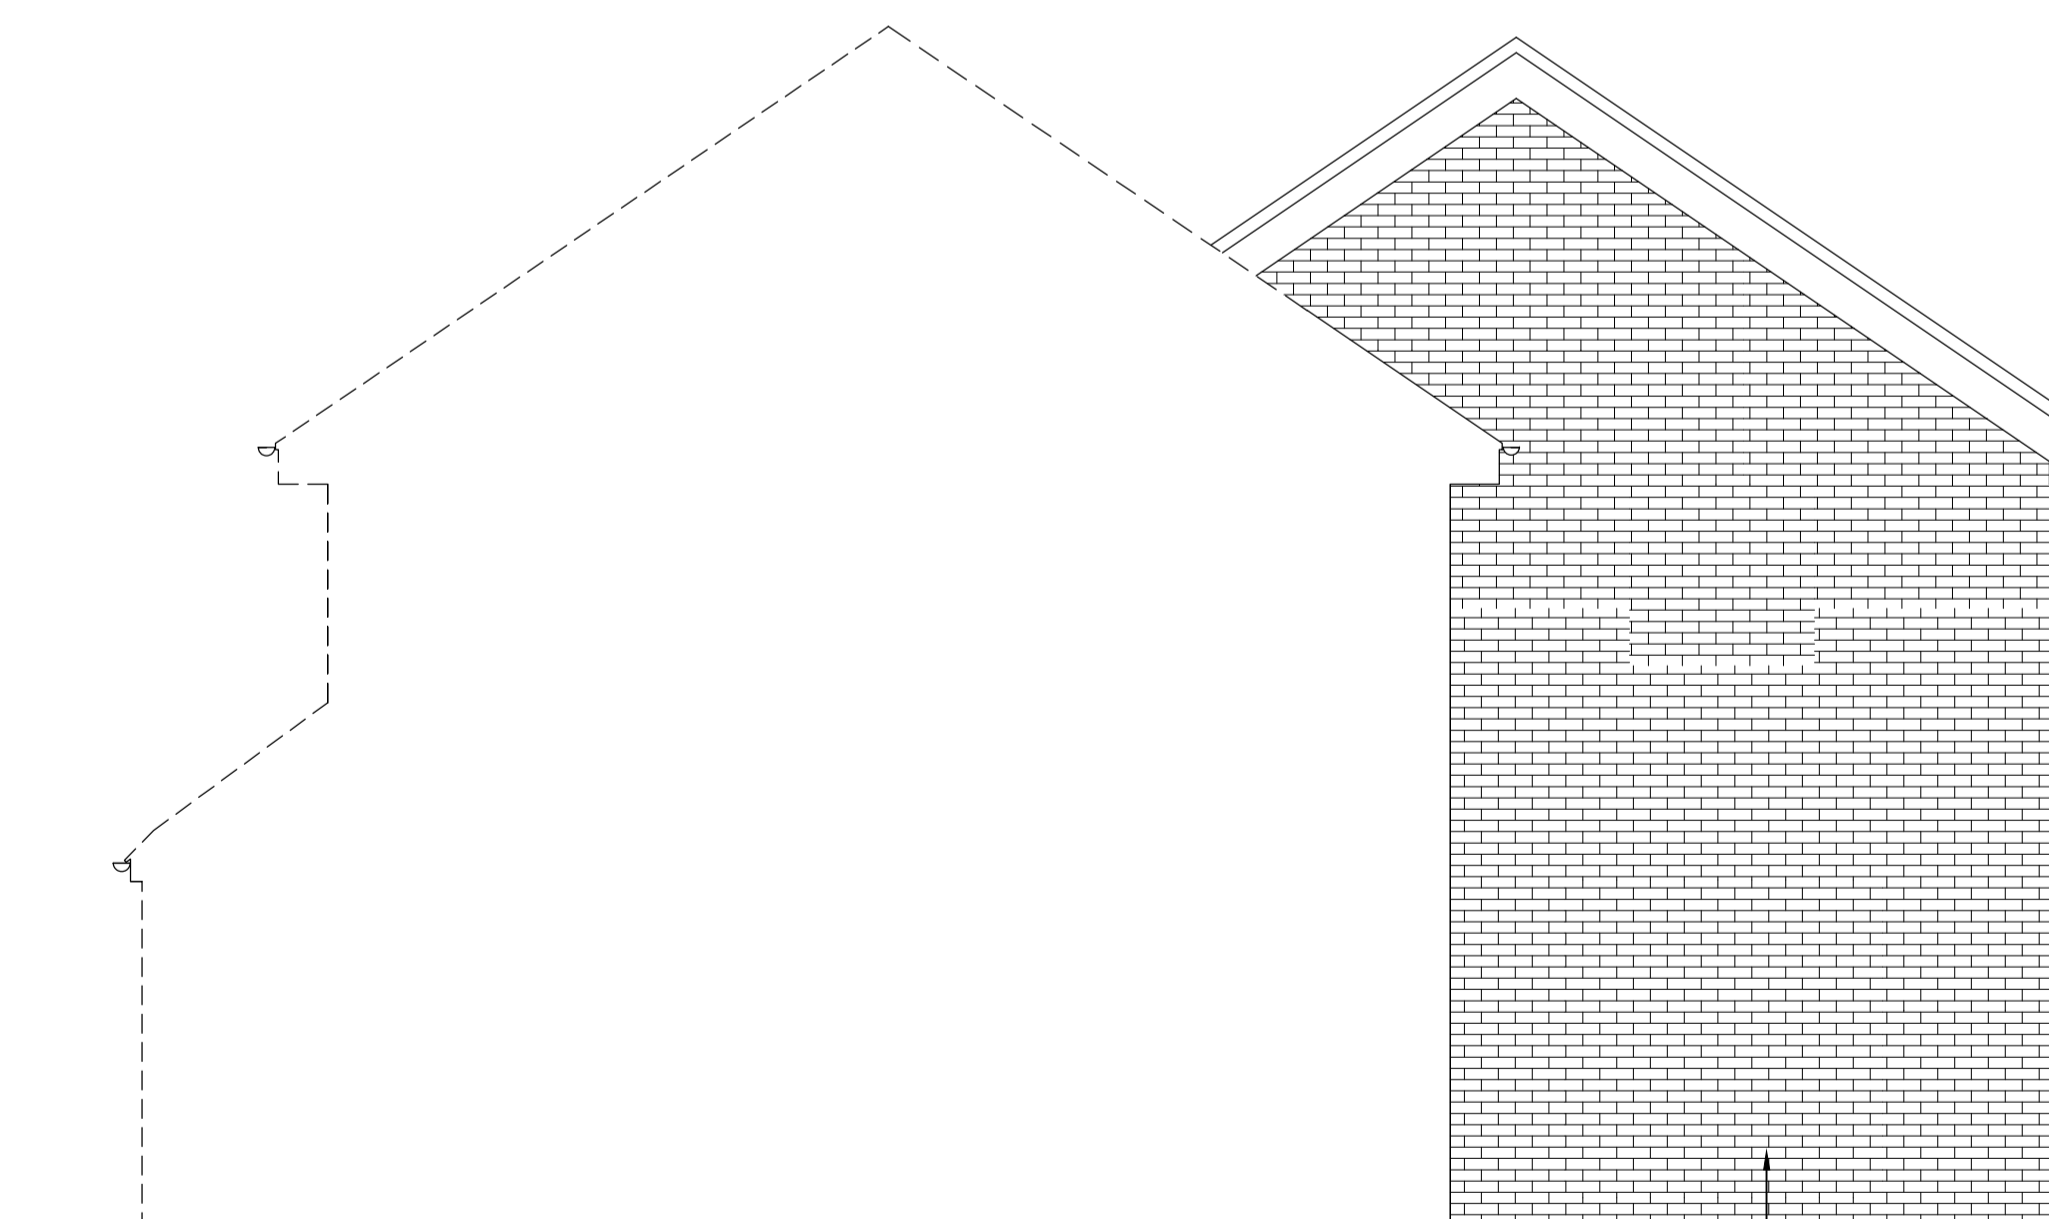

PROPOSED SIDE (4) ELEVATION (AS-BUILT)
Scale 1:50

REV.	DATE	DRAWN	CHECKED	DESCRIPTION
DRAWING STATUS				
FOR APPROVAL				
 AB Design Solutions Ltd Consulting Structural & Building Engineers The Estate Office, Upper Aynho Grounds, Aynho, Oxon, OX17 3AY T: 01865 717711 or 01280 880761 E: info@abdesignsolutions.co.uk W: www.abdesignsolutions.co.uk Company No. 6056872				
CLIENT				
MR S. TERKELSEN				
IN ASSOCIATION WITH:				
CONTRACT / PROJECT				
7 KROHN CLOSE, BUCKINGHAM				
TITLE				
EXISTING (AS APPROVED PLANNING APPLICATION) AND PROPOSED (AS-BUILT) REAR ELEVATIONS (3) AND SIDE ELEVATIONS (4)				
DRAWN: MFB		DATE: 08/01/2024		
CHECKED: MRA		SCALE: As shown @ A1		
DRAWING REF:				REV
4106-ABDS-XX-XX-EL-A-0005				-
<small>© This drawing is the property of AB DESIGN SOLUTIONS LTD and is issued in confidence. It must not be copied or disclosed to third parties without written permission.</small>				