


EXISTING FIRST FLOOR LAYOUT
(AS-APPROVED PLANNING APPLICATION 20/01018/APP)
Scale 1:50

PROPOSED LAYOUT SHOWING AS-BUILT CHANGES TO APPROVED PLANNING DRAWINGS 20/01018/APP. REQUIRING RETROSPECTIVE PLANNING APPROVAL.

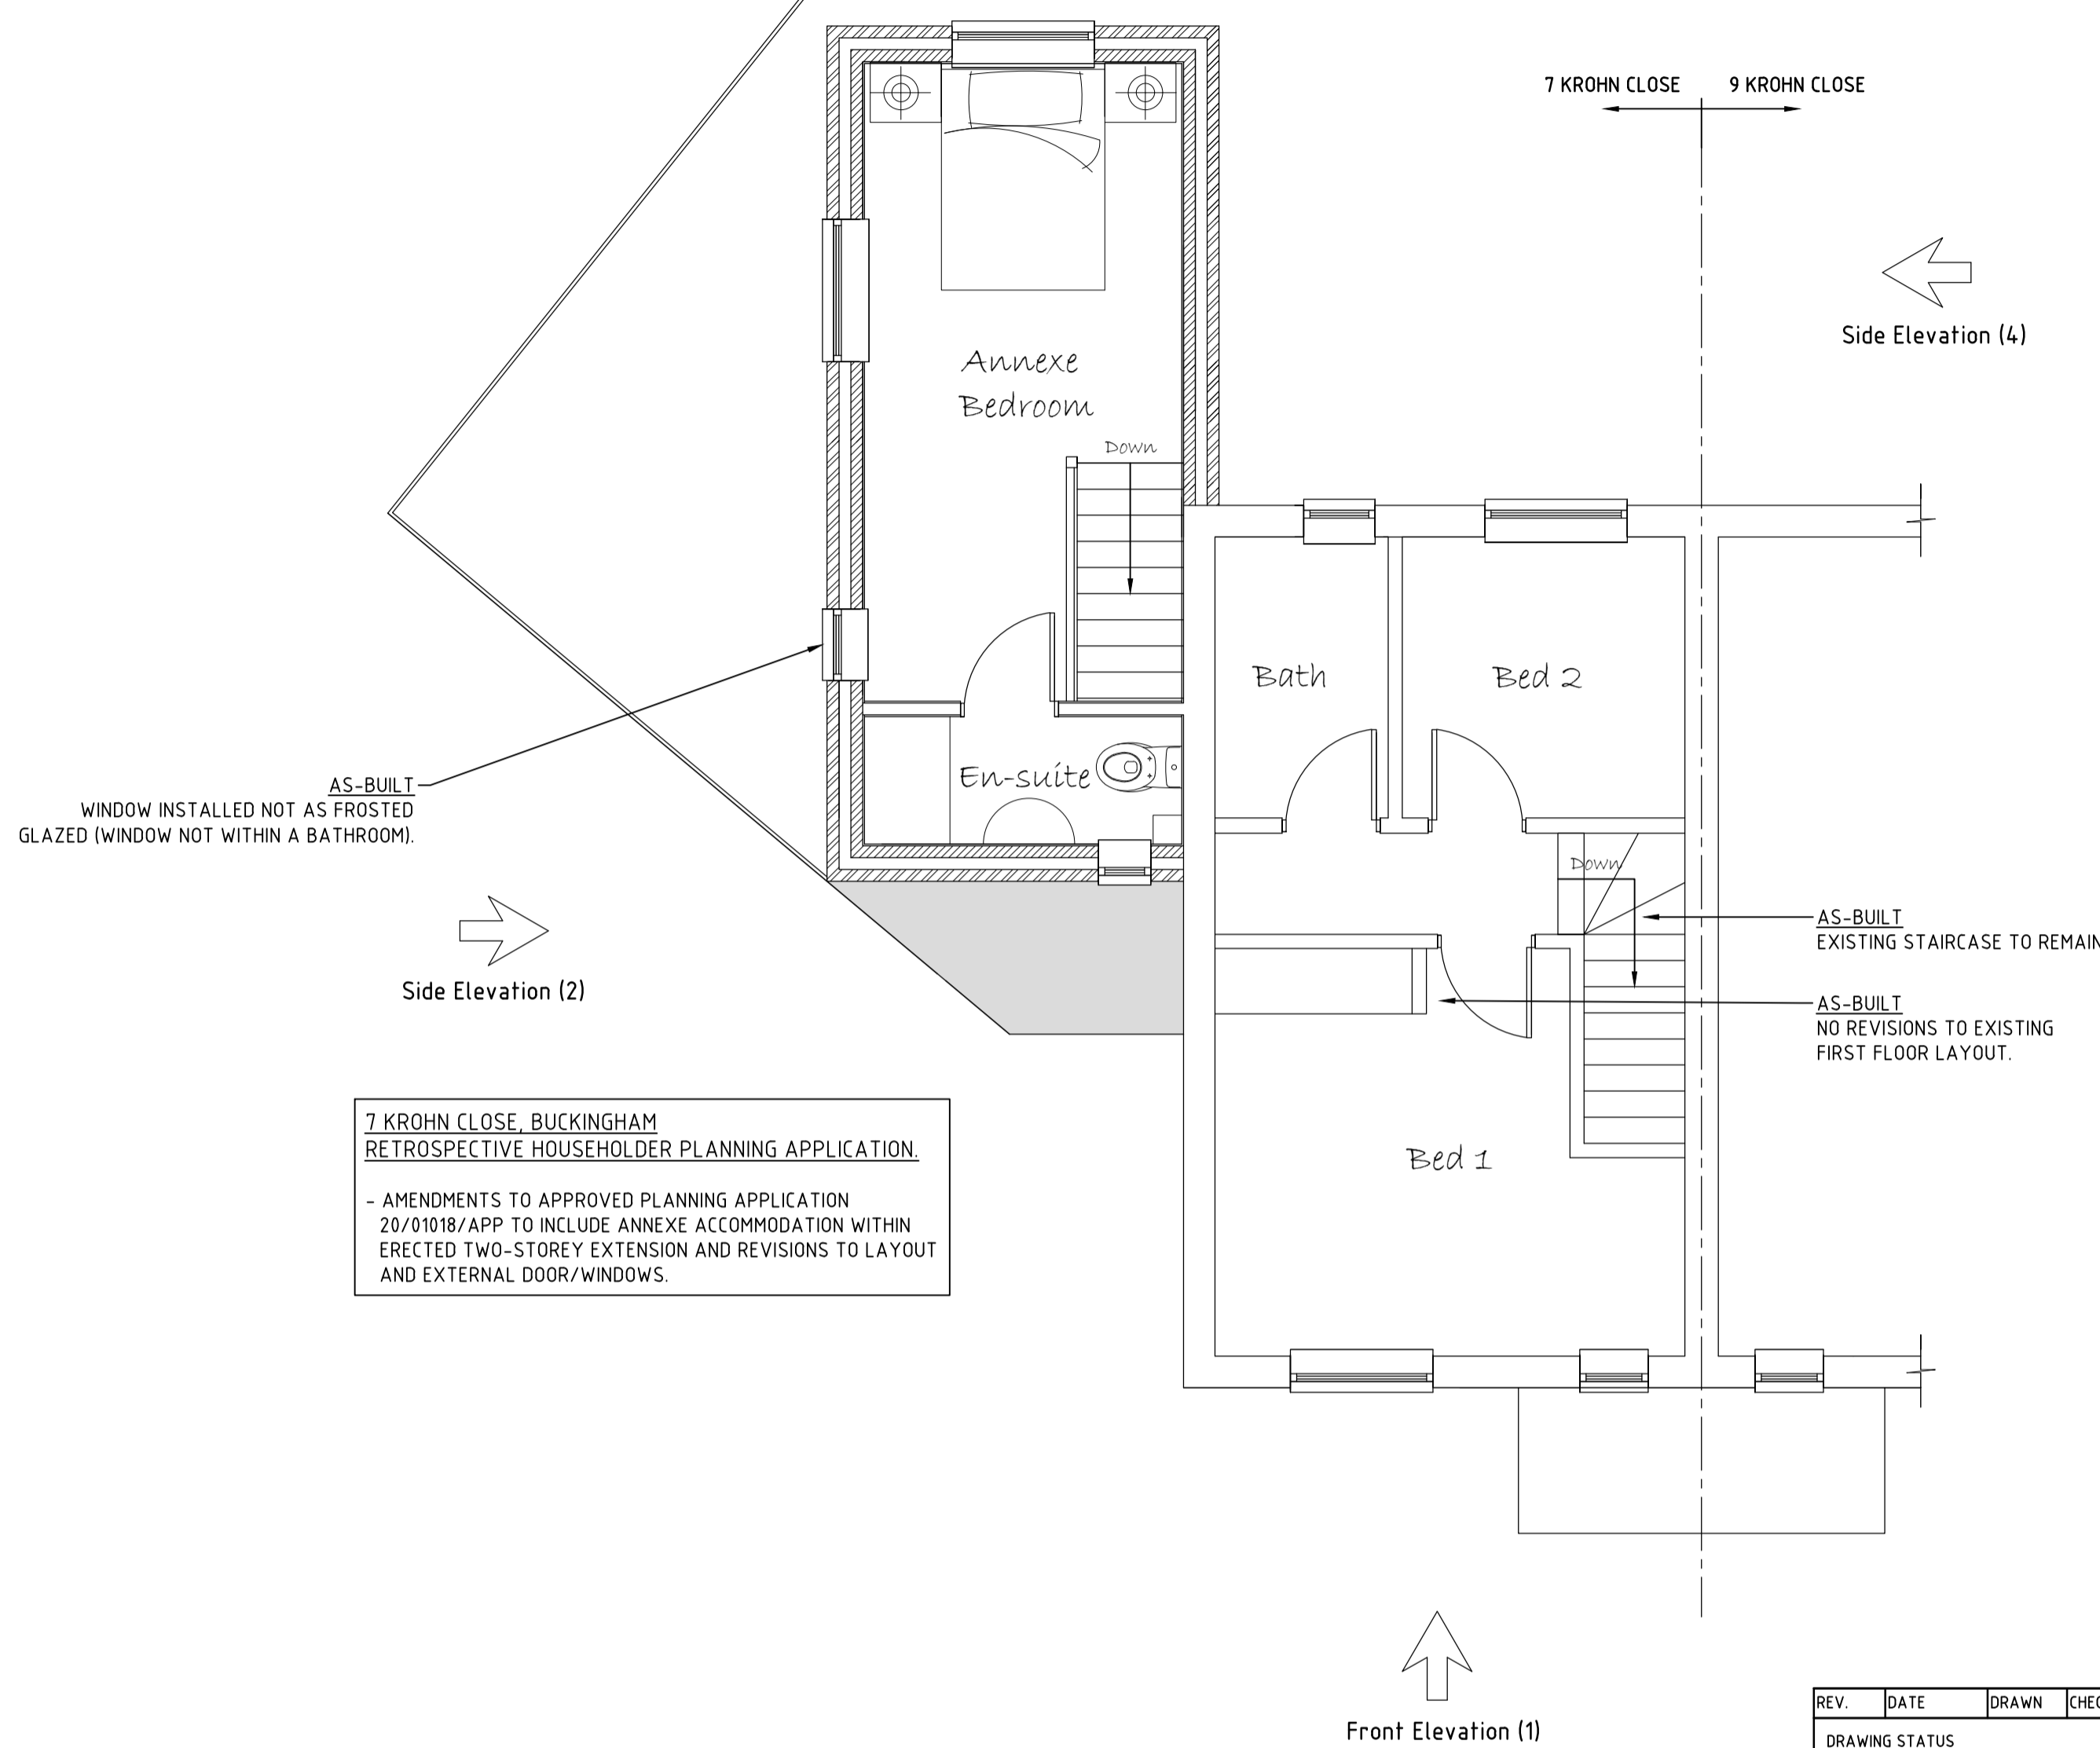

7 KROHN CLOSE, BUCKINGHAM
RETROSPECTIVE HOUSEHOLDER PLANNING APPLICATION
- AMENDMENTS TO APPROVED PLANNING APPLICATION 20/01018/APP TO INCLUDE ANNEXE ACCOMMODATION WITHIN ERECTED TWO-STOREY EXTENSION AND REVISIONS TO LAYOUT AND EXTERNAL DOOR/WINDOWS.

PROPOSED FIRST FLOOR LAYOUT (AS-BUILT)
Scale 1:50

REV.	DATE	DRAWN	CHECKED	DESCRIPTION
DRAWING STATUS				
FOR APPROVAL				
AB Design Solutions Ltd Consulting Structural & Building Engineers The Estate Office, Upper Aynho Grounds, Aynho, Oxon, OX17 3AY T: 01865 717711 or 01280 880761 E: info@abdesignsolutions.co.uk W: www.abdesignsolutions.co.uk Company No. 6056872				
CLIENT MR S. TERKELSEN				
IN ASSOCIATION WITH:				
CONTRACT / PROJECT 7 KROHN CLOSE, BUCKINGHAM				
TITLE EXISTING FIRST FLOOR LAYOUT (AS APPROVED PLANNING APPLICATION) AND PROPOSED FIRST FLOOR LAYOUT (AS-BUILT)				
DRAWN:	MFB	DATE:	08/01/2024	
CHECKED:	MRA	SCALE:	As shown @ A1	
DRAWING REF:	4106-ABDS-XX-XX-01-A-0003			REV -