


FRONT ELEVATION
SCALE 1:100




REAR ELEVATION

AS APPROVED ELEVATIONS

Ref: 20/00536/FUL

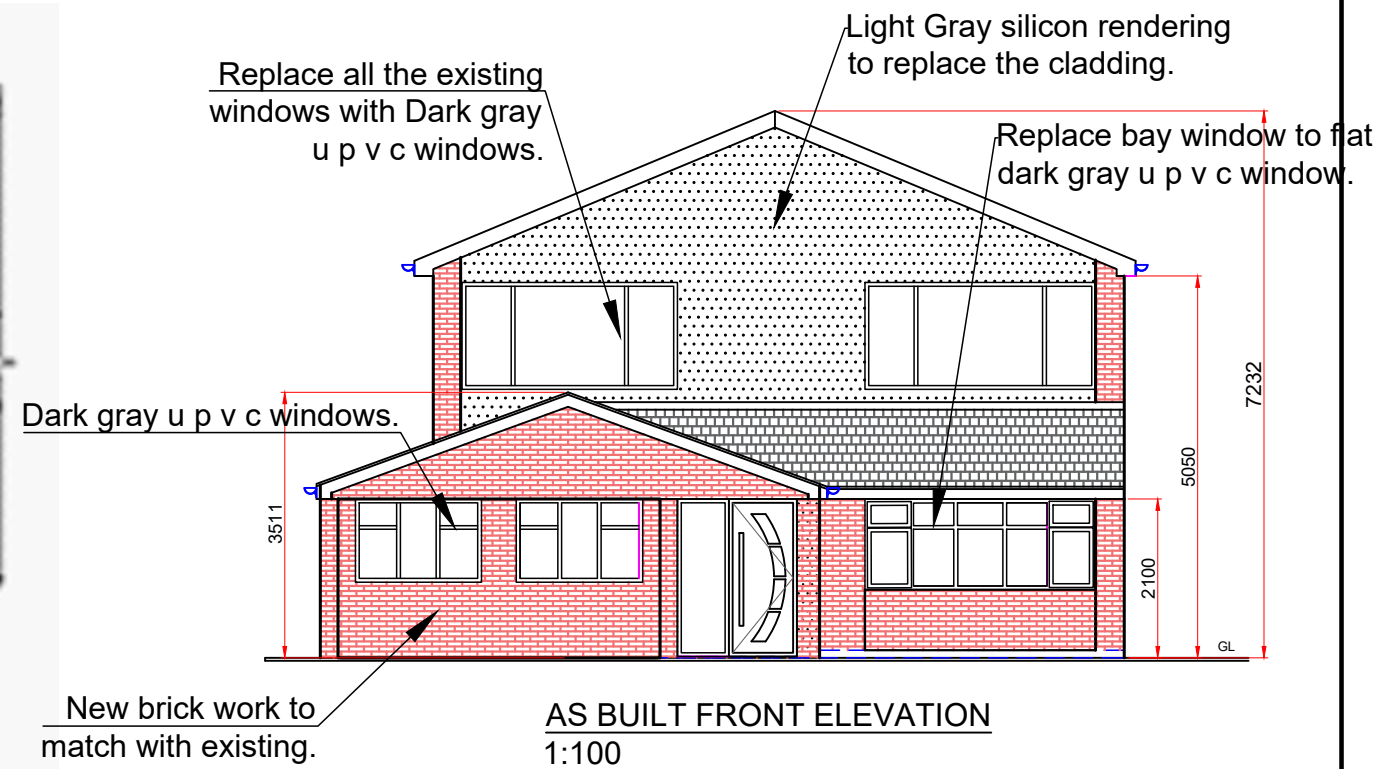


AS BUILT FRONT ELEVATION
1:100

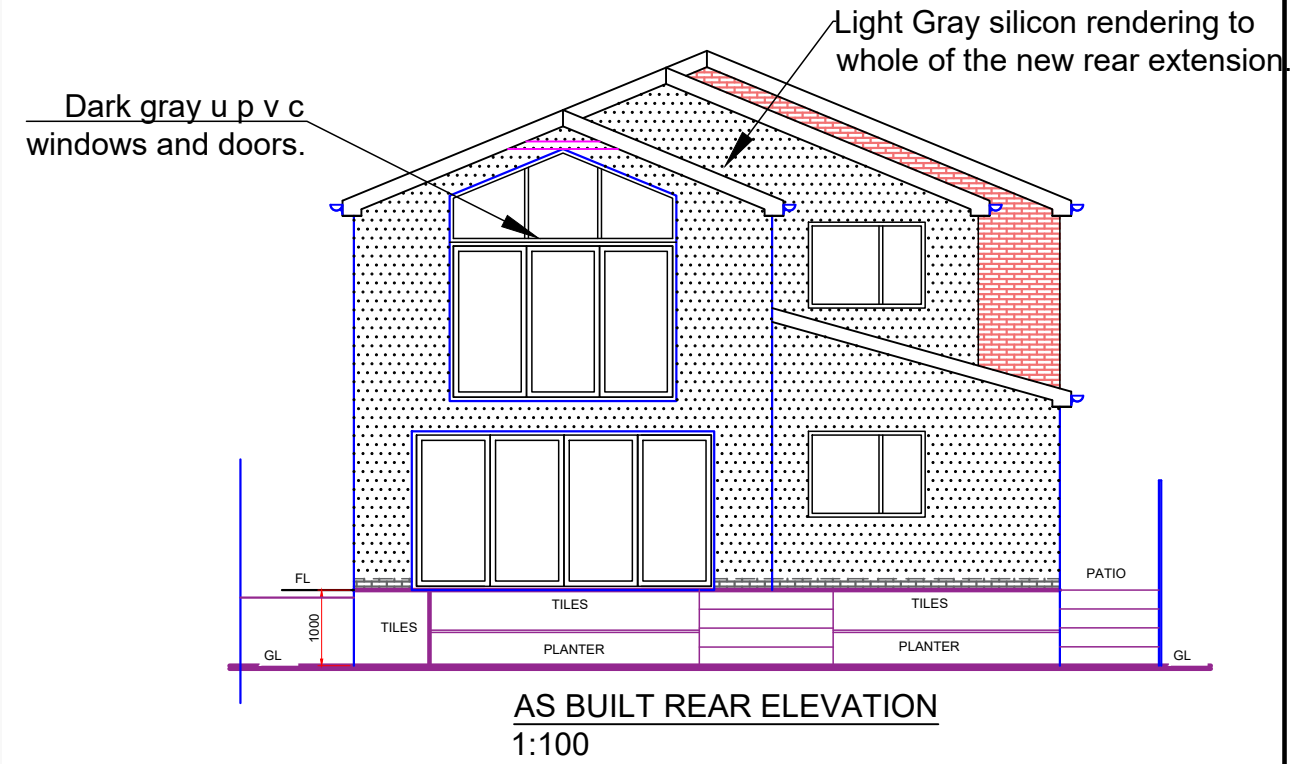

AS BUILT REAR ELEVATION
1:100

AS BUILT ELEVATIONS

FOR COMMENT
 FOR PLANNING PERMISSION
 FOR BUILDING REGULATIONS



Malik Enterprises
 Architectural Service
 30 Carlton Drive, Wigston,
 Leicestershire UK LE18 1DF
 M: 07808 266330
 E: tanvir@malikenterprises.co.uk

PROJECT: Variation of Condition.	
LOCATION: 12 Eden Road. Leicester. LE2 4JP	
CLIENT: Mr Jan Muhammad	
TITLE: Front and Rear Elevations	
DATE: Nov. 2023	SHEET: A3
DRAWING No: ME12123-04	SCALE: 1:100