


AS APPROVED LH SIDE ELEVATION
1:100 Ref: 20/00536/FUL



AS BUILT LH SIDE ELEVATION
1:100

FOR COMMENT FOR PLANNING PERMISSION FOR BUILDING REGULATIONS

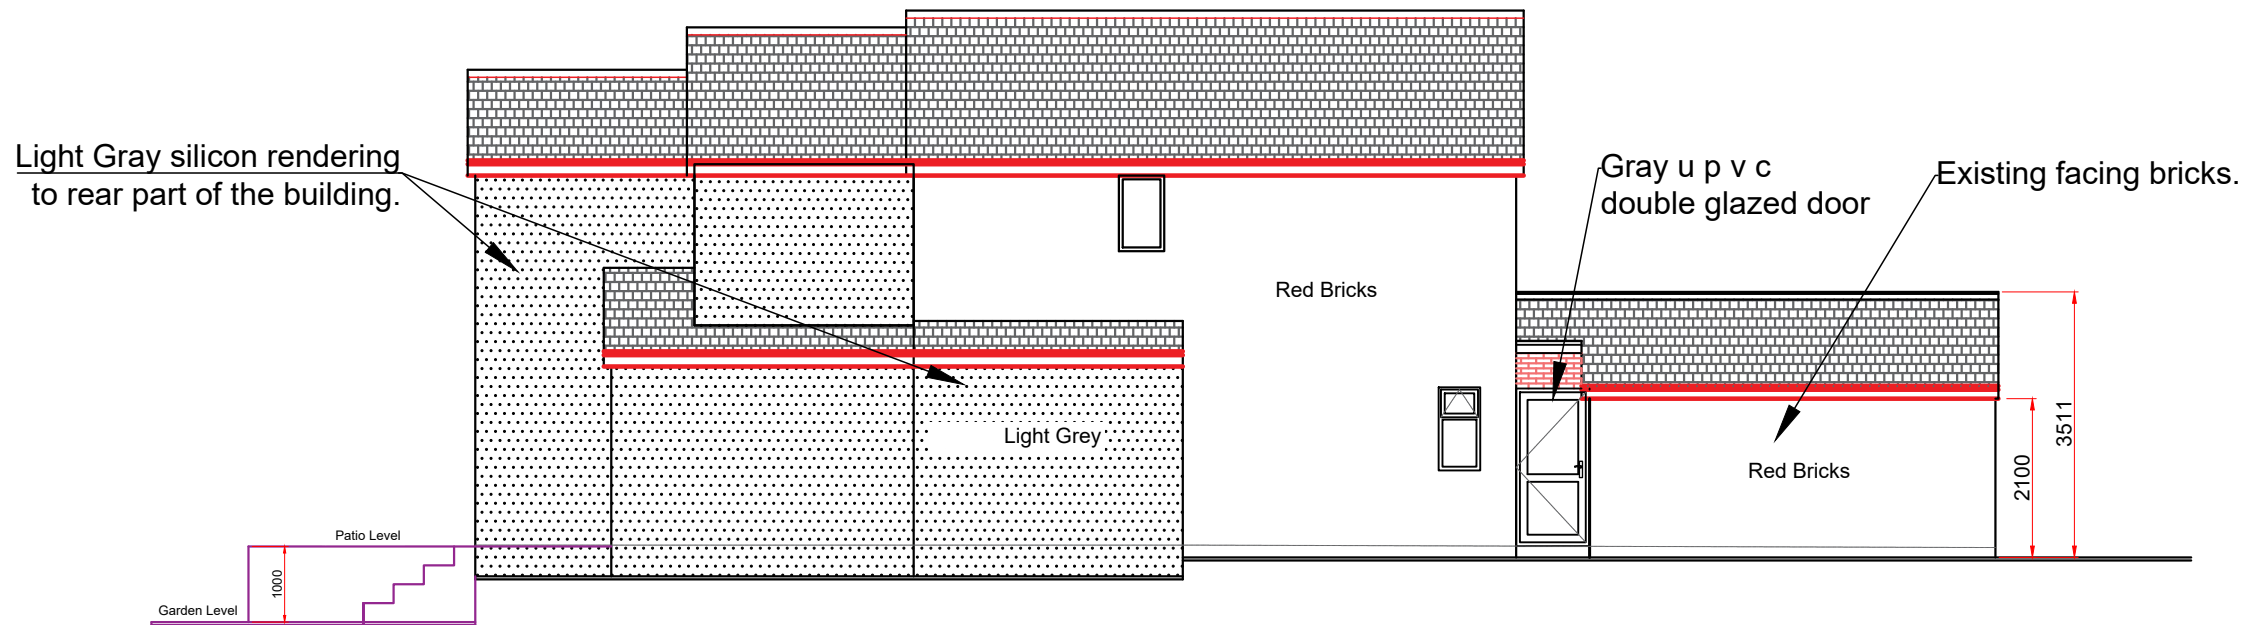

Malik Enterprises
Architectural Service
30 Carlton Drive, Wigston,
Leicestershire UK LE18 1DF
M: 07808 266330
E: tanvir@malikenterprises.co.uk

PROJECT: Variation of Condition.	
LOCATION: 12 Eden Road. Leicester. LE2 4JP	
CLIENT: Mr Jan Muhammad	
TITLE: LH Side Elevations	
DATE: Nov. 2023	SHEET: A3
DRAWING No: ME12123-06	SCALE: 1:100