




View 1 Looking south-east from main entrance area to temporary kitchen



View 2 Looking south between marquee & Master's Lodgings

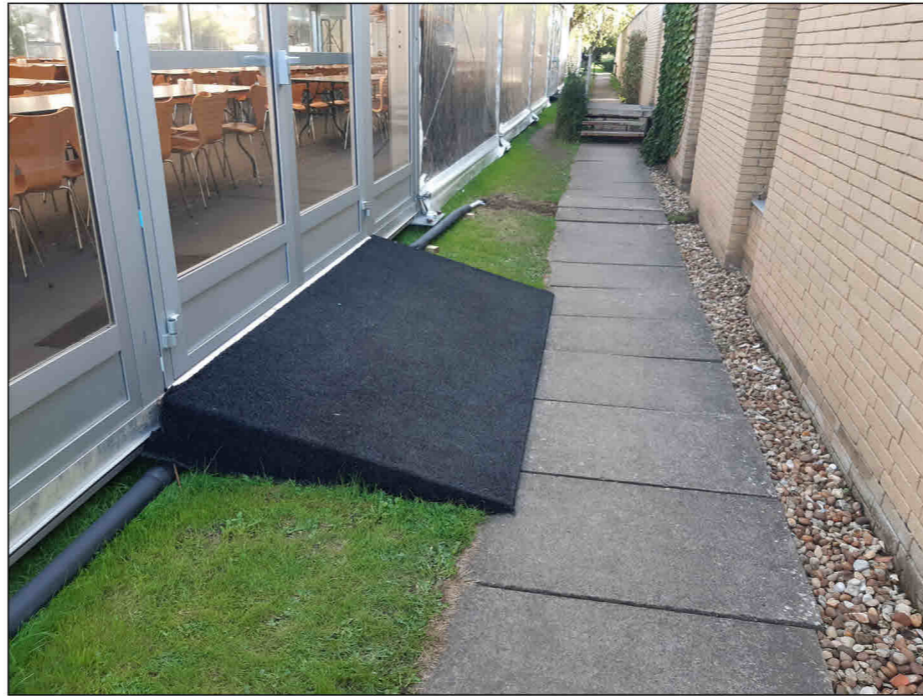

View 3 Looking north between marquee & Master's Lodgings garden wall




View 4 Looking at fuel store



View 5 Looking north-east at south end of marquee



View 6 Looking north from bridge to staircase 14

PROJECT St. Catherine's College Reinforced Autoclaved Aerated Concrete Roofs Urgent Mitigation Work		Pendery Architecture & Heritage Ltd 	
CLIENT St Catherine's College		<small>ALL DIMENSIONS IN MILLIMETRES UNLESS STATED OTHERWISE. DO NOT SCALE EXCEPT FOR PLANNING PURPOSES. USE GIVEN DIMENSIONS ONLY.</small> <small>LATEST REVISION:</small>	
TITLE Views 1 to 6 As Installed		SCALE @ A3 <small>© Pendery Architecture & Heritage Ltd</small>	DATE Oct'23 DWG NO. 2315-13 REV