



Side Elevation  
Scale 1:100 @A1

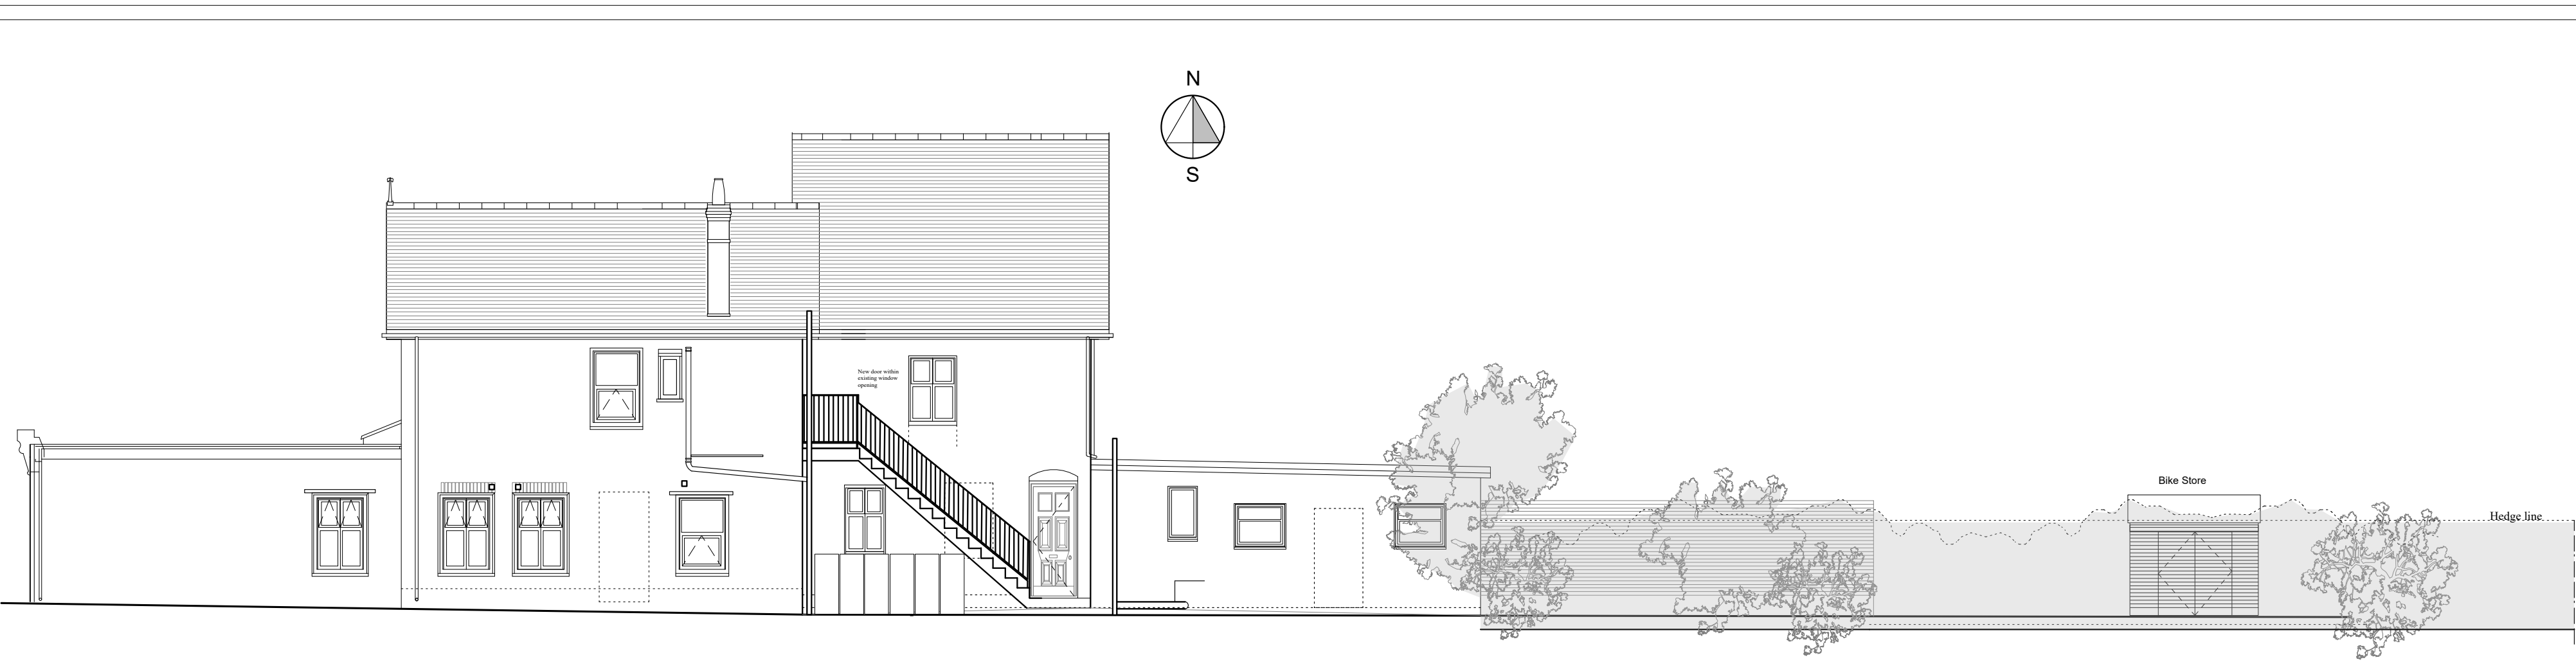


Bin Store  
Scale 1:100 @A1

Parking  
Scale 1:100 @A1


Cycle Store  
Scale 1:100 @A1

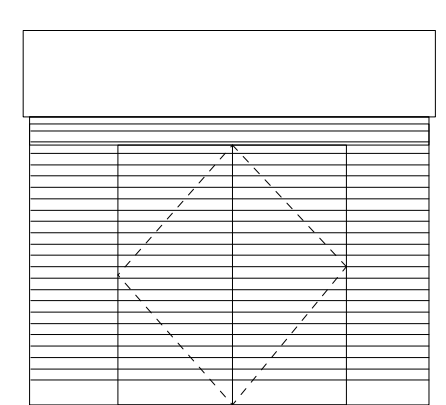

Cycle Store  
Scale 1:50 @A1

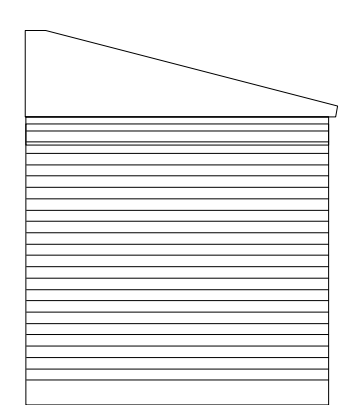

Cycle Store  
Scale 1:50 @A1

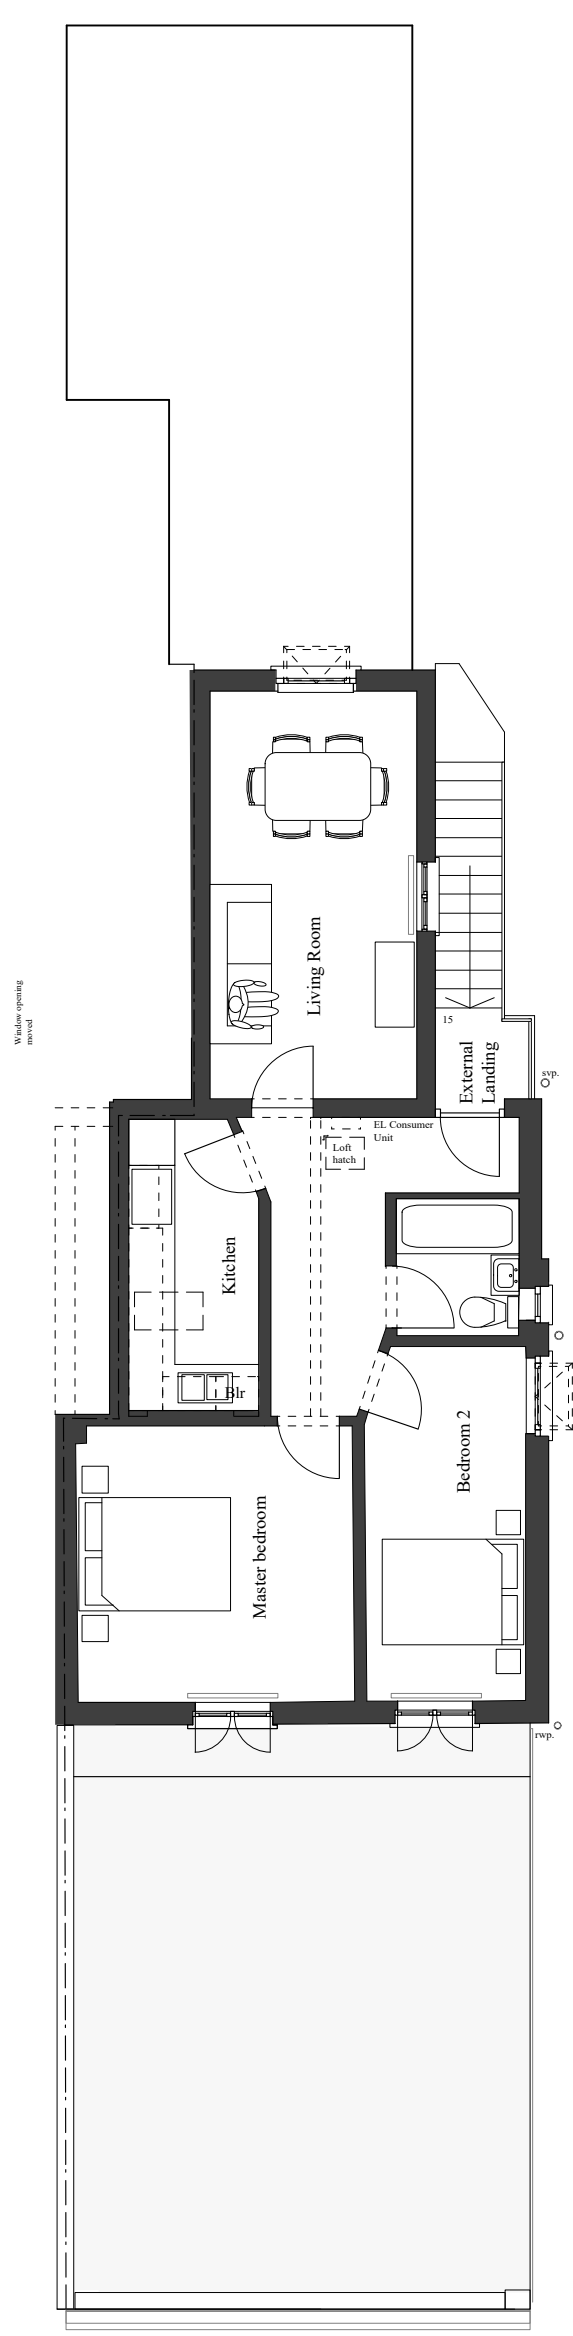

As Built First Floor Plan  
Scale 1:100@A1



Rear Elevation  
Scale 1:100 @A1



Proposed Front Elevation  
Scale 1:100 @A1



**Robert Young Associates (Hungerford) Ltd**  
 Architectural Consultants Chartered Townplanners  
 Kennet House, 19 High Street, Hungerford, Berkshire RG17 0NL  
 Tel: 01488 208 845 Mob: 07977407288  
 bobyoung@ryassociatesuk.co.uk | www.robertyoungassociates.com

job number: RY 845  
 drawing number: CR2 012 Plan and Elevations  
 drawing reference: Garden and Cycle Store  
 status: Planning application  
 revision: 18/12/2023  
 date: 18/12/2023  
 scale: 1:100 @ A1  
 drawn: RY  
 checked: RY

Use figured dimensions only. All levels and dimensions to be checked on site. This drawing is to be read in conjunction with all other relevant drawings and specifications. © Robert Young Associates (Hungerford) Ltd. This drawing and design remains the copyright and intellectual Property of Robert Young Associates (Hungerford) Ltd and shall not be copied in any format without approval.