

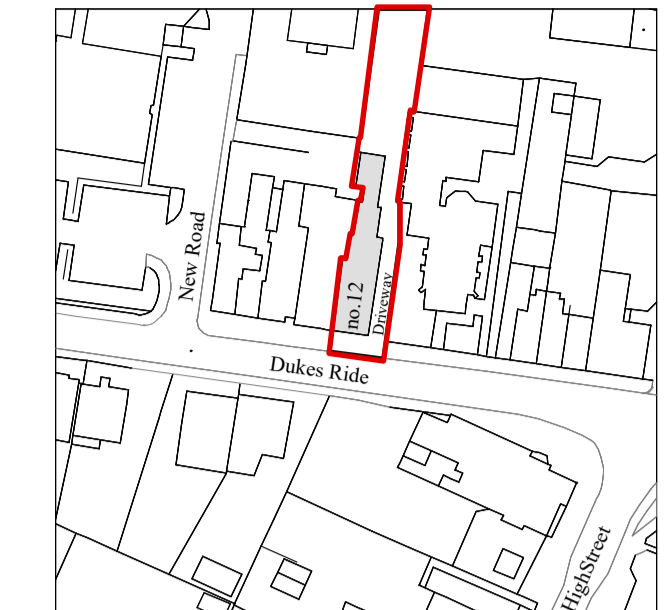


# As Built Survey Plans


Survey Plan  
Note : Works had not been completed at time of survey

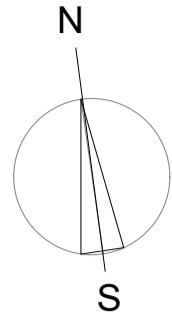


Location Plan  
Scale 1:1250 @A1

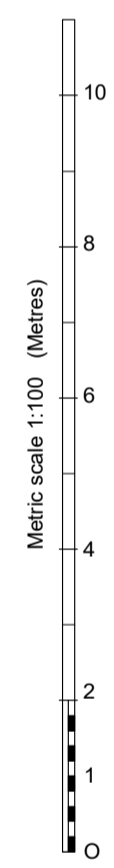


Ground Floor Survey Plan  
Scale 1:100 @A1

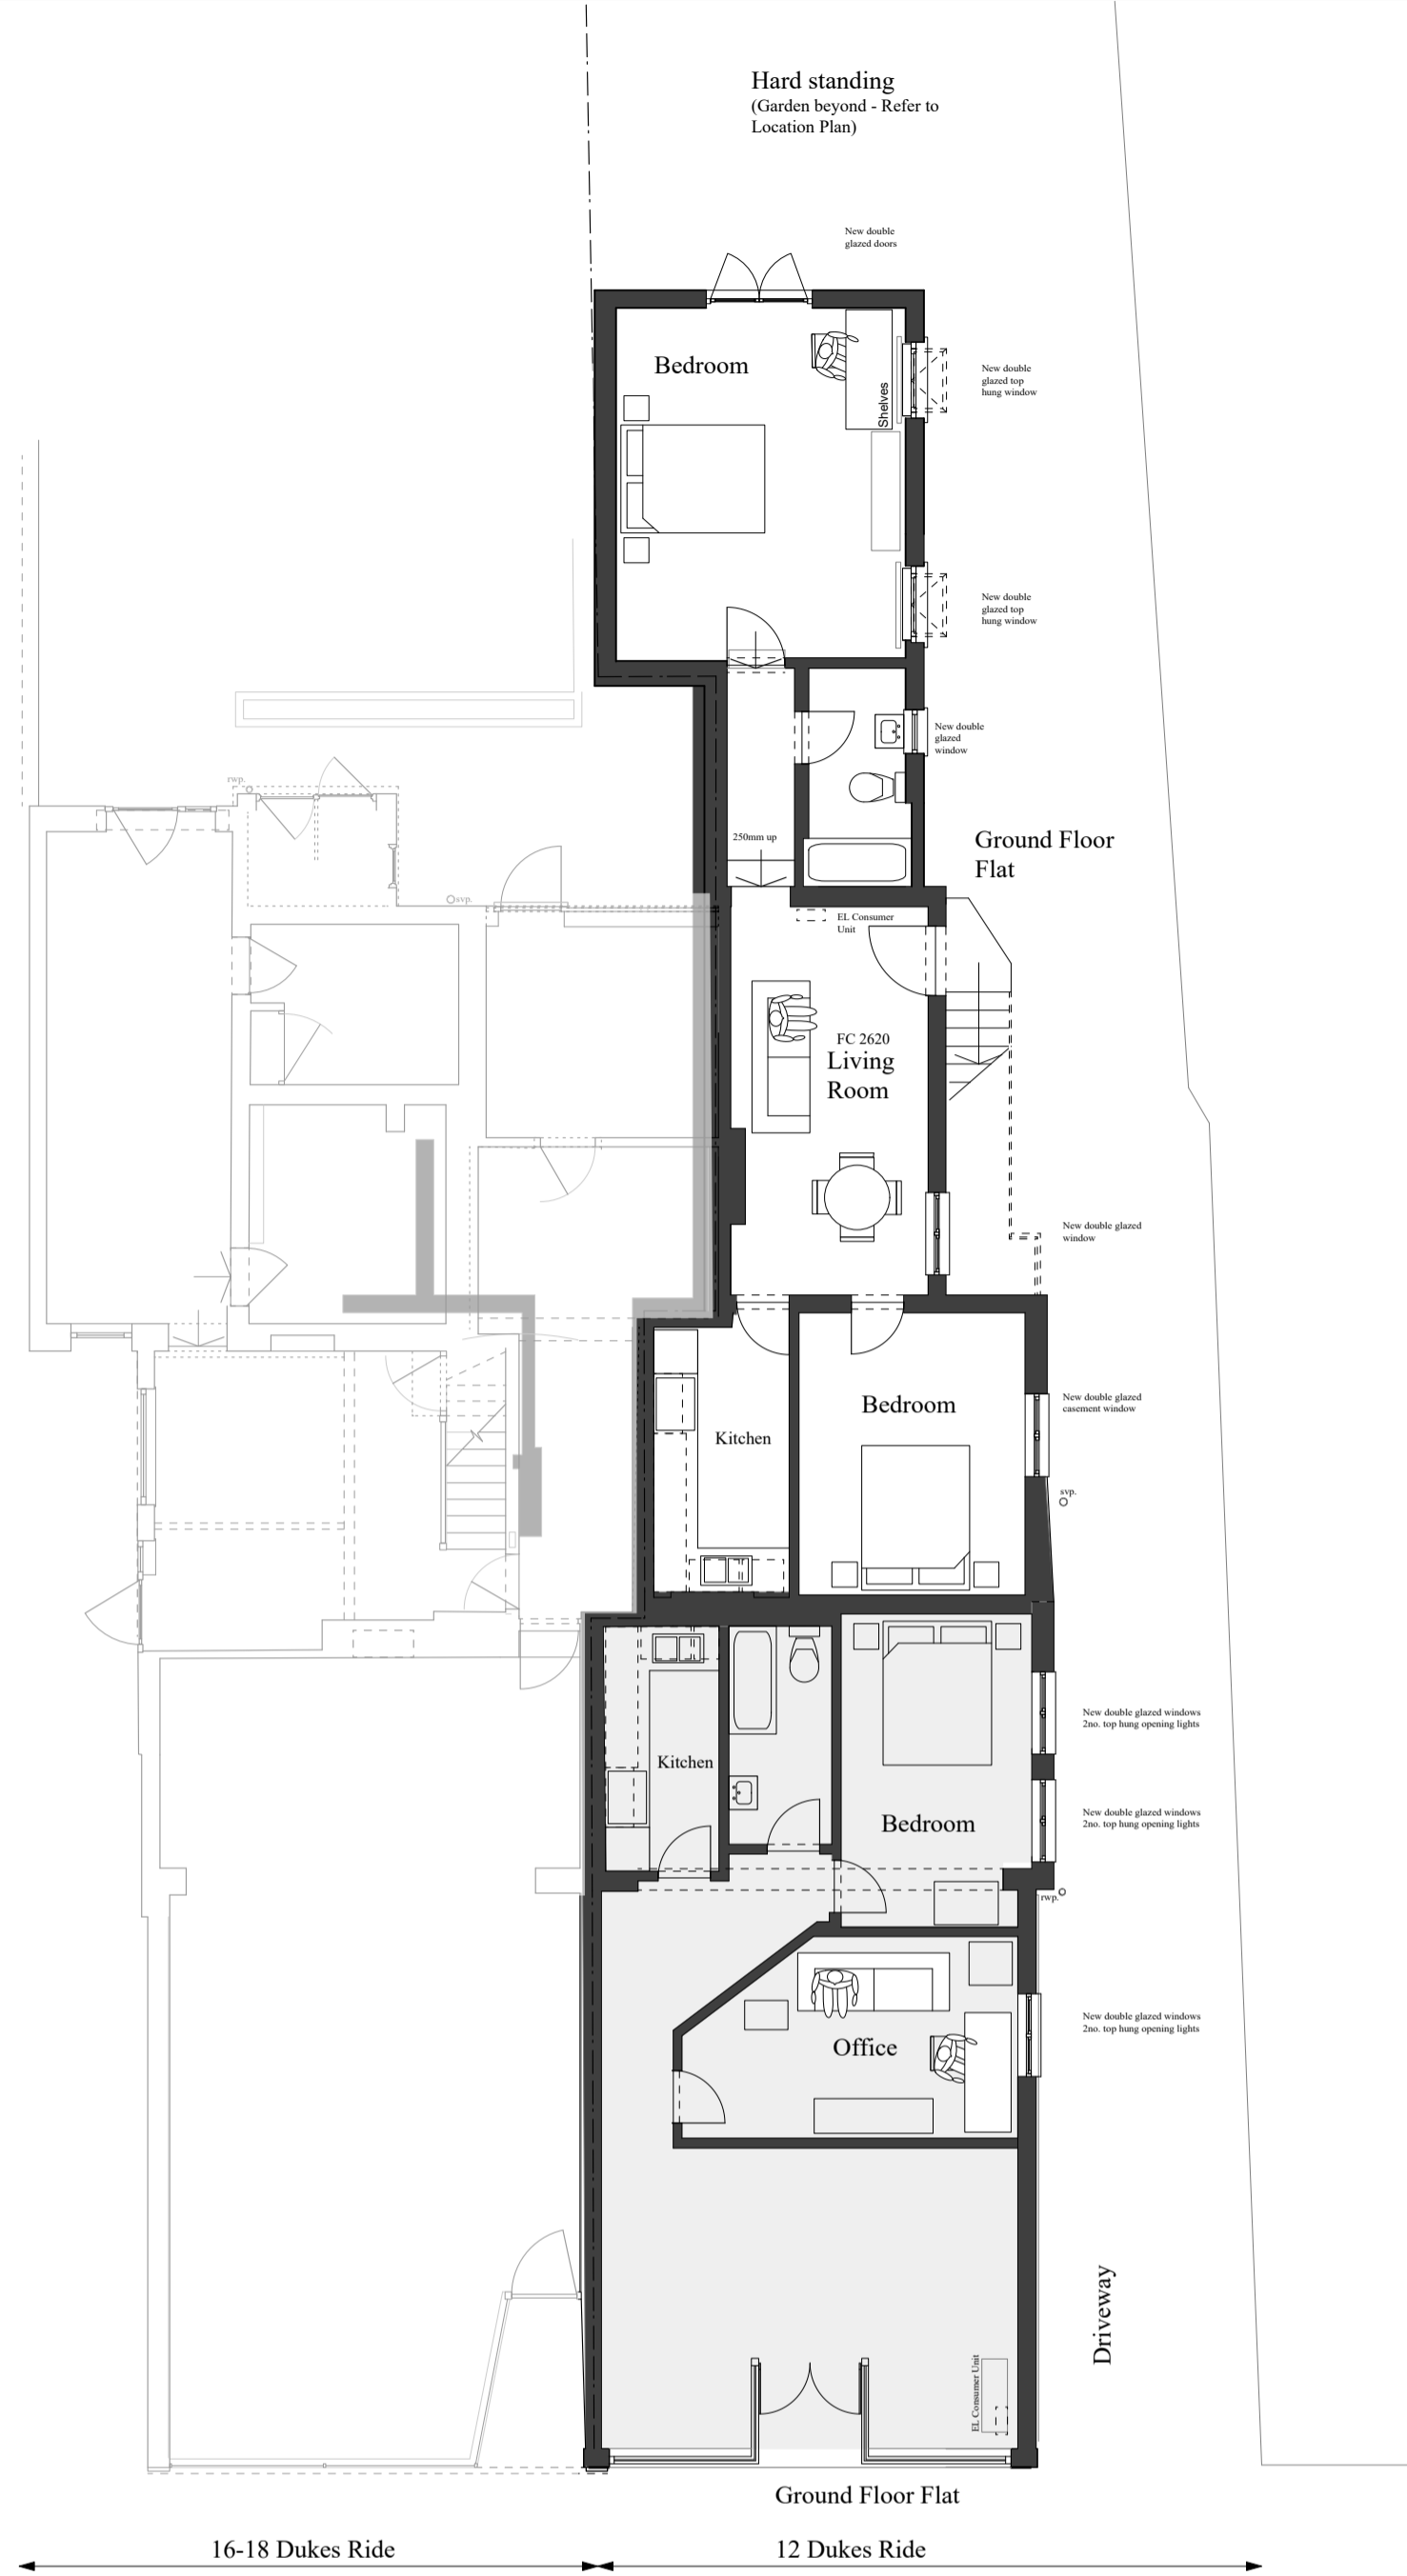

First Floor 2 Bed Flat  
Scale 1:100 @A1

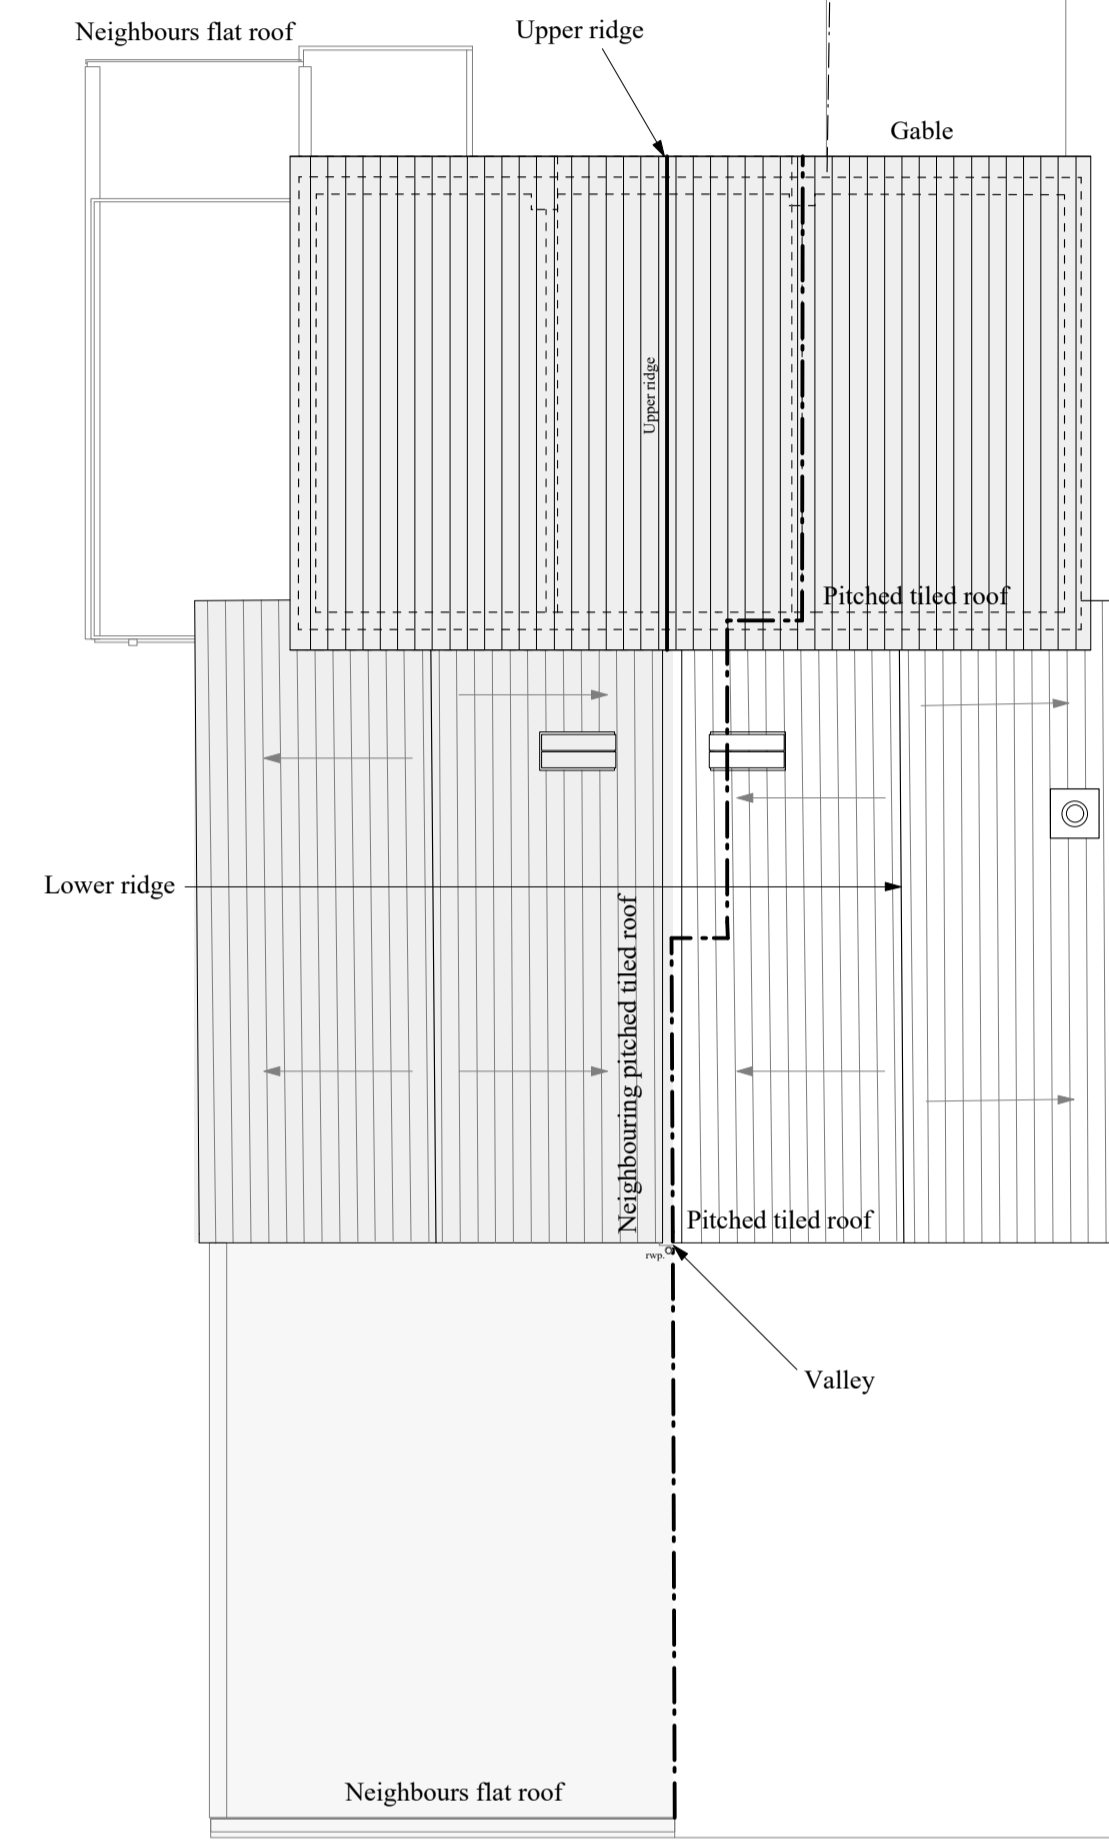

Roof Survey Plan  
Scale 1:100 @A1

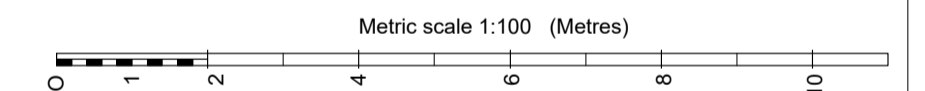

Front Elevation  
Scale 1:100 @A1



Rear Elevation  
Scale 1:100 @A1



Existing Side Elevation  
Scale 1:100 @A1

©Robert Young Associates (Hungerford) Ltd  
This drawing and design remains the  
copyright and intellectual Property of Robert  
Young Associates(Hungerford)Ltd and shall  
not be copied in any format without approval.

project name: 12 Dukes Ride  
Crowthorne  
Berkshire  
RG45 6LY  
client: Mr S Butterworth  
address: 12 Dukes Ride

job number: RY 845  
drawing reference: As Built Survey Plans  
and Elevations  
status: Planning application  
drawing number: CR2 010  
revision: A  
drawn: MFR  
date: 12/12/2023  
scale: 1:100 @ A1  
checked: R Y



**Robert Young Associates (Hungerford) Ltd**  
Architectural Consultants Chartered Townplanners  
Kennet House, 19 High Street, Hungerford, Berkshire RG17 0NL  
Tel: 01488 208 845 Mob: 07977407288  
bobyoung@ryassociatesuk.co.uk | www.robertyoungassociates.com