

- NOTES**
- UNDERGROUND SERVICES ARE INDICATIVE ONLY. POSITIONS SHOULD BE CONFIRMED ON SITE PRIOR TO ANY DEVELOPMENT
- DRAINAGE  
 DUCTS  
 FEEDERS  
 FENCE PLAN  
 GAS  
 LIGHTNING PROTECTION - EARTHING
- POWER  
 SERVICES UNKNOWN  
 TELECOMS  
 WATER

- ACCESS ARRANGEMENTS**
- KEYS:-
- ARQVA GATE KEY
  - B KEY
  - C KEY
  - LEGGIE KEY
- SURVEY REQUIRED TO CONFIRM ACCESS KEYS FOR REMAINING ROOMS AND SITE ENTRANCE

BT SKYLINE No. **GZ0036**

13.A			HFC
13	233577	16/10/20	JBT LBG
	MASTER UPDATE		
12	188912	03/05/19	KG LBG
	AS BUILT		
11	N/A	23/01/18	HF KG
	KEEP SELF INSTALL		
10	173706	12/01/17	HFC PD
	AS BUILTS		
ISS	REVISION	DATE	DRN APP



SITE No **164906**  
 MILNGAVIE ATE  
 ASHFIELD ROAD  
 MILNGAVIE  
 GLASGOW  
 GLASGOW  
 G62 6BT

NGR **NS 55298 74280**  
 OS GRID **255298 674280**


TITLE  
**SITE PLAN  
 EXISTING**

SCALE **1:200**

DRAWN	IM	31/05/11
APPROVED	LBG	16/10/20

DRG No.	Sheet 1 of 1	Rev
<b>164906-00-000-MD013</b>		<b>13.A</b>

NOTES

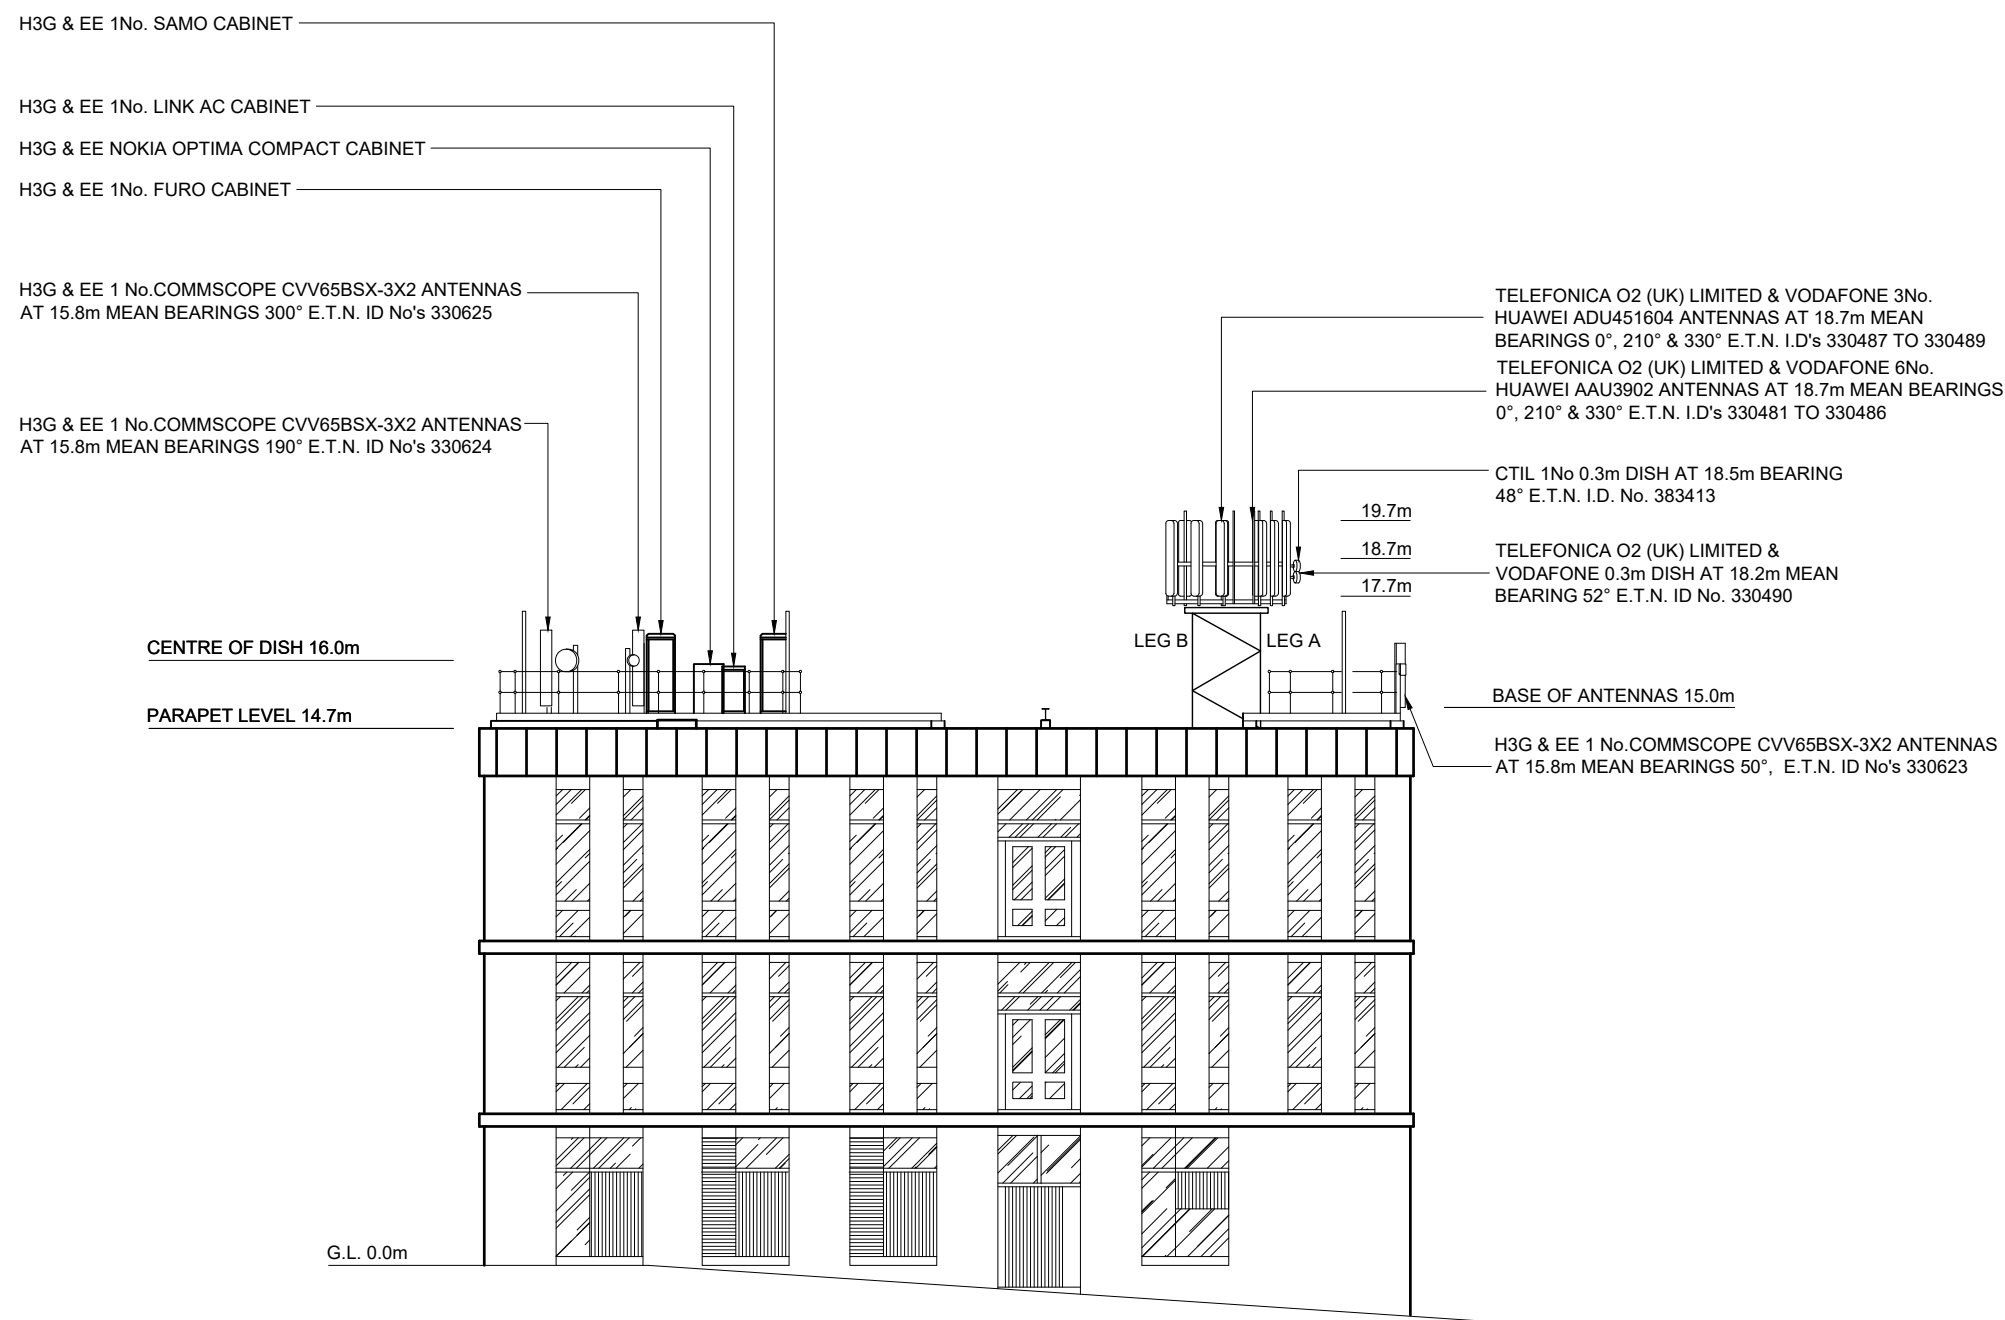

BT SKYLINE No.

**GZ0036**

13.A			HFC
13	233577	16/10/20	JBT LBG
	MASTER UPDATE		
12	188912	03/05/19	KG LBG
	AS BUILT		
11	N/A	23/01/18	HF KG
	KEEP SELF INSTALL		
10	173706	12/01/17	HFC PD
	AS BUILTS		
ISS	REVISION	DATE	DRN APP



CELLNEX UK  
 R+, 4TH FLOOR, 2 BLA GRAVE STREET, READING, RG1 1AZ  
 Tel. 020 4526 8553

SITE No **164906**

MILNGAVIE ATE  
 ASHFIELD ROAD  
 MILNGAVIE  
 GLASGOW  
 GLASGOW  
 G62 6BT

NGR **NS 55298 74280**

OS GRID **255298 674280**

TITLE  
 ELEVATION  
 EXISTING  
 SOUTH

SCALE **1:200**

DRAWN **IM** 31/05/11

APPROVED **LBG** 16/10/20

DRG No. **164906-00-002-MD013** Sheet 1 of 1 Rev

**13.A**