




AS BUILT GROUND FLOOR PLAN

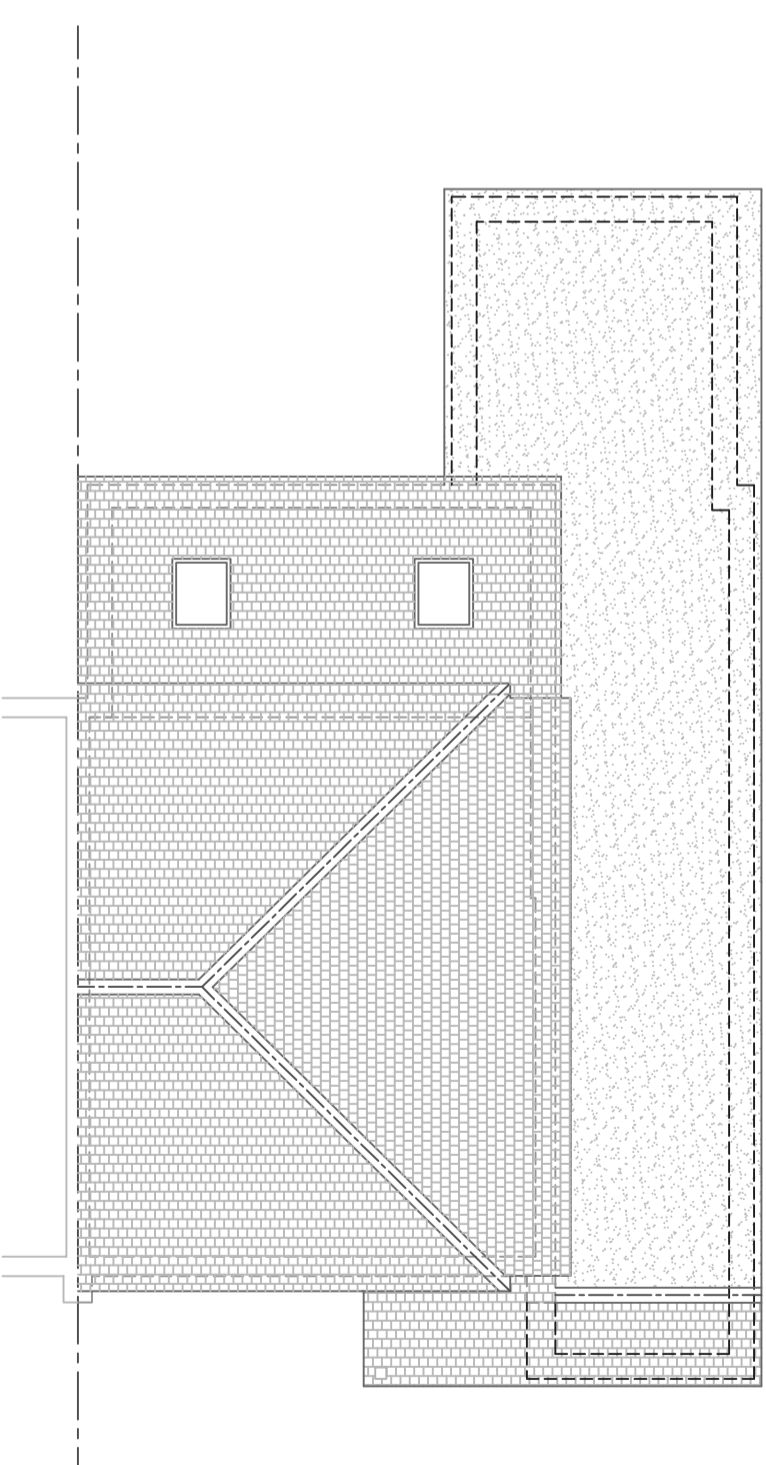


AS BUILT ROOF PLAN

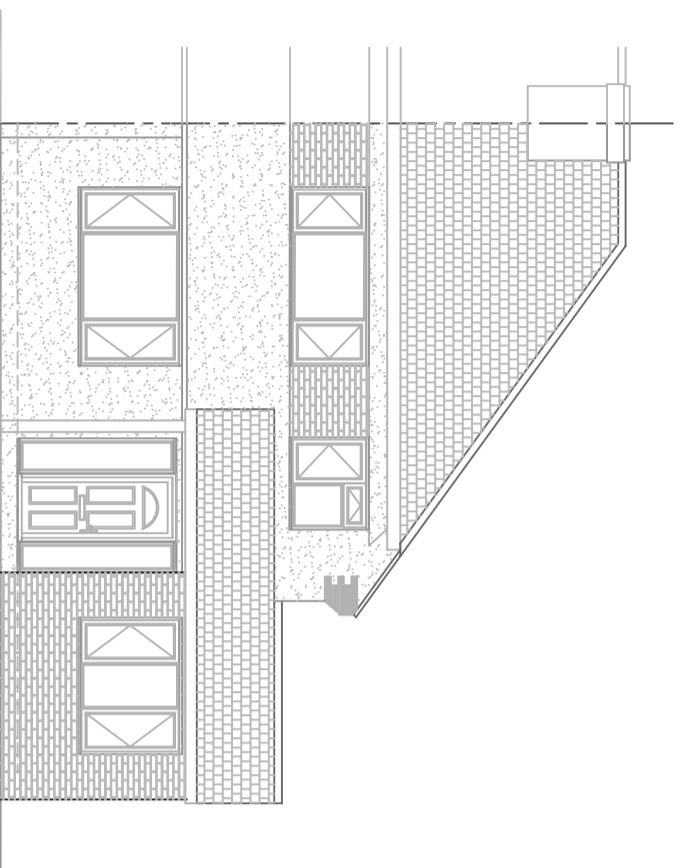


AS BUILT FRONT ELEVATION

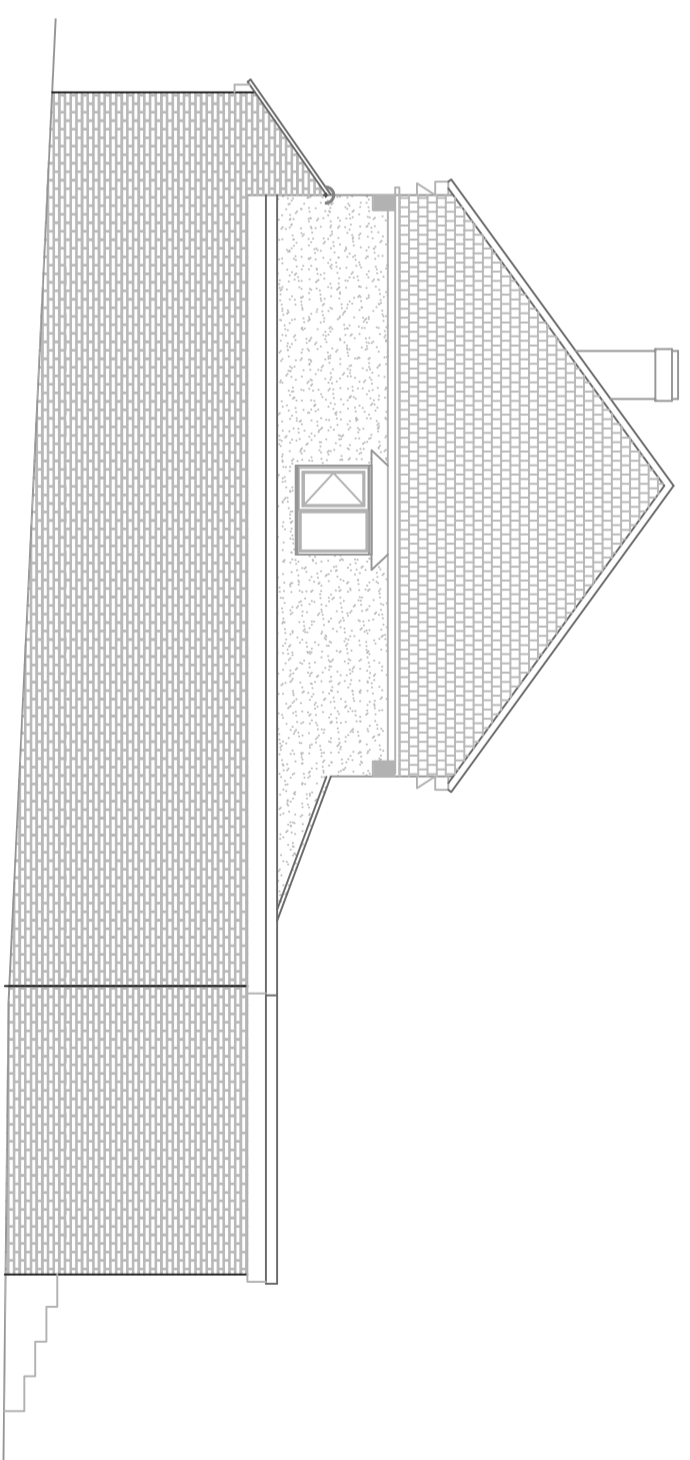

AS BUILT WEST SIDE ELEVATION

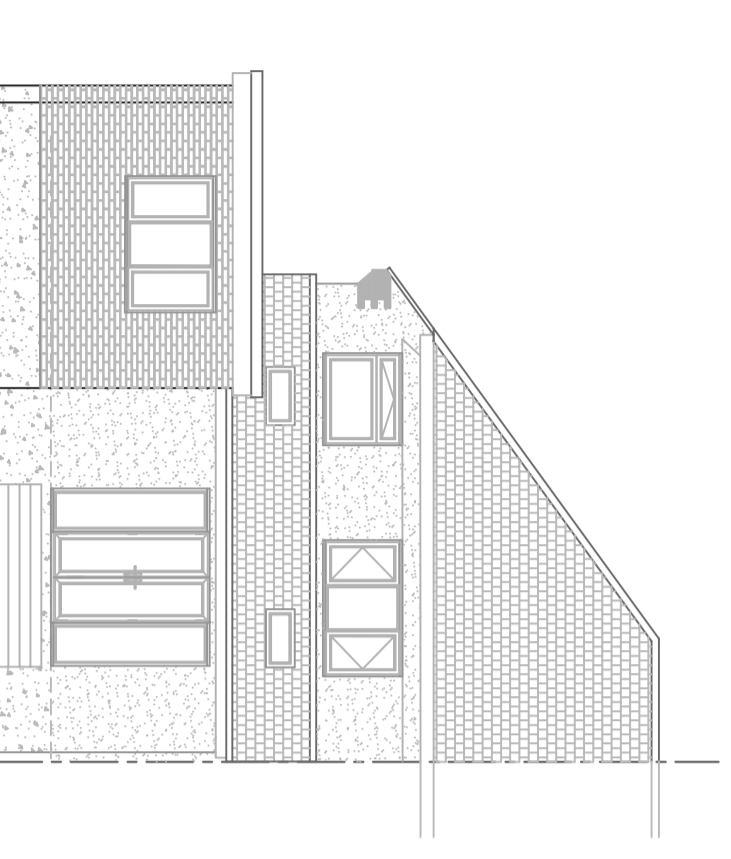

AS BUILT REAR ELEVATION

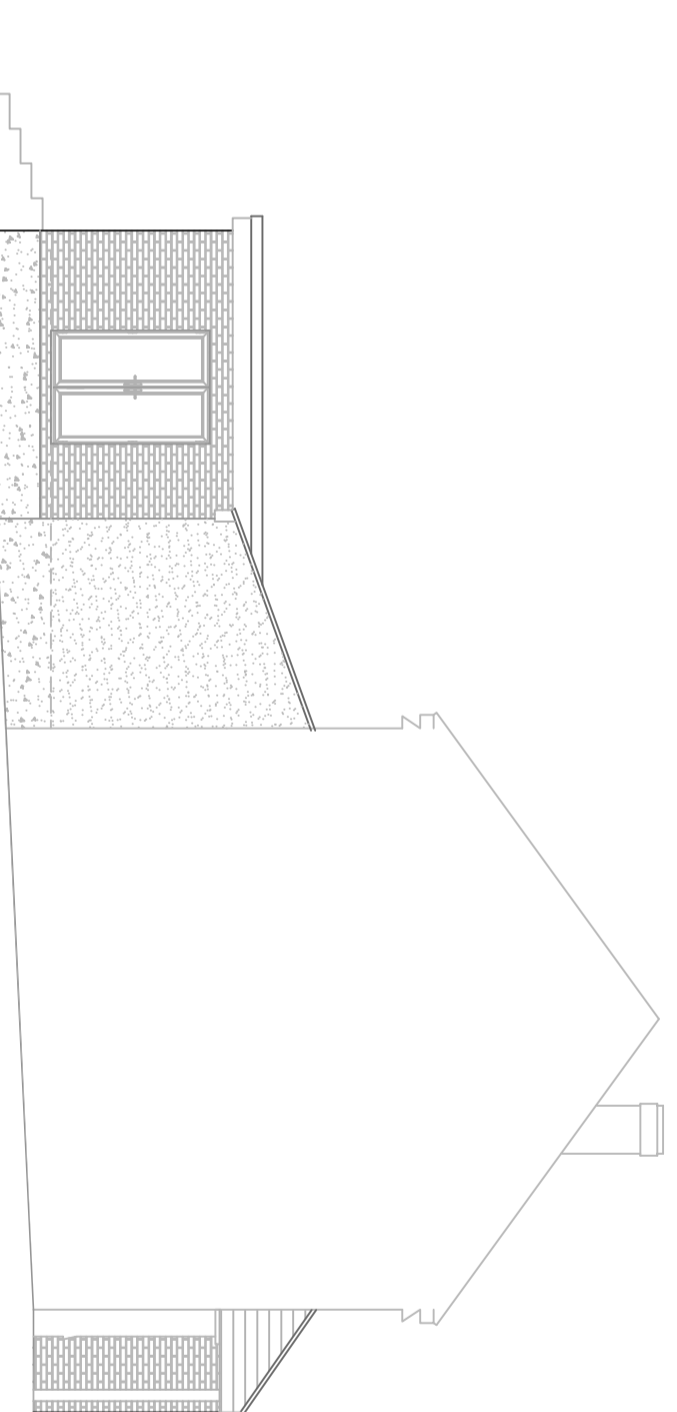

AS BUILT EAST SIDE ELEVATION



DATE	REVISION	REV
Jan 2024	ISSUED FOR DISCUSSION & APPROVAL BY CLIENT	A
		B
		C
		D

CLIENT
Mr Kevin Reynolds
28 Mable Road
Dartford, Kent
DA3 7QZ

TITLE
Single story side and rear at
28 Mable Road
Dartford, Kent
DA3 7QZ

AS APPROVED PLANS AND ELEVATIONS

Kentec Draughting Services
Architectural Division

Kentec Draughting Services
Architectural Division

LABC
Partner

DATE: January 2024

7632-P-03 A

PLAN APPROVED
Building Regulations Ref: -