

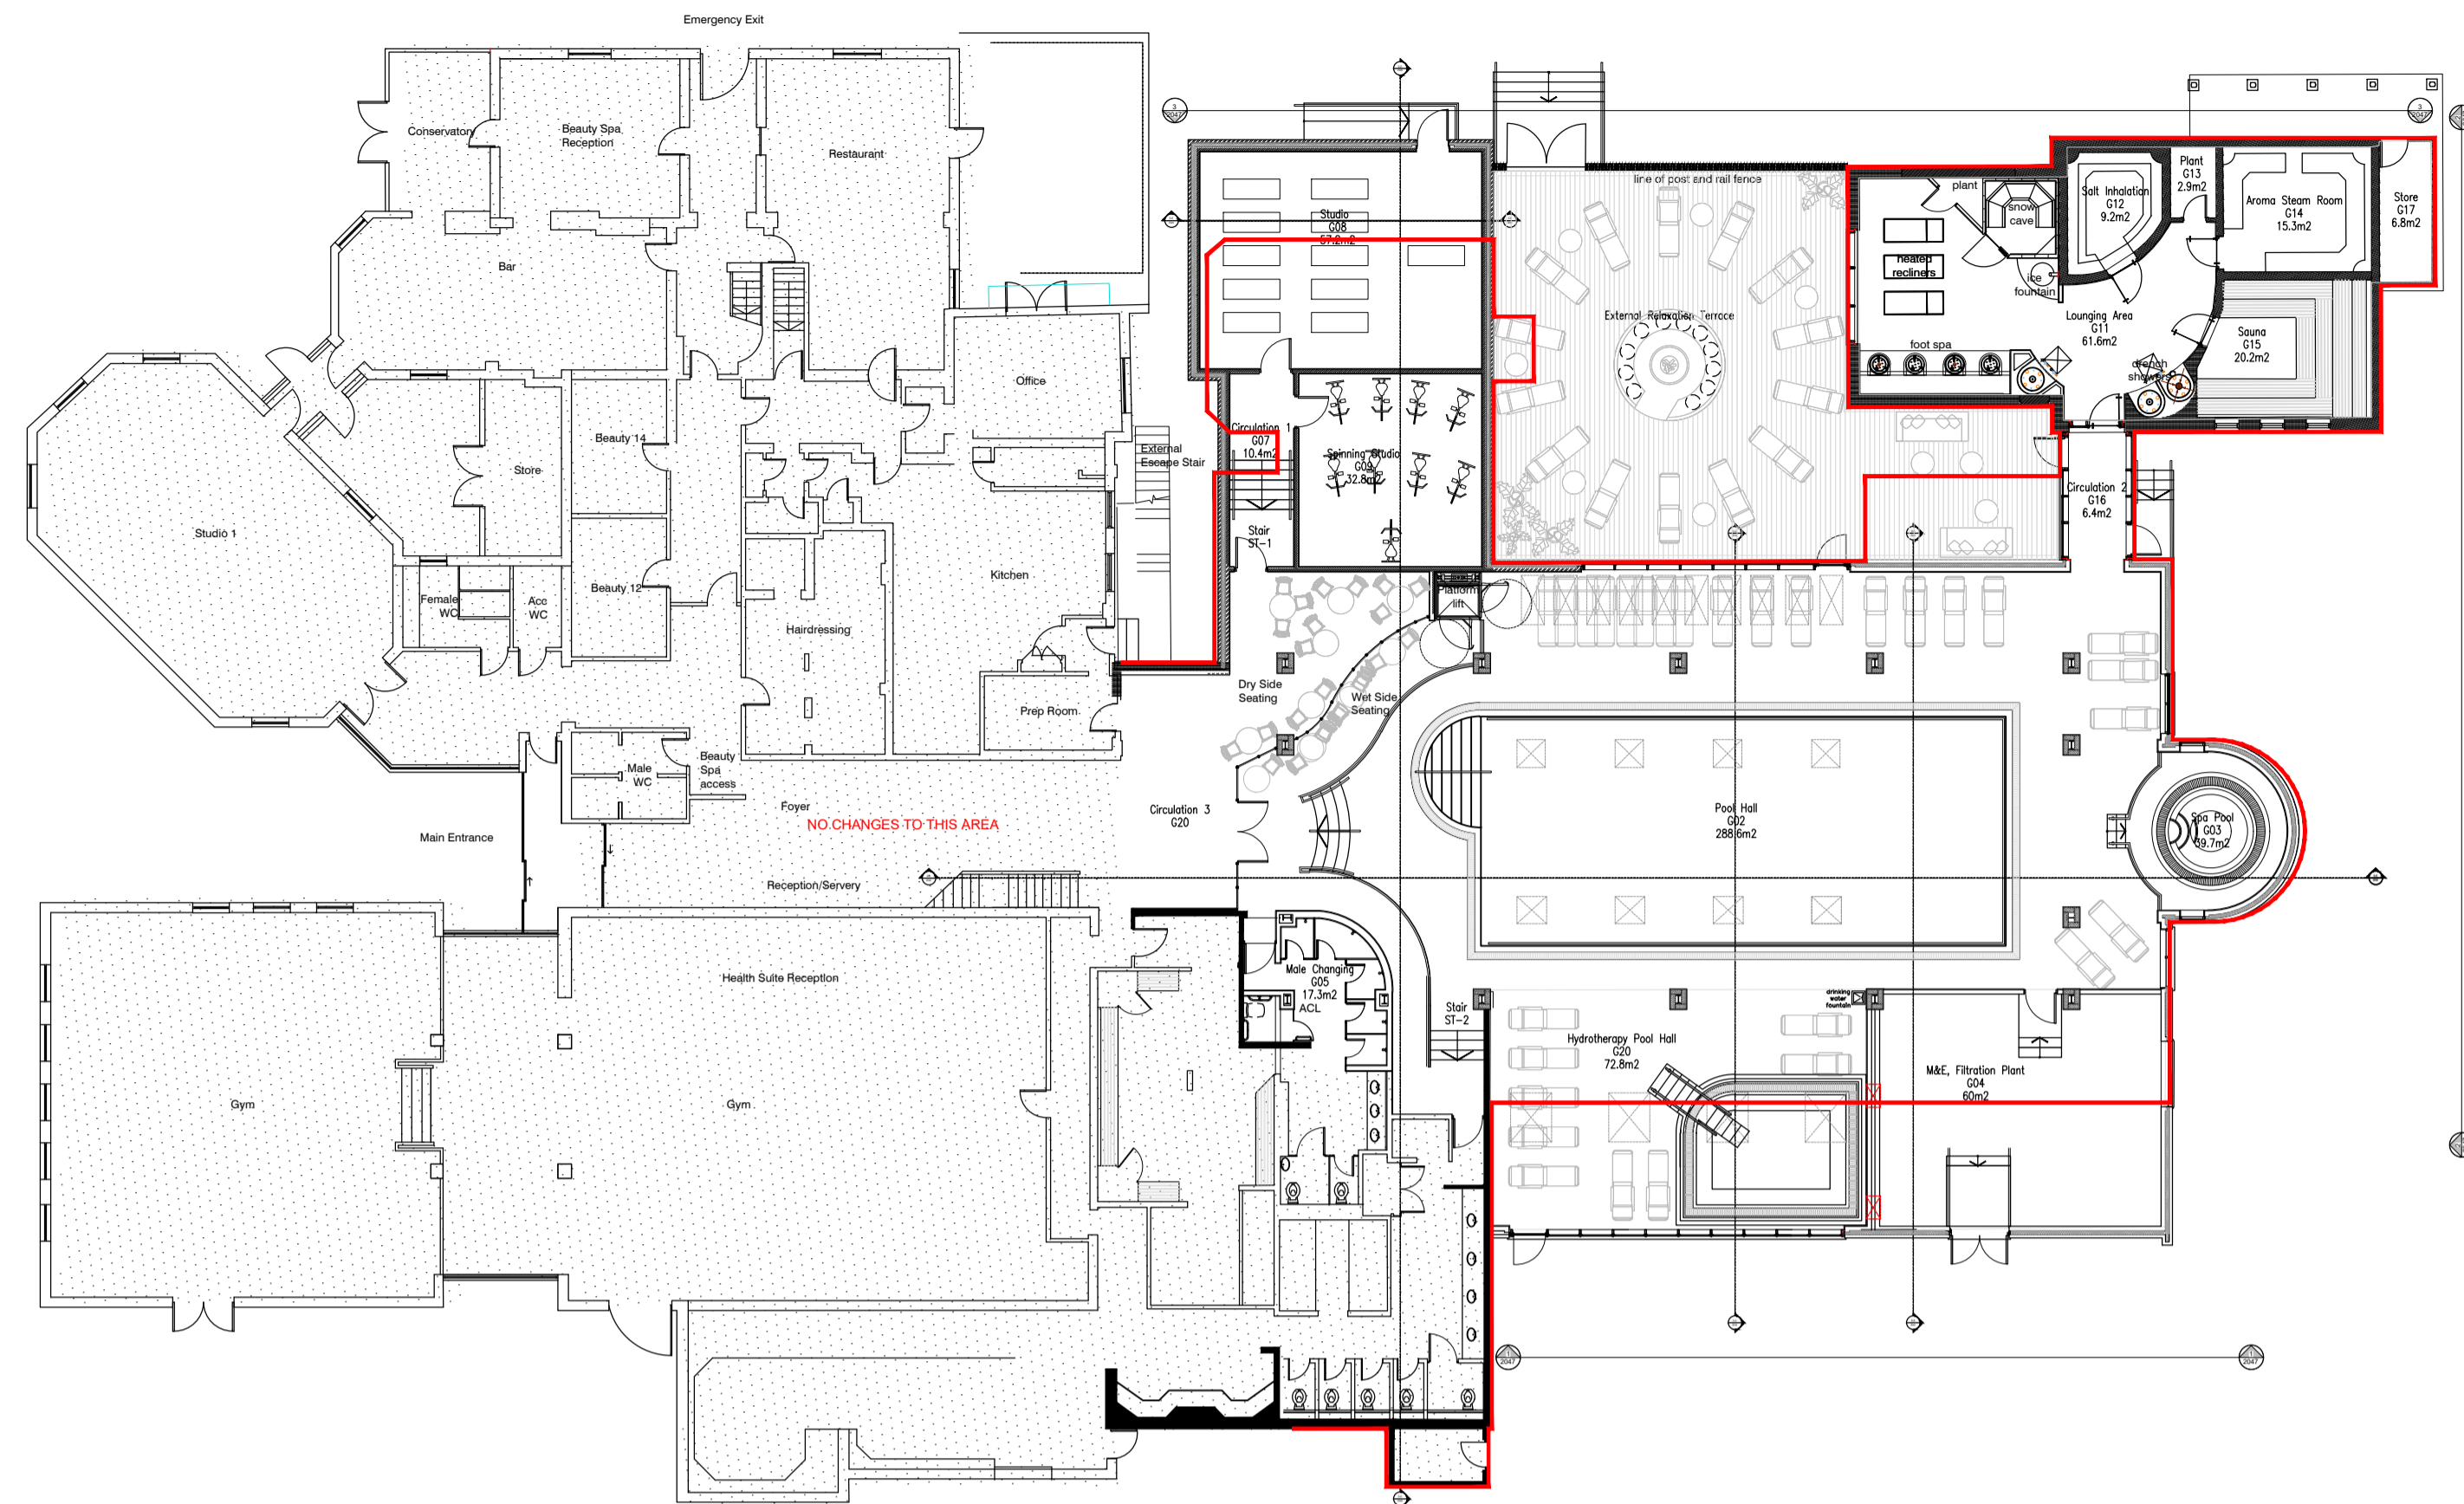


NOTE

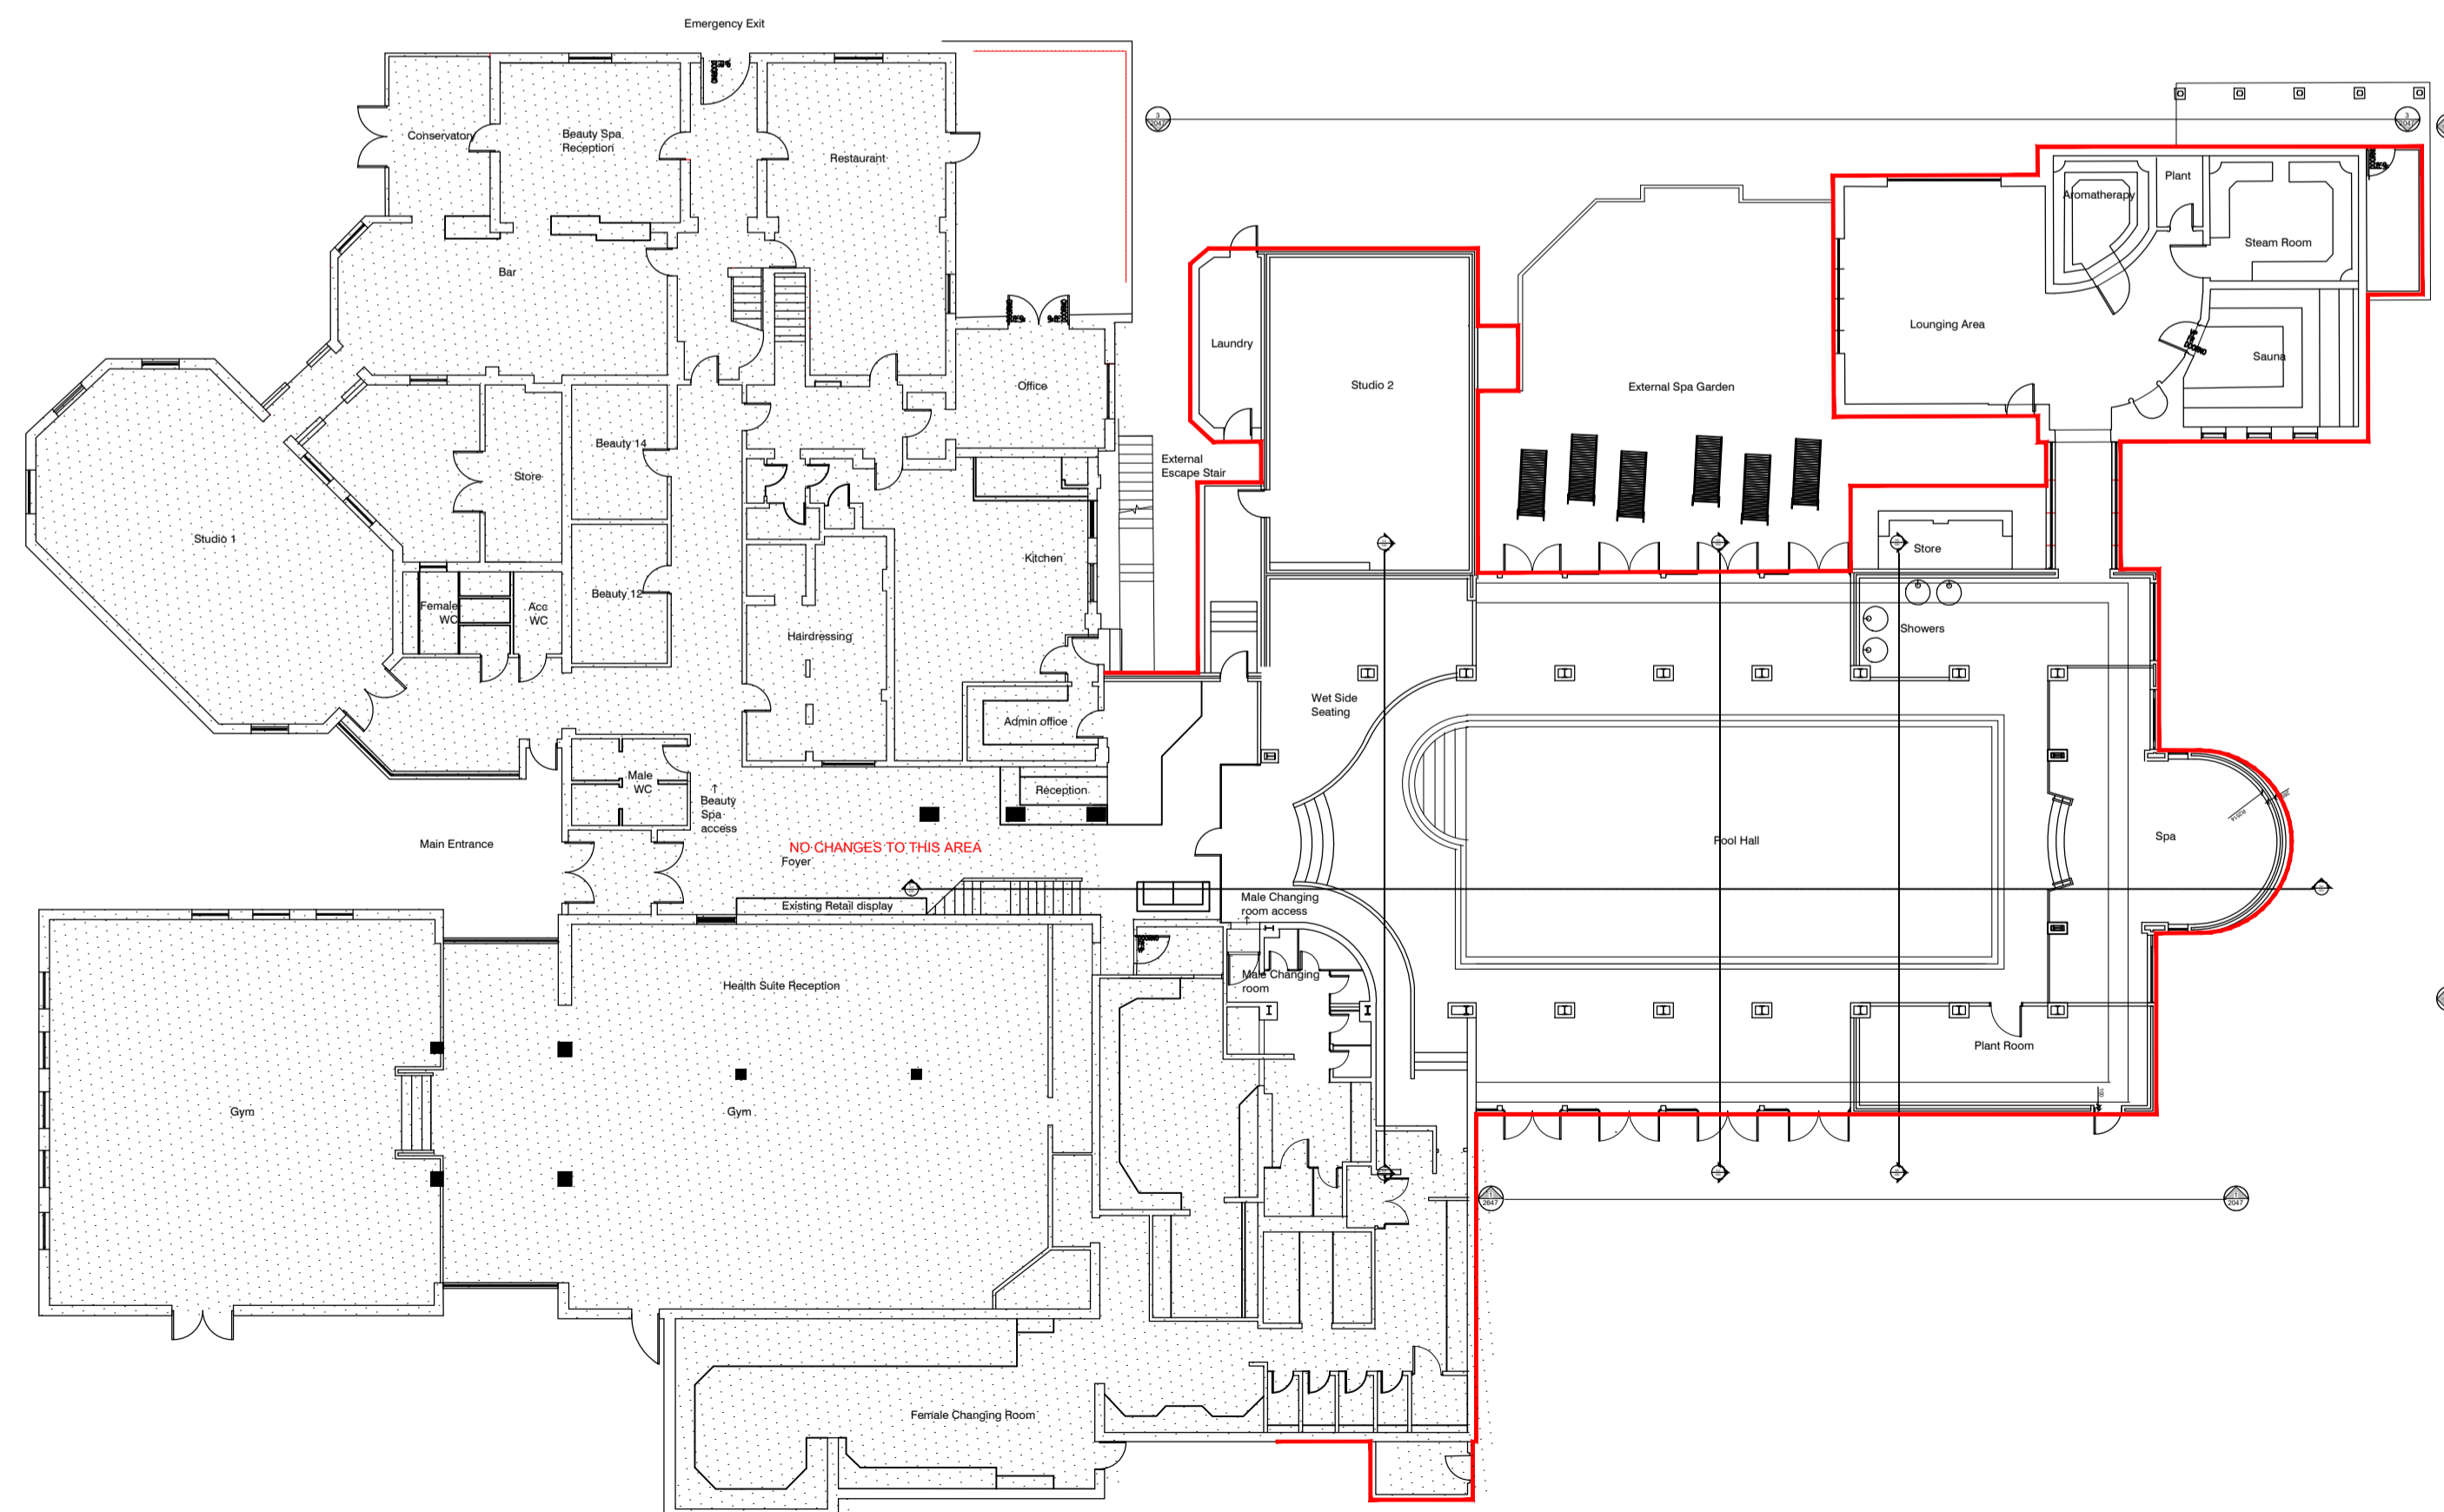


**BUILDING OUTLINE FROM EXISTING BUILDING OVERLAID ON PROPOSED FOR COMPARISONS**

**PROPOSED GROUND FLOOR PLAN - RED LINE IS OUTLINE OF EXISTING FLOOR PLAN**

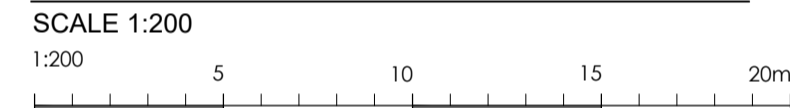

**EXISTING GROUND FLOOR PLAN**

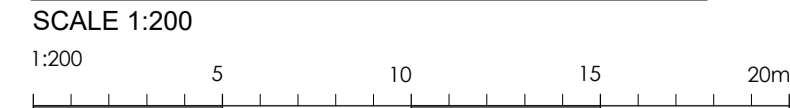

Revision	Date	Description	By/Ch
P01	20.12.23	Planning Submission	cm

CLIENT  
**Riverhills Health Club & Spa**  
 [Mosaic Group]



+44 800 909 8008    answers@space-place.com    www.space-place.com

STATUS: PLANNING

PROJECT

**RIVERHILLS HEALTH CLUB & SPA**  
 CLARICE HOUSE, BRAMFORD  
 IPSWICH IP8 4AZ

DRAWING

**COMPARISON OF EXISTING AND PROPOSED GROUND FLOOR PLAN**

SCALE 1:200    SHEET SIZE A1    DRAWN BY CM    CHECKED BY PC    DATE 20.12.2023

PROJECT NO.    DRAWING NO.    REVISION

**3970-ASP-ZZ-XX-DR-A-0815-P01**

This drawing must not be reproduced in whole or part without written consent. Do not scale this drawing. All dimensions in millimeters. Where dimensions to be checked on site. Electronic issue to be confirmed by paper copy only. ©2015 SPACE + PLACE. All Rights Reserved.