




NOTE

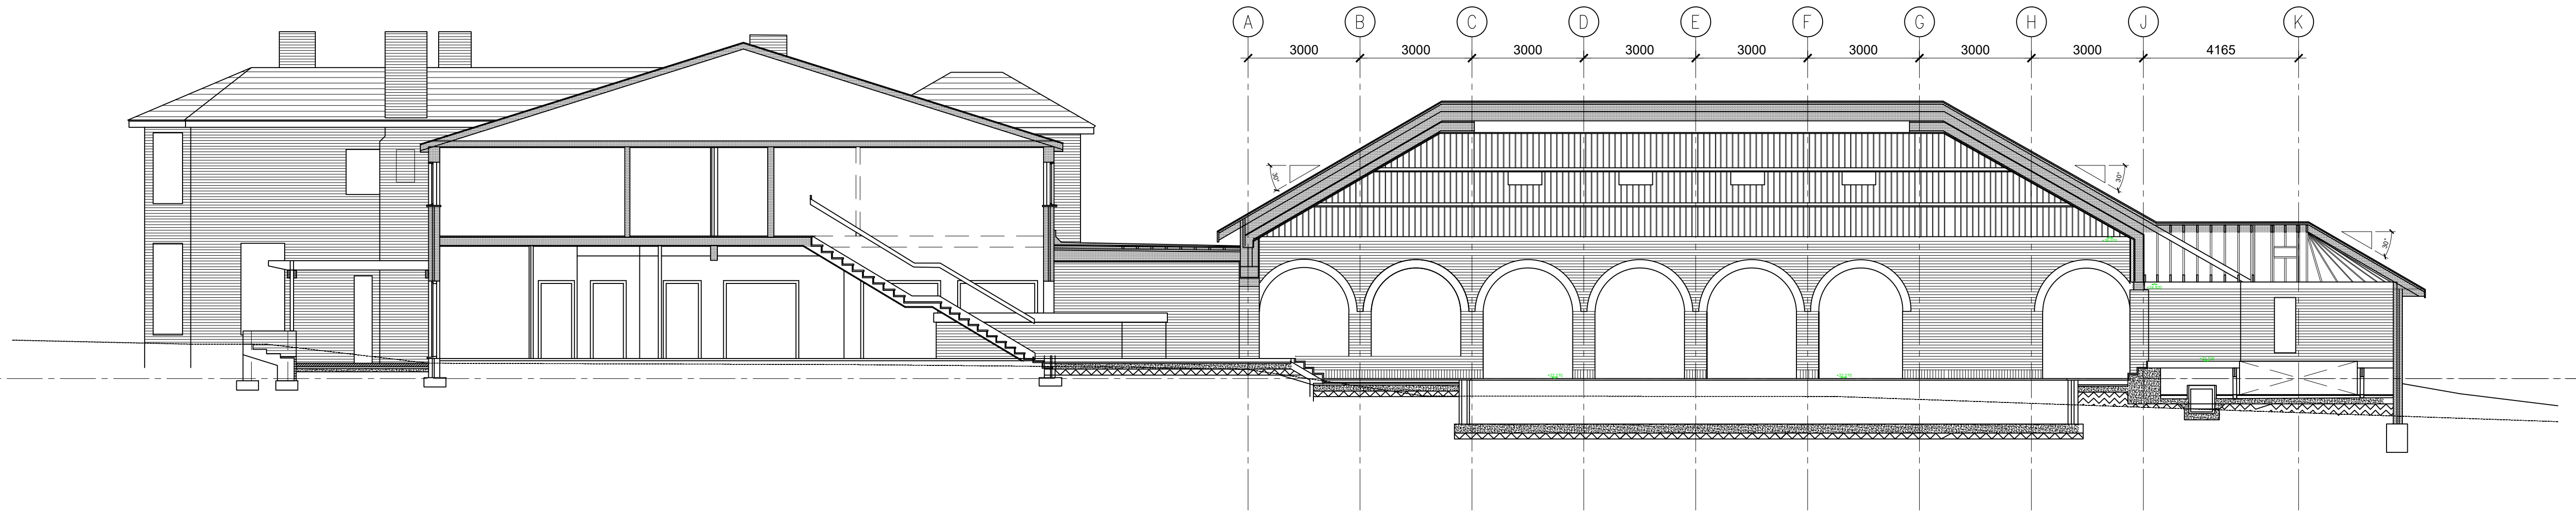


SECTION A-A  
SCALE 1:100

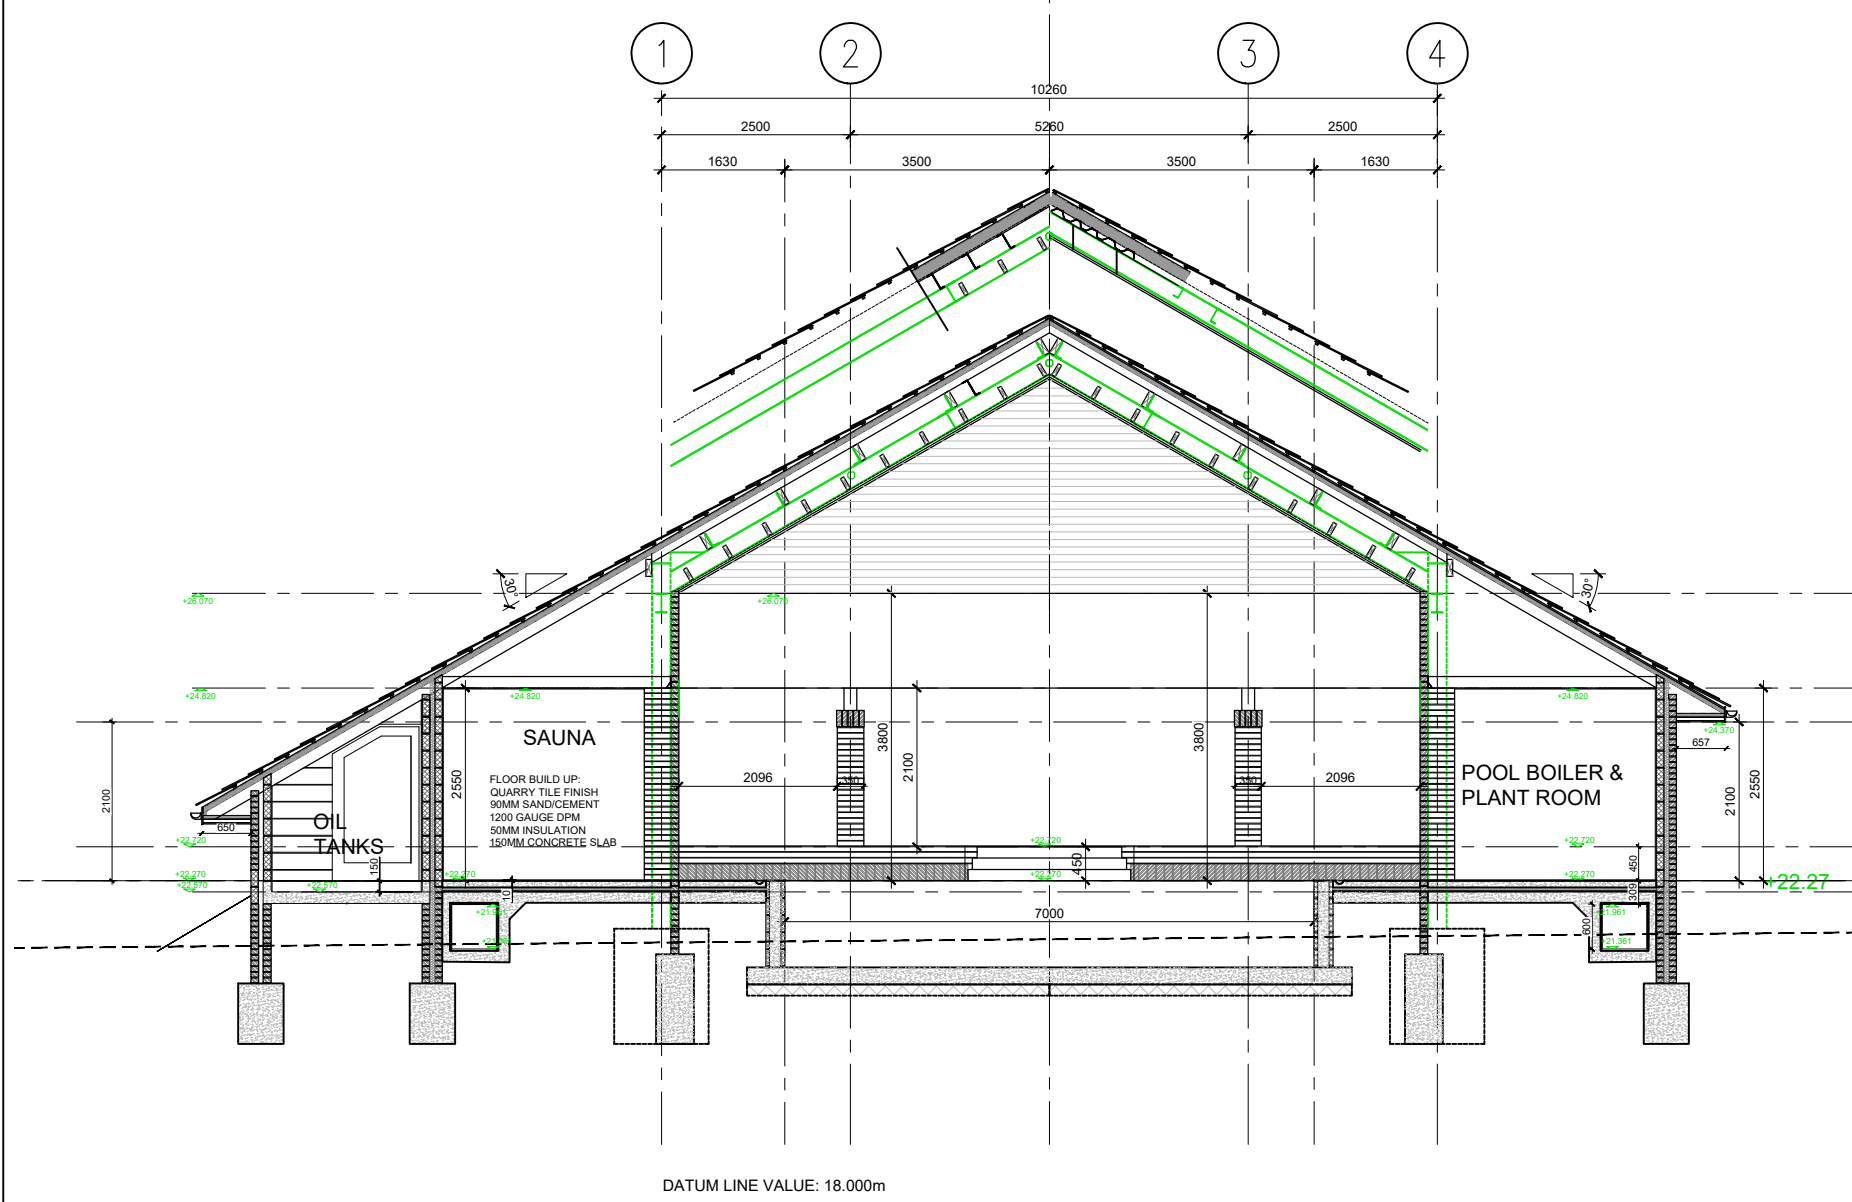

SECTION B-B  
SCALE 1:100

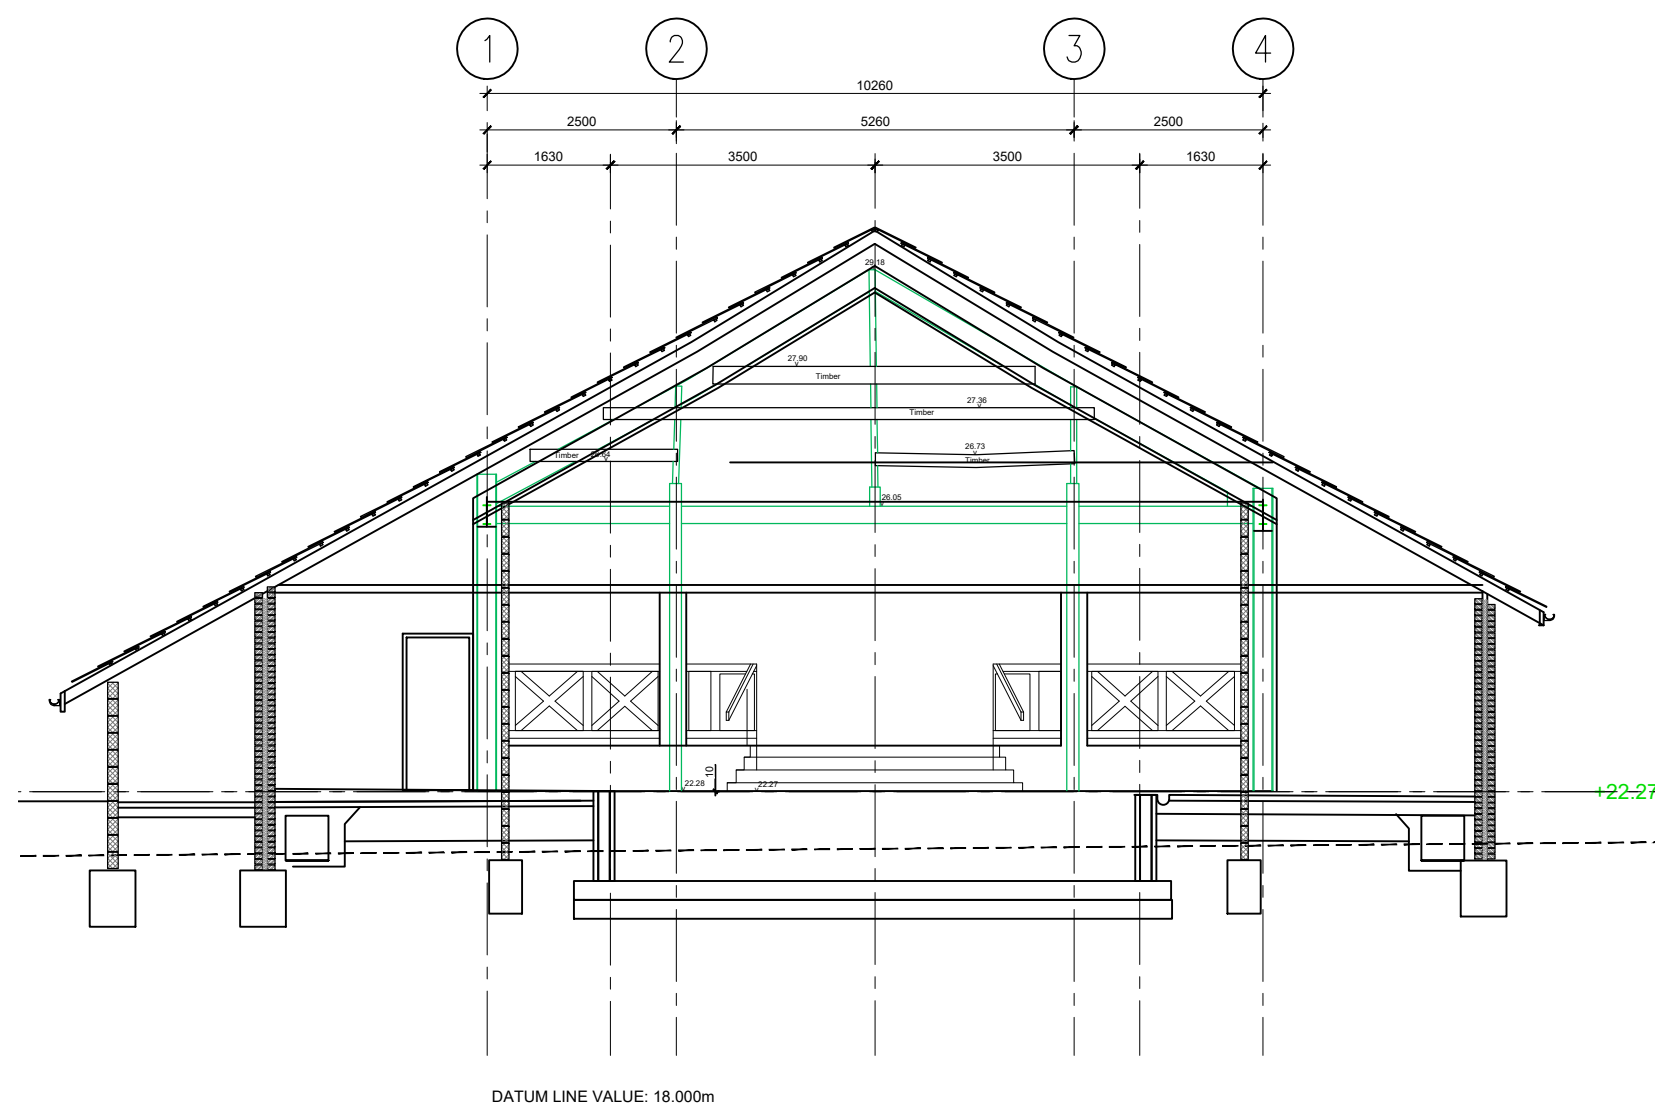

SECTION B-B WITH SURVEY OVERLAID

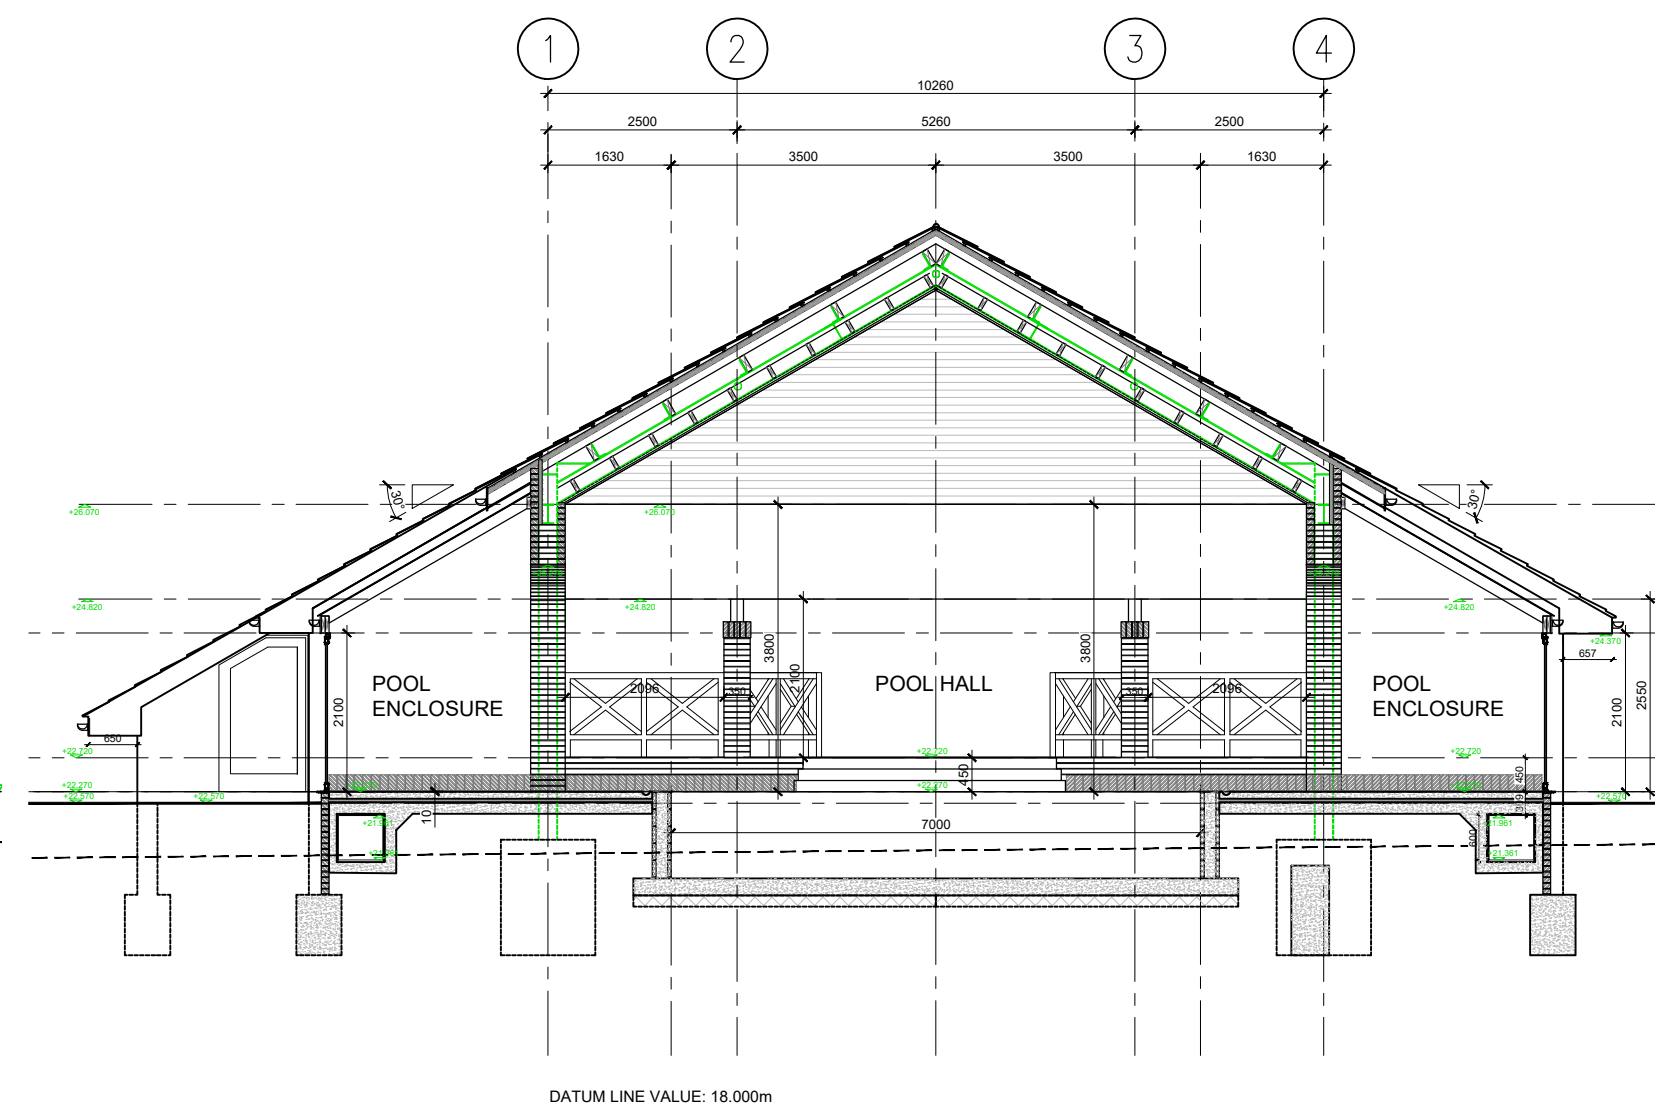

SECTION C-C  
SCALE 1:100

Dimensions in the pool hall area were taken from Hare Pert and Partners record drawings from 1994.


Where possible the survey information was used in conjunction with the record drawings.

Some areas, as noted, were too badly damaged in the fire for survey information and did not exist in the record drawings. Site survey verification will be required.


All information must be site verified. Not to be used for critical dimensions.



Revision	Date	Description	By/Ch
P02	25.10.23	Revised to incorporate the record drawings and survey information	CM

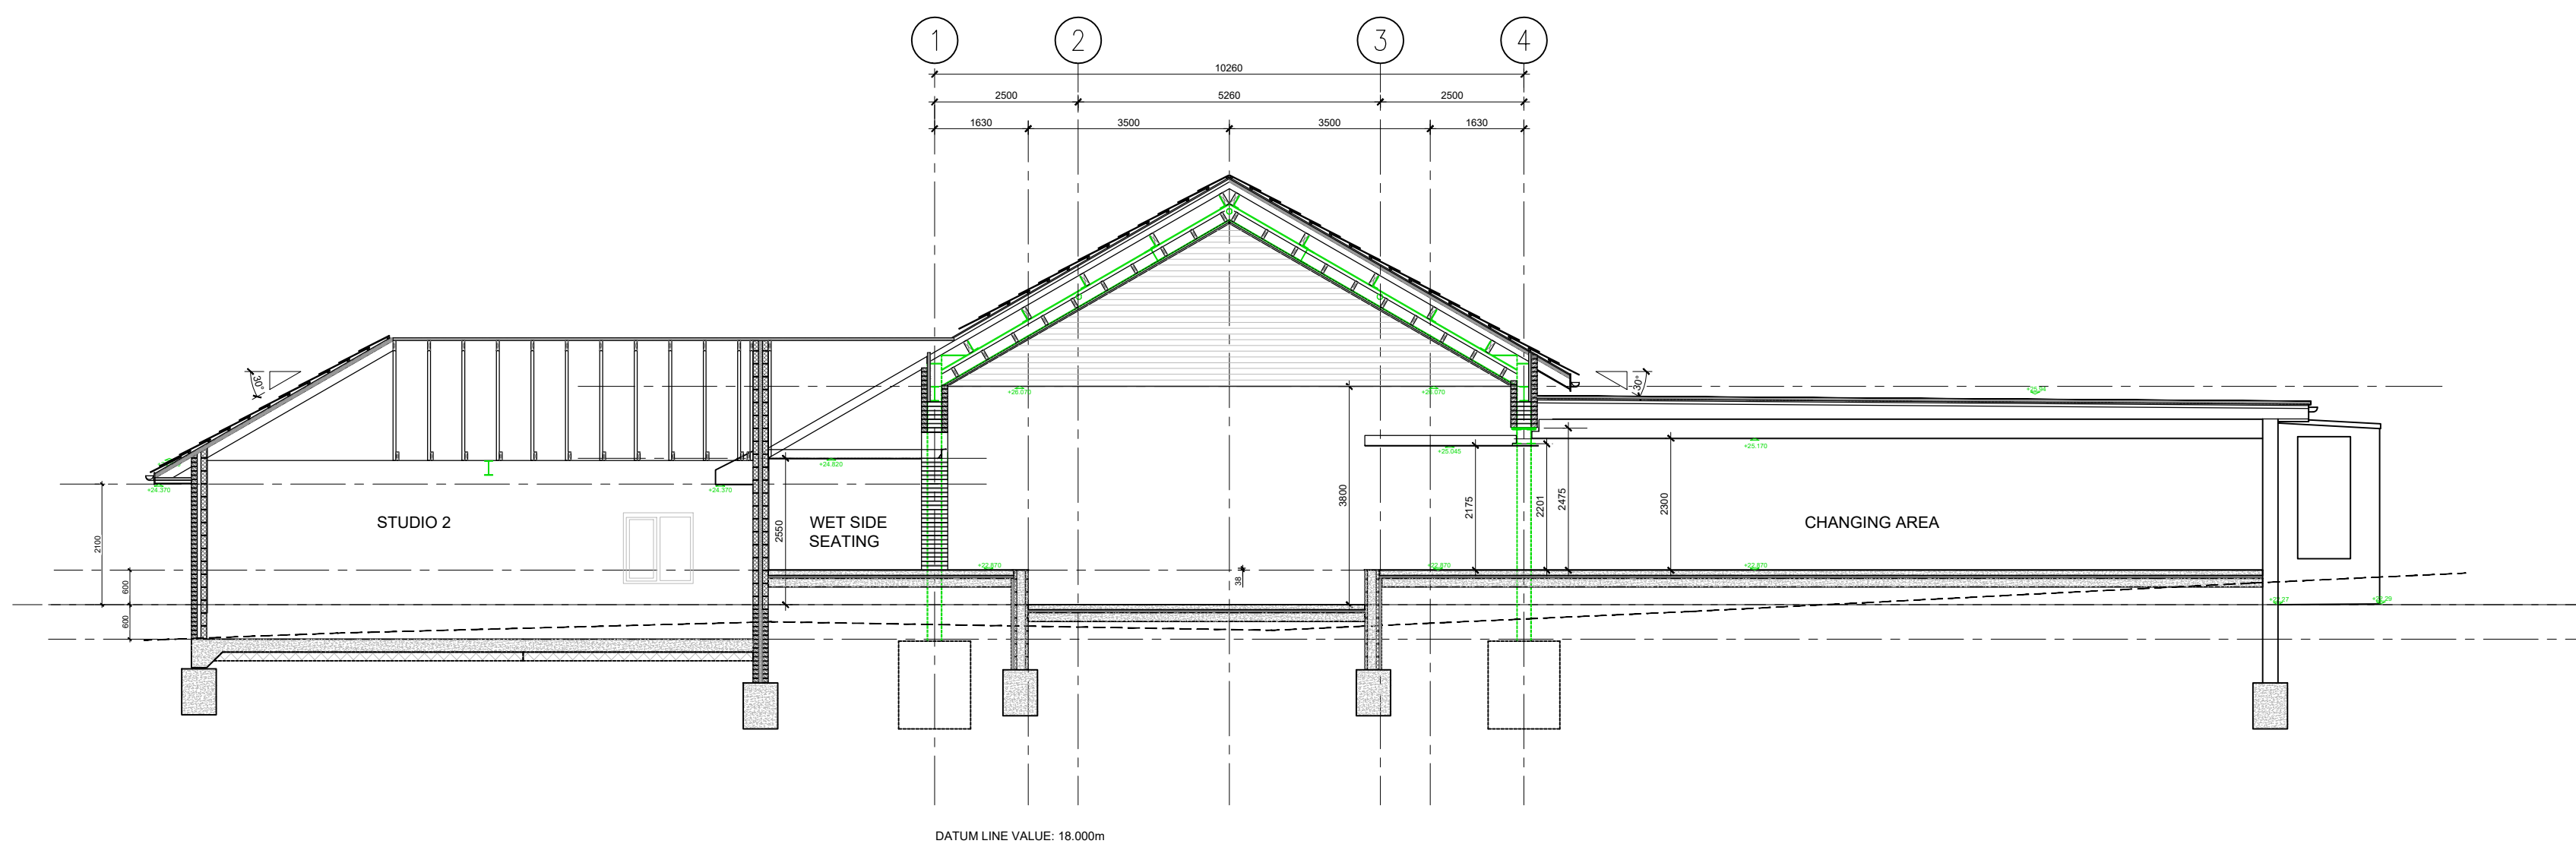

SECTION D-D  
SCALE 1:100

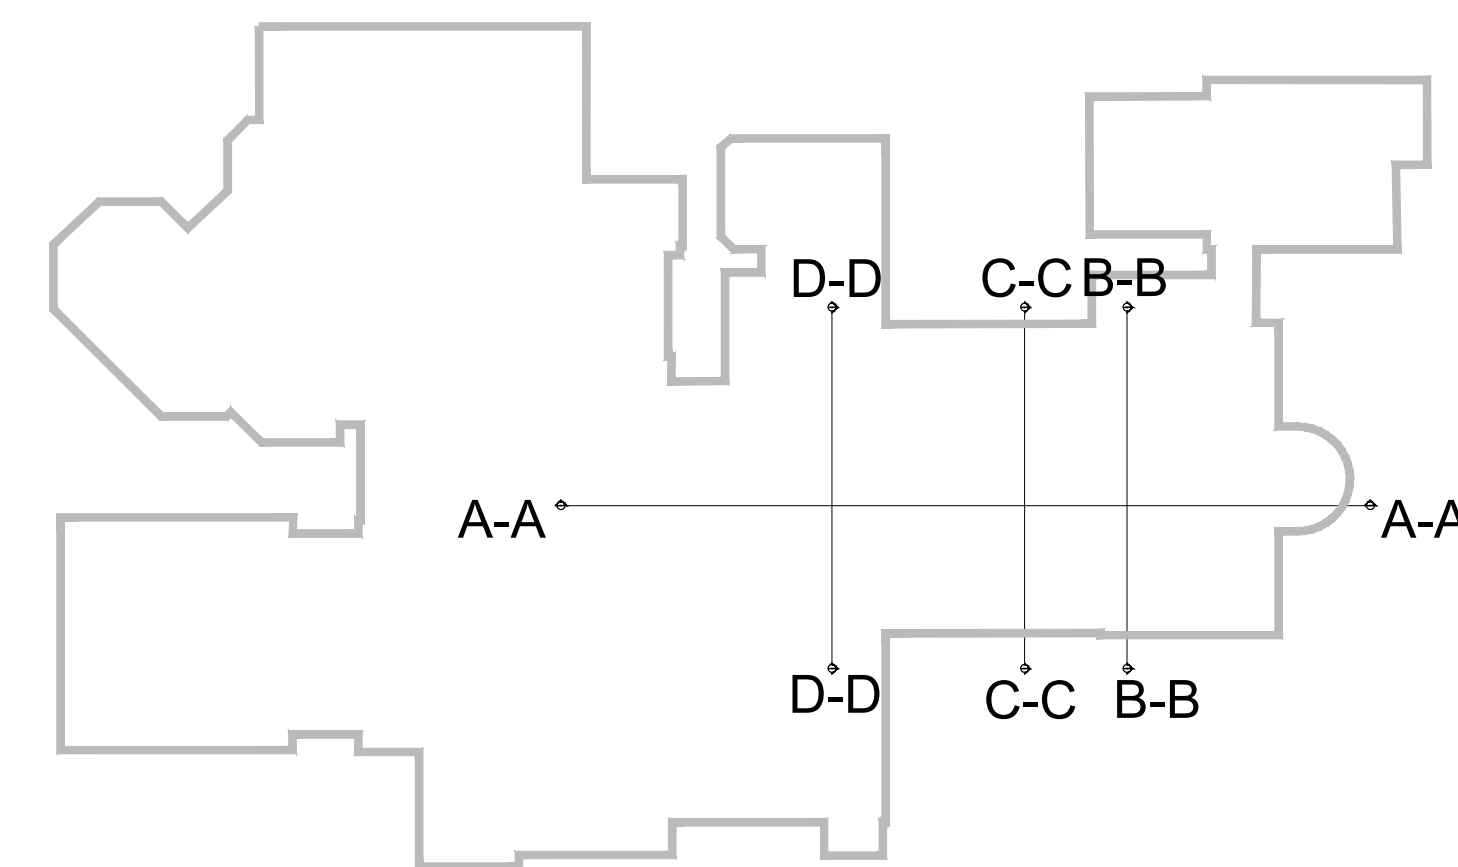

CLIENT  
Riverhills Health Club & Spa  
[Mosaic Group]

**SPACE PLACE**

+44 800 909 8008    answers@space-place.com    www.space-place.com

STATUS: PRELIMINARY

PROJECT

RIVERHILLS HEALTH CLUB & SPA  
CLARICE HOUSE, BRAMFORD  
IPSWICH IP8 4AZ

DRAWING

EXISTING SECTIONS

SCALE 1:100    SHEET SIZE A1    DRAWN BY CM    CHECKED BY PC    DATE 18.10.2023

PROJECT NO.    DRAWING NO.    REVISION

3970-ASP-ZZ-XX-DR-A-2044-P02

This drawing must not be reproduced in whole or part without written consent. Do not scale this drawing. All dimensions in millimeters. Where dimensions to be checked on site. Electronic issue to be confirmed by paper copy only. ©2013 SPACE PLACE. All Rights Reserved.